


O.D.O.T. DISTRICT 2 SURVEY OFFICE (USE ONLY)


PERSONNEL \_\_\_\_\_ REFERENCE NO. 34 SHEET 13 OF 35  
 NOTES HOMAN DATE 8/25/14 ROUTE SR 18  
 H.C. LEU WEATHER SUNNY COUNTY WOOD  
 R.C. RHOADES TEMP. 80° TOWNSHIP BLOOM  
 SECTION 33  
 DWG BY MILLER PID 93417 T 3 N R 11 E

TYPE MONUMENT SM.R.R. SPIKE  
~~ON SURFACE~~ - BELOW 0.5"  
 OFFSET  $\text{C}$  PAVEMENT 24.0' ~~±~~ : RT  
     TO      EDGE PAVEMENT 2.0' E  $\text{C}$  OF PVMT S  
 STATION: 850+99.70

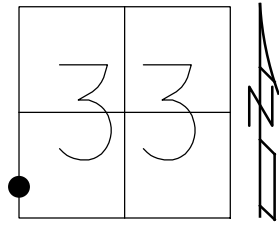

HORIZ.DATUM: NAD83 (2011) GEOID: 2012A  
 GRID: NORTHING: 550663.236 EASTING: 1662423.519

RECORD:  
 FD SM R.R. SPIKE  
 6/16/99, MB  
 SET P.K./WASHER  
 7/20/99, MB  
 FD SM R.R. SPIKE  
 REF34  
 8/25/14, DCH

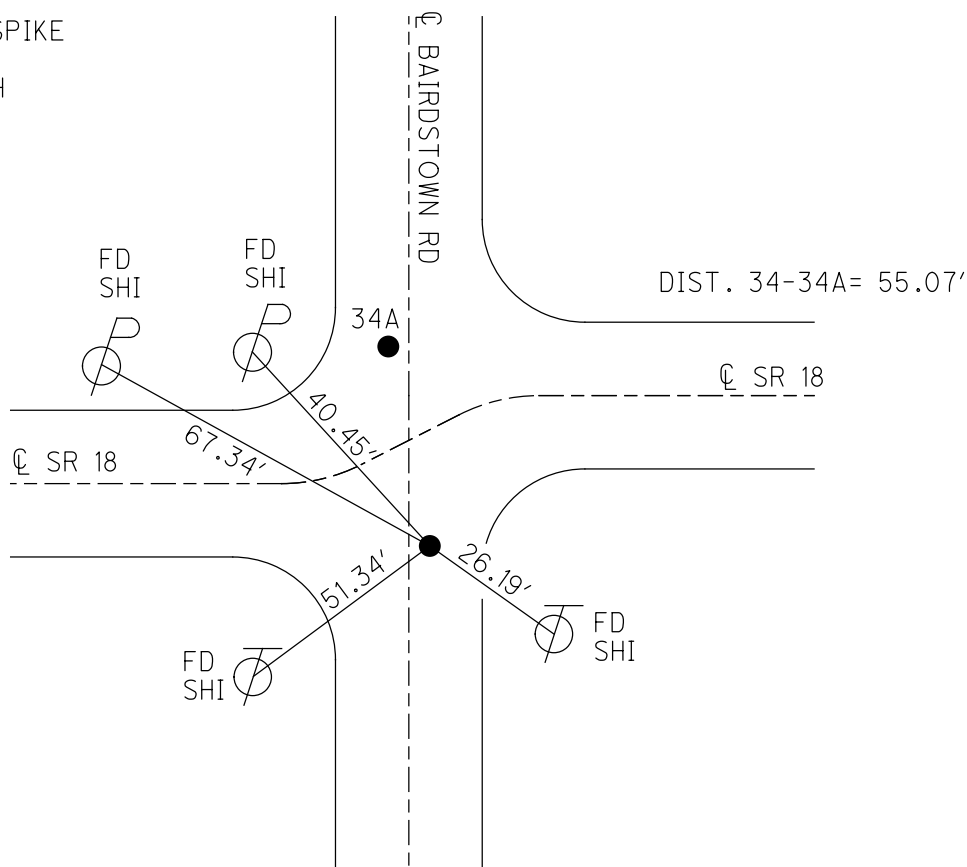

# O.D.O.T. DISTRICT 2 SURVEY OFFICE

PERSONNEL

REFERENCE NO. 34

SHEET 8 OF 29

NOTES BAPPHISEL

H.C. CANTERBURY

DATE 6-16-99

ROUTE SR 18

R.C. Rousos III

WEATHER CLOUDY

COUNTY Wood

TEMP. +65°

TOWNSHIP Bloom

SECTION 33

T 3 N R 11 E


TYPE MONUMENT SMALL R.R. SPIKE  
BORN POINTS A & B

ON SURFACE - BELOW 2" BELOW 2" BELOW


LEFT - PAV'T. - RIGHT A = 24' AT. & B = 31' AT.  
2' E. PAV'T. & 2' W. PAV'T.

TO EDGE PAVEMENT

S.L.M. 851+10 851+61

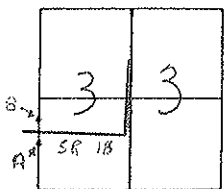

Reset PK/WASHER PT "A"  
 PT "B" NOT COVERED  
 7-20-99  
 MB

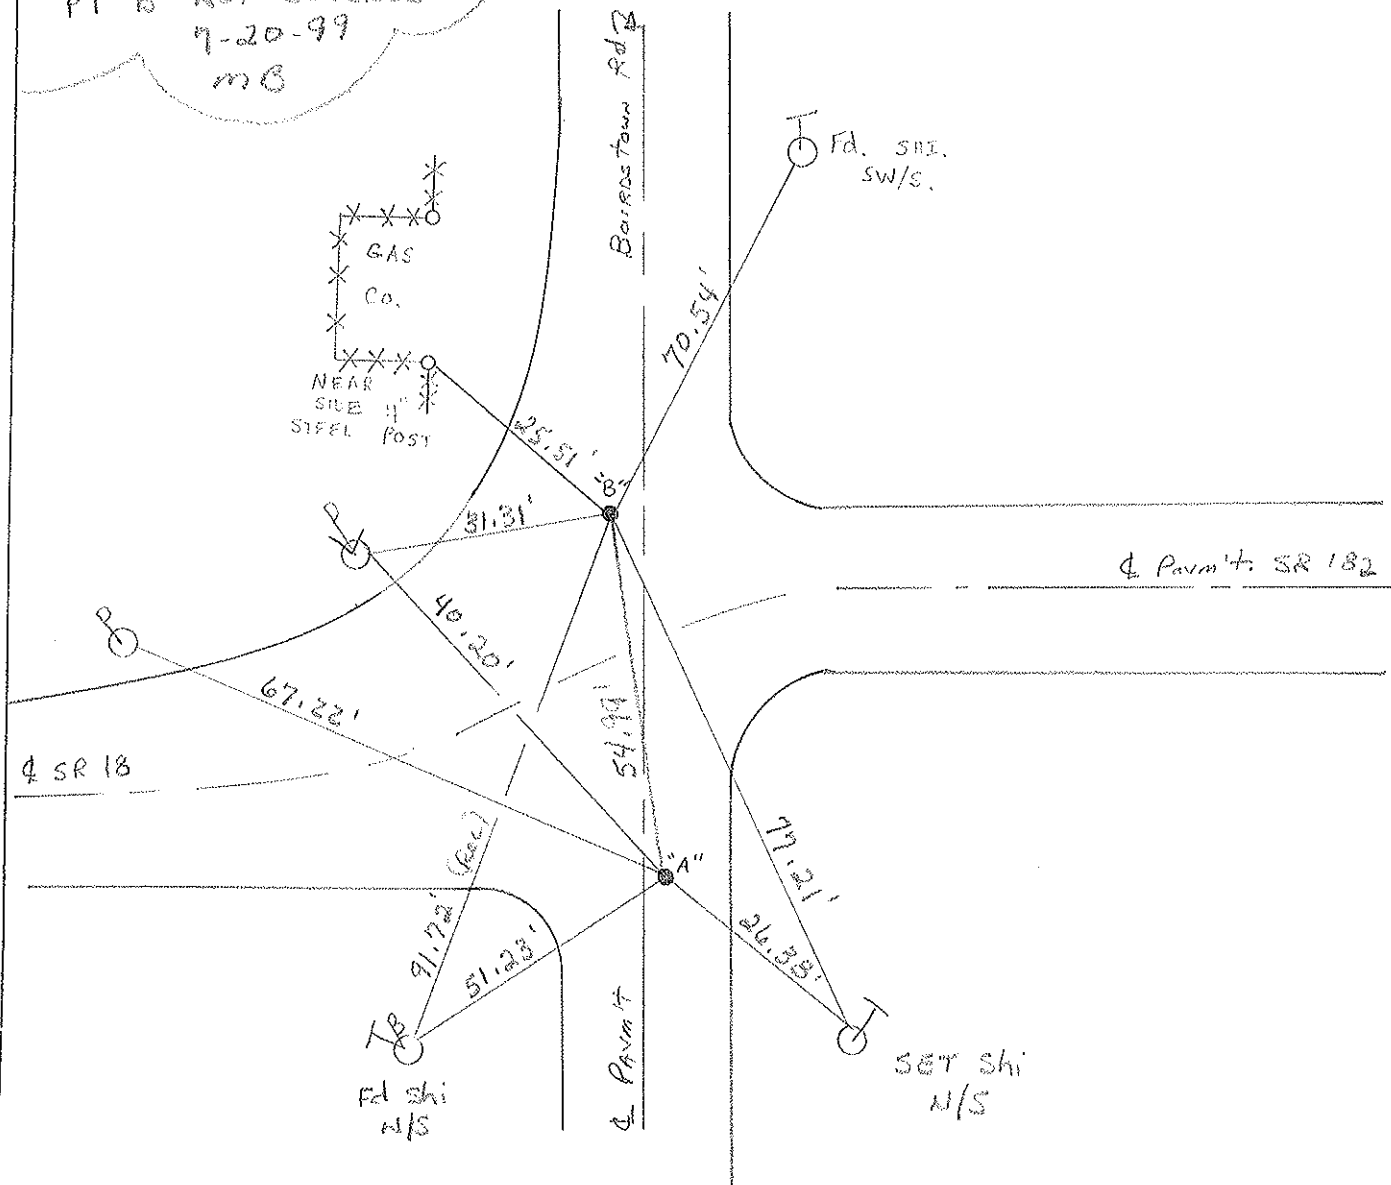

# O.D.O.T. DISTRICT 2 SURVEY OFFICE

PERSONNEL \_\_\_\_\_

REFERENCE NO. 34

SHEET \_\_\_\_\_ OF \_\_\_\_\_

NOTES Hoffman

H.C. BARWISER

DATE 5-13-86

ROUTE SR 18

R.C. PIETKOWSKI

WEATHER Cloudy

COUNTY Wood

TEMP. 65°

TOWNSHIP Bloom

SECTION 33

T. 3 N. R. 11 E

BOTH Points A & B


TYPE MONUMENT small RR spikes

ON SURFACE - BELOW 1"

LEFT - ~~C~~ PAVT - RIGHT A = 24' RT & B = 31' Lt.


TO EDGE PAVEMENT

S.L.M. 851+10

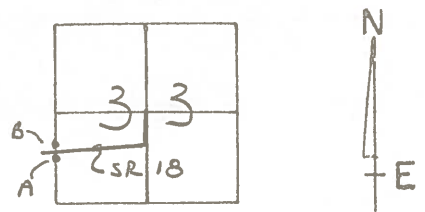

Pt. A  
Set P/K + washer  
6-17-86  
MJB

Pt "B" Not Covered

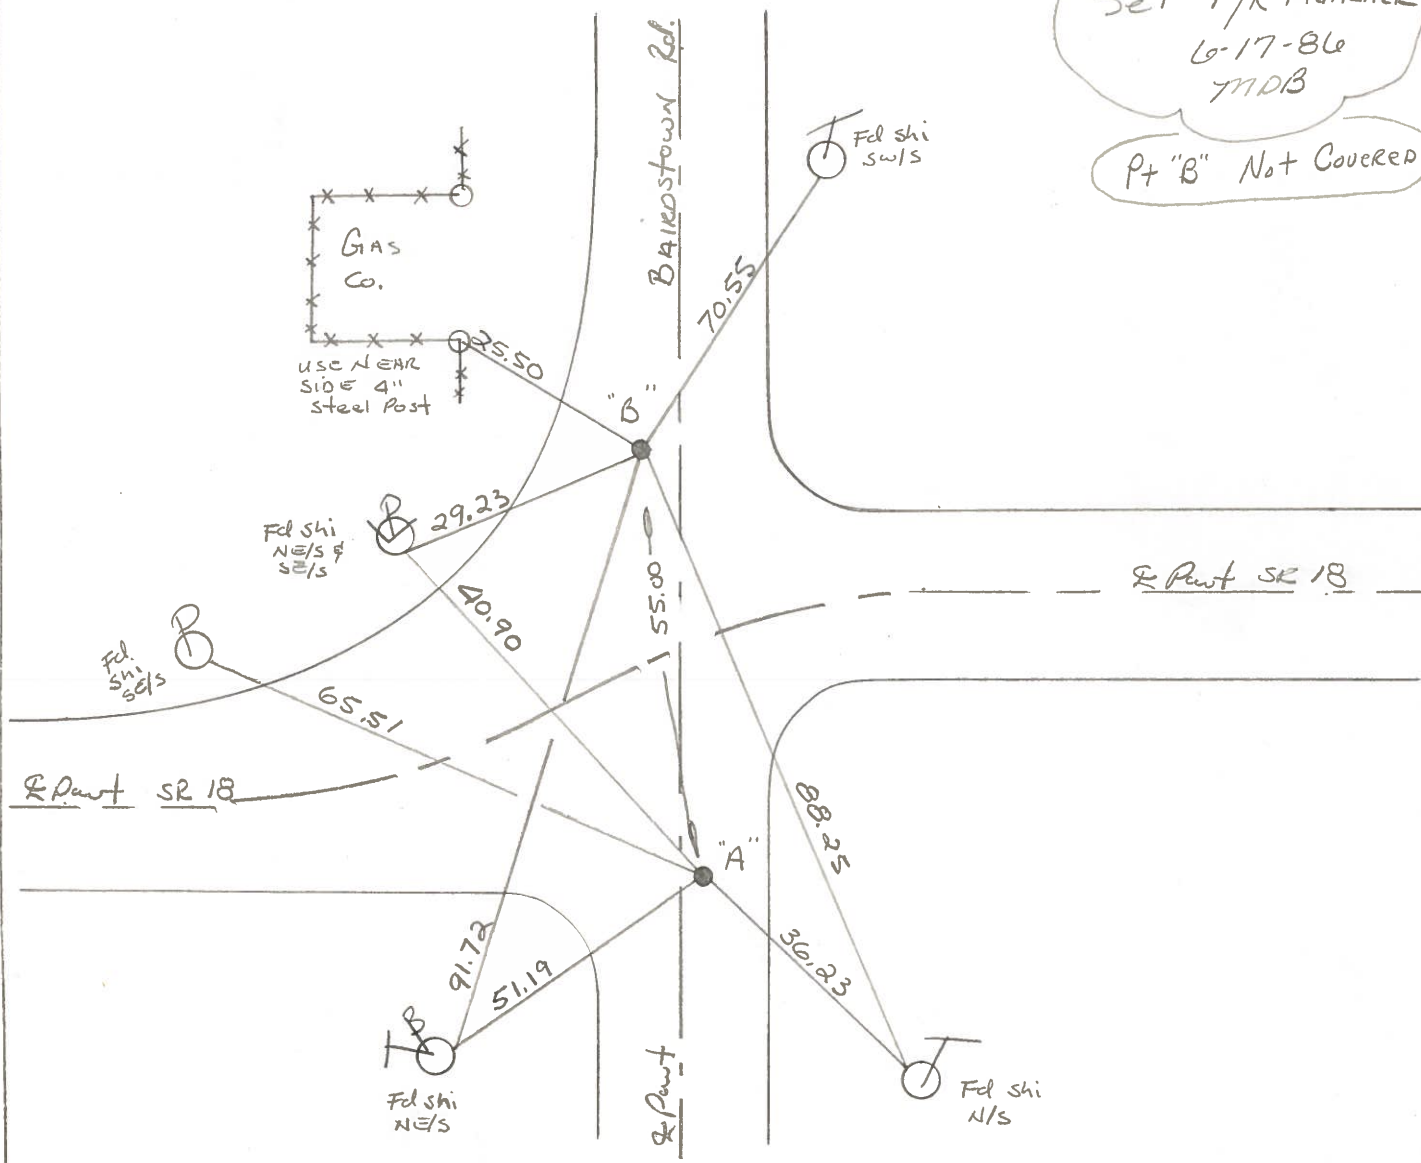

OD.O.T. DISTRICT 2 SURVEY OFFICE

Sht.      of       
S.R.18

County WOOD  
 Township BLOOM  
 Section 33  
 T3N, R1E  
 Personnel BURNSIDE  
SMITH  
BOWERS  
KNAPE  
MEAD

Date 6-2-78  
 Weather CLOUDY  
 Temp. +70°

