

O.D.O.T. DISTRICT 2 SURVEY OFFICE (USE ONLY)

PERSONNEL

REFERENCE NO. 34 A

SHEET 14 OF 35

NOTES HOMAN

DATE 8/25/14

ROUTE SR 18

H.C. LEU

WEATHER SUNNY

COUNTY WOOD

R.C. RHOADES

TEMP. 80°

TOWNSHIP BLOOM

SECTION 33

DWG BY MILLER PID 93417

T 3 N R 11 E

TYPE MONUMENT SM.R.R. SPIKE

~~ON SURFACE~~ - BELOW 0.5"

OFFSET \odot PAVEMENT 31.0' LT : ~~RT~~

- TO - EDGE PAVEMENT 2.0' W \odot OF PVMT N


STATION: 851+54.77

HORZ.DATUM: NAD83 (2011)


GEOID: 2012A

GRID: NORTHING: 550718.287

EASTING: 1662424.789

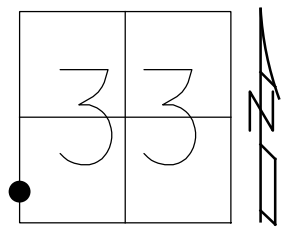

RECORD:
 FD SM.R.R. SPIKE
 6/16/99
 7/20/99, MB
 FD SM R.R. SPIKE
 REFA34
 8/25/14, DCH

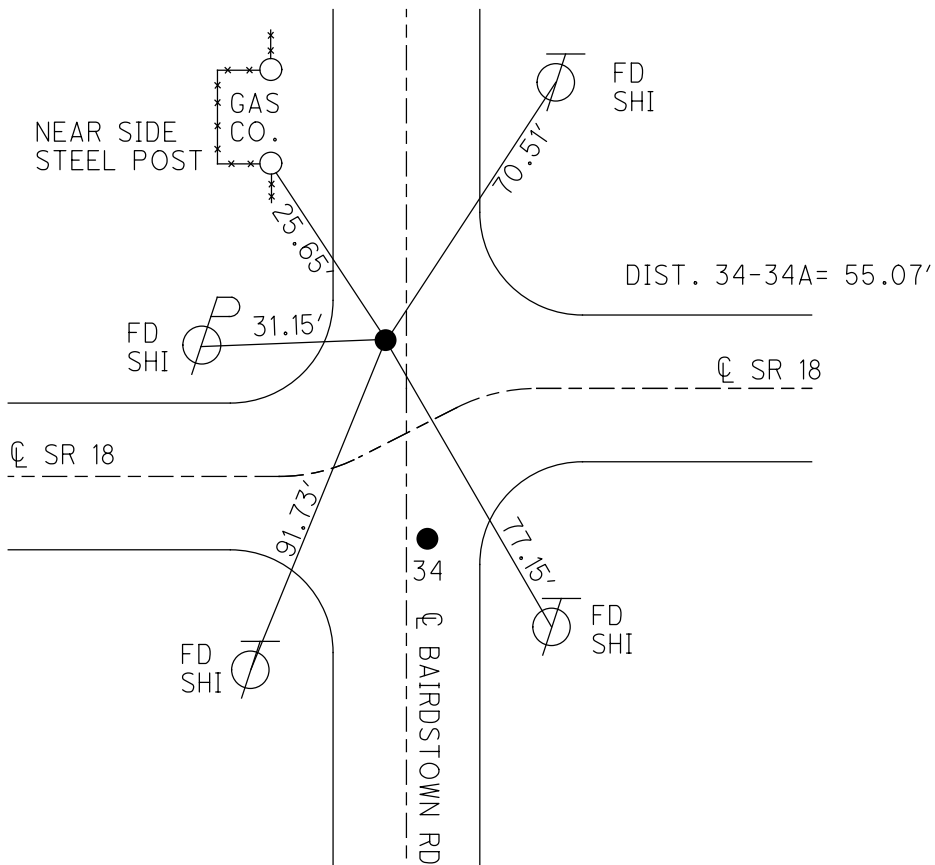

O.D.O.T. DISTRICT 2 SURVEY OFFICE

PERSONNEL _____

REFERENCE NO. 34

SHEET 8 OF 29

NOTES BAPPHISEL

H.C. CANTERBURY

DATE 6-16-99

ROUTE SR 18

R.C. Rousos III

WEATHER CLOUDY

COUNTY Wood

TEMP. +65°

TOWNSHIP Bloom

SECTION 33

T 3 N R 11 E


TYPE MONUMENT SMALL R.R. SPIKE
BORN POINTS A & B

ON SURFACE - BELOW 2" BELOW 2" BELOW


LEFT - PAV'T. - RIGHT A = 24' AT. & B = 31' AT.
2' E. PAV'T. & 2' W. PAV'T.

TO EDGE PAVEMENT

S.L.M. 851+10 851+61

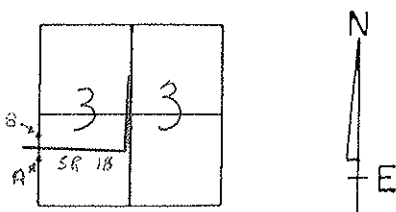

Reset PK/WASHER PT "A"
 PT "B" NOT COVERED
 7-20-99
 MB

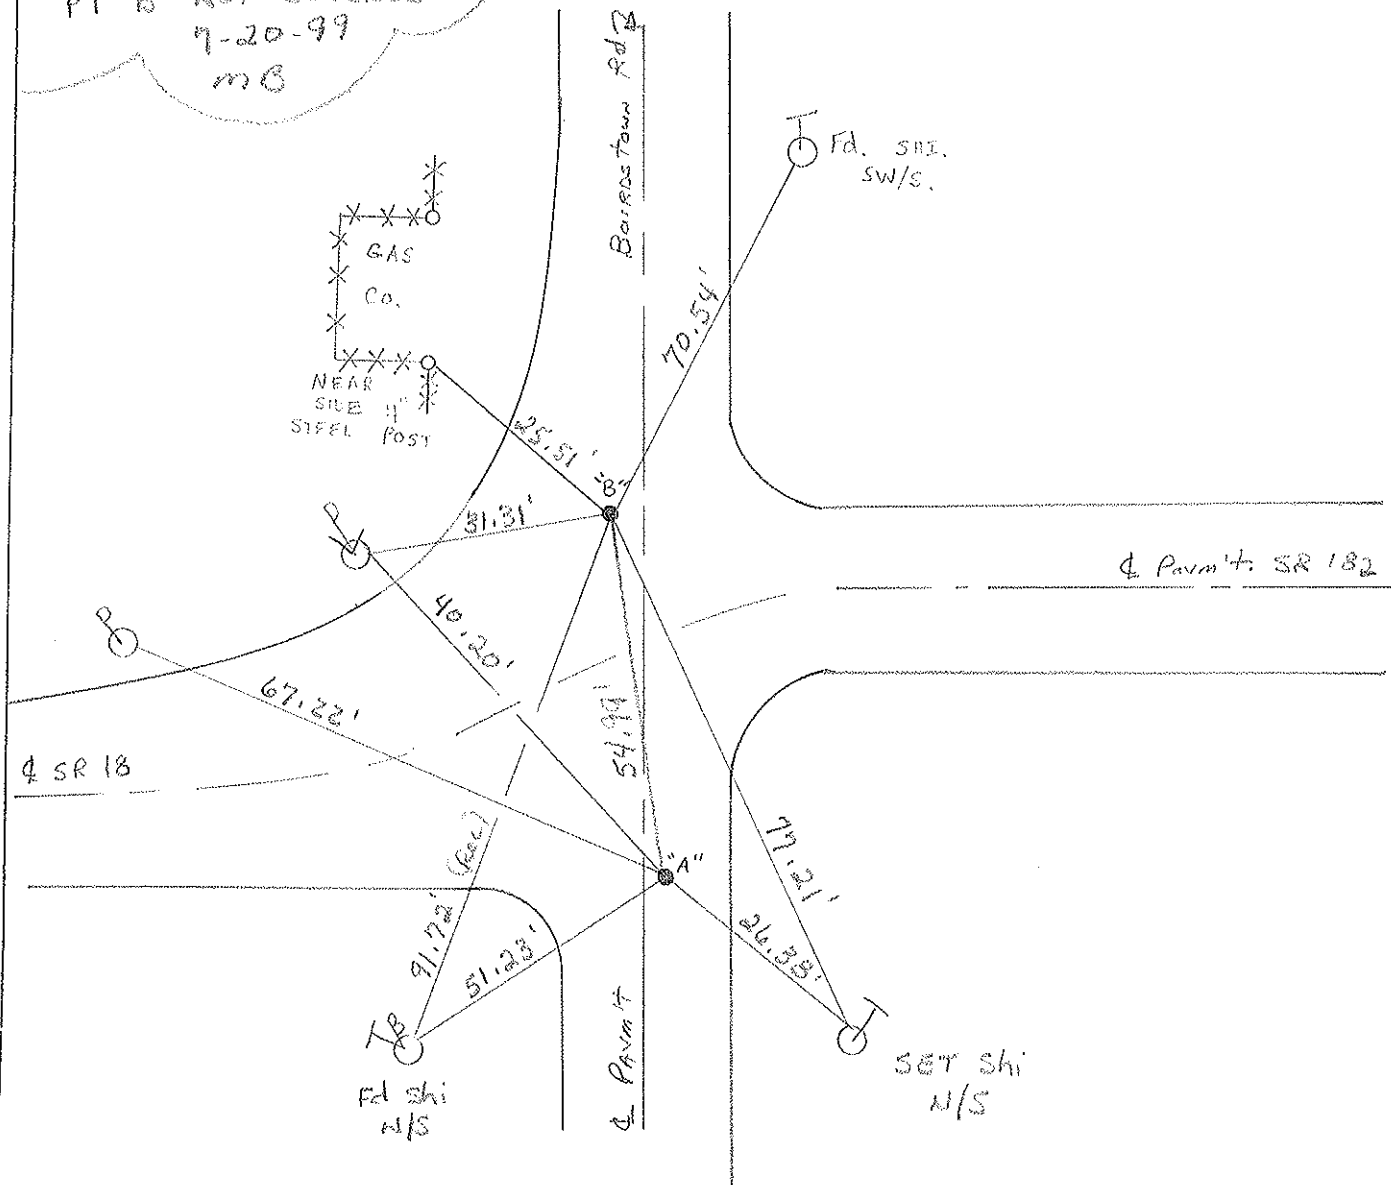

O.D.O.T. DISTRICT 2 SURVEY OFFICE

PERSONNEL _____

REFERENCE NO. 34

SHEET _____ OF _____

NOTES Hoffman

H.C. BARWISER

DATE 5-13-86

ROUTE SR 18

R.C. PIETKOWSKI

WEATHER Cloudy

COUNTY Wood

TEMP. 65°

TOWNSHIP Bloom

SECTION 33

T. 3 N. R. 11 E

BOTH Points A & B


TYPE MONUMENT small RR spikes

ON SURFACE - BELOW 1"

LEFT - ~~C~~ PAVT - RIGHT A = 24' RT & B = 31' Lt.


TO EDGE PAVEMENT

S.L.M. 851+10

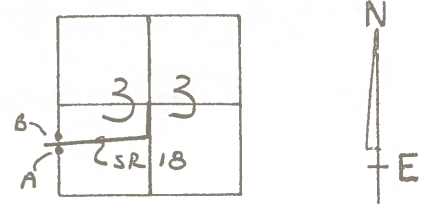

Pt. A
Set P/K + washer
6-17-86
MJB

Pt "B" Not Covered

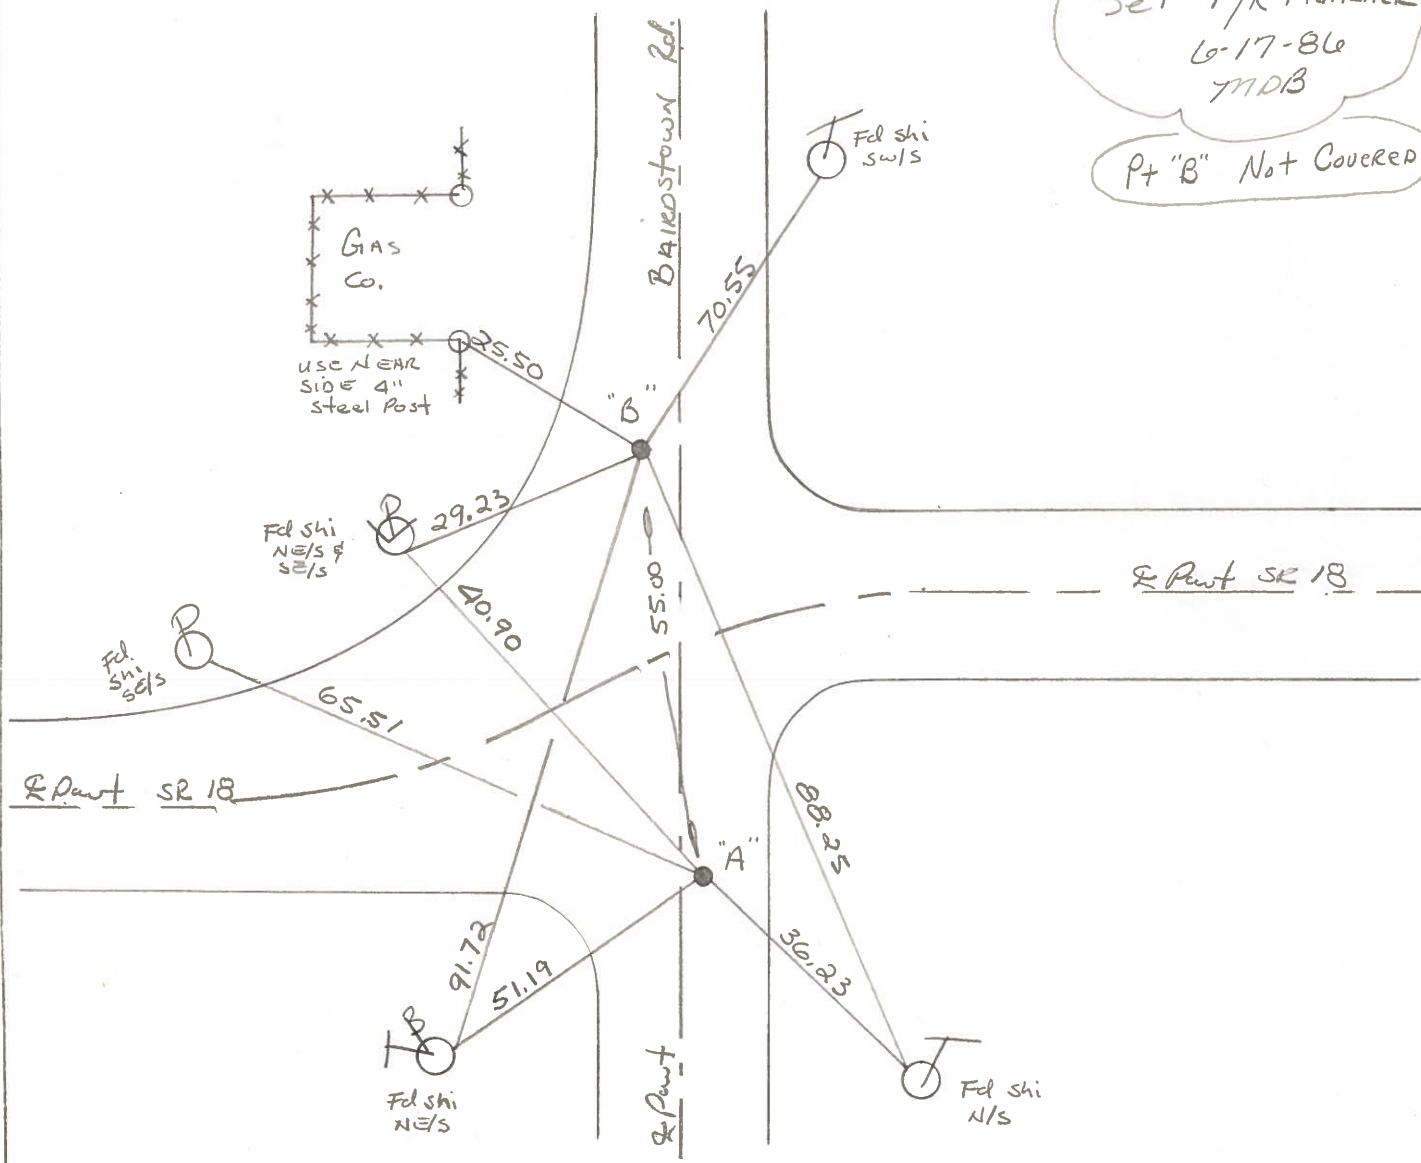

OD.O.T. DISTRICT 2 SURVEY OFFICE

Sht. ___ of ___
S.R.18

County WOOD

Date 6-2-78

Township BLOOM

Weather CLOUDY

Section 33

Temp. +70°

T3N, R1E

Personnel BURNSIDE

- SMITH
- BOWERS
- KNAPE
- MEAD

