

O.D.O.T. DISTRICT 2 SURVEY OFFICE (USE ONLY)

PERSONNEL

REFERENCE NO. 34 B

SHEET 15 OF 35

NOTES HOMAN

DATE 8/25/14

ROUTE SR 18

H.C. LEU

WEATHER SUNNY

COUNTY WOOD

R.C. RHOADES

TEMP. 85°

TOWNSHIP BLOOM

DWG BY MILLER PID 93417

SECTION 33

T 3 N R 11 E

TYPE MONUMENT P.K.

ON SURFACE - ~~BELOW~~ ON

OFFSET ϕ PAVEMENT ON LT : RT

10.0' TO RT EDGE PAVEMENT


STATION: 859+06.61

HORZ.DATUM: NAD83 (2011)


GEOID: 2012A

GRID: NORTHING: 550688.446

EASTING: 1663176.039

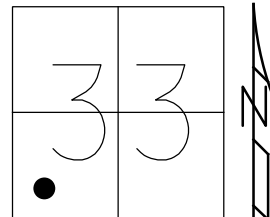

RECORD:
 FD P.K./SHI
 6/16/99, MB
 SET P.K./WASHER
 7/20/99, MB
 SET P.K./WASHER
 9/20/99, MB
 FD P.K. SHANK
 REFB34
 8/25/14, DCH
 SET MAG/WASHER
 11/05/14, DCH

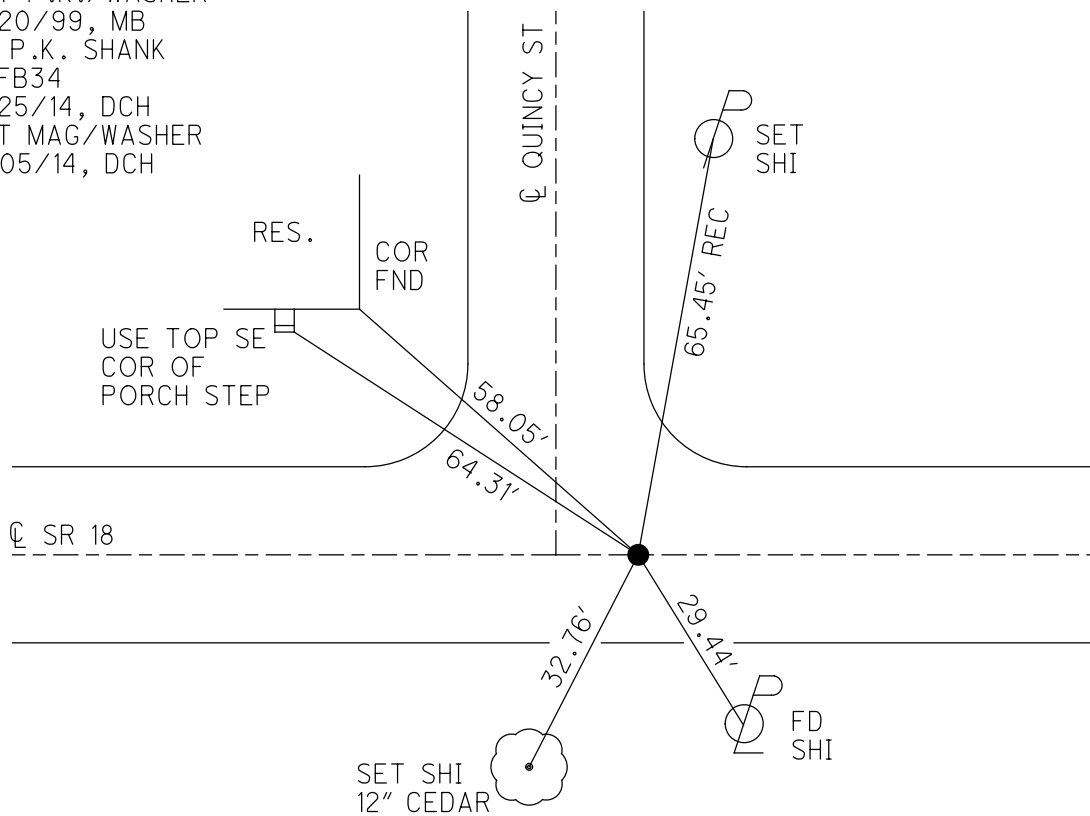

O.D.O.T. DISTRICT 2 SURVEY OFFICE

PERSONNEL _____

REFERENCE NO. _____

SHEET 9 OF 29

NOTES Bacchisel

H.C. Canterbury

R.C. Rowe III

DATE 6-16-99

WEATHER Cloudy

TEMP. 65°

ROUTE SR 18

COUNTY Wood

TOWNSHIP Bloom

SECTION 33

T. 3 / R. 11 E


TYPE MONUMENT P.K. & Shiner

ON SURFACE - BELOW ON

LEFT - ~~C~~ PAV'T. - RIGHT YES


10.0 TO RT EDGE PAVEMENT

S.L.M. 858+66

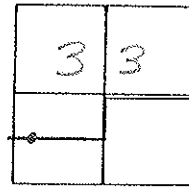

Reset PK WASHBURN
9-20-99
MB

SET PK
720-99

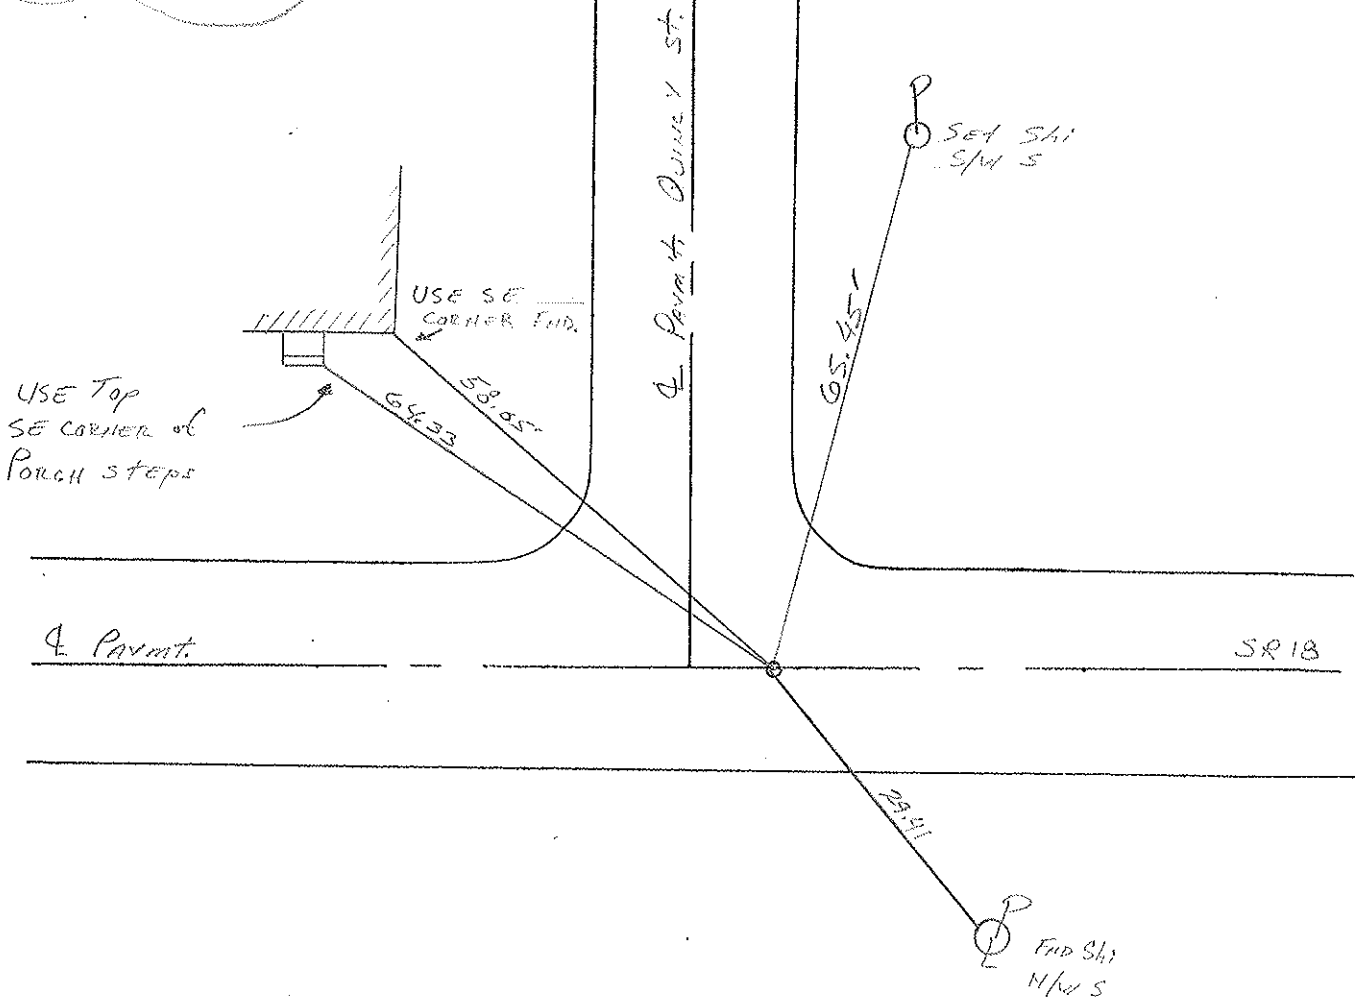

O.D.O.T. DISTRICT 2 SURVEY OFFICE

PERSONNEL _____

REFERENCE NO. 34A

SHEET _____ OF _____

NOTES Hoffman

H.C. BARNHISEL

DATE 5-13-86

ROUTE SR 18

R.C. PIETRYKOWSKI

WEATHER P. Cloudy

COUNTY WOOD

TEMP. 65°

TOWNSHIP Bloom

SECTION 33

T3 N R 11 E

TYPE MONUMENT P.K. nail BY OTHERS

ON SURFACE - ~~BELOW~~ yes

~~LEFT - & PAV'T. - RIGHT~~ yes

9.3' TO RT. EDGE PAVEMENT

S.L.M. 858+66

