

O.D.O.T. DISTRICT 2 SURVEY OFFICE (USE ONLY)

PERSONNEL

REFERENCE NO. 40

SHEET 26 OF 36

NOTES ASTON

DATE 8/10/23

ROUTE SR 18

H.C. NIESE

WEATHER CLOUDY

COUNTY WOOD

R.C. AUBLE

TEMP. 74°

TOWNSHIP BLOOM

SECTION 35

DWG BY RHOADES

PID 95796

T 3 N R 11 E

TYPE MONUMENT MAG/WASHER

ON SURFACE - ~~BELOW~~ ON

OFFSET ☉ PAVEMENT 0.5' LT : ~~RT~~

- TO - EDGE PAVEMENT


STATION: 1000+17.32

HORZ.DATUM: NAD83 (2011)

GEOID: NAVD88 2018


GRID: NORTHING: 550456.154

EASTING: 1676404.786

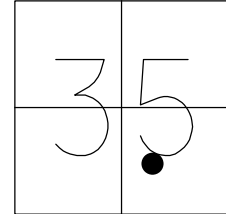

RECORD:
 FD P.K./WASHER
 6/8/99, MB
 SET P.K./WASHER
 7/20/99, TR
 FD P.K./WASHER
 REF40
 8/26/14, DCH
 FD P.K.SHANK
 3" DOWN
 4/12/22, TDN
 SET MAG/WASHER
 8-10-23, TDN

WOOD LDP:
 N: 372615.287
 E: 188531.165

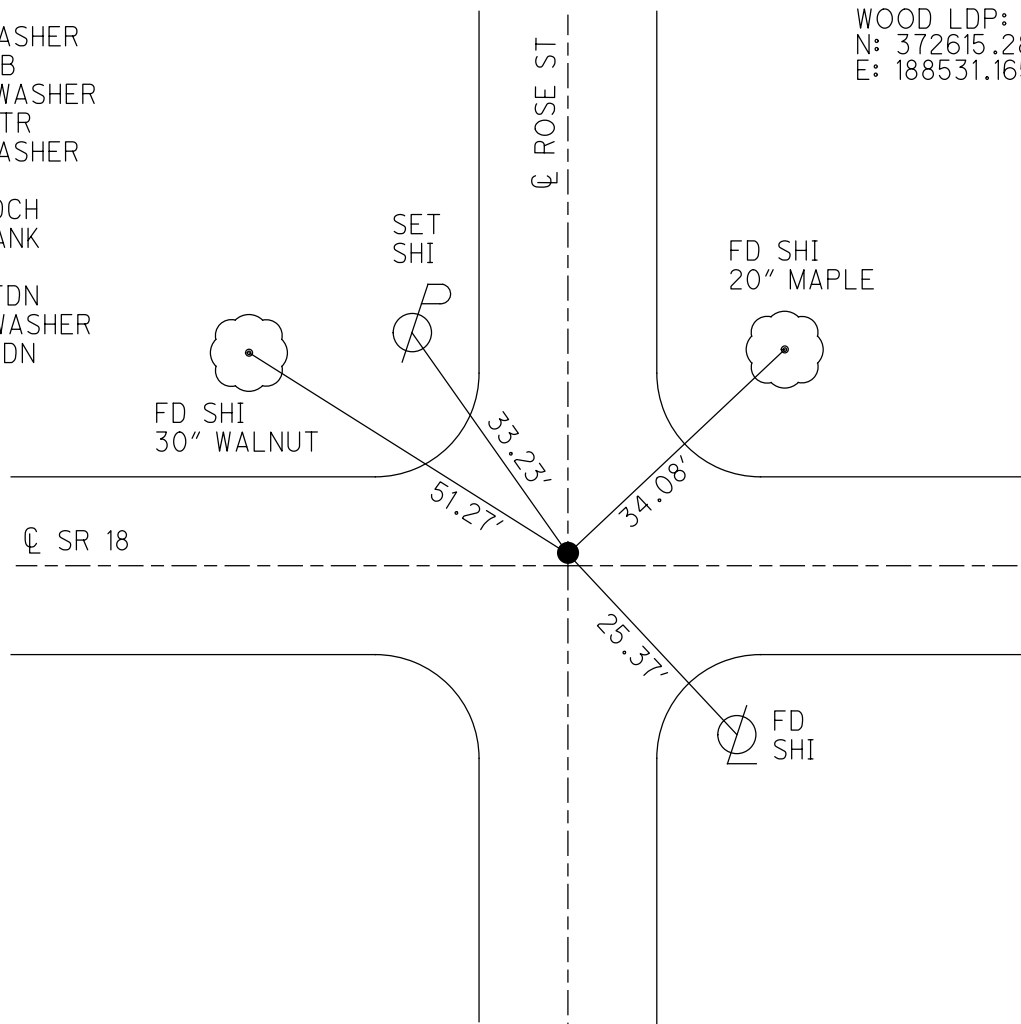

O.D.O.T. DISTRICT 2 SURVEY OFFICE (USE ONLY)

PERSONNEL

REFERENCE NO. 40

SHEET 26 OF 35

NOTES HOMAN

DATE 8/26/14

ROUTE SR 18

H.C. LEU

WEATHER SUNNY

COUNTY WOOD

R.C. HOMAN

TEMP. 80°

TOWNSHIP BLOOM

SECTION 35

DWG BY MILLER

PID 93417

T 3 N R 11 E

TYPE MONUMENT P.K./WASHER

ON SURFACE - ~~BELOW~~ ON

OFFSET C PAVEMENT 0.5' LT : ~~RT~~

- TO - EDGE PAVEMENT


STATION: 1000+17.32

HORZ.DATUM: NAD83 (2011)


GEOID: 2012A

GRID: NORTHING: 550456.185

EASTING: 1676404.647

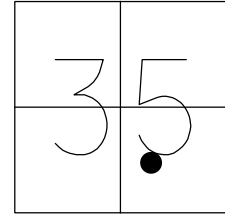

RECORD:
 FD P.K./WASHER
 6/8/99, MB
 SET P.K./WASHER
 7/20/99, TR
 FD P.K./WASHER
 REF40
 8/26/14, DCH

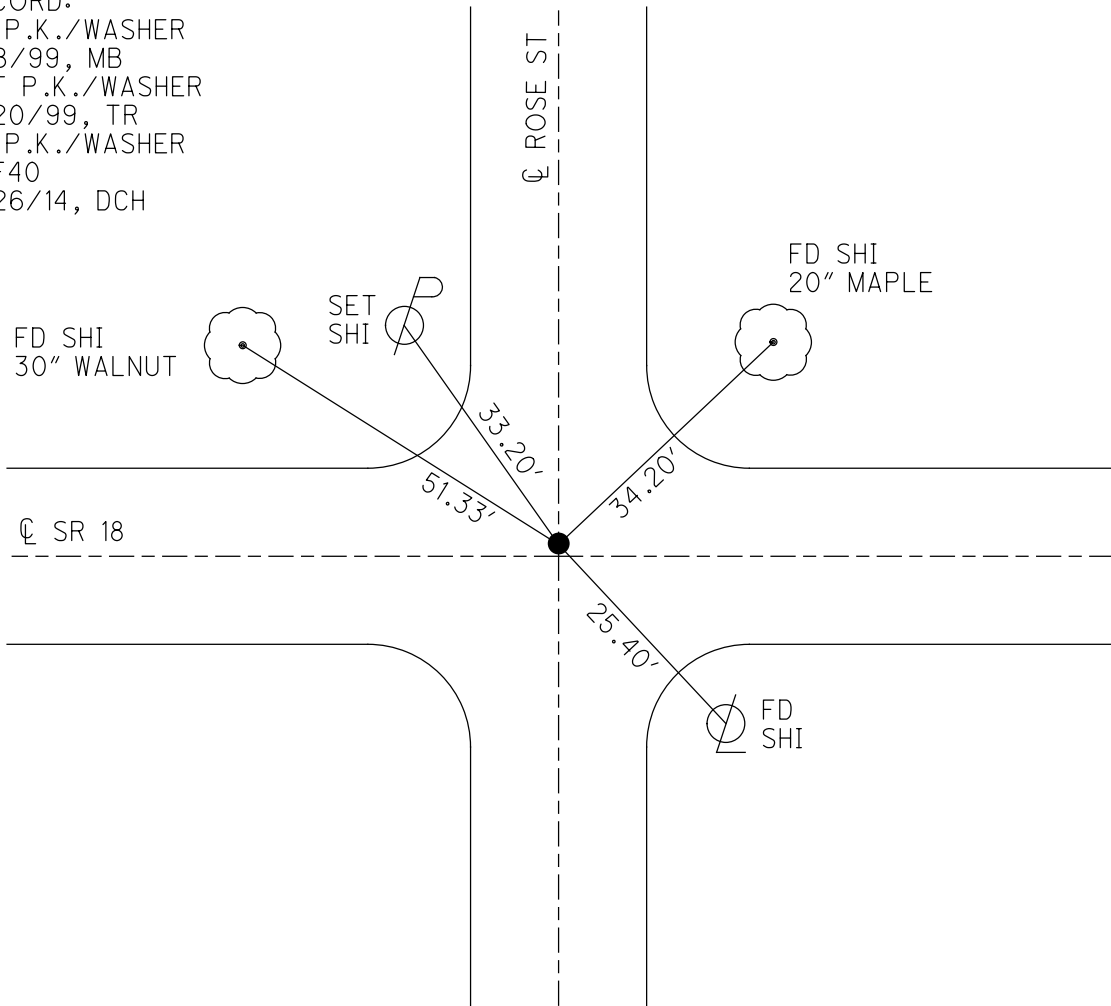

O.D.O.T. DISTRICT 2 SURVEY OFFICE

PERSONNEL _____

REFERENCE NO. 40

SHEET 20 OF 29

NOTES Barnhisal

H.C. Canterbury

R.C. Rouses III

DATE 6-8-99

WEATHER Sunny

TEMP. +90°

ROUTE SR 18

COUNTY Wood

TOWNSHIP Bloom

SECTION 25

T3 NR 1 E



TYPE MONUMENT PK & Washer

ON SURFACE - BELOW Surface

LEFT - ♀ PAV'T. - RIGHT 0.5 ft

- TO - EDGE PAVEMENT on ♀ ST. NORTH

S.L.M. 1000-102

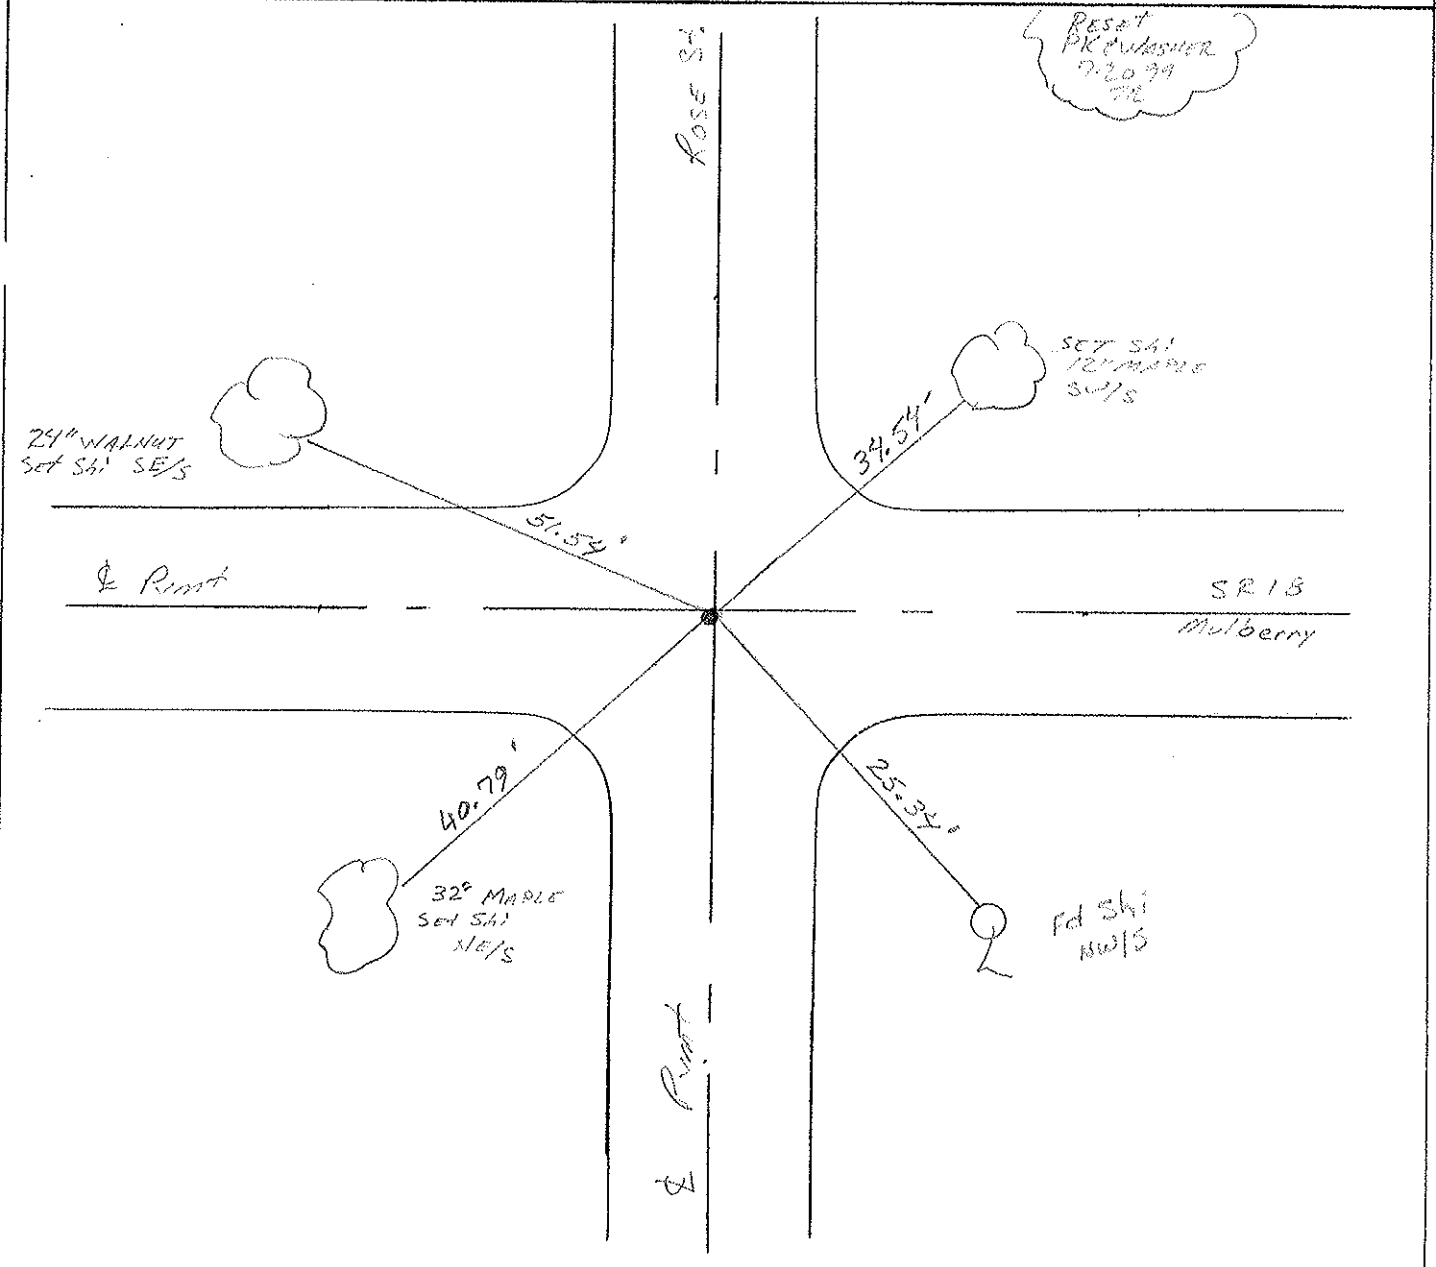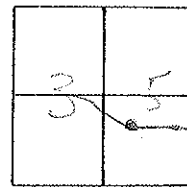

O.D.O.T. DISTRICT 2 SURVEY OFFICE

PERSONNEL _____

REFERENCE NO. 40

SHEET _____ OF _____

NOTES Hoffman

H.C. BARWHEEL

DATE 5-14-86

ROUTE SR 18

R.C. LOEHRKE

WEATHER Cloudy

COUNTY WOOD

TEMP. 65°

TOWNSHIP Bloom

SECTION 35

T.3 N R.11 E

TYPE MONUMENT P.K. Nail BY OTHERS

ON SURFACE - ~~BELOW~~ yes

~~LEFT- & PAV'T.~~ RIGHT yes

TO EDGE PAVEMENT

S.L.M. 999 + 54

