



O.D.O.T. DISTRICT 2 SURVEY OFFICE (USE ONLY)

PERSONNEL \_\_\_\_\_ REFERENCE NO. 40 D SHEET 30 OF 36  
 NOTES ASTON DATE 8/10/23 ROUTE SR 18  
 H.C. NIESE WEATHER CLOUDY COUNTY WOOD  
 R.C. AUBLE TEMP. 74° TOWNSHIP BLOOM  
 DWG BY RHOADES PID 95796 SECTION 35  
 T 3 N R 11 E

TYPE MONUMENT P.K./WASHER  
 ON SURFACE - ~~BELOW~~ ON  
 OFFSET ☉ PAVEMENT 0.25' ~~LT~~ : RT  
- TO - EDGE PAVEMENT  
 STATION: 1014+96.77

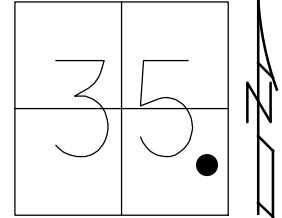

HORZ.DATUM: NAD83 (2011) GEOID: NAVD88 2018  
 GRID: NORTHING: 550414.236 EASTING: 1677883.516

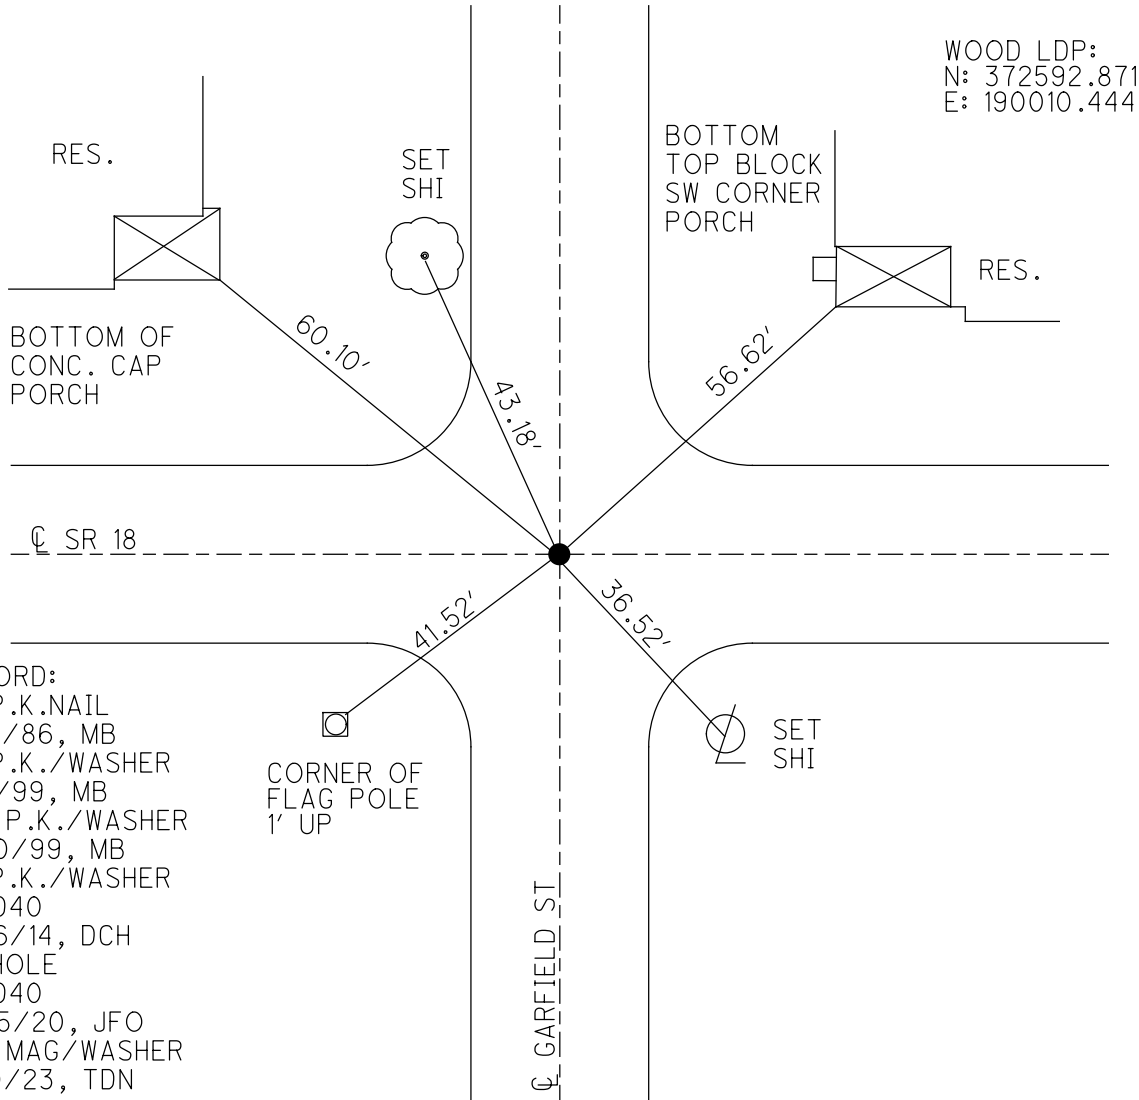

RECORD:  
 FD P.K.NAIL  
 5/14/86, MB  
 FD P.K./WASHER  
 6/8/99, MB  
 SET P.K./WASHER  
 7/20/99, MB  
 FD P.K./WASHER  
 REFD40  
 8/26/14, DCH  
 FD HOLE  
 REFD40  
 11/05/20, JFO  
 SET MAG/WASHER  
 8/10/23, TDN

O.D.O.T. DISTRICT 2 SURVEY OFFICE (USE ONLY)

PERSONNEL \_\_\_\_\_

REFERENCE NO. 40 D

SHEET 30 OF 35

NOTES BARNHISEL

DATE 6/8/99

ROUTE SR 18

H.C. CANTERBURY

WEATHER SUNNY

COUNTY WOOD

R.C. ROUSES

TEMP. 90°

TOWNSHIP BLOOM

SECTION 35

DWG BY RHOADES PID 93417

T 3 N R 11 E

TYPE MONUMENT P.K./WASHER

ON SURFACE - ~~BELOW~~ ON

OFFSET 0 PAVEMENT - LT : RT

- TO - EDGE PAVEMENT



STATION: 1014+96.77

HORIZ.DATUM: NAD83 (2011)

GEOID: 2012A

GRID: NORTHING: 550414.278

EASTING: 1677883.509

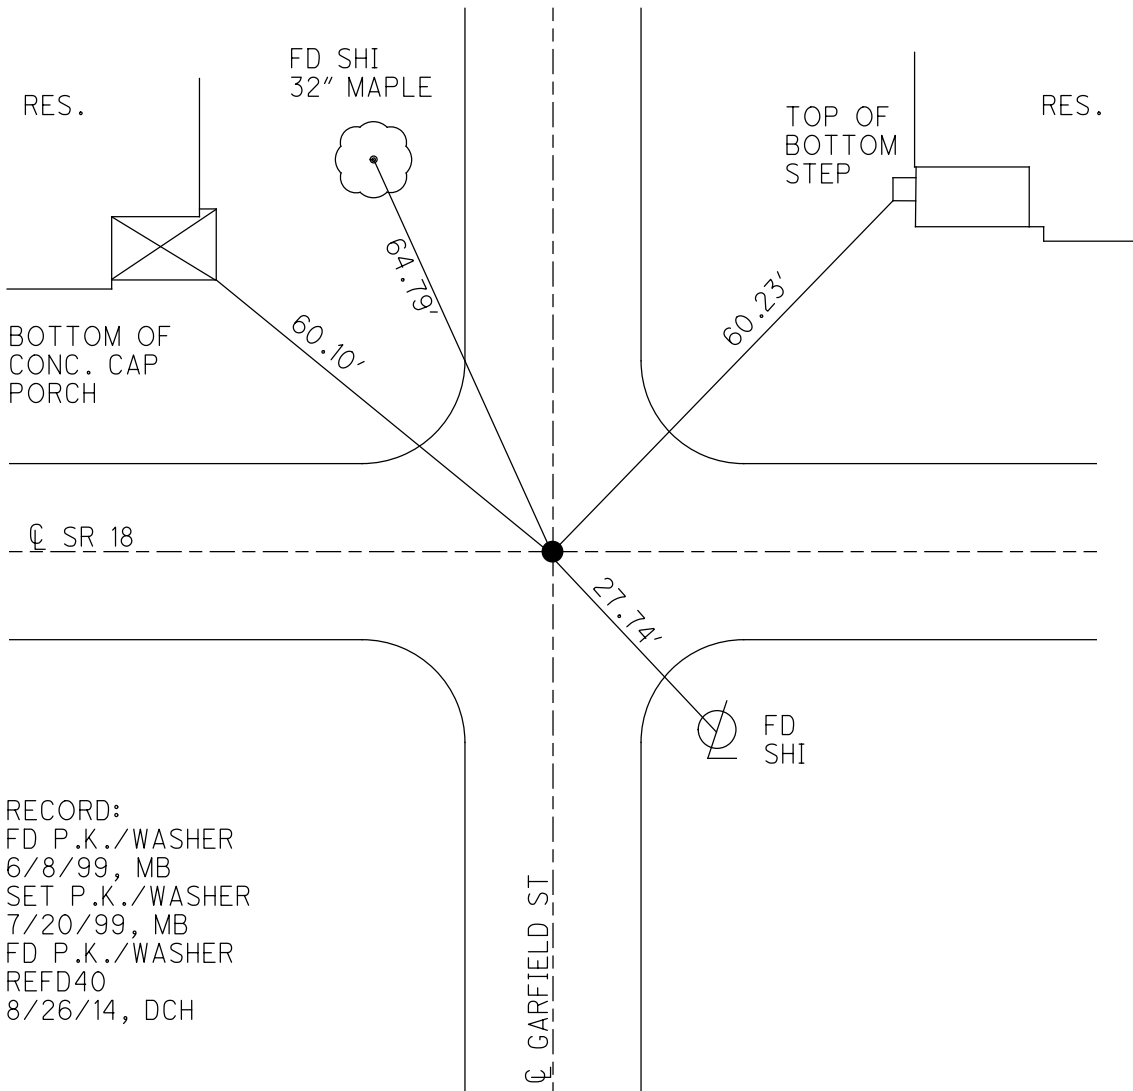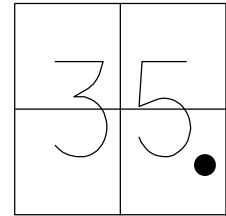

RECORD:  
 FD P.K./WASHER  
 6/8/99, MB  
 SET P.K./WASHER  
 7/20/99, MB  
 FD P.K./WASHER  
 REFD40  
 8/26/14, DCH

# O.D.O.T. DISTRICT 2 SURVEY OFFICE

PERSONNEL \_\_\_\_\_

REFERENCE NO. 40-D

SHEET 24 OF 29

NOTES Bornhiser

H.C. Cantonbury

R.C. Rousar

DATE 6-8-99

WEATHER Sunny

TEMP. 70°

ROUTE SR18

COUNTY Wood

TOWNSHIP Bloom

SECTION 35

T3 N R 11 E



TYPE MONUMENT P.K. & WASHER

ON SURFACE - BELOW Surface

LEFT - ☉ PAV'T. - RIGHT \_\_\_\_\_

TO \_\_\_\_\_ EDGE PAVEMENT

S.L.M. 10/4481 of 2S

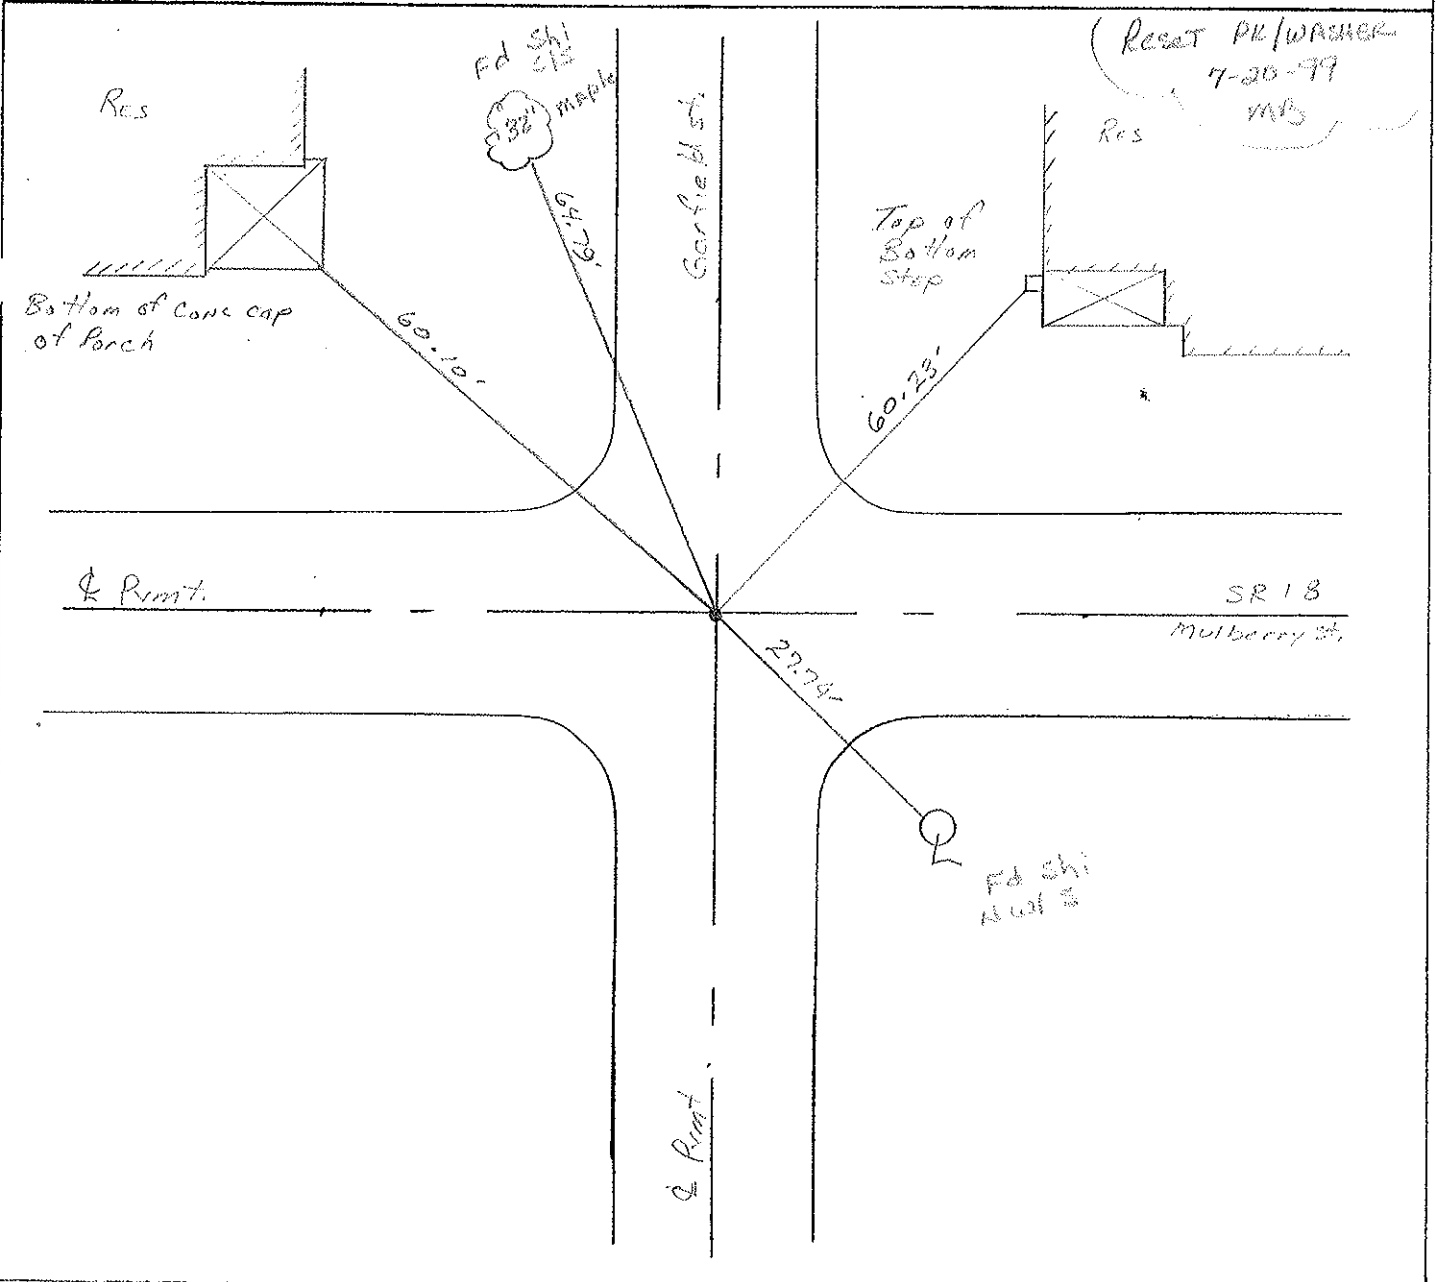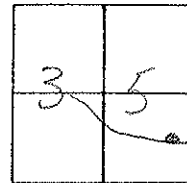

# O.D.O.T. DISTRICT 2 SURVEY OFFICE

PERSONNEL

REFERENCE NO. 40-D

SHEET      OF     

NOTES Hoffman

H.C. BARNHISEL

DATE 5-14-86

ROUTE SR 18

R.C. LOEHRKE

WEATHER Lt. Rain

COUNTY WOOD

TEMP. 70°

TOWNSHIP Bloom

SECTION 35

T 3 N 11 E



TYPE MONUMENT P.K. Nail BY OTHERS

ON SURFACE - BELOW 1"

LEFT - ~~C~~ PAV'T. - ~~RIGHT~~ yes

TO      EDGE PAVEMENT

S.L.M. 10 14 + 33

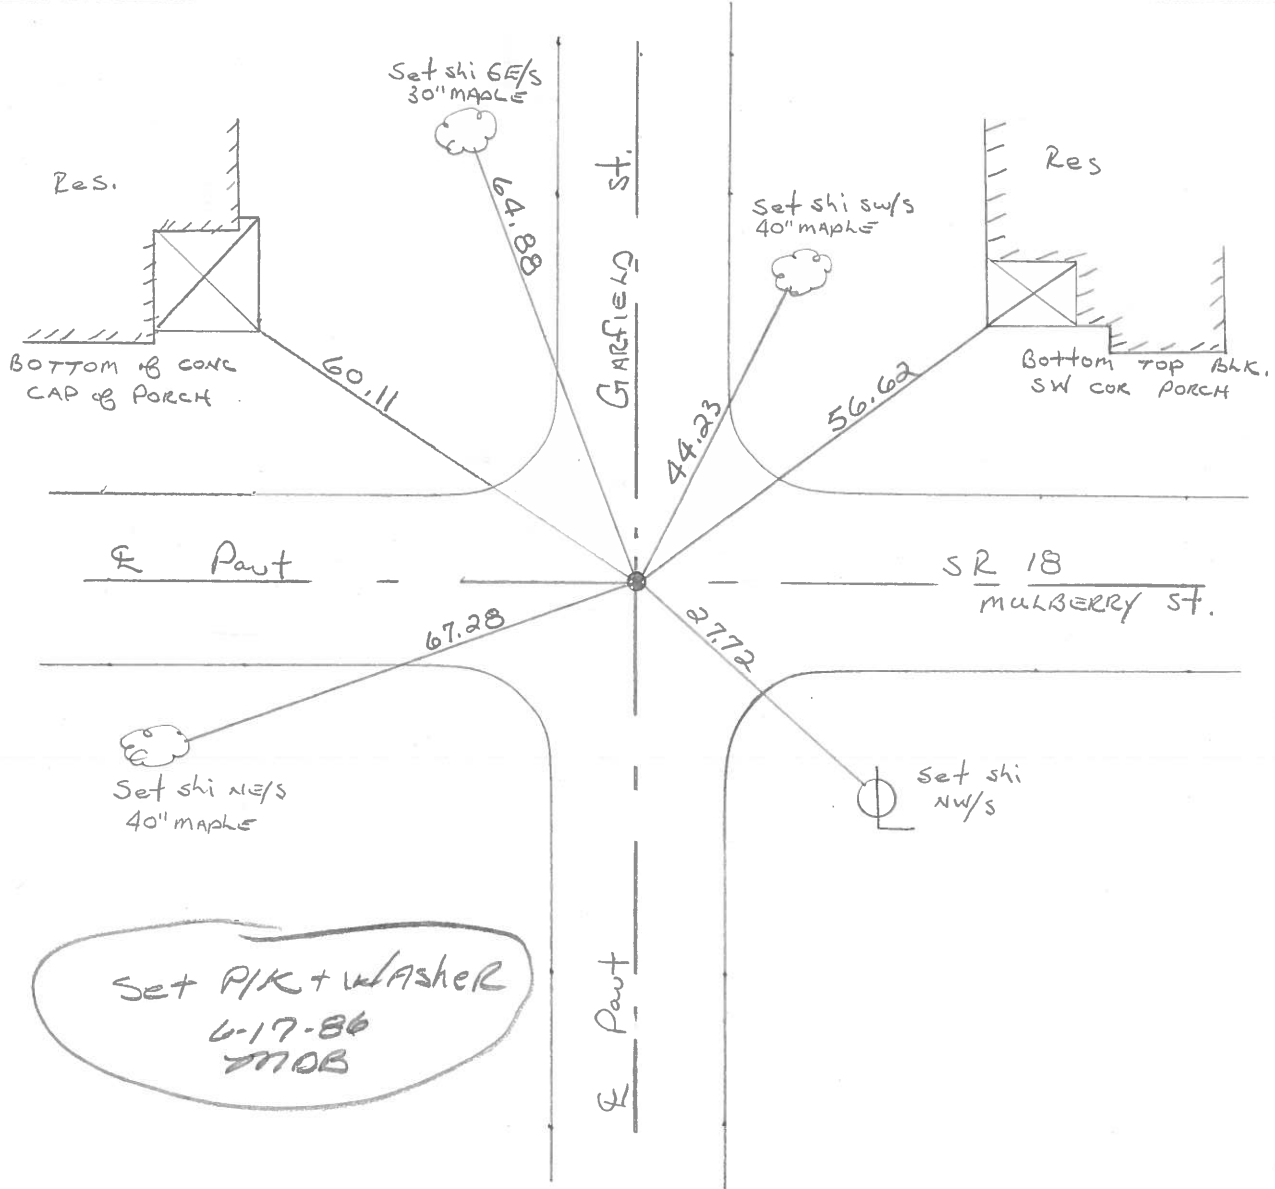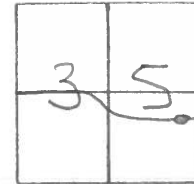

Set P/K + washer  
 6-17-86  
 MOB