

ODET (D-2)

To OPERATION 11-30-88
1990 TWO-LANE RESURFACING PROGRAM

PRIORITY NO. _____ PART 1 OF 2 SHEET _____ OF _____
COUNTY WOOD ROUTE USR 20 SECTION ~~1.14~~ 1.14
BEGIN LOG (SLM) 1.14 TERMINII SR 65 60+19.20 = (C&M) (B&H)
END LOG (SLM) 1.40 TERMINII SR 199 73+92 = C 73+73 = (M)
TOTAL LENGTH 0.26 MILES
MUNICIPALITY Perrysburg BEGIN LOG (SLM) 1.14 END LOG (SLM) 1.40
MUNICIPALITY _____ BEGIN LOG (SLM) _____ END LOG (SLM) _____
PROPOSED WORK:
PAVEMENT 1 1/2" 404 SHOULDER Curb
OTHER Mill 1 1/2"

EXISTING DATA:

SLM	TO	PAV'T	WIDTH	(type)	SHLD	WIDTH	(type)
SLM	TO	PAV'T	WIDTH	(type)	SHLD	WIDTH	(type)
STRUCTURES:

STR. NO.	<u>None</u>	WIDTH	LENGTH	PROP. WORK
STR. NO.		WIDTH	LENGTH	PROP. WORK
STR. NO.		WIDTH	LENGTH	PROP. WORK
RAILROAD CROSSING: (no work)

NAME <u>Chessie</u>	STATION <u>69+09</u>	NO. TRACKS <u>1</u>	LENGTH ALONG C L <u>5'</u> ft
NAME	STATION	NO. TRACKS	LENGTH ALONG C L ft
NAME	STATION	NO. TRACKS	LENGTH ALONG C L ft

MISCELLANEOUS:

NO. RAISED PAVEMENT MARKERS; EDGE OF PAVEMENT None, CENTERLINE None
NO. MAILBOX APPROACHES None, MAILBOX SUPPORTS None

REMARKS:

PERSONNEL

TITLE

PERSONNEL

TITLE

COUNTY WoodDATE 29 Nov. 88S. R. 15#20WEATHER ColdSEC. 1.14 - 1.40TEMP. 31°

DESCRIPTION


Pavement Widths

JOB NO.

LEFT

CENTER LINE

RIGHT

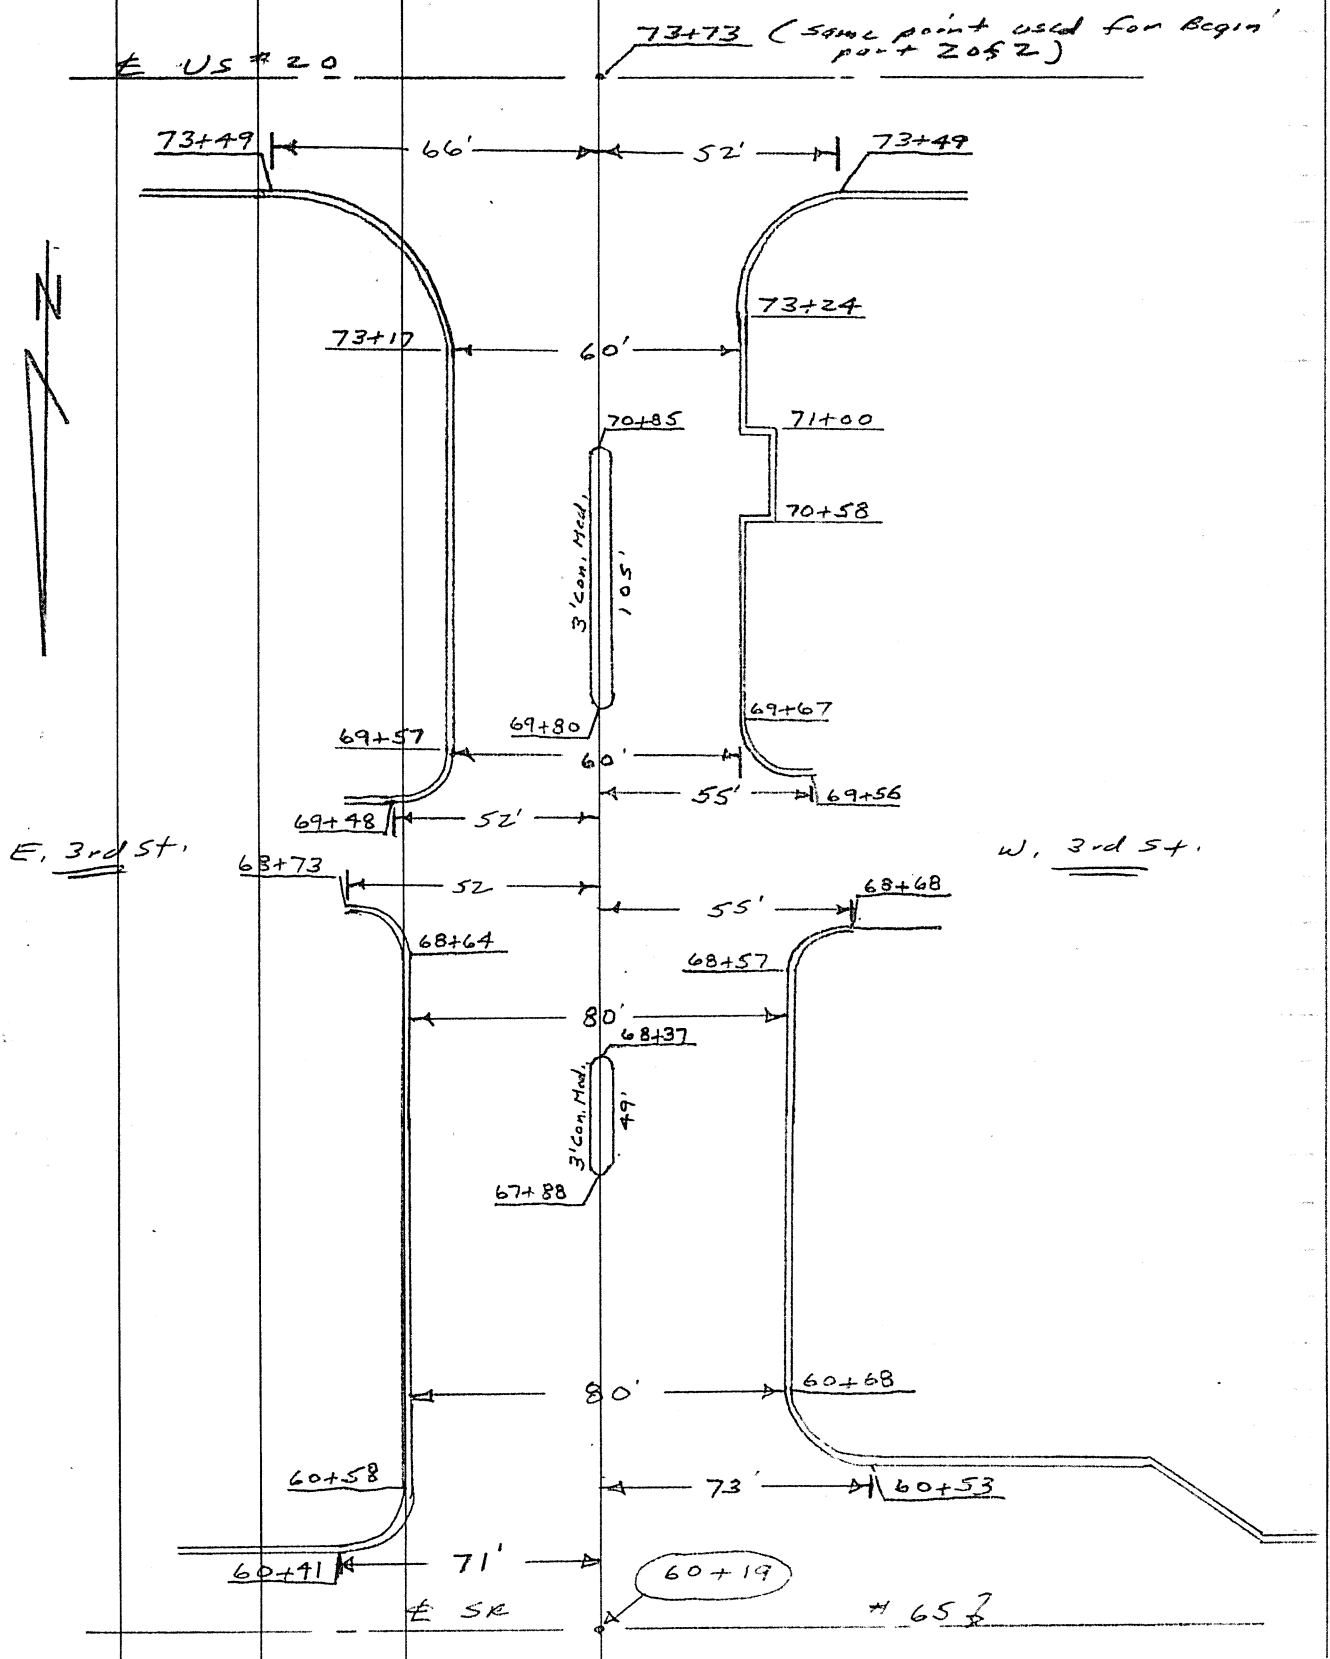

APPROACHES (INTERSECTIONS & DRIVES)

COUNTY Wood

ROUTE 05 #20

SECTION 1.14 - 1.40

L = Prop Pav't Depth (in.) x 10; W = Width @ Mouth; W-1 = Width @ Throat

[illegible]

UTILITIES (Catch Basin, Manhole, Inlet, Watervalue Box and Monument Box)

COUNTY Wood

ROUTE US # 20

SECTION 1.14-1.40

R = Raise F = Feather

[illegible]