

ODOT (D-2) Notes to: B. Rosebrook 11-8-93 1994 1996 1994 TWO-LANE RESURFACING PROGRAM
 DATE 11-8-93 PERSONNEL Loenake CANTERBURY

PRIORITY NO. 21 PART 2 OF 2 SHEET 1 OF 18
 COUNTY WOOD ROUTE US 20 SECTION 10.24
 BEGIN LOG (SLM) 10.24 Const. Joint
 END LOG (SLM) 14.01 Sandusky Co Line
 TOTAL LENGTH 3.77 MILES
 MUNICIPALITY BEGIN LOG (SLM) END LOG (SLM)
 MUNICIPALITY BEGIN LOG (SLM) END LOG (SLM)
 PROPOSED WORK: Repair any bad pavement joints & Resurface
 PAVEMENT 1 1/2" 404 SHOULDER 1 1/2" 404 & 617
 OTHER

STATION ESTABLISHED FROM:
 Station CARRIED FORWARD From 1993 Resurf Job To THE
NORTH WEST, which began at 4 LANES South East of Perrysburg

STRUCTURES:

NUMBER	STATION	WIDTH	LENGTH	PROPOSED WORK
10.48	553+71	43'	649' +50'	No Deck Work! Butt Joint @ Approach Slab Need
13.59	718+09	44'	70'	Deck Covered w/ Asphalt - poor Stipe SEE Sht. # 18 of 18

RAILROAD CROSSING: NONE (NO WORK)
 NAME STATION NO. TRACKS LENGTH ALONG C L FT

SHEET 2 OF 18

1994 TWO-LANE RESURFACING PROGRAM
INTERSECTIONS

COUNTY Wood ROUTE U.S. 20 SECTION 10, 24

L - PROP PAVT DEPTH (IN.) X 10; W - WIDTH @ MOUTH; W-I - WIDTH @ THROAT

[illegible]

DATE Oct 93SHEET 3 OF 10

1994 TWO-LANE RESURFACING PROGRAM

UTILITIES (CATCH BASIN, MANHOLE, INLET, WATER VALVE, BOX AND MONUMENT BOX)

COUNTY Woup ROUTE U.S. 20 SECTION 10.24

R - RAISE F - FEATHER

STATION	OUT (FT) RT/LT OF C	CATCH BASIN	MAN- HOLE	INLET	W V BOX	MON BOX	CASTING		REMARKS ie: RECONSTRUCT, NO WORK
							R	F	
561+01	20' Rt			CURB INLET				X	
581+60	Lt CURB			X				X	
589+66	Lt. CURB E.B.			X			X		
593+78	Lt CURB E.B.			X			X		
597+15	Lt CURB E.B.			X			X		
595+79	U.S. 20 W.B. NORTH CURB			X			X		
586+62	U.S. 20 WB SOUTH CURB			X			X		
508+75	W.B. 20 NORTH CURB			X			X		
589+06	W.B. 20 SOUTH CURB			X			X		
S.B. 420	East CURB		X	X			X		IF PAVING IN AREA
Sta B+56									
S.B. 420	East CURB		X	X			X		
4+09									
0+55									
N.B. 420	East CURB			X			X		
N.B. 420 ³ +90	East CURB			X			X		

1984 TWO LANE RESURFACING PROGRAM

NOTE: LOCATE ALL
CHANGES IN PVMT WIDTH

COUNTY Wood ROUTE U.S. 20 SECTION 1024

[illegible][illegible]

DATE Oct 93

SHEET 5 OF 10

1994 TWO-LANE RESURFACING PROGRAM
DEFECTIVE PAVEMENT AREAS

COUNTY W. JACO ROUTE U.S. 20 SECTION 10.24

[illegible]

P.W. 1

SHEET NO. 6 of 18

PERSONNEL

TITLE

COUNTY Wood

1

Q. 17


•

הערה:

PAVT WIDTHS

RIGHT

JOB NO.

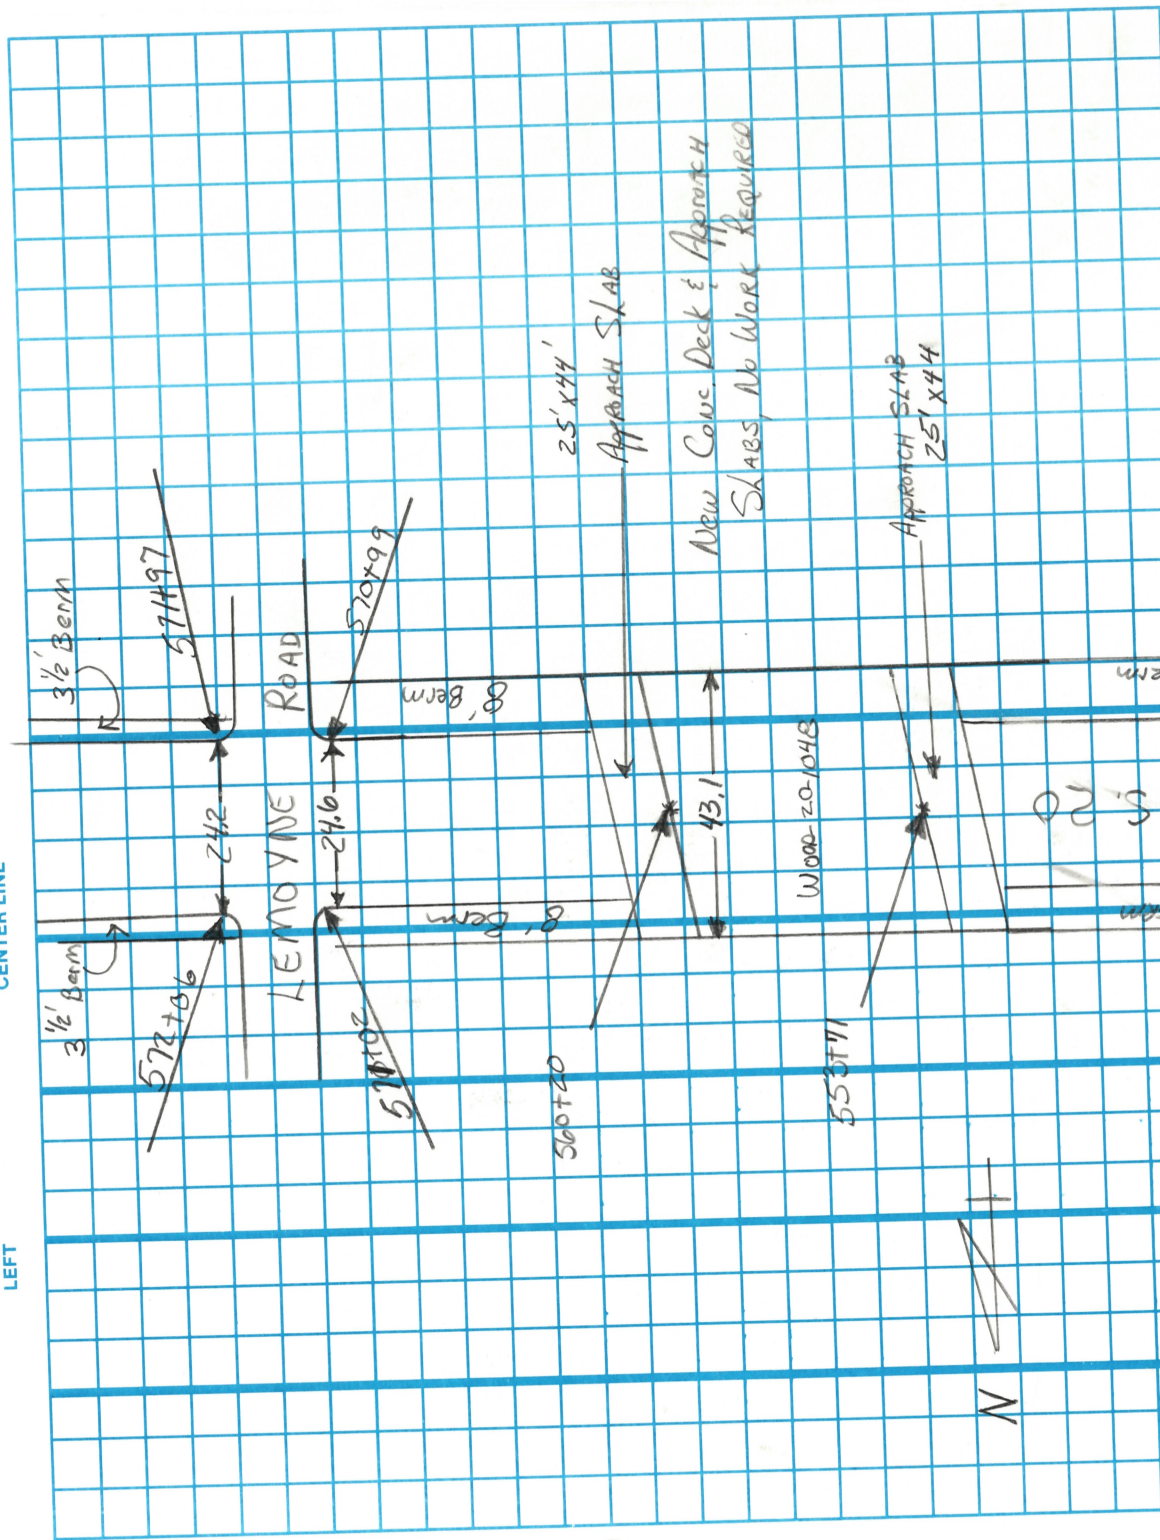

State of Ohio Department of Transportation
Field Notes

SHEET NO. 7 of 18

PERSONNEL	TITLE	PERSONNEL	TITLE	COUNTY	DATE	9-20-93
LOCHERKE				WOOD		
CANTERBURY				S. R.	U.S. 20	CHADY
				SEC.	10, 24	465


COUNTY Wood DATE 9-20-93
S. R. U.S. 20 WEATHER Cloudy
SEC. 10, 24 TEMP. 46.5

JOB NO. _____

DESCRIPTION

LEFT

RIGHT

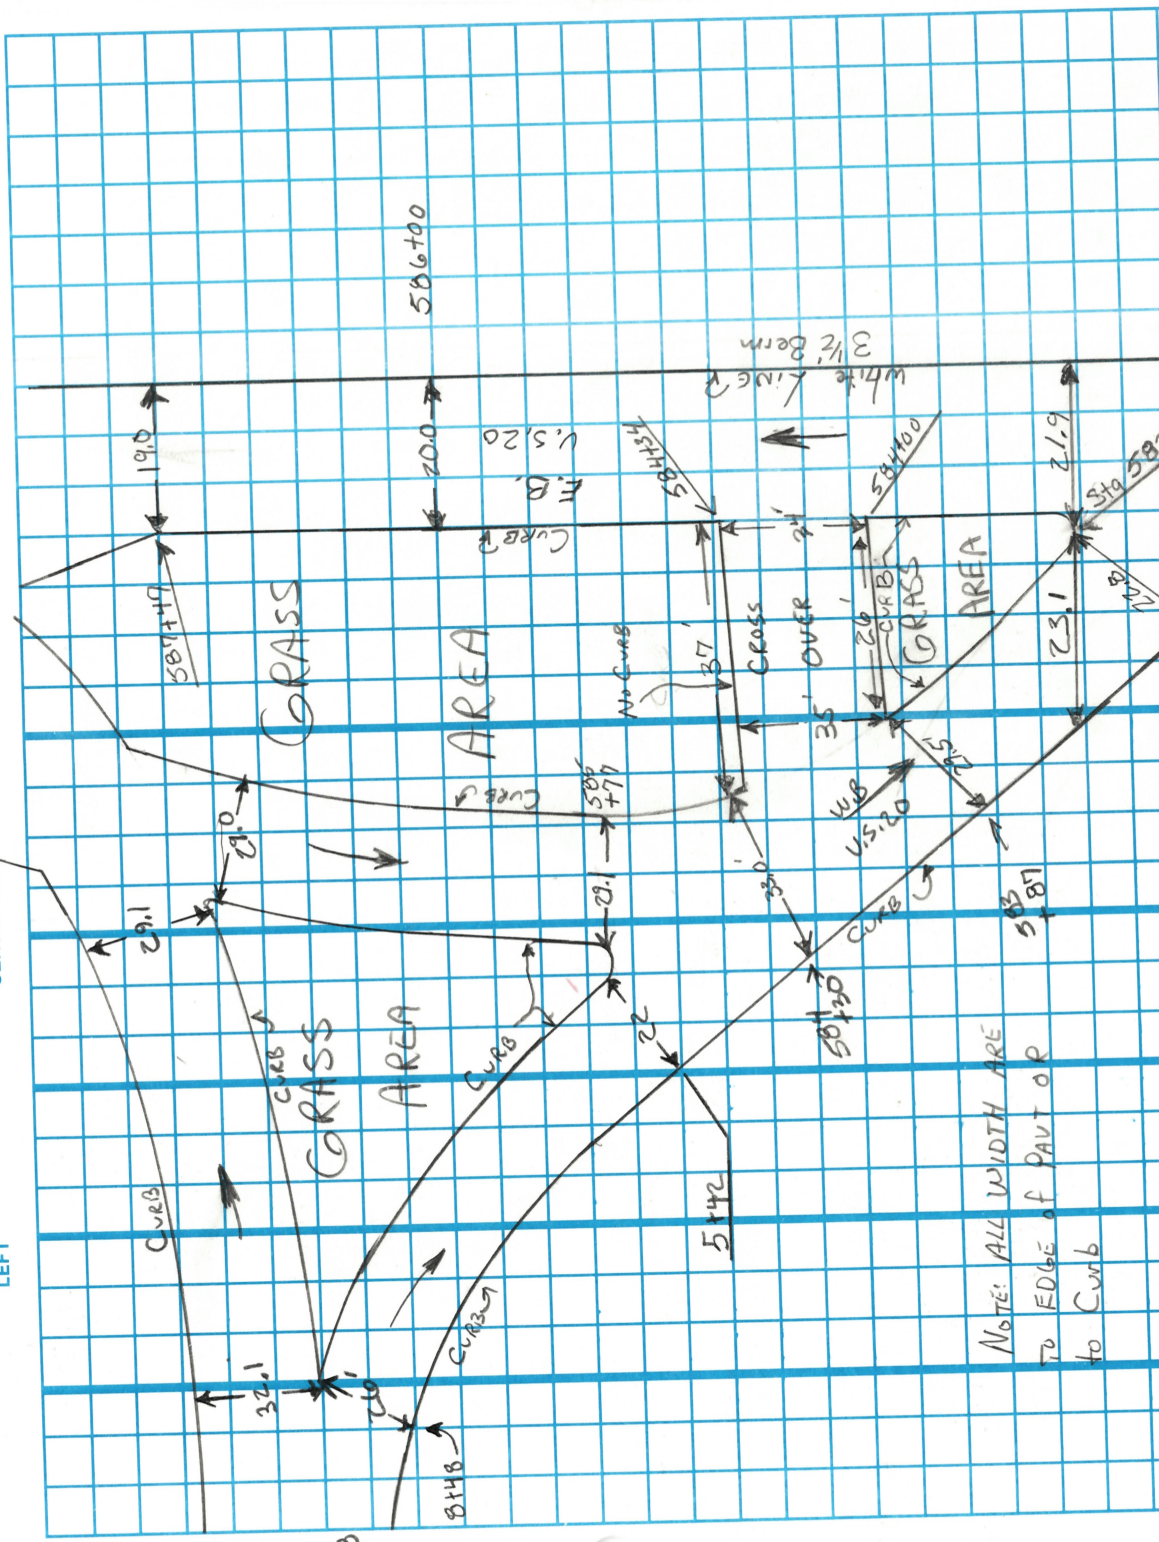

NOTE: ALL WIDTH ARE TO EDGE of PAVT OR to Curb

P.W.3


State of Ohio Department of Transportation
Field Notes

LD-5
5-92

PERSONNEL LOERKE TITLE _____ PERSONNEL _____ TITLE _____
CANTERBURY _____ PERSONNEL _____ TITLE _____
 COUNTY Ward DATE 11-1-93 WEATHER Cloudy
 S.R. US.20 TEMP. +34
 SEC. 10.24

SHEET NO. 8 of 18

DESCRIPTION PAVT WIDTHS LEFT CENTER LINE RIGHT JOB NO. _____

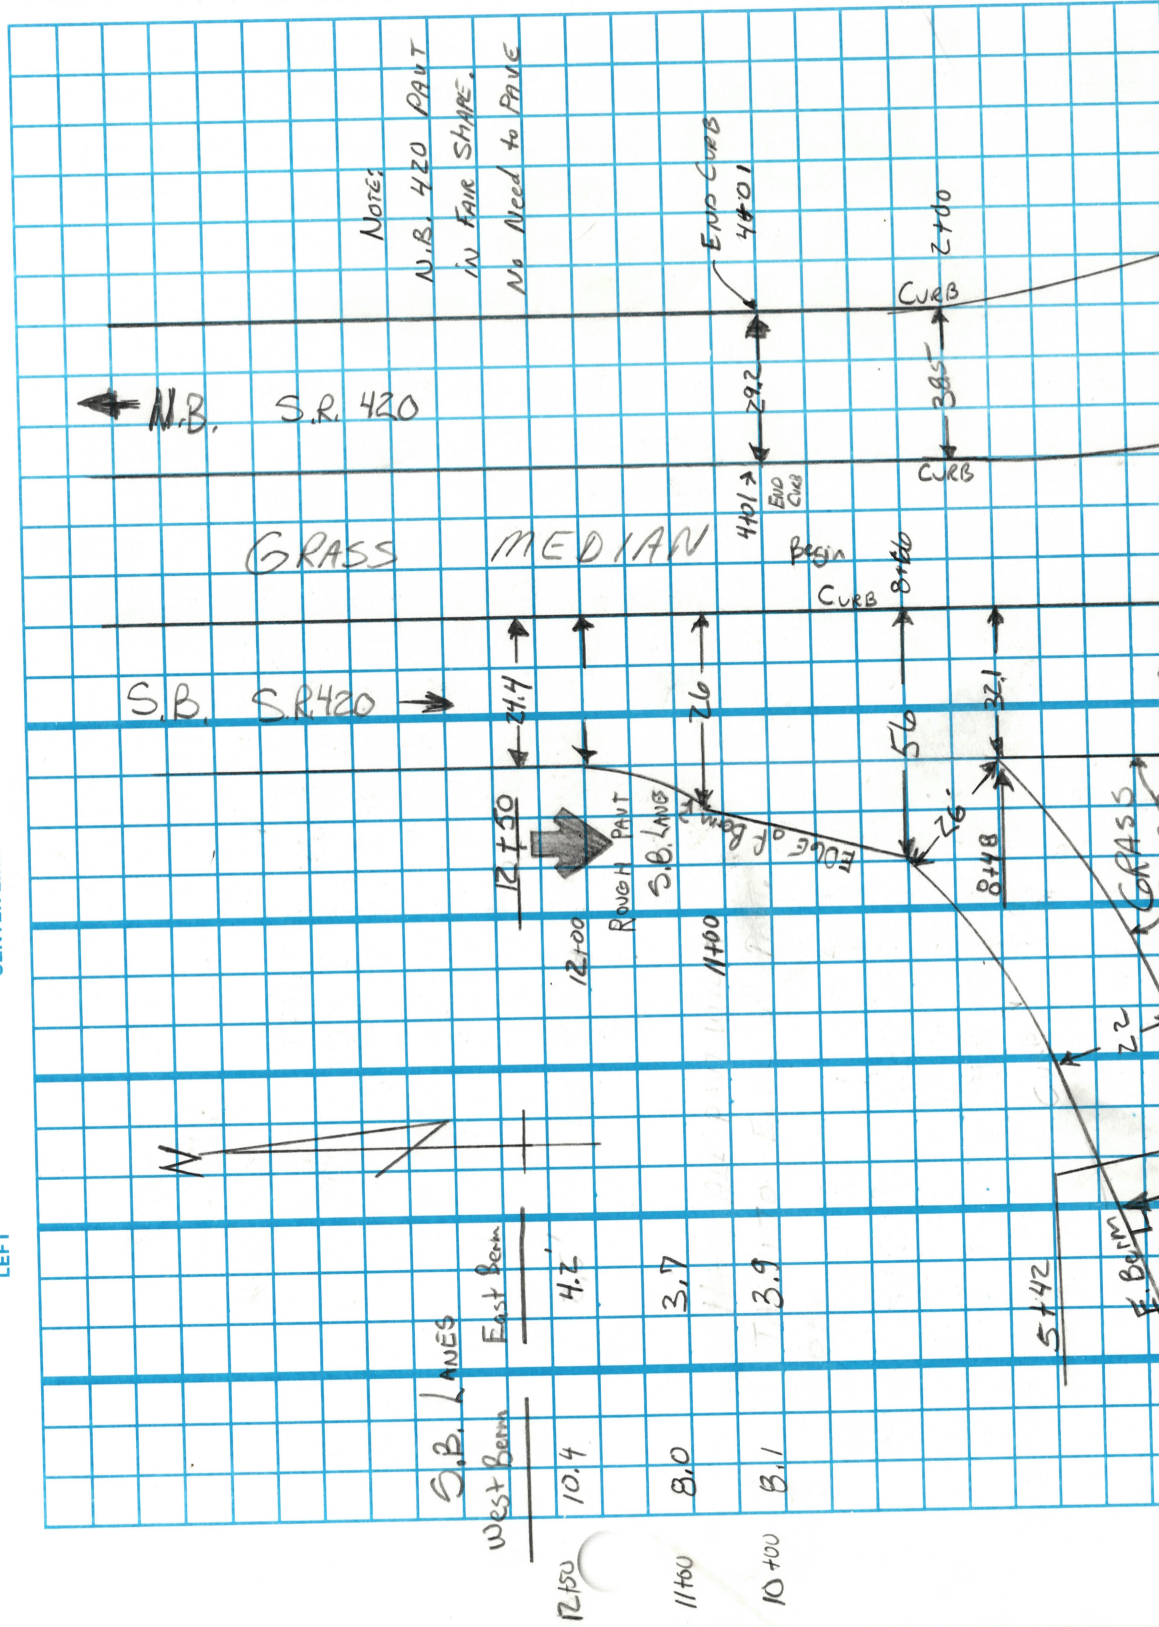

State of Ohio Department of Transportation
Field Notes

SHEET NO. 9 of 18

TITLE	PERSONNEL	TITLE
-------	-----------	-------

COUNTY Wood

DATE 9-20-93

1

THEY

US.20

ATHER Cloudy

1


TEMP. 76.5

part with

JOB NO. _____

CENTER LINE

RIGHT

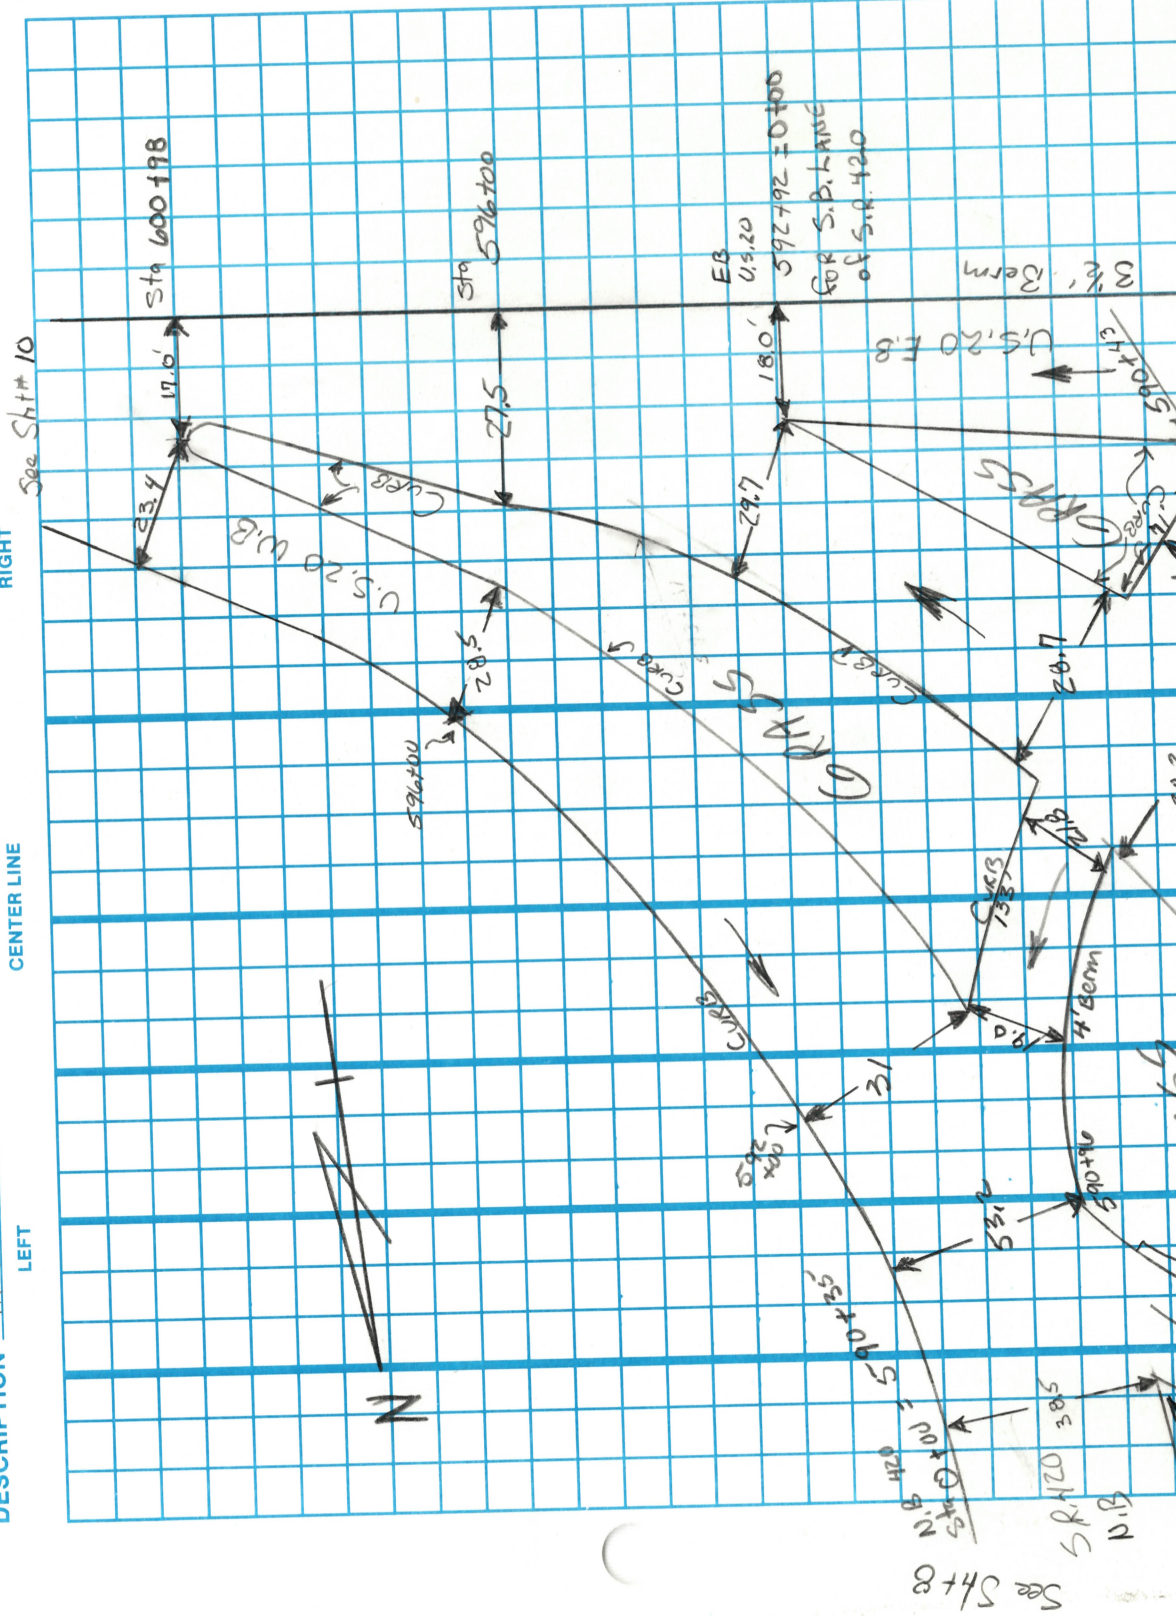

P.W. 5

SHEET NO. 10 of 18

DATE 9-20-93

TITLE

PERSONNEL

TITLE

COUNTY Wood

WEATHER Chilly

WEATHER

WEATHER

TEMP. +60S

TEMP. +60S

TEMP. +60S

JOB NO. _____

DESCRIPTION	<u>PART WIDTH</u>	LEFT


DESCRIPTION

PART WITH

LEFT

CENTER LINE

RIGHT

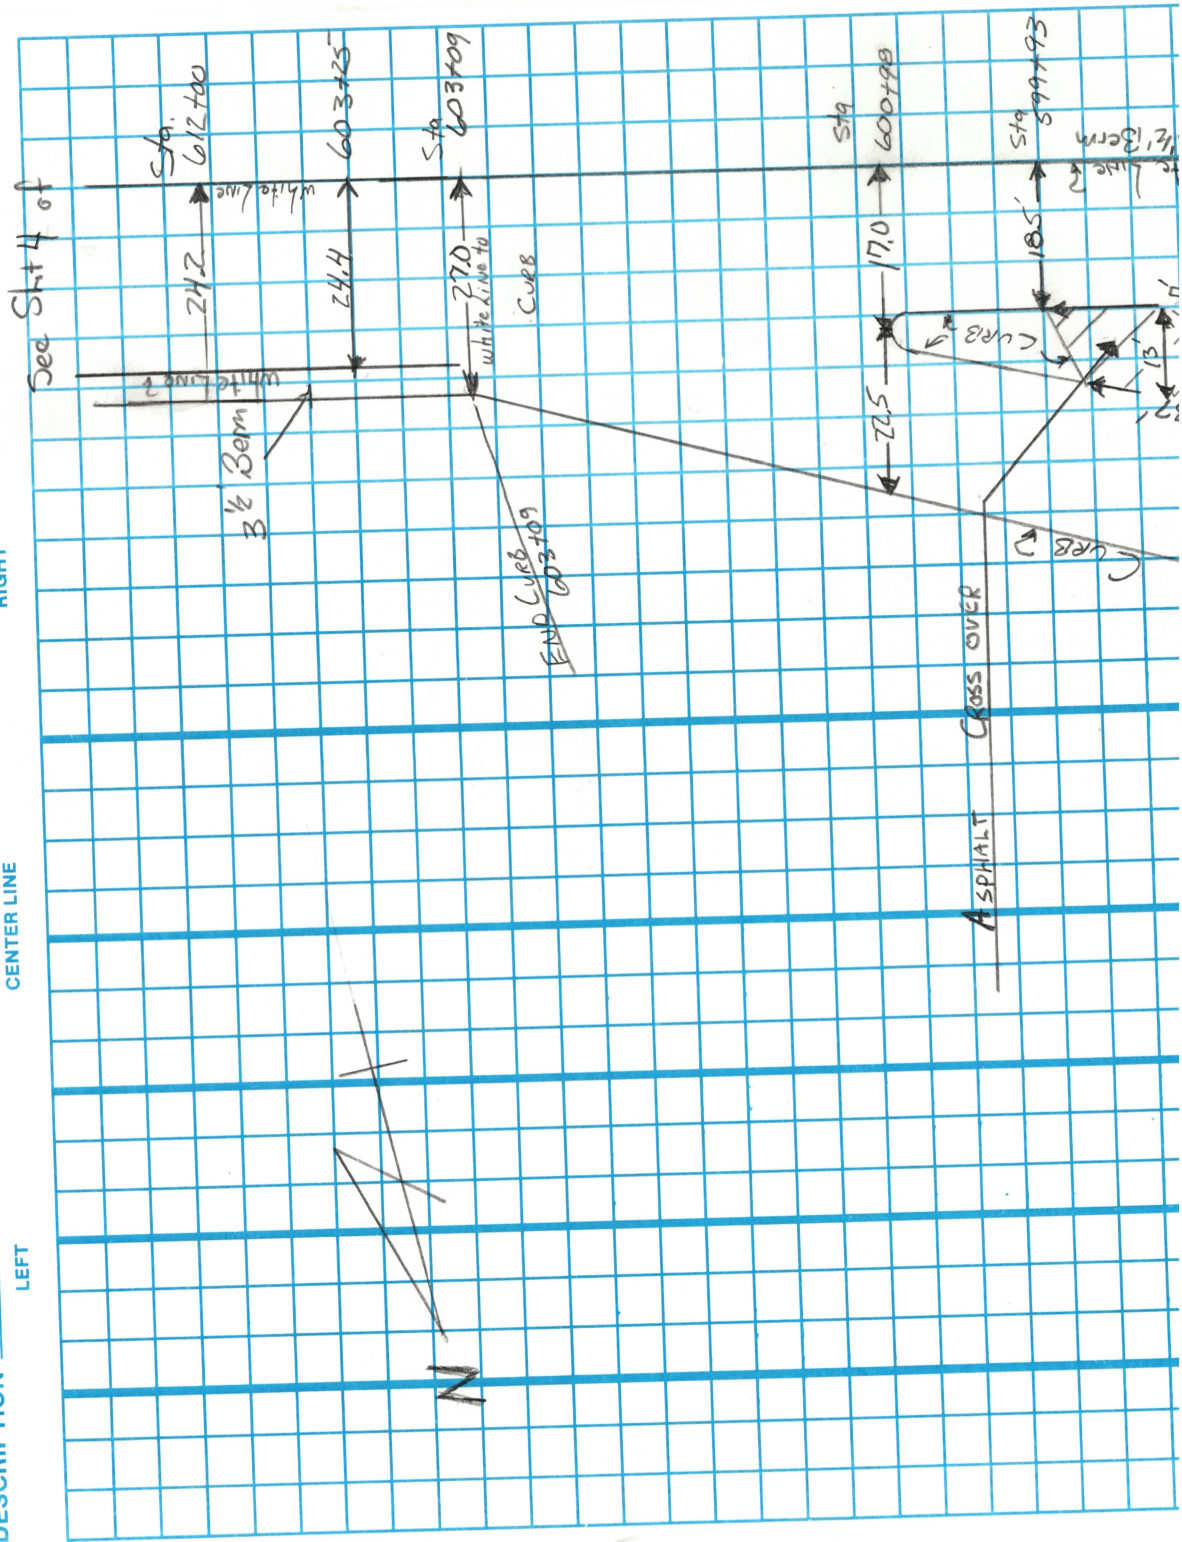

State of Ohio Department of Transportation


LD-5
5-92

Field Notes

SHEET NO. 11 of 18
DATE 11-1-93
WEATHER Pr Cloudy
PERSONNEL LOENKE
CANTERBURY
TITLE
PERSONNEL
COUNTY Wood
S. R. U.S. 20
SEC. 10.24
TEMP. +40

DESCRIPTION Stationing of Ramp AREAS U.S. 20 @ S.R. 420 JOB NO.

LEFT CENTER LINE RIGHT

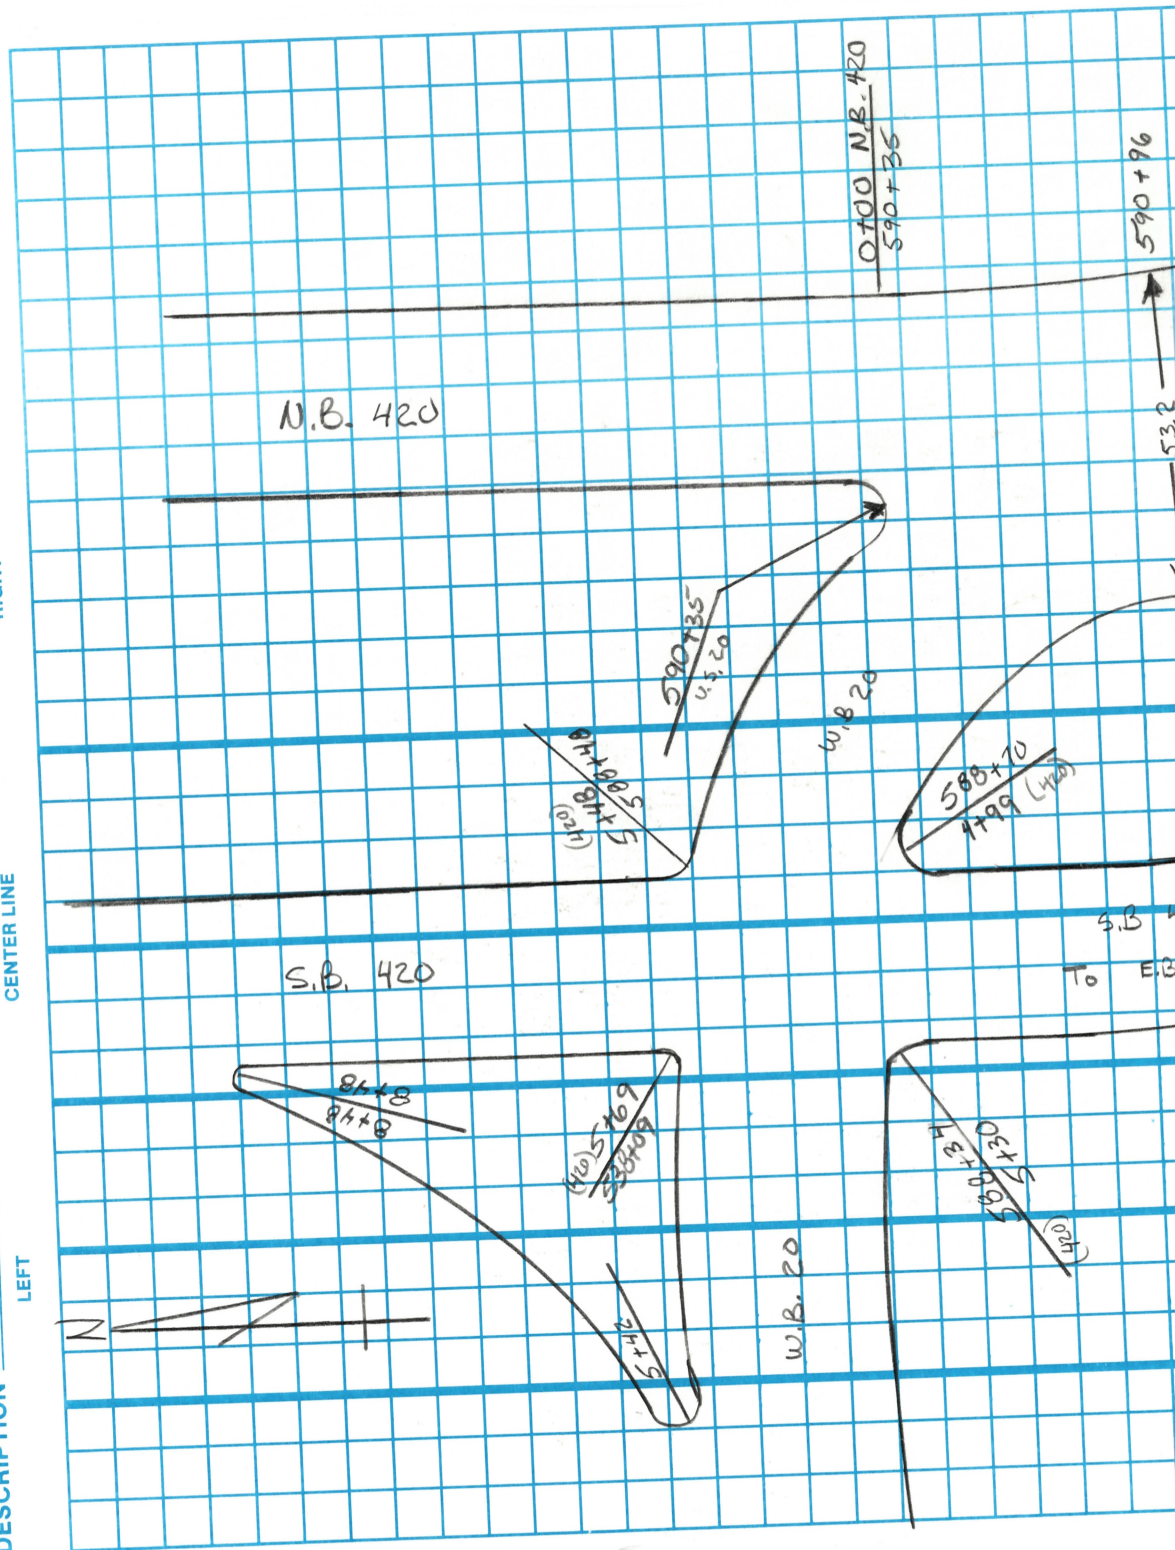


State of Ohio Department of Transportation Field Notes

SHEET NO. 12 of 18
DATE 11-1-93

LD-5
5-92

PERSONNEL	TITLE	PERSONNEL	TITLE	COUNTY	WOOD	DATE	11-1-93
LOEHKE				S. R.	U.S. 20	WEATHER	Chover
CANTERBURY				SEC.	10.24	TEMP.	+34

DESCRIPTION New Pavt - Oct 28-1993 S.B. LANES S.R. 420 JOB NO.

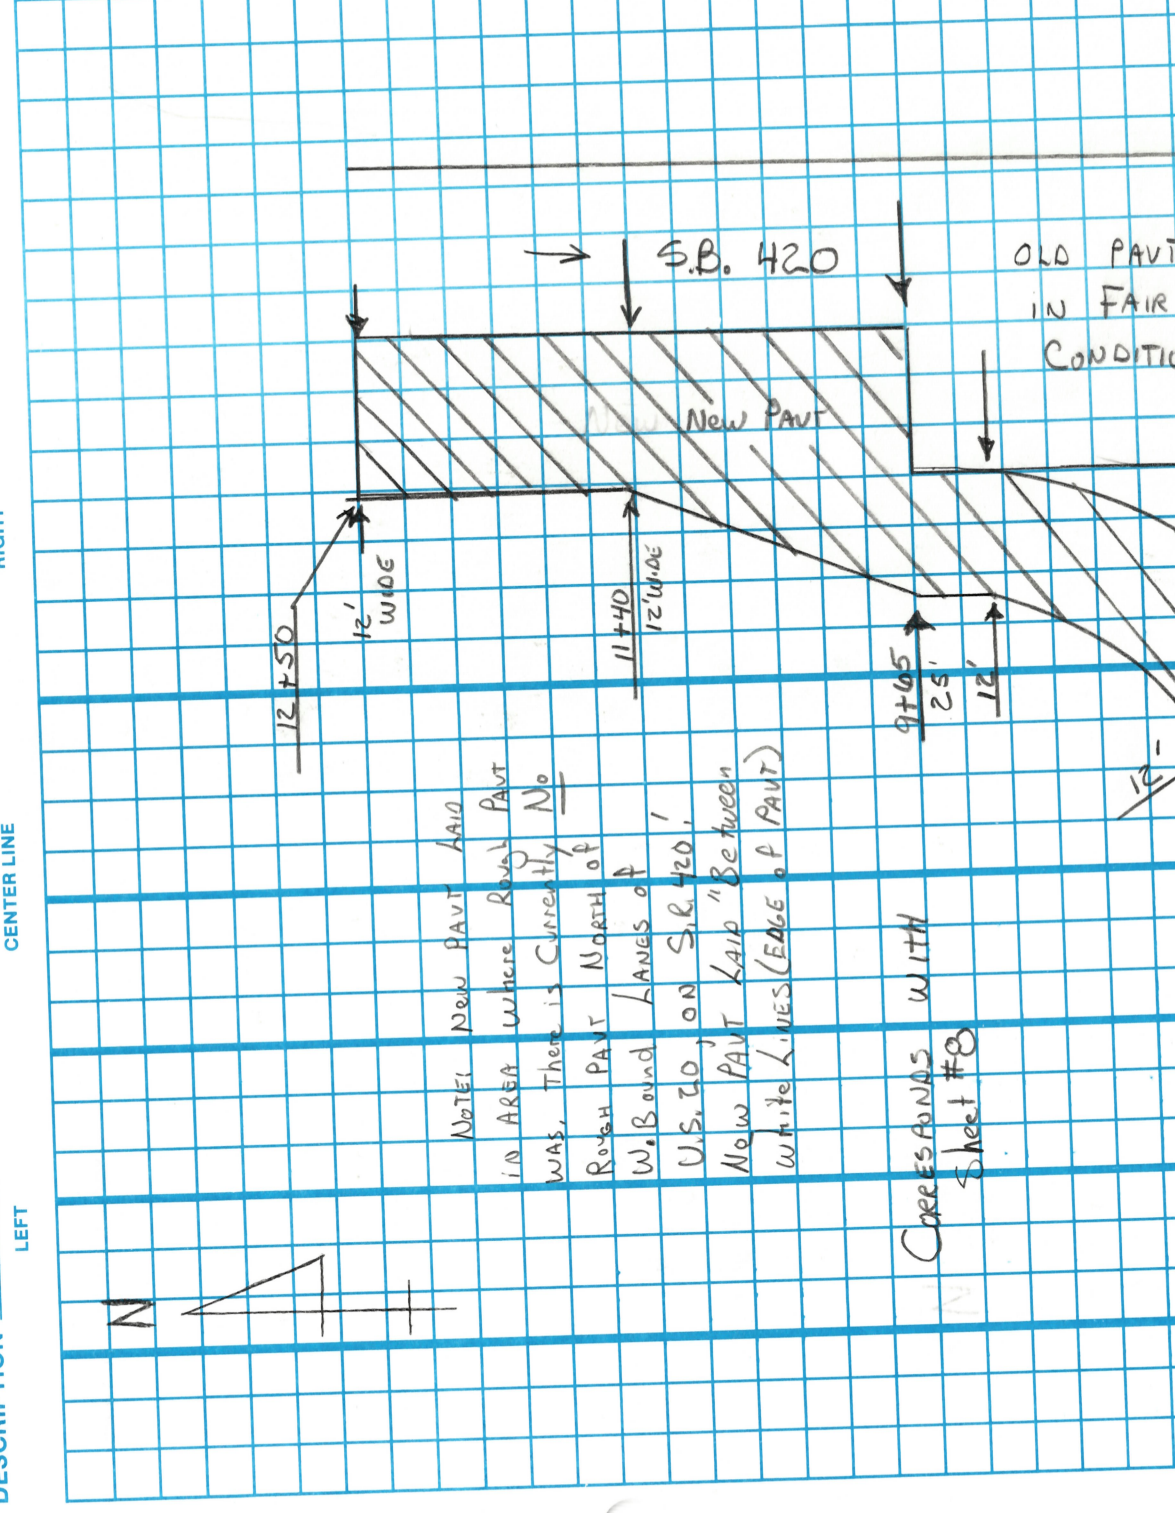

State of Ohio Department of Transportation
Field Notes


P.M. 1

LD-5
5-92

SHEET NO. 13 of 18
DATE 11-2-93

PERSONNEL	TITLE	PERSONNEL	TITLE	COUNTY	WEATHER	TEMP.
LoCHANE				WOOD	CLOUDY	+45°
CANTERBURY				S. R. U.S. 20		
				SEC. 10, 24		

DESCRIPTION PAVT MARKINGS LEFT RIGHT JOB NO. (A)

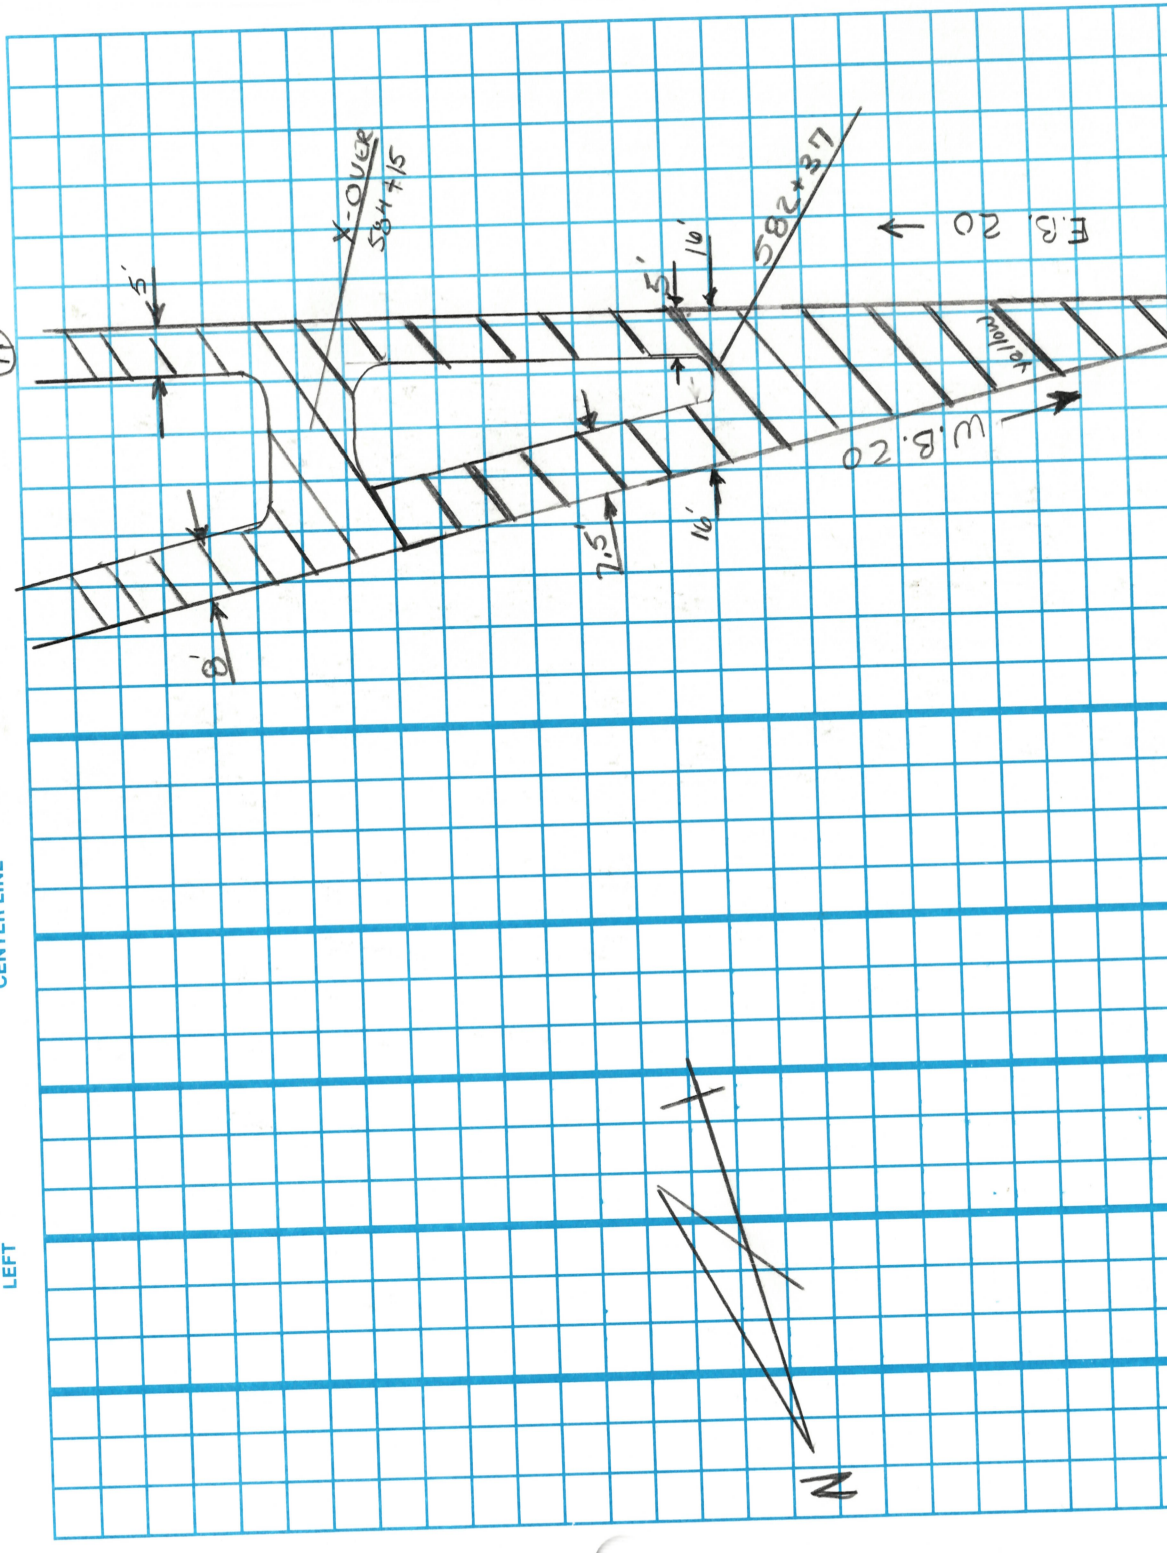

State of Ohio Department of Transportation Field Notes

LD-5
5-92

PERSONNEL
LOEBKE
CANTERBURY

TITLE
PERSONNEL
TITLE

COUNTY
WOOD

S.R.
V.S.20

SEC.
10.24

WEATHER
CLOUDY

TEMP.
+45

SHEET NO. 14 of 18

DATE 11-2-93

JOB NO.


PAV MARKINGS

DESCRIPTION

LEFT

CENTER LINE

RIGHT

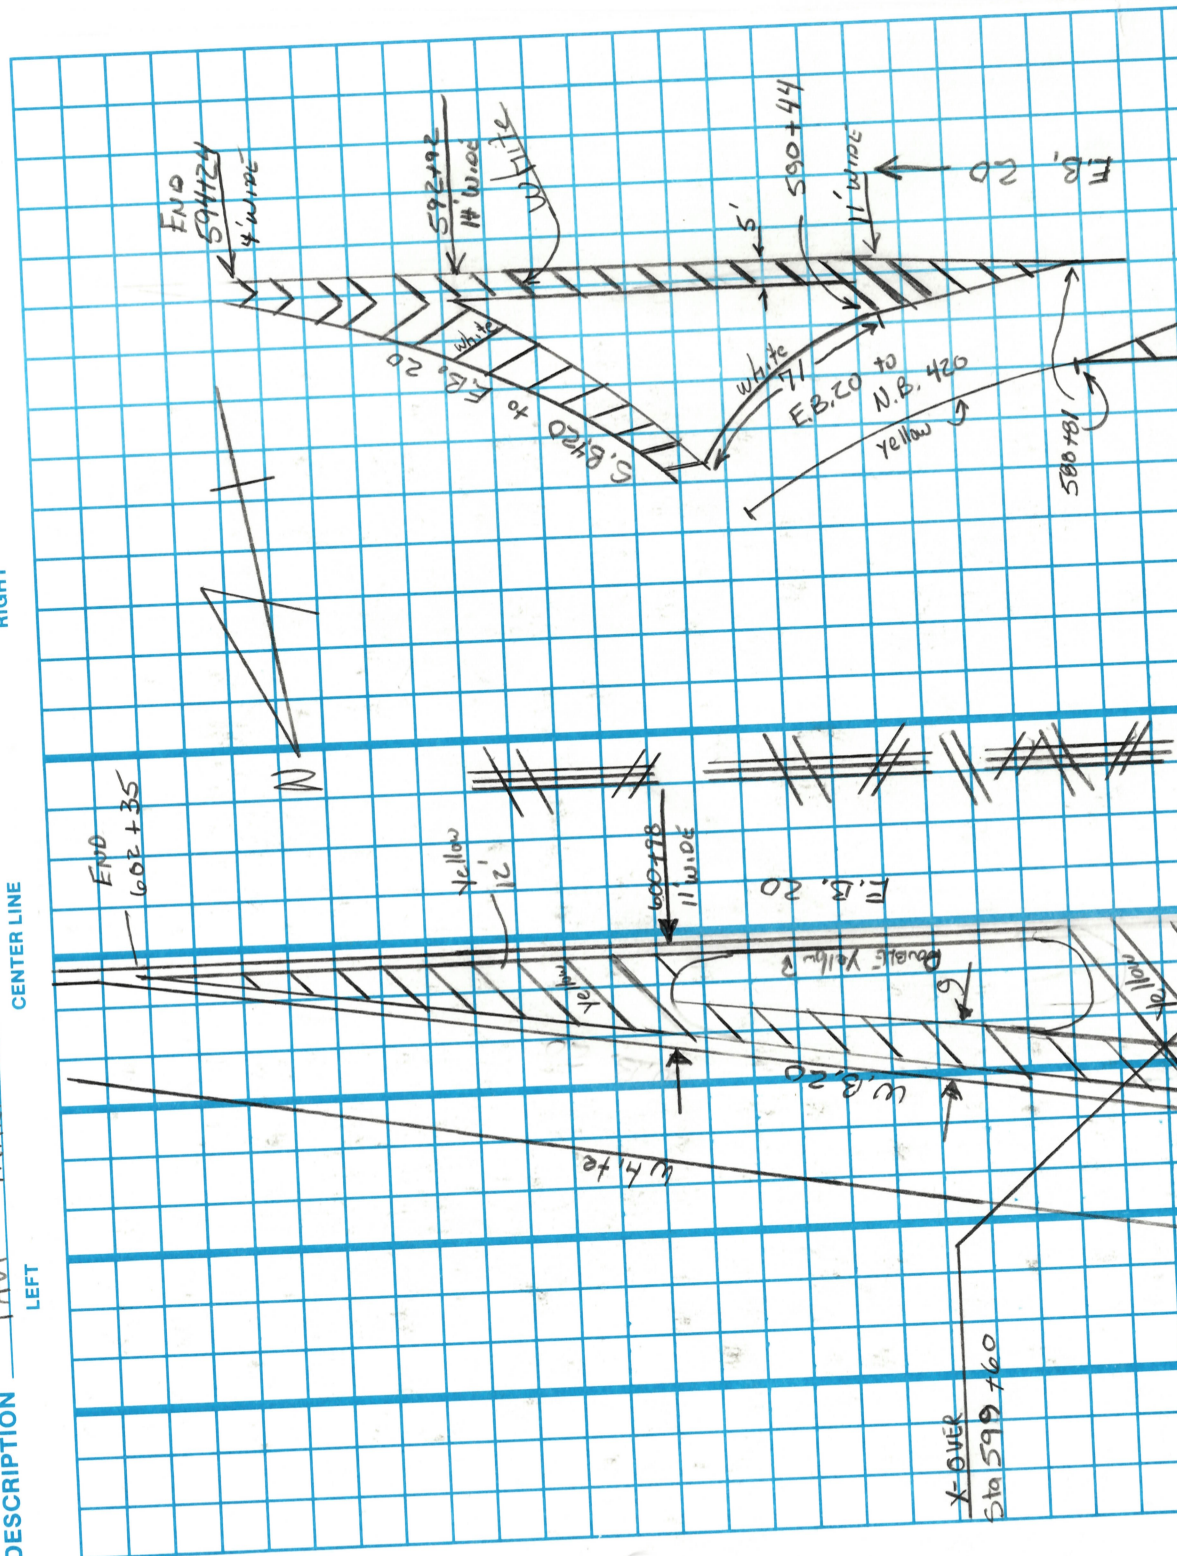

LD-5
5-92


	TITLE	PERSONNEL	TITLE	COUNTY	Wood	DATE	
				S. R.	U.S. ZO	WEATHER	CLEAR
				SEC.	10.24	TEMP.	+45
						JOB NO.	

DAUT MARKINGS

High

CENTER LINE

DESCRIPTION	PAY	LEFT

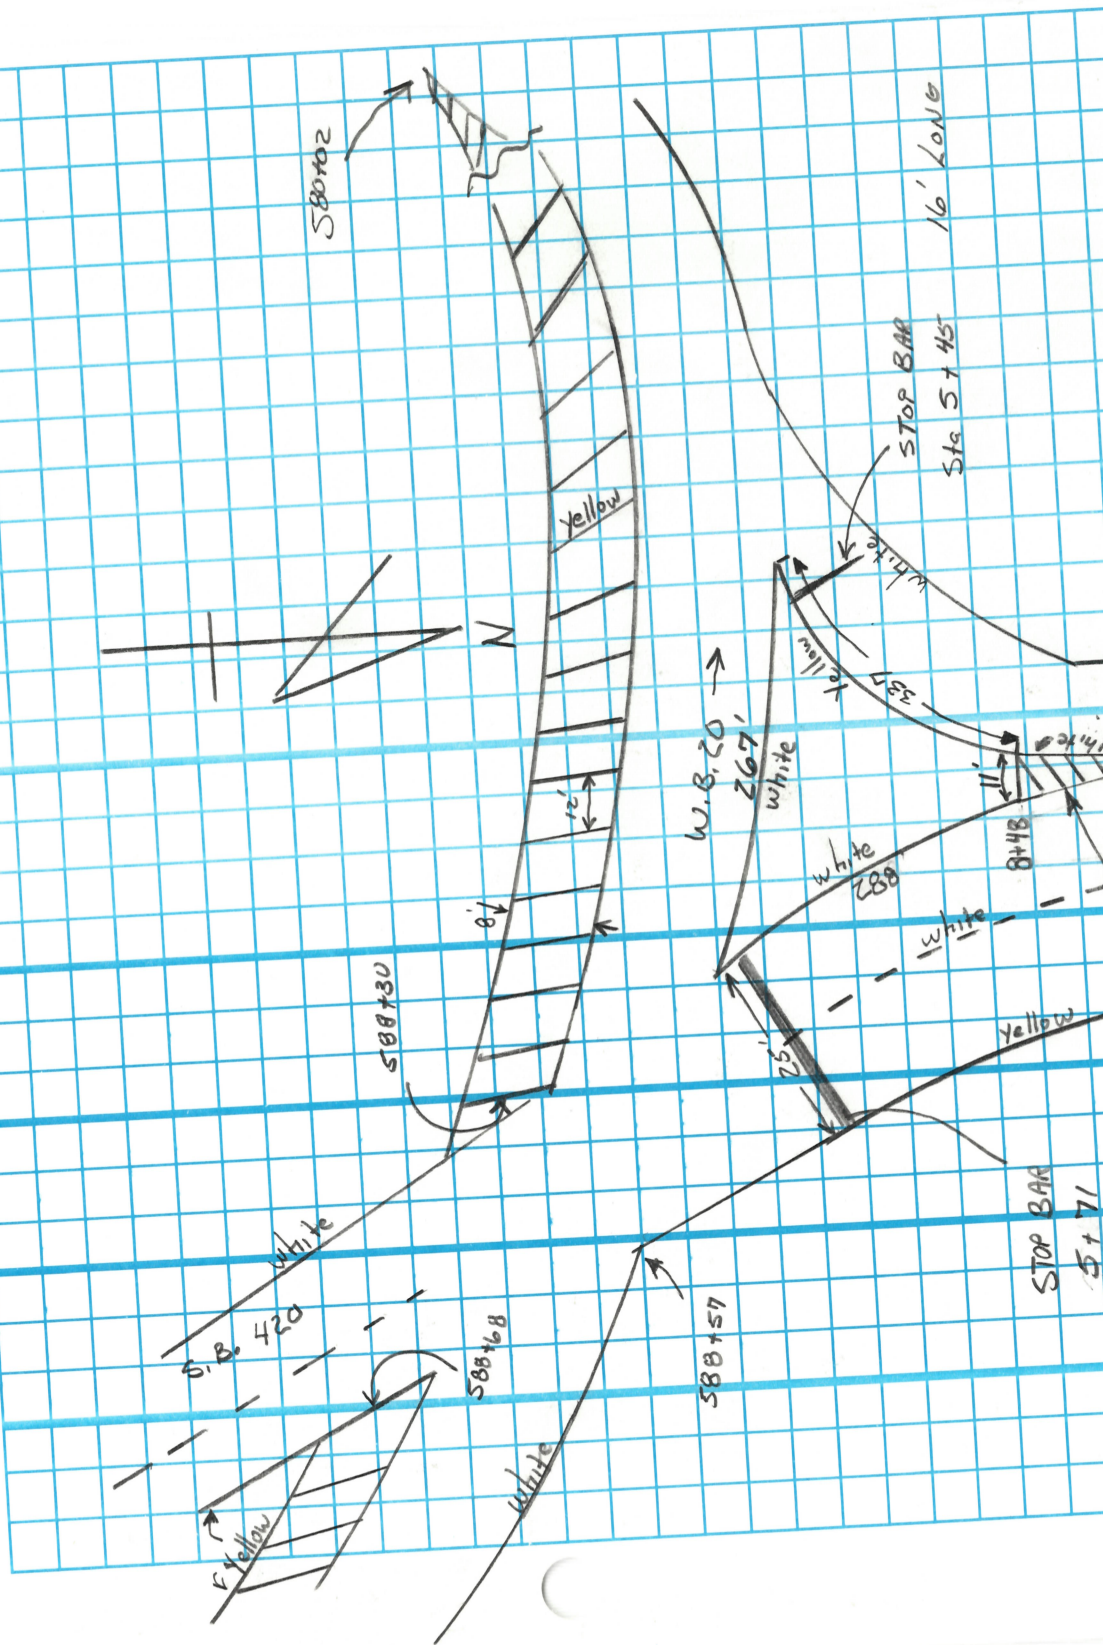

State of Ohio Department of Transportation
Field Notes

LD-5
5-92

SHEET NO. 16 of 18
DATE 11-2-93

PERSONNEL
LOEHRKE
CANTER BURY

TITLE
PERSONNEL
TITLE
COUNTY
S. R.
SEC.

WEATHER
Cloudy

TEMP.
+45


JOB NO. _____

PAV MARKINGS

DESCRIPTION

CENTER LINE

RIGHT

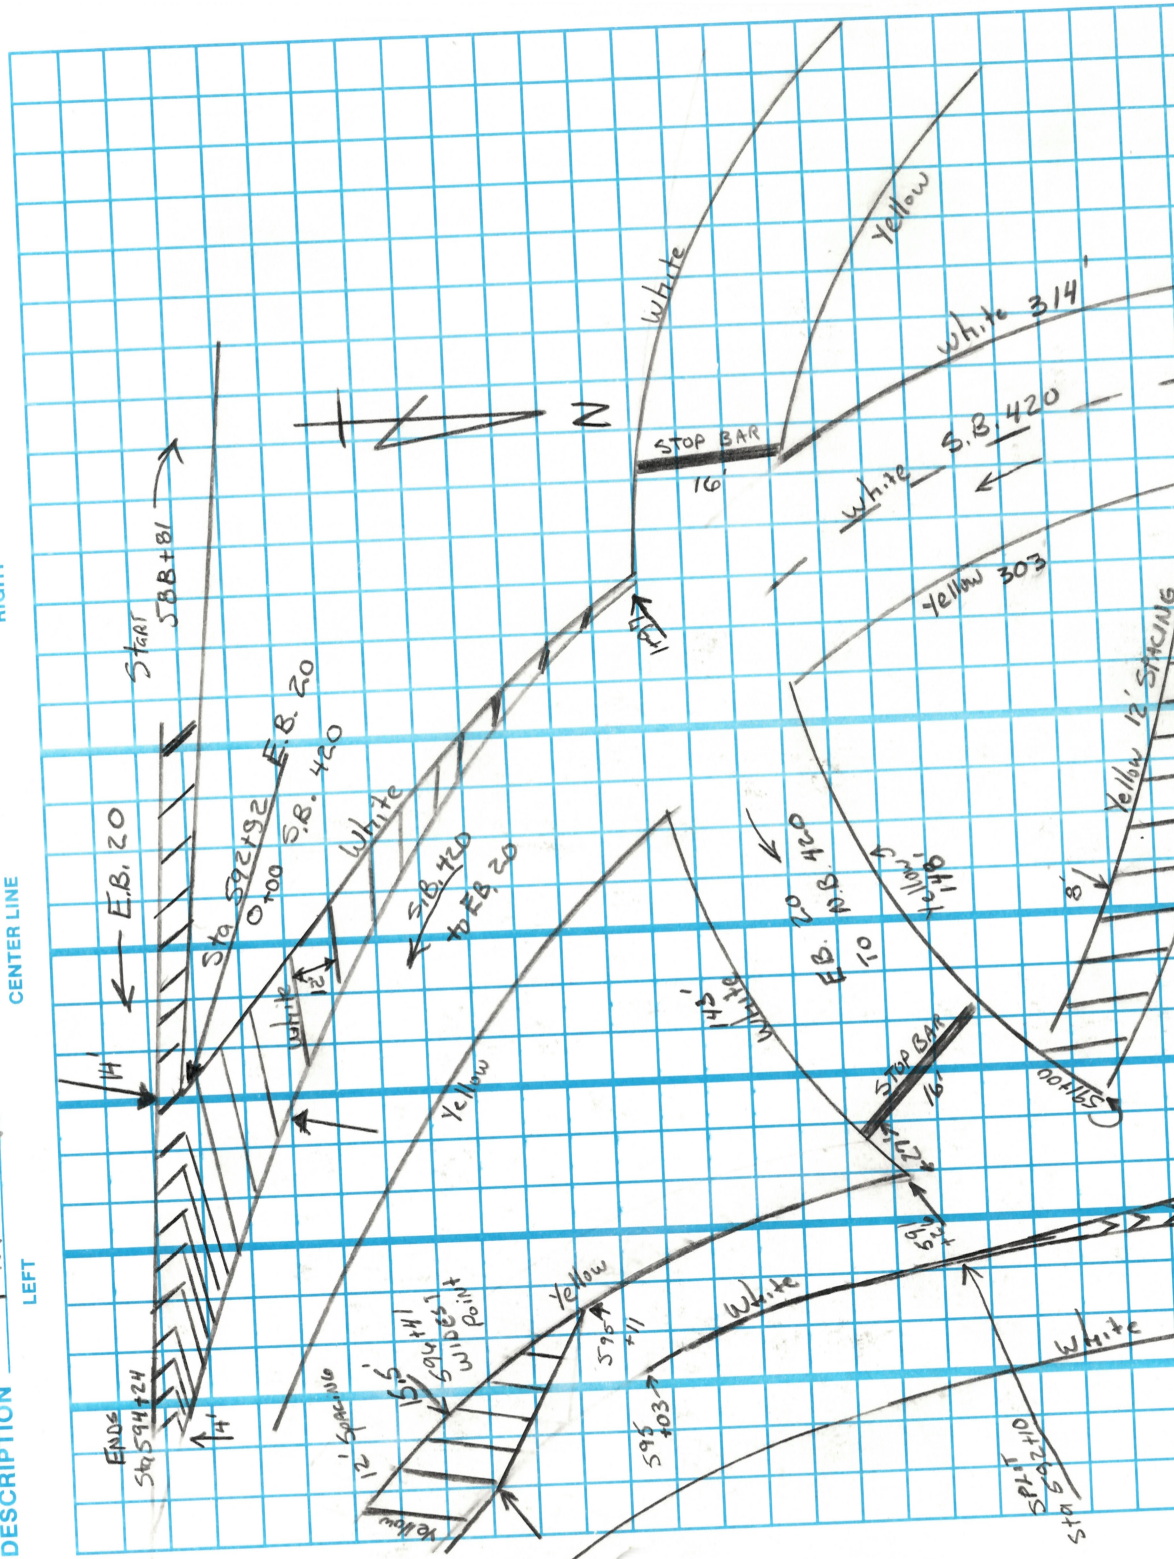

State of Ohio Department of Transportation Field Notes

LD-5
5-92

PERSONNEL
LOEHKE
CANTERBURY

TITLE
PERSONNEL
TITLE

COUNTY
Wood

S.R.
U.S. 20

SEC.
10, 24

WEATHER
Cloudy

TEMP.
+48

SHEET NO.
1708 18

DATE
11-5-93

JOB NO.


PAVT MARKINGS

RIGHT

CENTER LINE

LEFT

DESCRIPTION

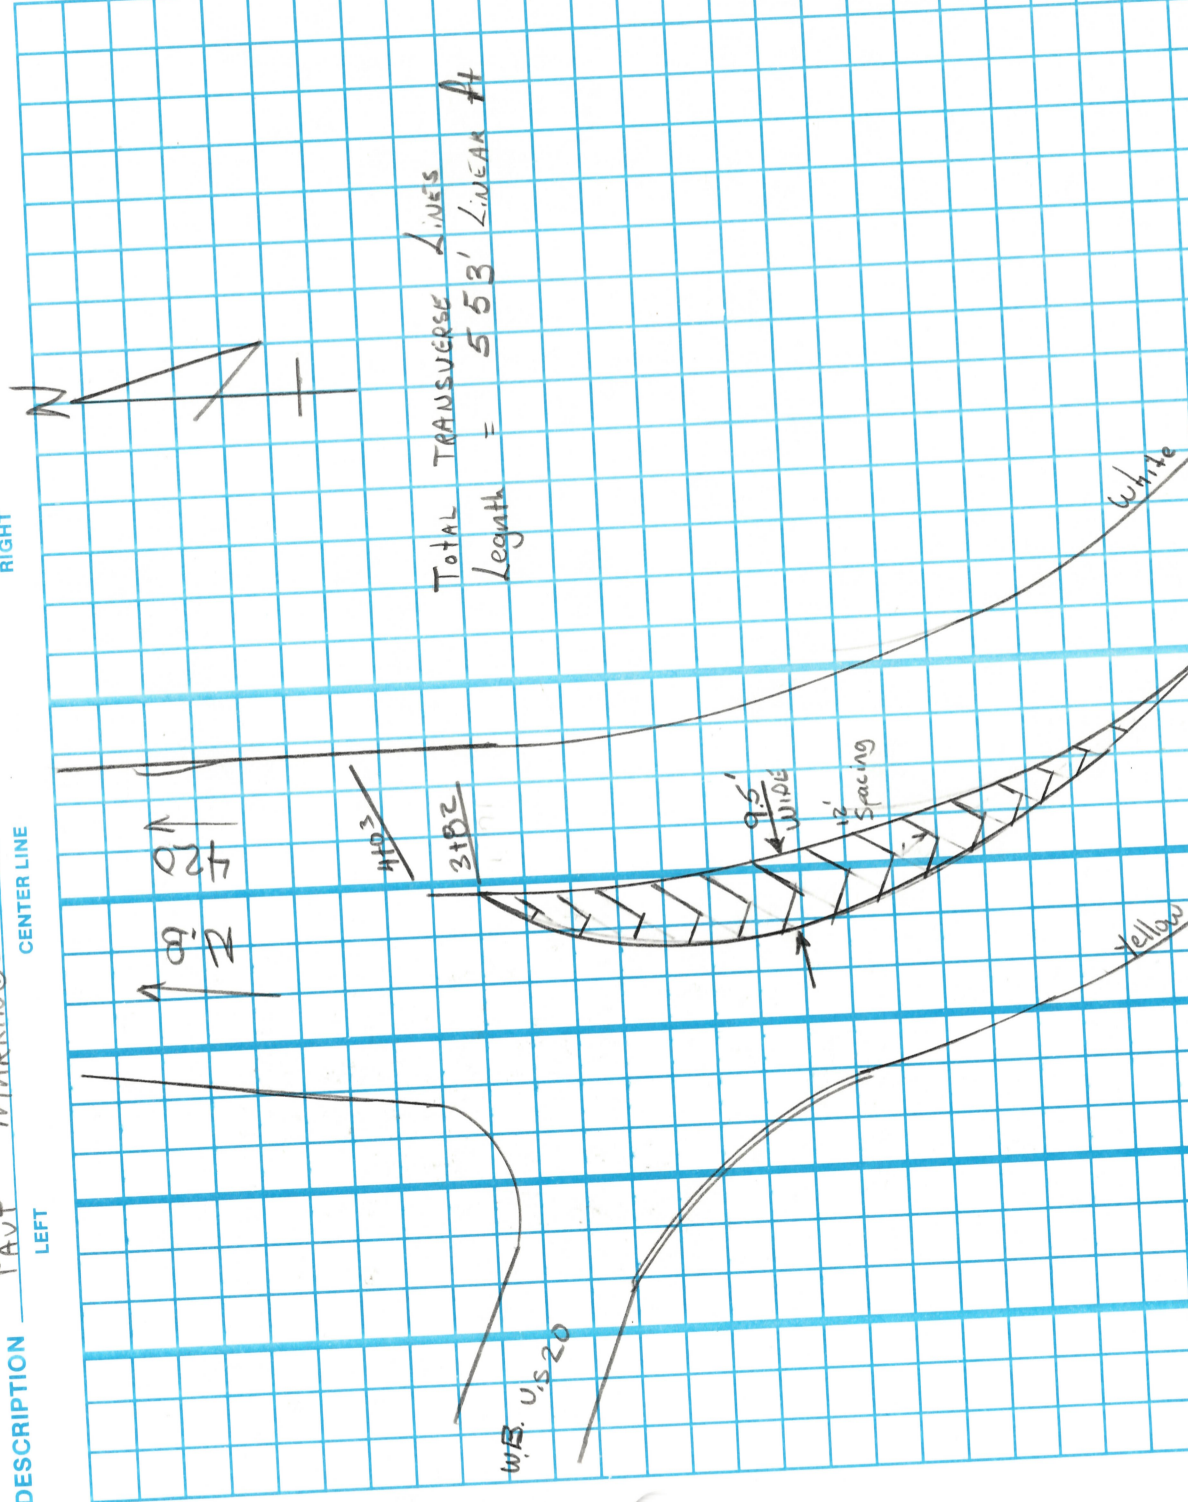

State of Ohio Department of Transportation
Field Notes

LD-5
5-92

SHEET NO. 180718
DATE 11-2-93

COUNTY Wood
S. R. V. S. 20 WEATHER Cloudy
SEC. 10, 24 TEMP. +45

TITLE _____
PERSONNEL _____
TITLE _____
PERSONNEL _____
TITLE _____
PERSONNEL _____

JOB NO. _____


BRIDGE INFO

DESCRIPTION

RIGHT

CENTER LINE

LEFT

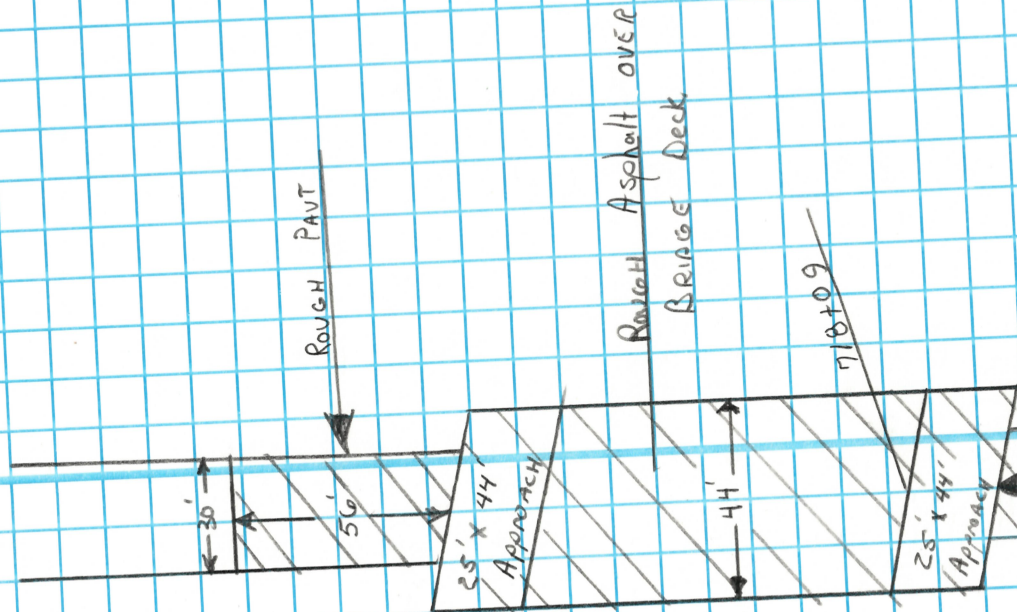

Wood-20-13.59

NOTE PAVT IS RUGH
From Sta 717+28 to
Sta 719+60