

O.D.O.T. DISTRICT 2 SURVEY OFFICE (USE ONLY)

PERSONNEL _____

REFERENCE NO. 1

SHEET 1 OF 15

NOTES BARNHISEL

DATE 9/5/02

ROUTE US 20

H.C. HOMAN

WEATHER SUNNY

COUNTY WOOD

R.C. BEAUMONT

TEMP. 70°

TOWNSHIP PERRYSBURG

SECTION RT 67

DWG BY NIESE

PID _____

T 4 N

TYPE MONUMENT P.K. NAIL

ON SURFACE - ~~BELOW~~ ON

OFFSET ☑ PAVEMENT _____ LT : RT

23.6' TO RT EDGE PAVEMENT


STATION: 19+82

HORZ. DATUM: _____


GEOID: _____

GRID: NORTHING: _____

EASTING: _____

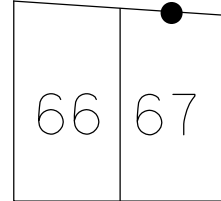

RECORD: P.I.
 STA 19+64.03
 $\Delta = 15^\circ 17' 30''$
 $D = 4^\circ$
 $R = 1432.40'$
 P.C. = 17+71.74
 P.I. = 19+64.03
 P.T. = 21+54.03
 FD P.K.
 9/5/02, MB

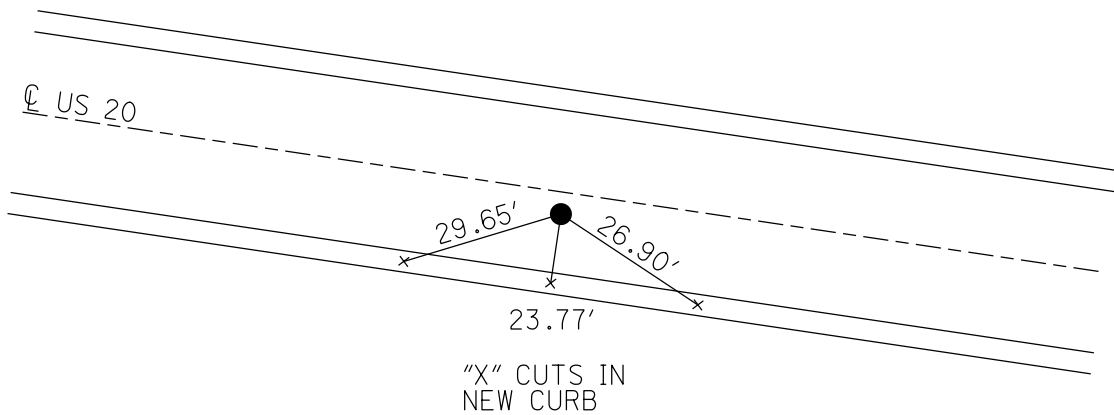

O.D.O.T. DISTRICT 2 SURVEY OFFICE (USE ONLY)

PERSONNEL

REFERENCE NO. 1 A

SHEET 2 OF 15

NOTES RHOADES

DATE 4/9/14

ROUTE US 20

H.C. ROUSOS

WEATHER CLEAR

COUNTY WOOD

R.C. HOMAN

TEMP. 41°

TOWNSHIP PERRYSBURG

GABLE

SECTION 12 MILE RESERVE

DWG BY NIESE

PID _____

T 4 N

TYPE MONUMENT MONBOX

ON SURFACE - ~~BELOW~~ ON

OFFSET Q PAVEMENT _____ LT : RT

_____ TO _____ EDGE PAVEMENT



STATION: 24+47

HORZ.DATUM: _____

GEOID: _____

GRID: NORTHING: 690404.886

EASTING: 1656011.473

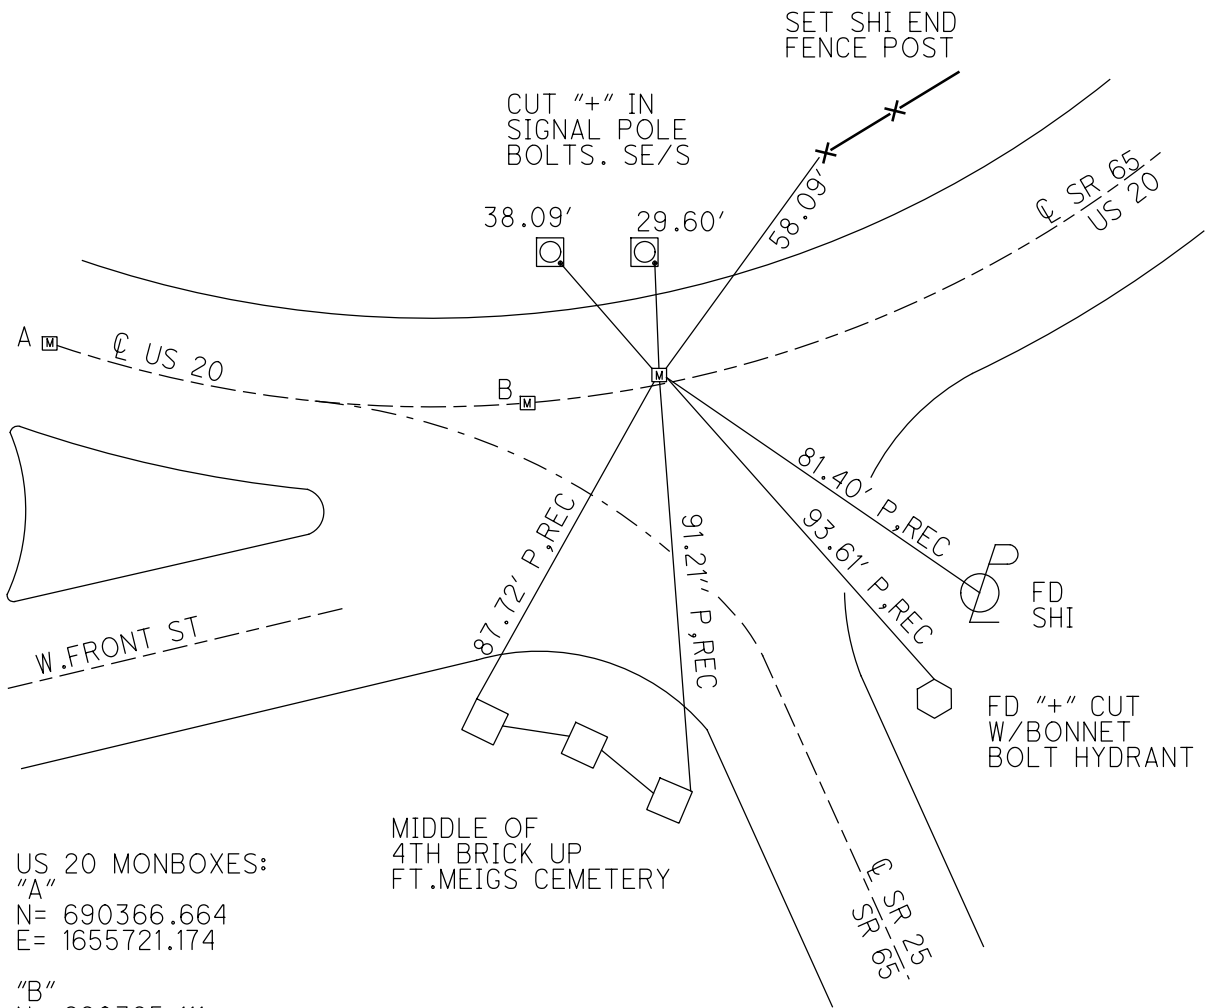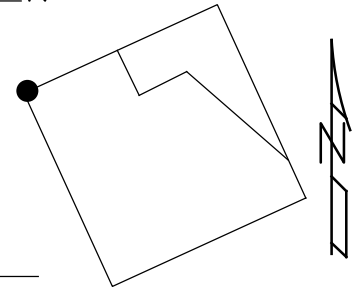

US 20 MONBOXES:

"A"
N= 690366.664
E= 1655721.174

"B"
N= 690395.111
E= 1655991.073


MIDDLE OF
4TH BRICK UP
FT. MEIGS CEMETERY

O.D.O.T. DISTRICT 2 SURVEY OFFICE (USE ONLY)


PERSONNEL _____ REFERENCE NO. 2 SHEET 3 OF 15
 NOTES BURNSIDE DATE 2/27/70 ROUTE US 20
 H.C. SMITH WEATHER CLOUDY COUNTY WOOD
 R.C. HOFFMAN TEMP. 32° TOWNSHIP PERRYSBURG
 DWG BY NIESE PID _____ SECTION 12 MILE RESERVE
 T 4 N

TYPE MONUMENT P.K. NAIL
 ON SURFACE - ~~BELOW~~ ON
 OFFSET ☉ PAVEMENT ON LT : RT
 TO EDGE PAVEMENT
 STATION: 85+53.6

HORZ. DATUM: _____ GEOID: _____
 GRID: NORTHING: _____ EASTING: _____

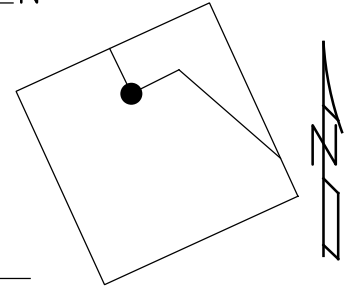

RECORD:
 FD P.K. NAIL
 2/27/70, BURNSIDE

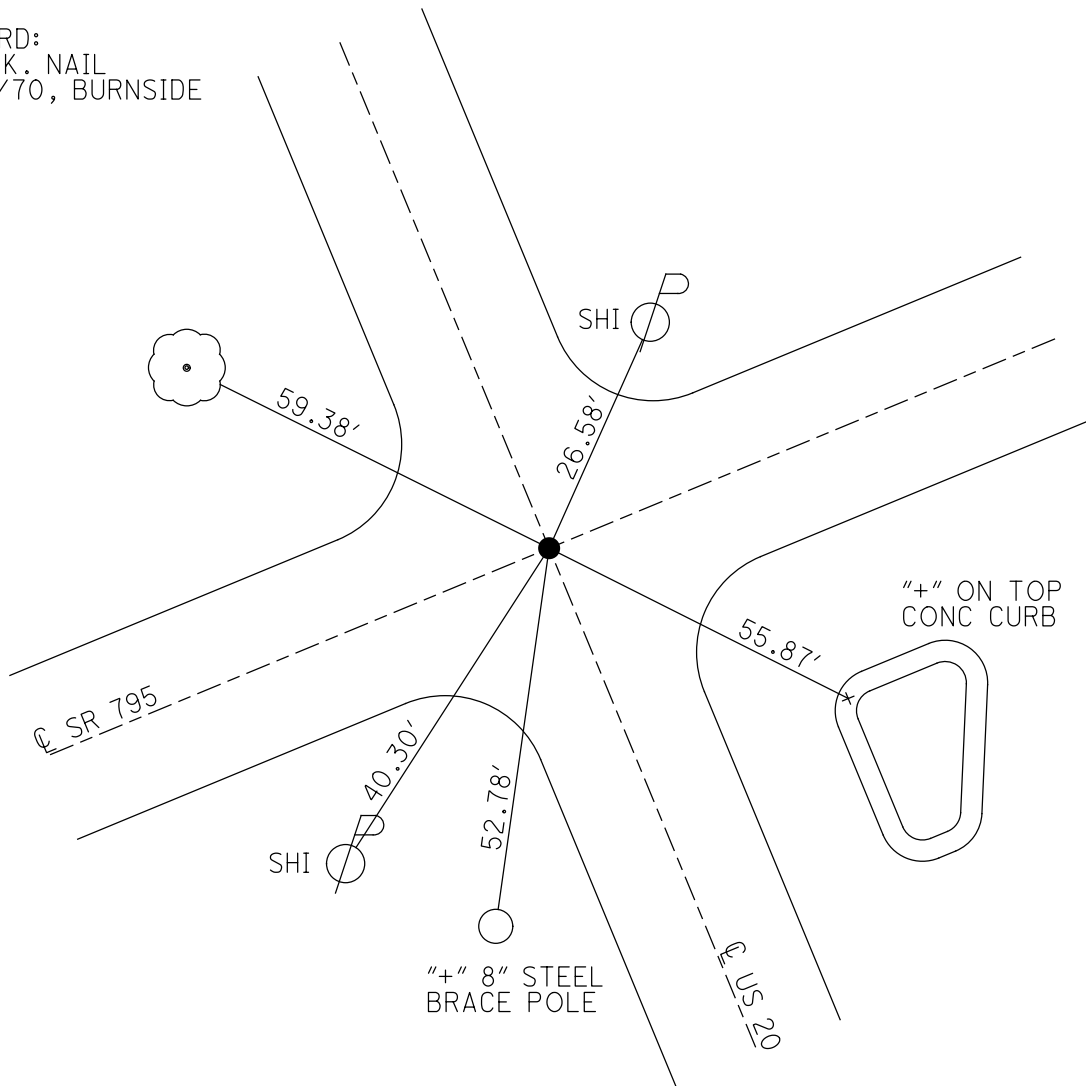

O.D.O.T. DISTRICT 2 SURVEY OFFICE (USE ONLY)

PERSONNEL _____

REFERENCE NO. 3

SHEET 4 OF 15

NOTES BURNSIDE

DATE 2/27/20

ROUTE US 20

H.C. SMITH

WEATHER CLOUDY

COUNTY WOOD

R.C. HOFFMAN

TEMP. 32°

TOWNSHIP PERRYSBURG

SECTION 12 MILE RESERVE

DWG BY NIESE

PID _____

T 4 N

TYPE MONUMENT P.K. NAIL

ON SURFACE - ~~BELOW~~ ON

OFFSET ☉ PAVEMENT ON LT : RT

- TO - EDGE PAVEMENT


STATION: 91+34.4

HORZ.DATUM: _____


GEOID: _____

GRID: NORTHING: _____

EASTING: _____

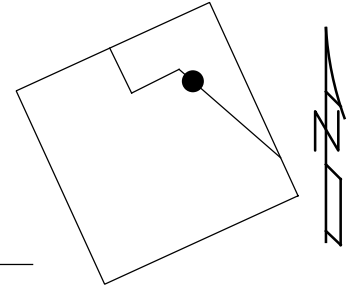

RECORD:
FD P.K. NAIL
2/27/70, BURNSIDE

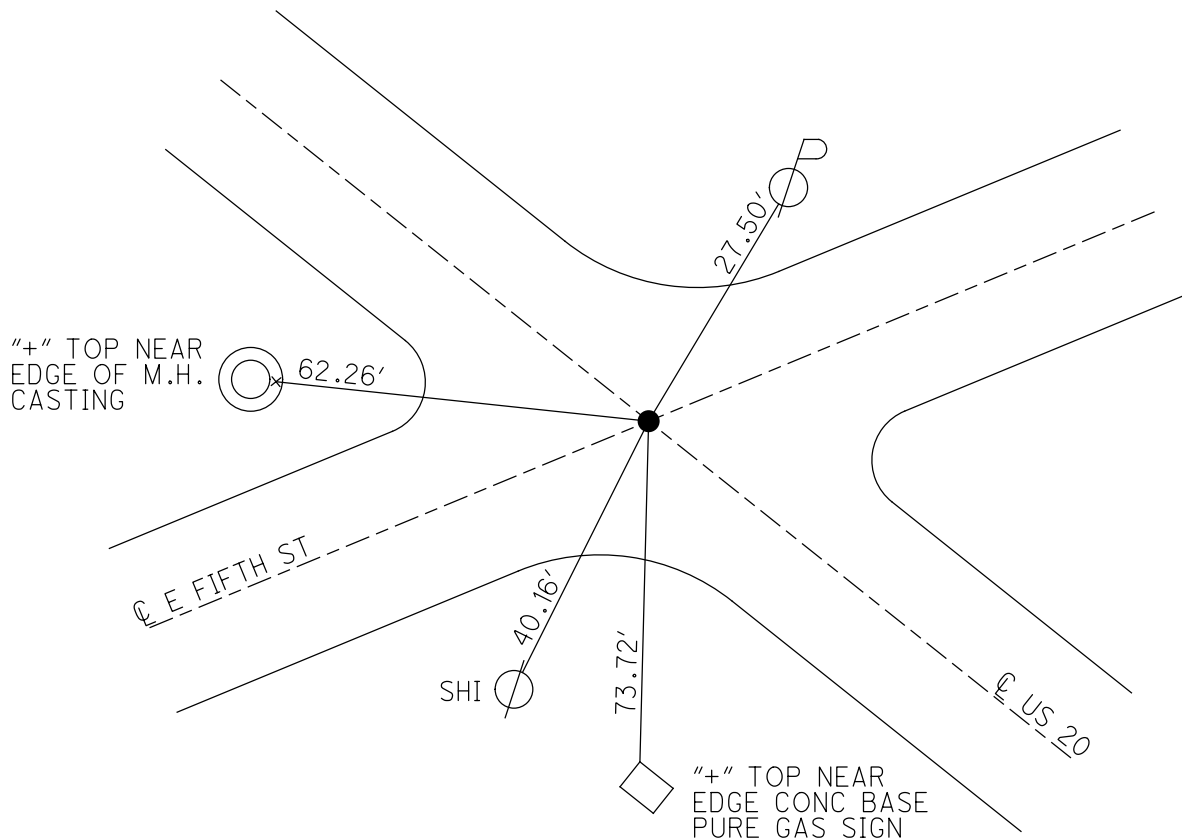


O.D.O.T. DISTRICT 2 SURVEY OFFICE (USE ONLY)


PERSONNEL _____ REFERENCE NO. 4 SHEET 1 OF 13

NOTES	<u>ROUSOS</u>	DATE	<u>4/16/02</u>	ROUTE	<u>US 20</u>
H.C.	<u>HOMAN</u>	WEATHER	<u>SUNNY</u>	COUNTY	<u>WOOD</u>
R.C.	<u>ROUSOS</u>	TEMP.	<u>85°</u>	TOWNSHIP	<u>PERRYSBURG</u>
				SECTION	<u>5</u>
				T	<u>4</u> N
				R	<u>11</u> E

TYPE MONUMENT _____ LG. R.R. SPIKE _____
 ON SURFACE - BELOW _____ 2" _____
 LEFT - Q PAV'T - RIGHT _____ ON _____
 - TO - EDGE PAVEMENT _____
 S.L.M. _____ 102+32 _____
 GRID: NORTHING: _____ EASTING: _____

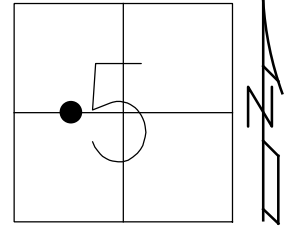


RECORD:
 R.R. SPK
 08-16-88, MB
 FD R.R. SPIKE
 4-16-02, DH

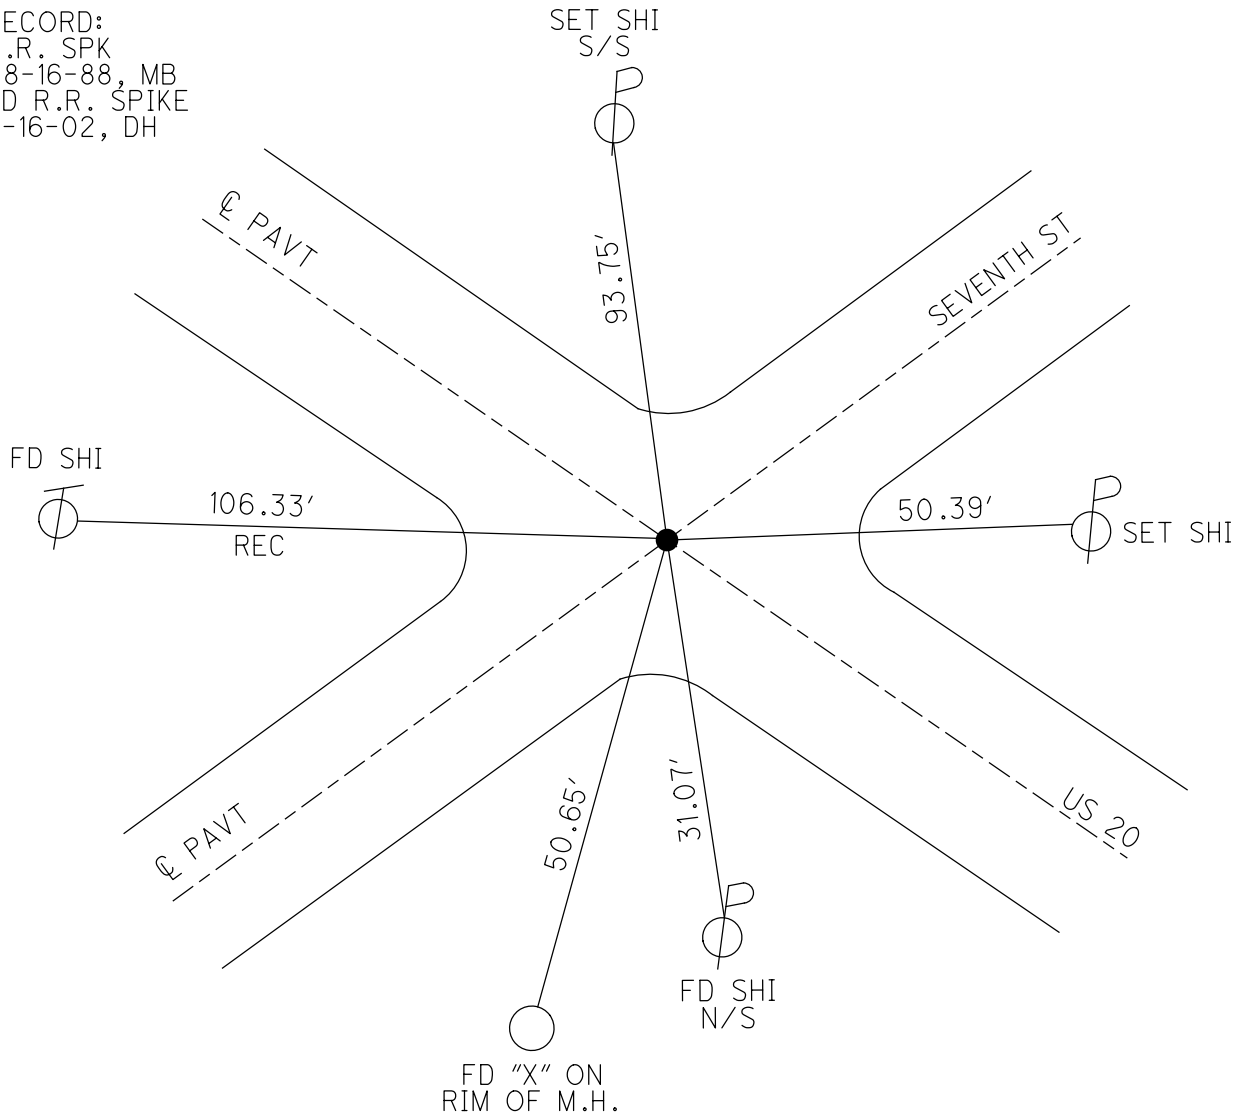


O.D.O.T. DISTRICT 2 SURVEY OFFICE (USE ONLY)

PERSONNEL	REFERENCE NO.	<u>5</u>	SHEET	<u>2</u>	OF	<u>13</u>
NOTES	<u>ROUSOS</u>	DATE	<u>4/16/02</u>	ROUTE	<u>US 20</u>	
H.C.	<u>HOMAN</u>	WEATHER	<u>SUNNY</u>	COUNTY	<u>WOOD</u>	
R.C.	<u>ROUSOS</u>	TEMP.	<u>84°</u>	TOWNSHIP	<u>PERRYSBURG</u>	
				SECTION	<u>5</u>	
				T	<u>4</u>	R
					<u>N</u>	<u>11</u>
					<u>E</u>	

TYPE MONUMENT _____ PK NAIL _____
 ON SURFACE - BELOW _____ ON _____
 LEFT - C PAV'T - RIGHT 3' _____
 - TO - EDGE PAVEMENT _____
 S.L.M. _____ 110+12 _____
 GRID: NORTHING: _____ EASTING: _____

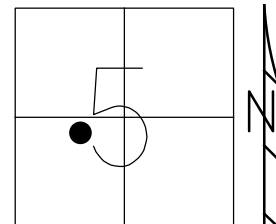


RECORD:
 SET PK & WASHER
 08-16-88, MB
 FD P.K. NAIL
 4-16-02, DH

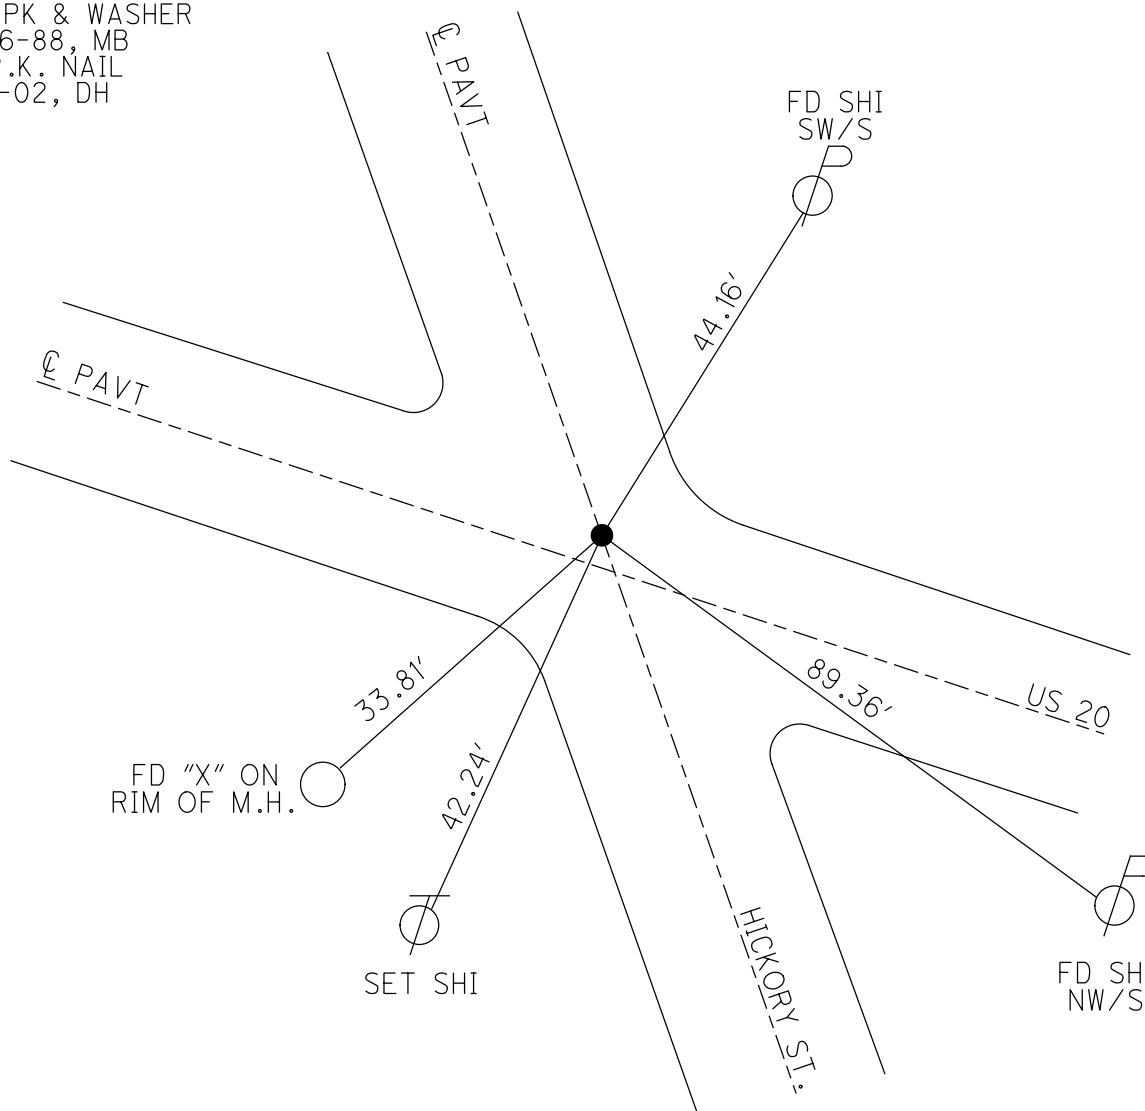


O.D.O.T. DISTRICT 2 SURVEY OFFICE (USE ONLY)

PERSONNEL _____ REFERENCE NO. 6 SHEET 3 OF 13
 NOTES LEU DATE 03-13-2018 ROUTE US20
 H.C. O'DONNELL WEATHER LIGHT SNOW COUNTY WOOD
 R.C. AUBLE TEMP. 29° TOWNSHIP PERRYSBURG
 SEAMAN SECTION RT 5
 DWG BY JAMES PID 102808 T 4 N R 11 E

TYPE MONUMENT MAG/WASHER
 ON SURFACE - ~~BELOW~~ ON
 OFFSET Q PAVEMENT ON ~~LT~~ : ~~RT~~
- TO - EDGE PAVEMENT
 STATION: 127+24.8

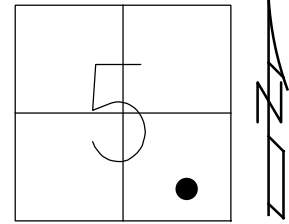

HORIZ.DATUM: NAD83 2011 GEOID: NAVD88 2012A
 GRID: NORTHING: 689232.171 EASTING: 1664533.281

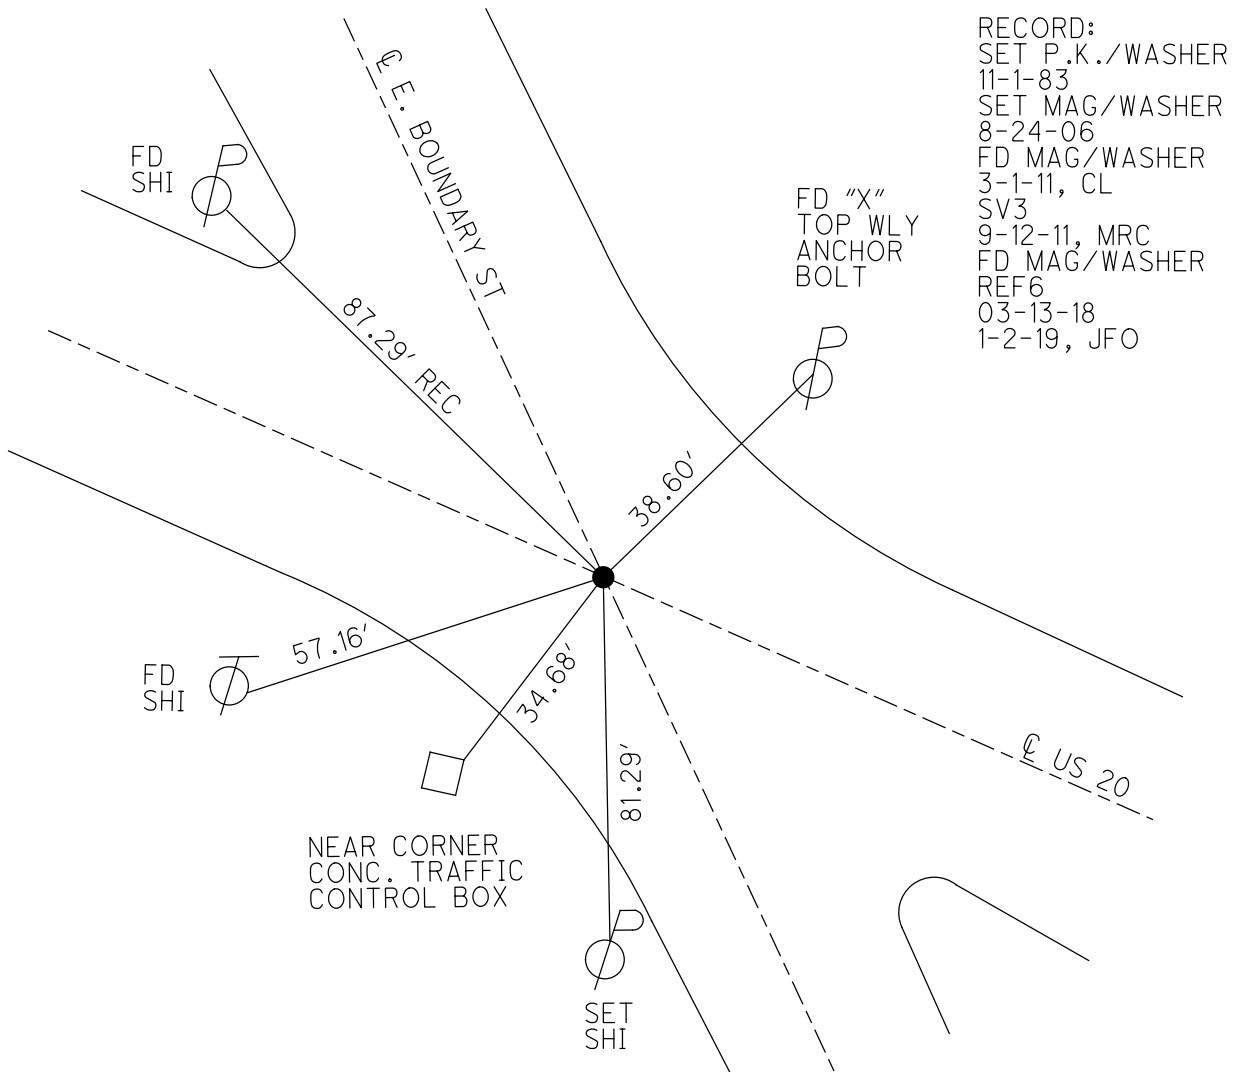

O.D.O.T. DISTRICT 2 SURVEY OFFICE (USE ONLY)

PERSONNEL

REFERENCE NO. 7

SHEET 4 OF 13

NOTES LEU

DATE 03-13-18

ROUTE US 20

H.C. O'DONNELL

WEATHER CLOUDY

COUNTY WOOD

R.C. AUBLE

TEMP. 31°

TOWNSHIP PERRYSBURG

SEAMAN

SECTION RT 5

DWG BY JAMES PID 102808

T 4 N R 11 E

TYPE MONUMENT MAG/WASHER

ON SURFACE - ~~BELOW~~ ON

OFFSET \odot PAVEMENT 5.0' LT : ~~RT~~

- TO - EDGE PAVEMENT



STATION: 138+77

HORIZ.DATUM: NAD83 2011

GEOID: NAVD88 2012A

GRID: NORTHING: 688663.427

EASTING: 1665555.438

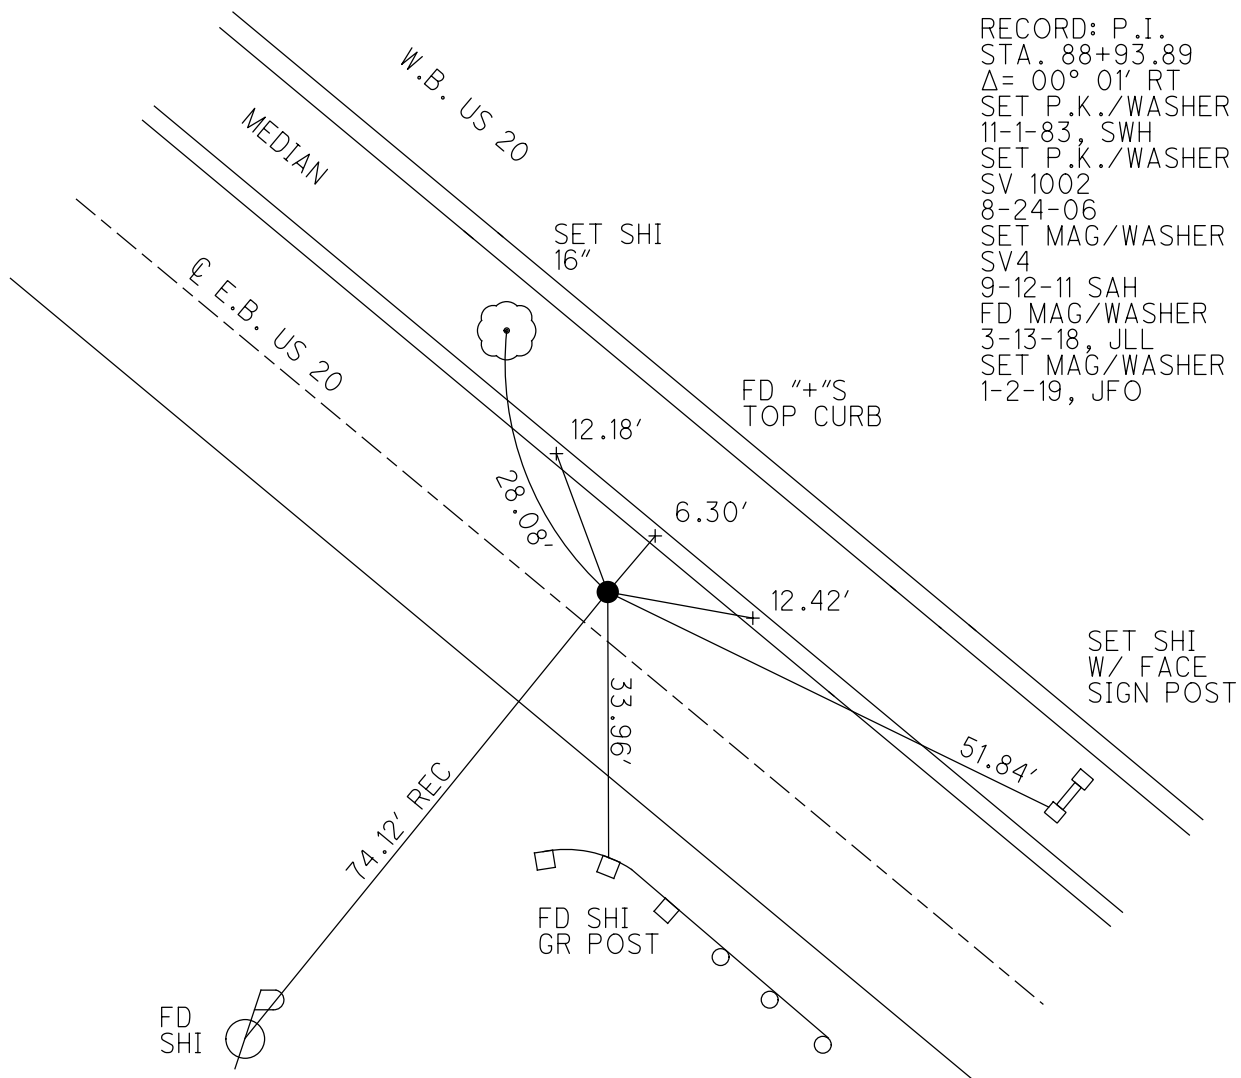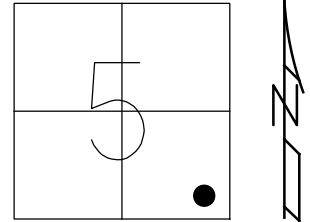


RECORD: P.I.
 STA. 88+93.89
 $\Delta = 00^\circ 01' RT$
 SET P.K./WASHER
 11-1-83, SWH
 SET P.K./WASHER
 SV 1002
 8-24-06
 SET MAG/WASHER
 SV4
 9-12-11 SAH
 FD MAG/WASHER
 3-13-18, JLL
 SET MAG/WASHER
 1-2-19, JFO

O.D.O.T. DISTRICT 2 SURVEY OFFICE (USE ONLY)


PERSONNEL _____ REFERENCE NO. 8 SHEET 5 OF 13
 NOTES HOFFMAN DATE 9/7/83 ROUTE US 20
 H.C. LOEHRKE WEATHER CLEAR COUNTY WOOD
 R.C. HOUSEHOLDER TEMP. 70° TOWNSHIP PERRYSBURG
 BARNHISEL SECTION 9
 DWG BY JAMES PID 102808 T 4 N R 11 E

TYPE MONUMENT P.K./WASHER
 ON SURFACE - ~~BELOW~~ ON
 OFFSET C PAVEMENT _____ $\text{L} \neq \text{R}$
 _____ TO _____ EDGE PAVEMENT
 STATION: 155+44.73

HORZ. DATUM: _____ GEOID: _____
 GRID: NORTHING: _____ EASTING: _____

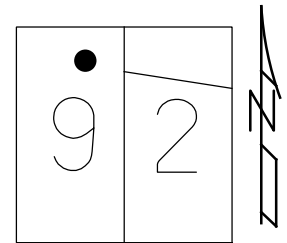

RECORD:
 FD P.K./WASHER
 9/7/83
 SET P.K./WASHER
 11-1-83
 DNF
 8-24-06, 9-12-11
 3-13-18, JFO

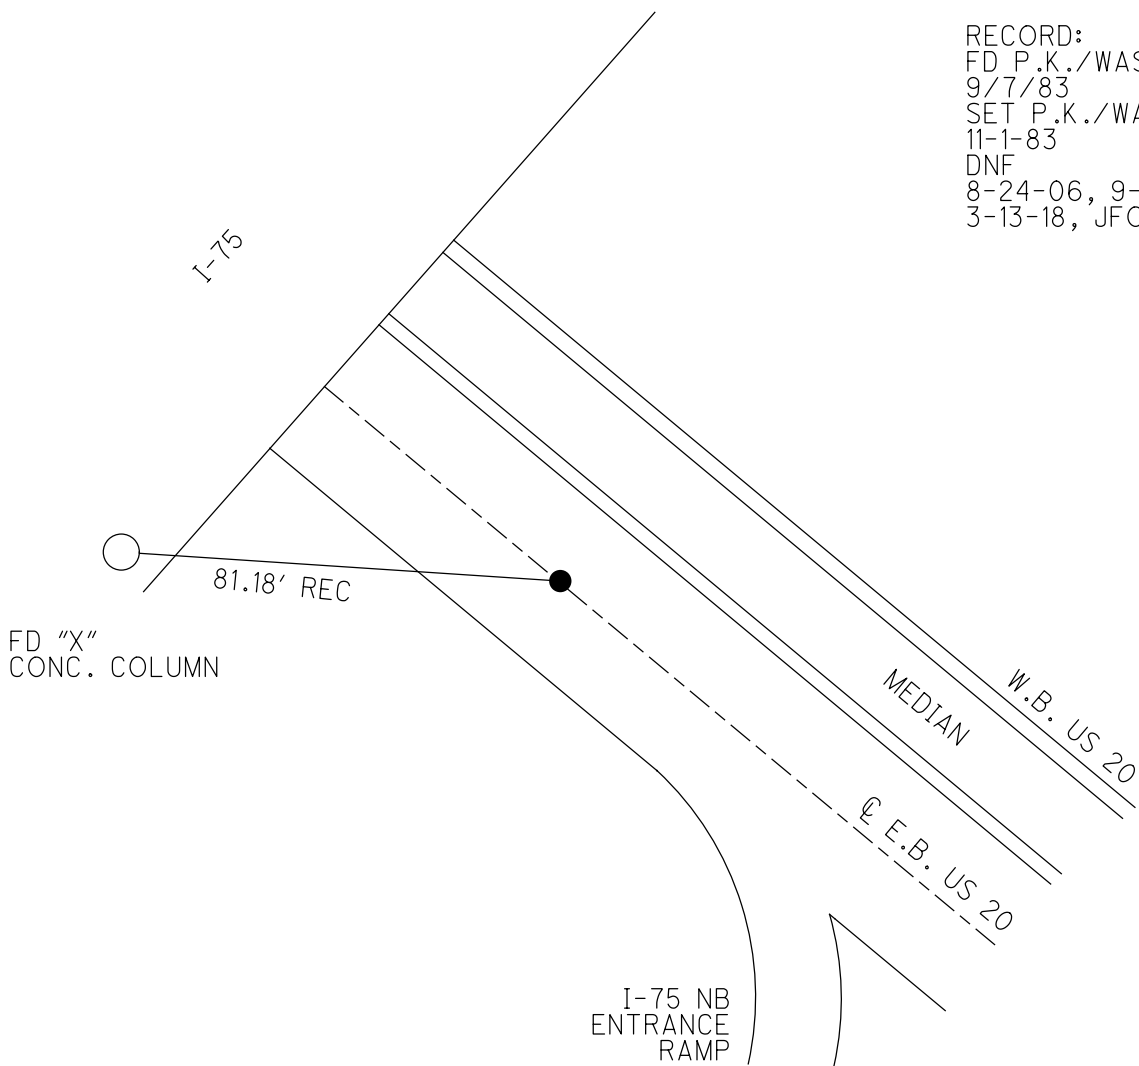

O.D.O.T. DISTRICT 2 SURVEY OFFICE (USE ONLY)

PERSONNEL

REFERENCE NO. 9

SHEET 6 OF 13

NOTES HOFFMAN

DATE 9/7/83

ROUTE US 20

H.C. LOERHKE

WEATHER CLEAR

COUNTY WOOD

R.C. HOUSEHOLDER

TEMP. 70°

TOWNSHIP PERRYSBURG

BARNHISEL

SECTION 9

DWG BY JAMES

PID 102808

T 4 N R 11 E

TYPE MONUMENT P.K./WASHER

ON SURFACE - ~~BELOW~~ ON

OFFSET ☉ PAVEMENT _____ LT : RT

- TO - EDGE PAVEMENT


STATION: 160+51

HORZ.DATUM: _____


GEOID: _____

GRID: NORTHING: _____

EASTING: _____

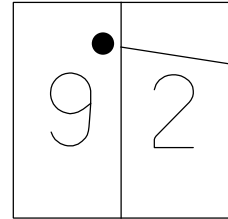

RECORD:
FD P.K./WASHER
9-7-83, CL
SET P.K./WASHER
11-1-83
DNF
9-12-11, SAH
3-13-18, JFO

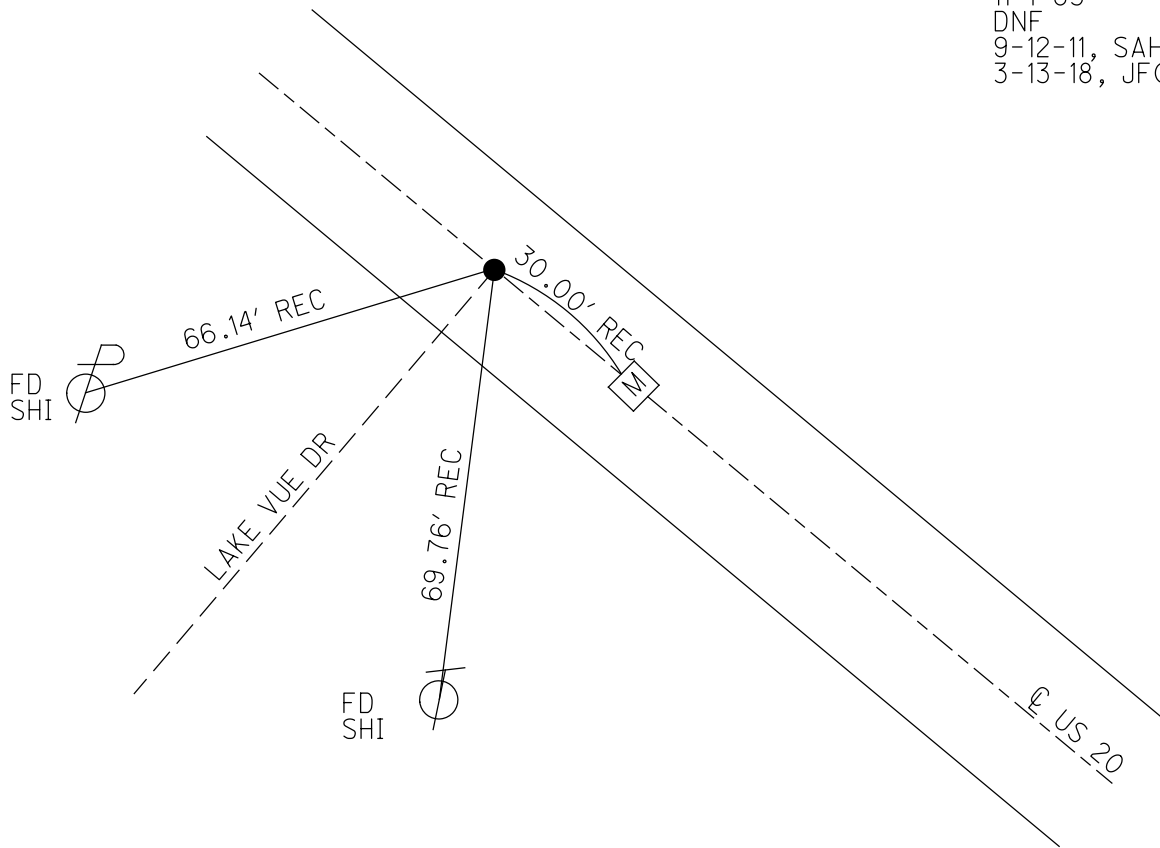

O.D.O.T. DISTRICT 2 SURVEY OFFICE (USE ONLY)

PERSONNEL

REFERENCE NO. 10

SHEET 7 OF 13

NOTES HOFFMAN

DATE 9/7/83

ROUTE US 20

H.C. LOEHRKE

WEATHER CLEAR

COUNTY WOOD

R.C. HOUSEHOLDER

TEMP. 70°

TOWNSHIP PERRYSBURG

BARNHISEL

SECTION 9

DWG BY JAMES

PID 83592, 102808

T 4 N R 11 E

TYPE MONUMENT MONBOX

ON SURFACE - ~~BELOW~~ ON

OFFSET \odot PAVEMENT _____ LT : RT

- TO - EDGE PAVEMENT


STATION: 160+91.49

HORZ.DATUM: NAD83 2011


GEOID: NAVD88 2012A

GRID: NORTHING: 687596.207

EASTING: 1667462.539

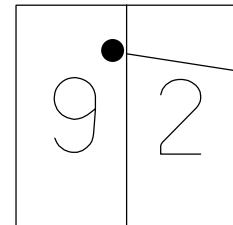

RECORD:
 FD MONBOX
 9/7/83, CL
 FD MONBOX
 SV1006
 9-12-11, SAH
 MONBOX BURIED
 3-13-18, JFO
 FD MONBOX
 W/ 1" IPIN
 REF10
 4-18-18, JFO

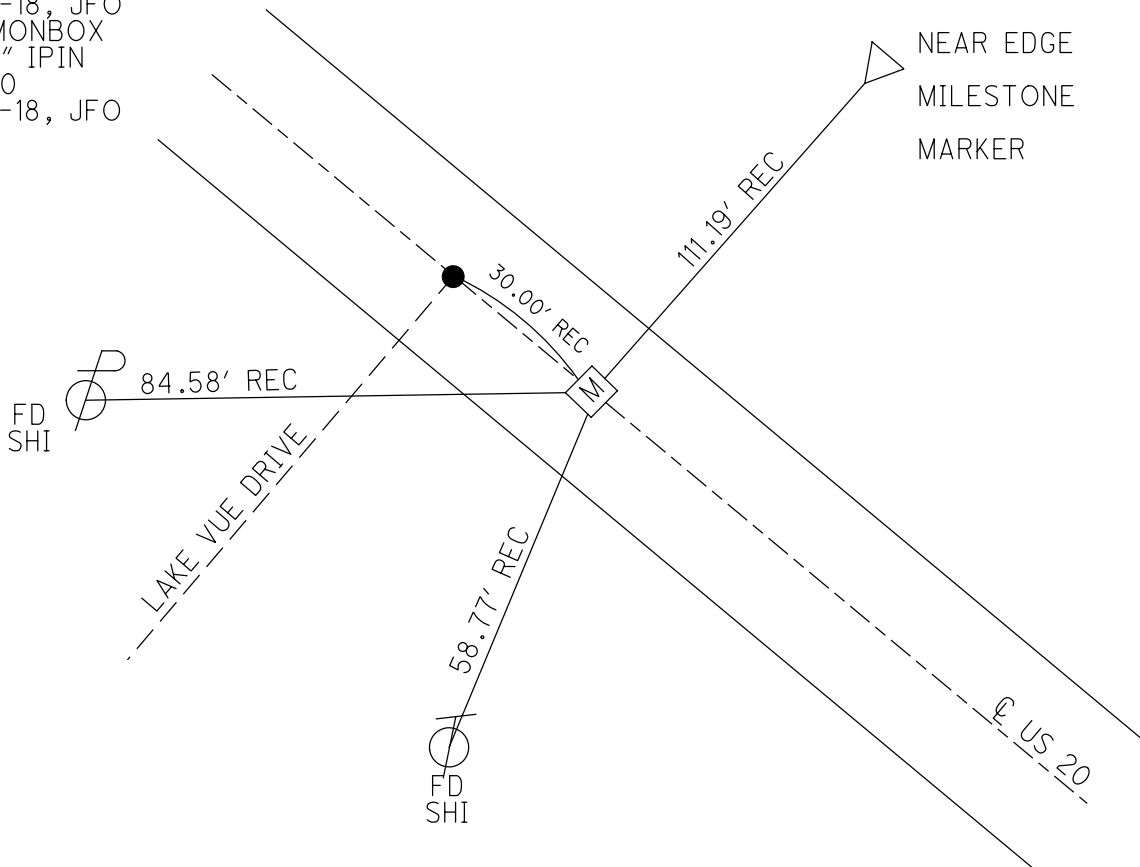

O.D.O.T. DISTRICT 2 SURVEY OFFICE (USE ONLY)

PERSONNEL

REFERENCE NO. 12

SHEET 8 OF 13

NOTES HOFFMAN
 H.C. LOEHRKE
 R.C. HOUSEHOLDER
BARNHISEL

DATE 9/7/83
 WEATHER CLOUDY
 TEMP. 31°

ROUTE US 20
 COUNTY WOOD
 TOWNSHIP PERRYSBURG
 SECTION 2

DWG BY JAMES PID 83592, 102808

T 4 N R 11 E

TYPE MONUMENT MONBOX

ON SURFACE - ~~BELOW~~ ON

OFFSET 0 PAVEMENT LT : RT

- TO - EDGE PAVEMENT


STATION: 185+86

HORZ. DATUM: NAD83 2011


GEOID: NAVD88 2012A

GRID: NORTHING: 686368.252

EASTING: 1669633.372

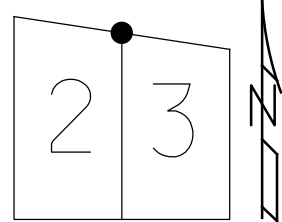


RECORD:
 FD MONBOX
 9/7/83, CL
 FD MONBOX
 SV7
 9-12-11, SAH
 FD MONBOX
 3-13-18, JFO
 FD MONBOX
 W/ 1" IPIN
 REF12
 4-18-18, JFO

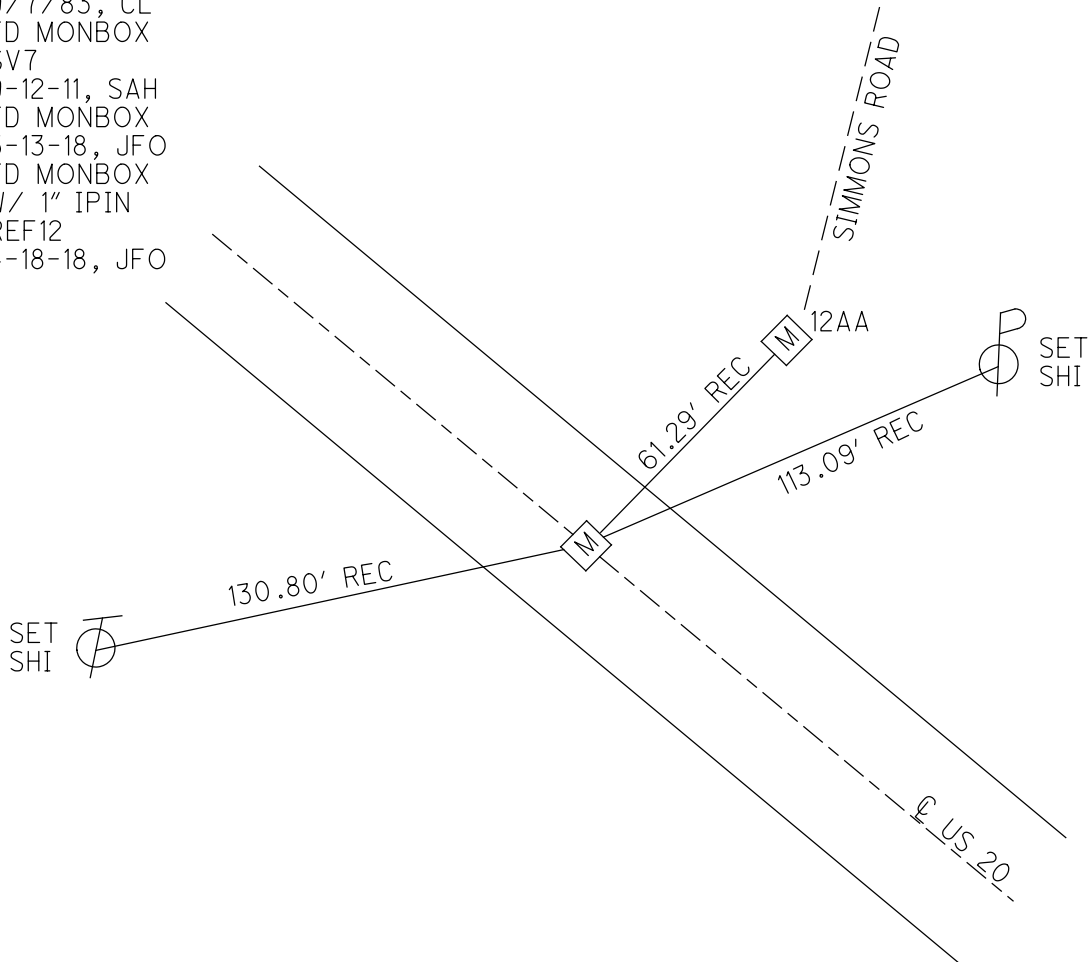

O.D.O.T. DISTRICT 2 SURVEY OFFICE (USE ONLY)


PERSONNEL _____ REFERENCE NO. 12 AA SHEET 9 OF 13
 NOTES HOFFMAN DATE 9/7/83 ROUTE US 20
 H.C. LOEHRKE WEATHER CLEAR COUNTY WOOD
 R.C. HOUSEHOLDER TEMP. 70° TOWNSHIP PERRYSBURG
 BARNHISEL SECTION 2
 DWG BY JAMES PID 83592, 102808 T 4 N R 11 E

TYPE MONUMENT MONBOX
 ON SURFACE - ~~BELOW~~ ON
 OFFSET \odot PAVEMENT _____ LT : RT
 - TO EDGE PAVEMENT
 STATION: 185+86

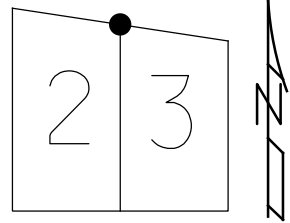

HORZ. DATUM: NAD88 2011 GEOID: NAVD88 2012A
 GRID: NORTHING: 686421.786 EASTING: 1669663.103

RECORD:
 SIMMONS RD @
 STA 135+73.75±
 5-19-80
 FD MONBOX
 9/7/83, CL
 FD MONBOX
 SV7
 9-12-11 SAH
 FD MONBOX
 W/ IPIN
 RUSTED TO
 A POINT
 3-13-18, JFO

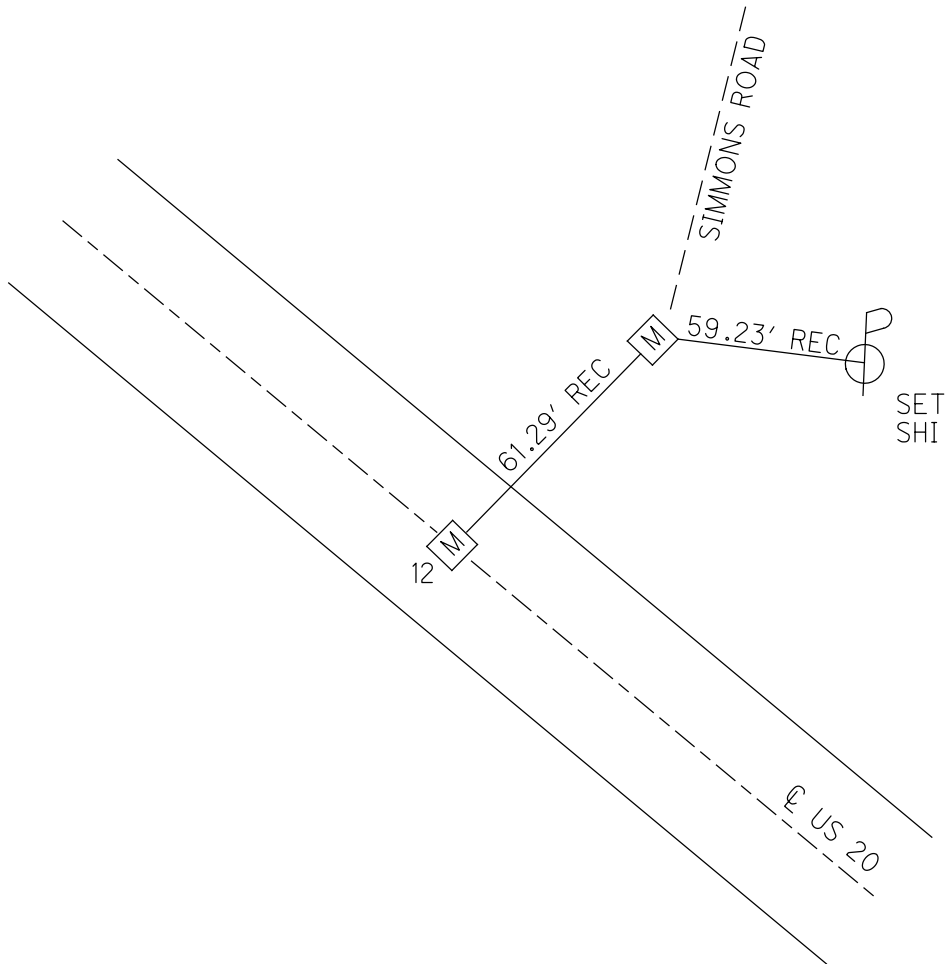

O.D.O.T. DISTRICT 2 SURVEY OFFICE (USE ONLY)

PERSONNEL

REFERENCE NO. 12 A

SHEET 10 OF 13

NOTES CRONIN DATE 10/7/81

ROUTE US 20

H.C. RIPPLE WEATHER -

COUNTY WOOD

R.C. GEYMAN TEMP. 45°

TOWNSHIP PERRYSBURG

SCHNEIDER, MOSSER, BARBOUR

SECTION 3

DWG BY JAMES PID 102808

T 4 N R 11 E

TYPE MONUMENT P.K. NAIL

~~ON SURFACE~~ - BELOW 1"


OFFSET ☉ PAVEMENT _____ LT : RT

- TO - EDGE PAVEMENT


STATION: _____

HORIZ.DATUM: _____ GEOID: _____

GRID: NORTHING: _____ EASTING: _____

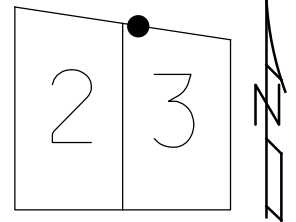

RECORD:
 STA. 144+25±
 FD. P.K. NAIL
 1" DOWN
 5-19-80, DC
 FD P.K. NAIL
 1" DOWN
 10-7-81, DC
 DNF
 9-12-11

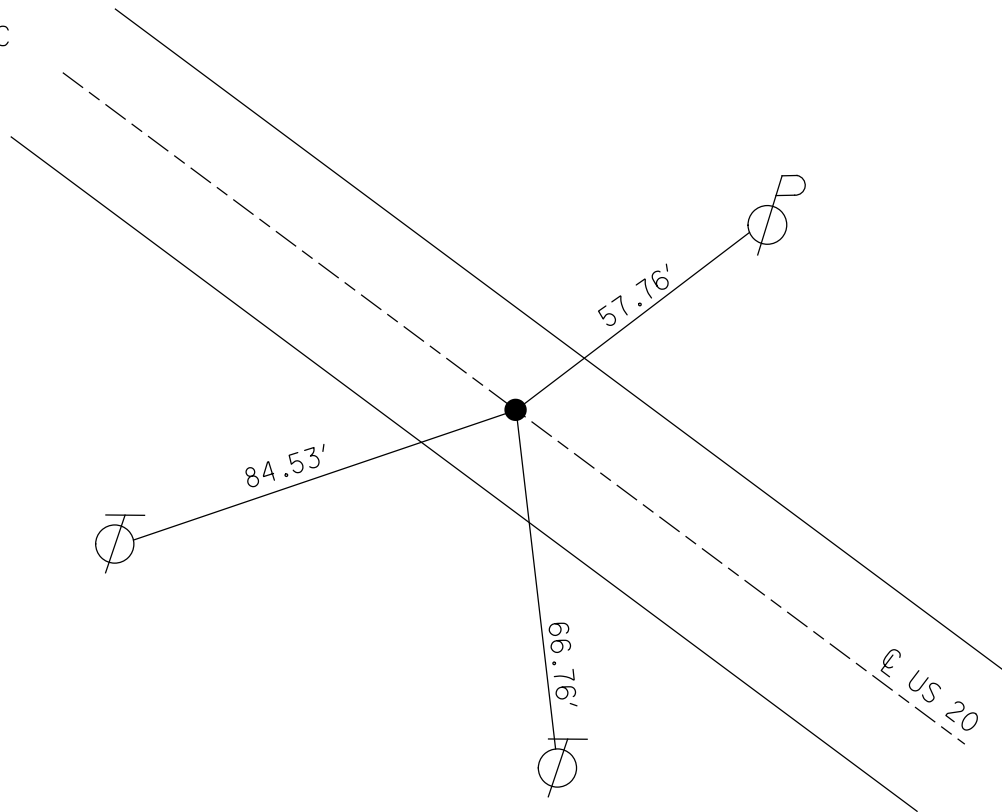

O.D.O.T. DISTRICT 2 SURVEY OFFICE (USE ONLY)

PERSONNEL _____ REFERENCE NO. 13 SHEET 11 OF 13

NOTES HOFFMAN DATE 9/7/83 ROUTE US 20
 H.C. LOEHRKE WEATHER CLEAR COUNTY WOOD
 R.C. HOUSEHOLDER TEMP. 70° TOWNSHIP PERRYSBURG
BARNHISEL SECTION 3

DWG BY JAMES PID 83592, 102808 T 4 N R 11 E

TYPE MONUMENT MONBOX

ON SURFACE - ~~BELOW~~ ON _____


OFFSET \varnothing PAVEMENT _____ LT : RT

_____ TO _____ EDGE PAVEMENT


STATION: 200+64

HORZ.DATUM: NAD83 2011 GEOID: NAVD88 2012A

GRID: NORTHING: 685617.649 EASTING: 1670961.809

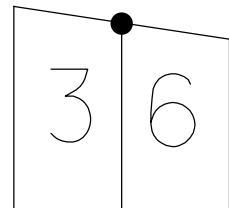

RECORD:
 FD MNOBOX
 9/7/83, CL
 FD MONBOX
 BROKEN
 8-25-06
 FD MONBOX
 SV8
 9-12-11
 FD MONBOX
 W/ 3/4" IPIN
 REF 13
 3-13-18, JFO

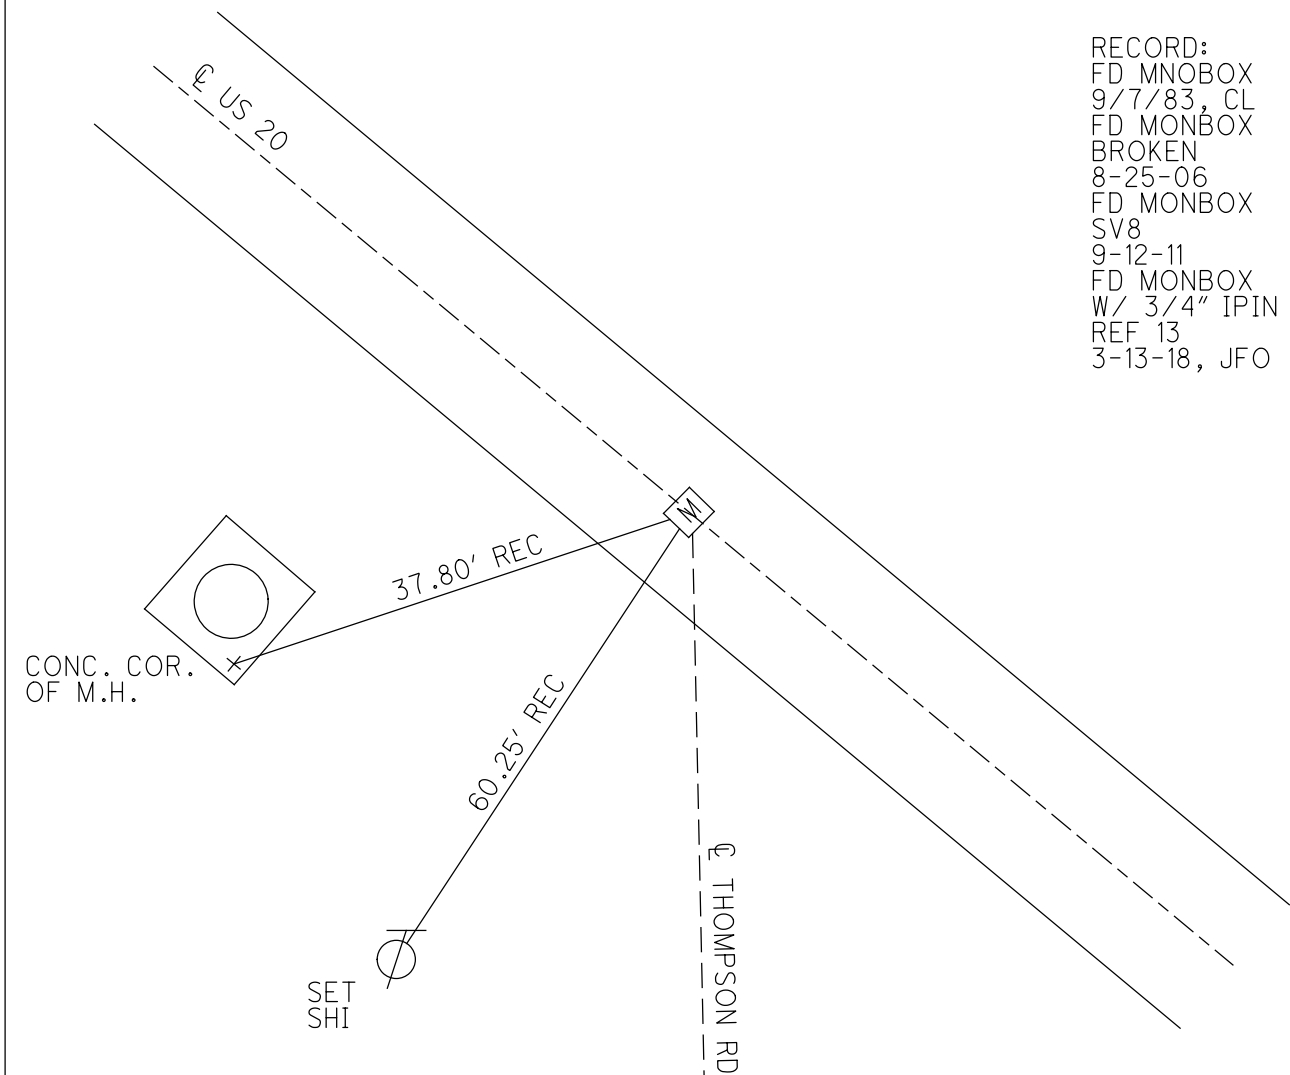

O.D.O.T. DISTRICT 2 SURVEY OFFICE (USE ONLY)

PERSONNEL

REFERENCE NO. 16 A

SHEET 1 OF 4

NOTES LEU

DATE 3-13-18

ROUTE US 20

H.C. O'DONNELL

WEATHER SNOW

COUNTY WOOD

R.C. AUBLE

TEMP. 34°

TOWNSHIP PERRYSBURG

SEAMAN

SECTION 11

DWG BY JAMES PID 102808

T 4 N R U S E

TYPE MONUMENT MAG/WASHER

ON SURFACE - BELOW ON

OFFSET \odot PAVEMENT - LT : RT

- TO - EDGE PAVEMENT


STATION: 240+69.21

HORZ. DATUM: NAD83 2011


GEOID: NAVD88 2012A

GRID: NORTHING: 683661.974

EASTING: 1674422.456

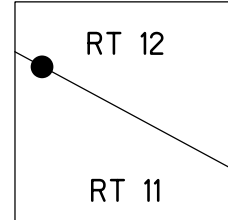


RECORD: P.I.
 $\Delta = 0^\circ 52' RT$
 FD P.K./WASHER
 6/29/93, CL
 SET MAG/WASHER
 9/9/11, MC
 SVA16
 9/12/11, SAH
 FD MAG/WASHER
 4/30/14, TMR
 SET MAG/WASHER
 1-2-19, JFO

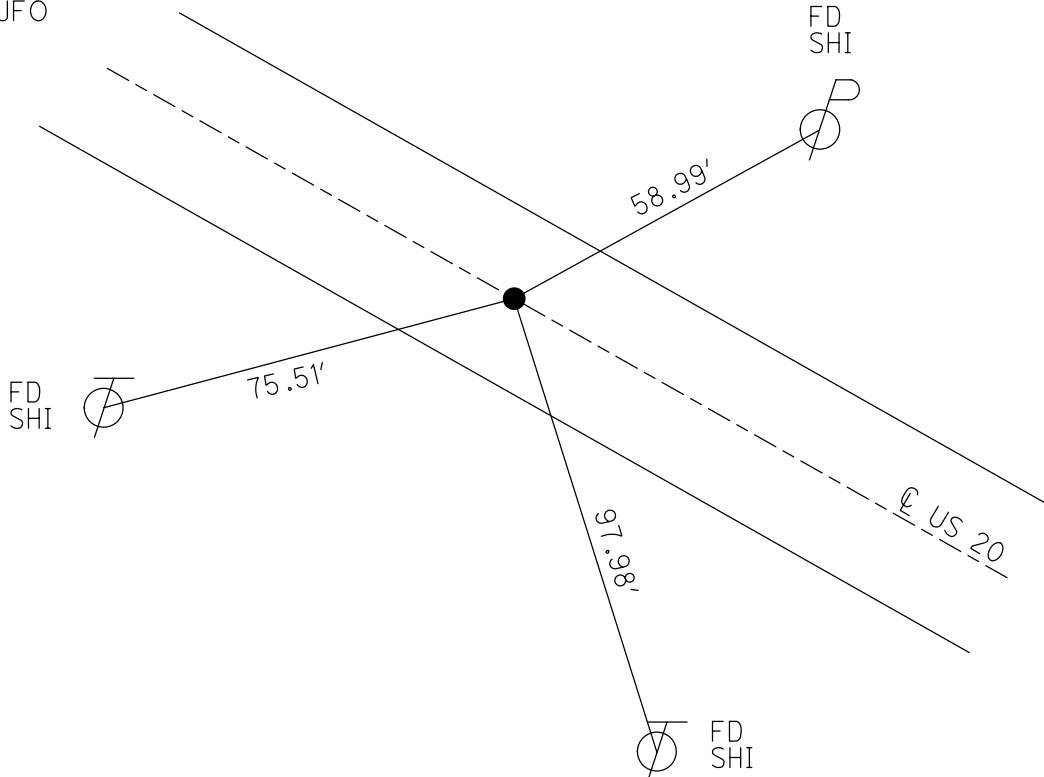


O.D.O.T. DISTRICT 2 SURVEY OFFICE (USE ONLY)

PERSONNEL	REFERENCE NO. <u>16 B</u>	SHEET <u>2</u> OF <u>4</u>
NOTES <u>LEU</u>	DATE <u>3-13-18</u>	ROUTE <u>US 20</u>
H.C. <u>O'DONNELL</u>	WEATHER <u>CLOUDY</u>	COUNTY <u>WOOD</u>
R.C. <u>AUBLE</u>	TEMP. <u>34°</u>	TOWNSHIP <u>PERRYSBURG</u>
<u>SEAMAN</u>		SECTION <u>11</u>
DWG BY <u>JAMES</u>	PID <u>102808</u>	T <u>4</u> N R <u>USE</u>

TYPE MONUMENT MAG/WASHER
 ON SURFACE - ~~BELOW~~ ON
 OFFSET \odot PAVEMENT 12.5' LT : ~~RT~~
0.2' TO LT EDGE PAVEMENT
 STATION: 246+00.31

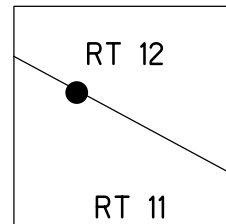

HORIZ.DATUM: NAD83 2011 GEOID: NAVD88 2012A
 GRID: NORTHING: 683400.903 EASTING: 1674884.912

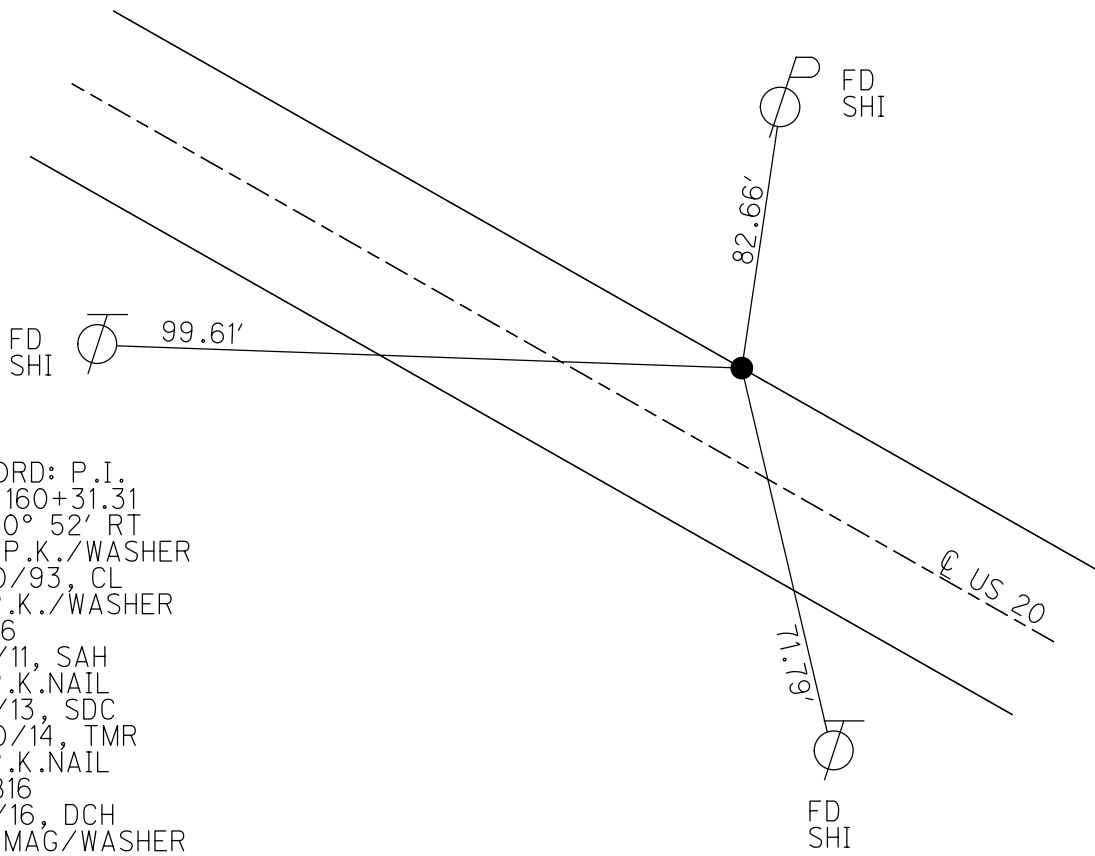


RECORD: P.I.
 STA 160+31.31
 $\Delta = 0^\circ 52' RT$
 SET P.K./WASHER
 6/20/93, CL
 FD P.K./WASHER
 SVB16
 9/9/11, SAH
 FD P.K.NAIL
 6/3/13, SDC
 4/30/14, TMR
 FD P.K.NAIL
 REFB16
 8/8/16, DCH
 SET MAG/WASHER
 BY COORDINATES
 3-13-18, JFO
 FD MAG/WASHER
 1-2-19, JFO

O.D.O.T. DISTRICT 2 SURVEY OFFICE (USE ONLY)

PERSONNEL _____ REFERENCE NO. 17 SHEET 3 OF 4
 NOTES LEU DATE 10-23-16 ROUTE US 20
 H.C. HOMAN WEATHER SUNNY COUNTY WOOD
 R.C. LEU TEMP. 60° TOWNSHIP PERRYSBURG
 SECTION R.T. 11
T 4 N R 5 E


TYPE MONUMENT MAG/WASHER
 ON SURFACE - ~~BELOW~~ ON _____
 LEFT - CL PAV'T - ~~RIGHT~~ 13.8'
2' LT TO LT EDGE PAVEMENT
 S.L.M. 261+36.00

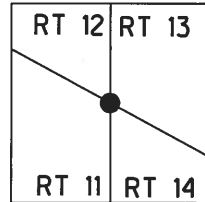

Grid: Northing: 682625.247 Easting: 1676210.489

RECOIRD: P.I.
 1948 PLANS
 S.H. 275 SEC.C
 STA 175+69.18
 $\Delta = 0^\circ 48' 30''$ LT
 $D = 0^\circ 04'$
 $R = 85943.70'$
 $T = 606.26'$
 $L = 1212.50'$
 $E = 1.93$


RECORD:
 FD BRASS MON
 2" DOWN
 1953, 1972, 1975, 1980
 FD BRASS MON
 4" DOWN
 1992
 SET P.K./WASHER
 6-29-93, CL
 SET P.K./WASHER
 SV17
 9-9-11, SAH
 FD ADJ.BRASS MON
 4" DOWN
 6/3/13, SDC
 SET MAG/WASHER
 FINREF17
 4/30/14, TMR
 FD MONBOX
 W/BRASS MON & "X"
 10-23-16, JLL

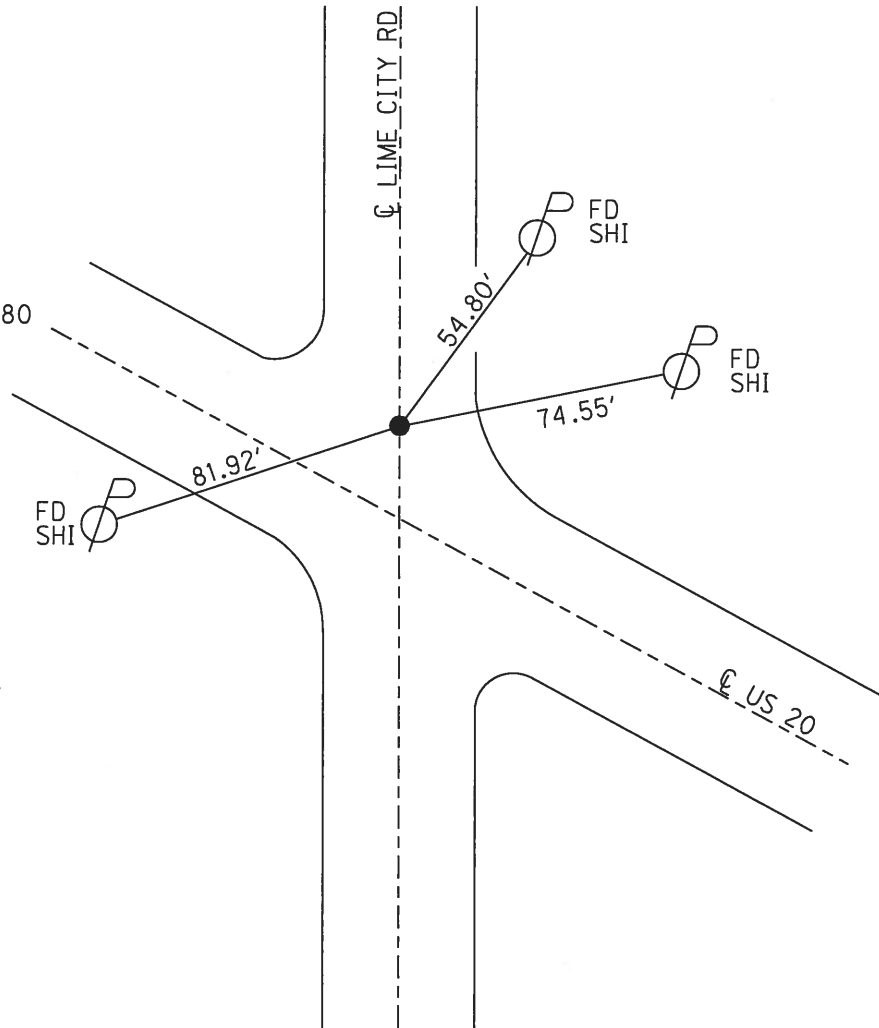


O.D.O.T. DISTRICT 2 SURVEY OFFICE (USE ONLY)

PERSONNEL _____ REFERENCE NO. 18 SHEET 4 OF 4
 NOTES LEU DATE 10/23/16 ROUTE US 20
 H.C. HOMAN WEATHER CLOUDY COUNTY WOOD
 R.C. LEU TEMP. 60°F TOWNSHIP PERRYSBURG
 SECTION R.T.14
T 4 N R U S E

TYPE MONUMENT MAG/WASHER
 ON SURFACE - ~~BELOW~~ ON _____
 LEFT - ℄ PAV'T - RIGHT 14.5'
2.6 LT TO LT EDGE PAVEMENT
S.L.M. 277+72.41
 Grid: Northing: 681819.071 Easting: 1677634.551

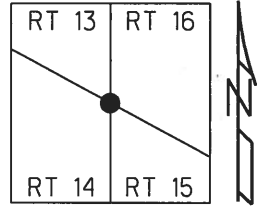


RECORD:
 1948 PLANS
 S.H. 275 SEC. C.
 REC P.I.
 STA 192+05.70
 25*64= 00° 32' RT
 D= 0° 03'
 R= 114591.60'
 L= 1066.67'
 T=533/33
 E=1.24'
 SET IRON BAR
 1953
 FD IPIN
 4" DOWN
 1972, 1975
 FD IPIN
 7" DOWN
 1980
 SET P.K./WASHER
 1992
 FD P.K./WASHER
 SV18
 9/12/11, SAH
 FD MONBOX
 W/IPIN
 REF18
 10-23-16, JLL

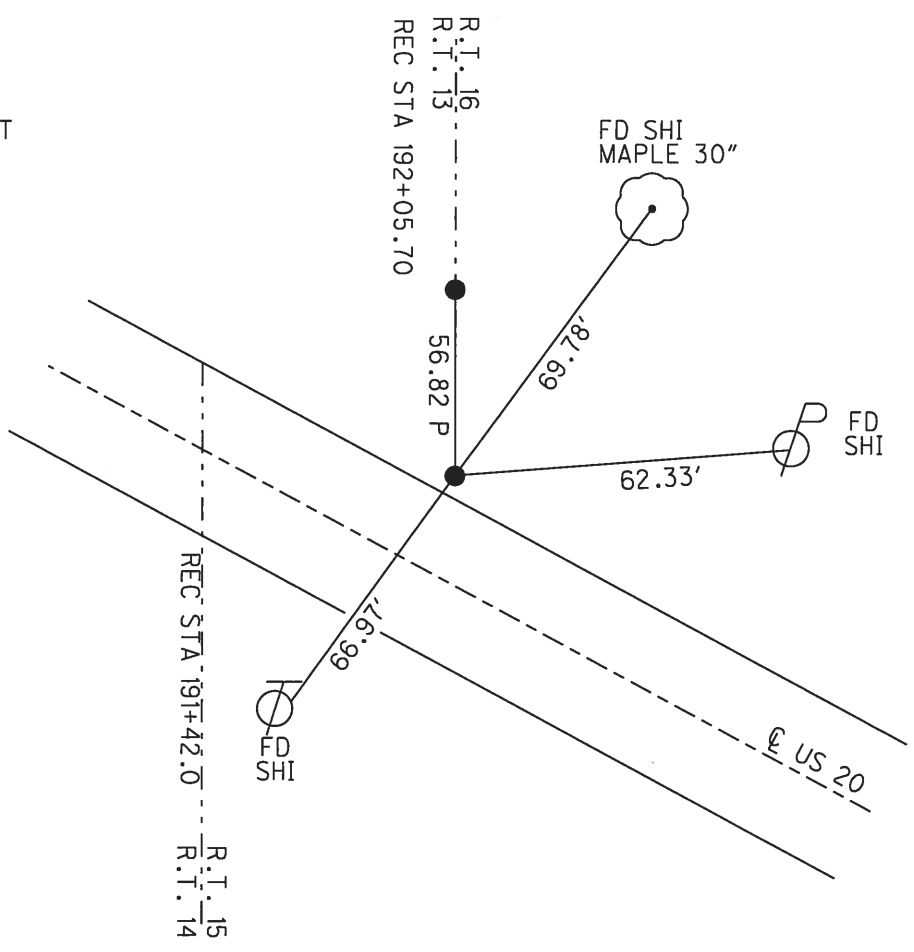

O.D.O.T. DISTRICT 2 SURVEY OFFICE (USE ONLY)


PERSONNEL	REFERENCE NO.	19	SHEET	1	OF	23
NOTES	LEU	DATE	8/10/16	ROUTE	US 20	
H.C.	HOMAN	WEATHER	CLEAR	COUNTY	WOOD	
R.C.	LEU	TEMP.	88°	TOWNSHIP	PERRYSBURG	
				SECTION	RT 16	
				T	4	N
				R	11	E

TYPE MONUMENT P.K.SHANK
 ON SURFACE - ~~BELOW~~ ON
 LEFT - ☉ PAV'T - ~~RIGHT~~ 13.7'
2.5' LT TO LT EDGE PAVEMENT
 S.L.M. 292+48

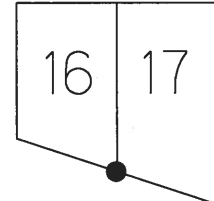

GRID: NORTHING: 681099.036 EASTING: 1678877.968


RECORD: P.I.
 1948 PLANS
 S.H. 275 SEC. C
 STA 206+43.18
 25#64= 0°26' 30" LT
 D= 0°02'
 R= 171887.30'
 T= 662.51'
 L= 1325.00'
 E= 1.29
 P.C.= 199+80.67'
 P.T.= 213+05.67'
 FD R.R.SPIKE
 1953
 FD P.K./WASHER
 1972, 1975
 FD BRASS MON
 2 3/4" DOWN
 1980
 SET P.K./WASHER
 1992
 FD P.K./WASHER
 6/24/02, KPM
 SET MAG/WASHER
 3/4/04, MB
 FD P.K.SHANK
 REF19
 8/10/16, DCH
 FD MONBOX
 W/BRASS MON &"X"
 10-23-17, JLL

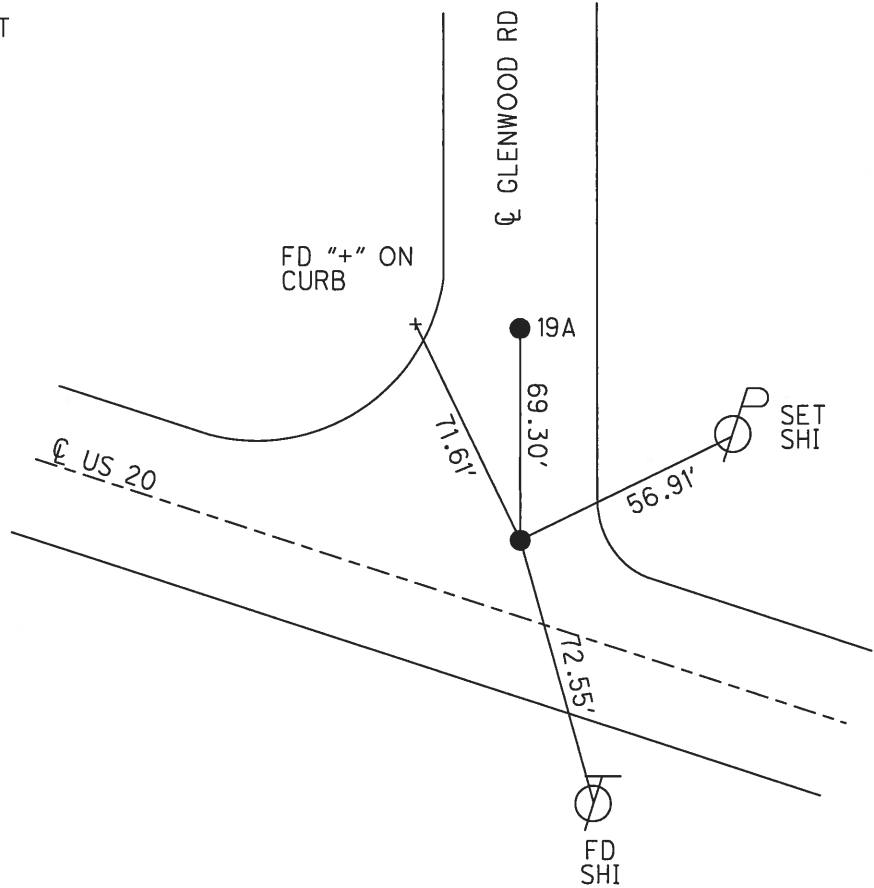


O.D.O.T. DISTRICT 2 SURVEY OFFICE (USE ONLY)

PERSONNEL _____ REFERENCE NO. 19 A SHEET 2 OF 23
 NOTES MALINSKY DATE 6/24/02 ROUTE US 20
 H.C. MOSER WEATHER CLEAR COUNTY WOOD
 R.C. SIEFRING TEMP. 95° TOWNSHIP PERRYSBURG
BEAUMONT SECTION RT 16
 T 4 N R 11 E

TYPE MONUMENT _____ PK/WASHER _____
 ON SURFACE - ~~BELOW~~ _____ ON _____
 LEFT - ☉ PAV'T - ~~RIGHT~~ _____ 83' _____
 _____ TO _____ EDGE PAVEMENT _____
 S.L.M. _____ 292+48 _____
 GRID: NORTHING: _____ - _____ EASTING: _____ - _____

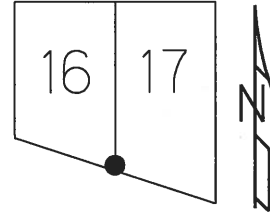


RECORD:
 STA 206+43.18
 $\Delta = 0^\circ 26' 30''$ RT
 $D = 0^\circ 02'$
 $R = 171887.30'$
 $T = 662.51'$
 $L = 1325.00'$
 $E = 1.29'$
 1948 PLANS
 S.H. 275 SEC C
 FD P.K.NAIL
 1972, 1975, 1980, 1992
 SET MAG/WASHER
 3/4/04, MB
 D.N.F. MAG/WASHER
 8-11-16, DCH

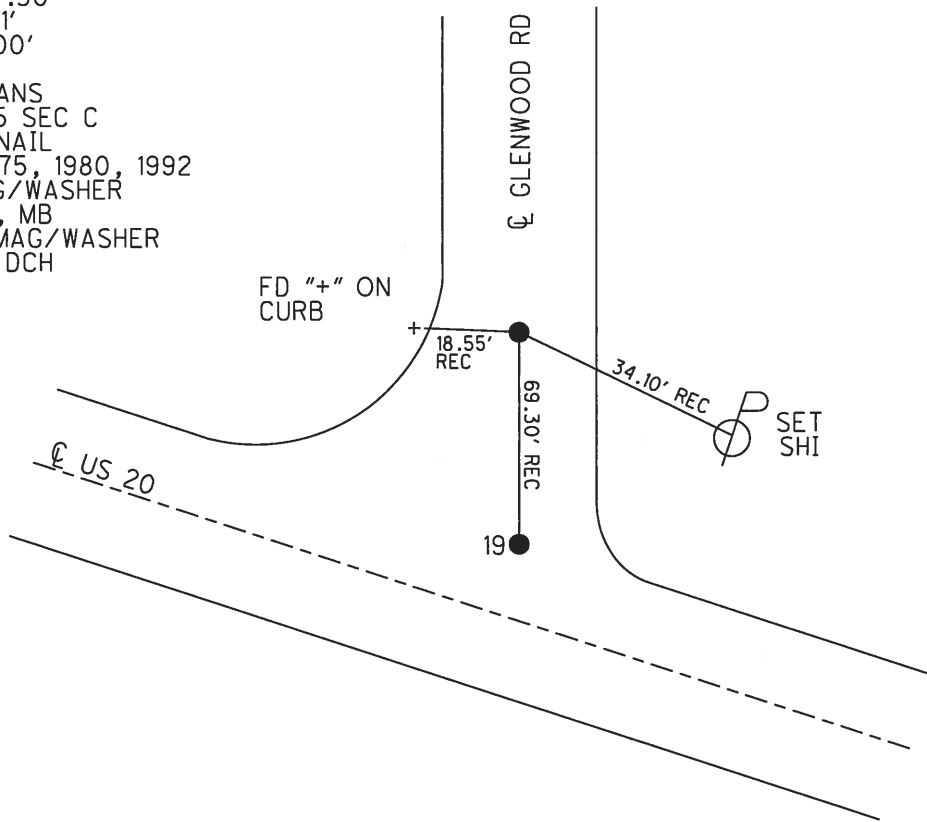

O.D.O.T. DISTRICT 2 SURVEY OFFICE (USE ONLY)


PERSONNEL _____ REFERENCE NO. 23 SHEET 3 OF 23
 NOTES LEU _____ DATE 8/10/16 ROUTE US 20
 H.C. HOMAN WEATHER CLEAR COUNTY WOOD
 R.C. LEU TEMP. 78° TOWNSHIP PERRYSBURG
 _____ SECTION RT 24
 _____ T 4 N R 11 E

TYPE MONUMENT MAG NAIL
 ON SURFACE - ~~BELOW~~ ON _____
 LEFT - ℄ PAV'T - ~~RIGHT~~ 15.4'
 3.5' LT TO LT EDGE PAVEMENT
 S.L.M. 353+41

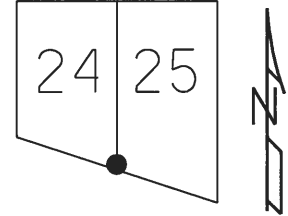

GRID: NORTHING: 678090.131 EASTING: 1684172.749


RECORD: P.I.
 SH PLANS 1948
 STA 267+33.01
 FD R.R.SPIKE
 1953
 FD BRASS MON
 1972, 1975
 FD "X" ON CONC.
 1990, 1992
 SET MAG NAIL
 IN CONC.
 3/4/04, MB
 FD MAG NAIL
 BENT SOUTHERNLY
 REF23
 8/10/16, DCH
 FD MONBOX W/IPIN
 10/23/17, JLL

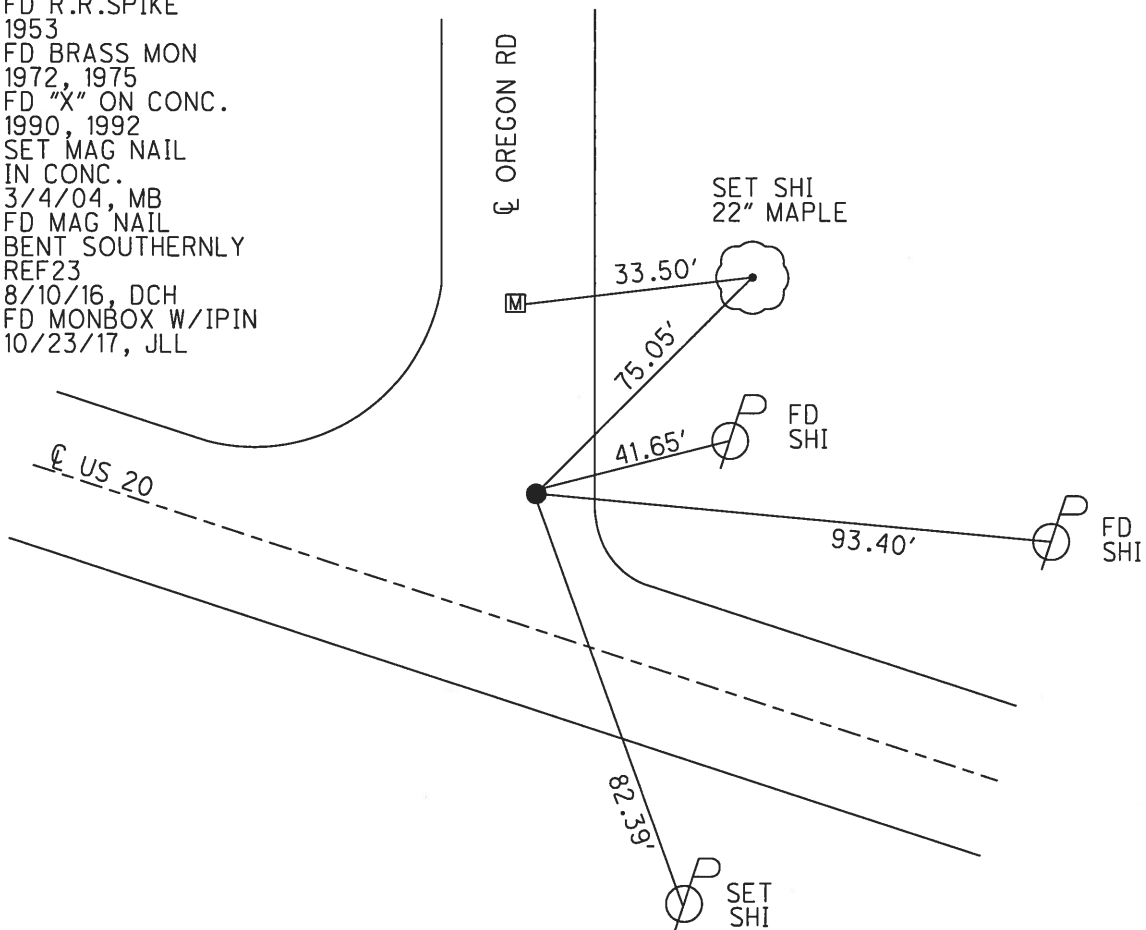

O.D.O.T. DISTRICT 2 SURVEY OFFICE (USE ONLY)


PERSONNEL _____ REFERENCE NO. 24 SHEET 4 OF 23
 NOTES LEU DATE 8/10/16 ROUTE US 20
 H.C. HOMAN WEATHER CLEAR COUNTY WOOD
 R.C. LEU TEMP. 78° TOWNSHIP PERRYSBURG
 SECTION RT 25
 T 4 N R 11 E

TYPE MONUMENT MAG/WASHER
 ON SURFACE - ~~BELOW~~ ON _____
 LEFT - ℄ PAV'T - ~~RIGHT~~ 14.3'
 2.3' LT TO LT EDGE PAVEMENT
 S.L.M. 368+38

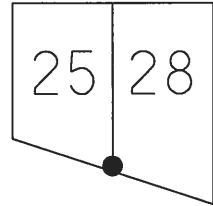

GRID: NORTHING: 677328.111 EASTING: 1685460.879


RECORD: P.I.
 STA 282+30.41
 $\Delta = 0^\circ 05' 30''$ LT
 ℄ R/W
 FD CMON
 1953, 1972, 1975
 FD CMON
 3.5" DOWN
 SET "X" CUT AND
 PUNCH HOLE IN TOP
 1980
 FD PK NAIL
 1992
 SET P.K./WASHER
 10/23/17, JLL
 FD MONBOX
 CMON W/"X" CUT
 FD P.K./WASHER
 6/24/02, KPM
 SET MAG/WASHER
 3/4/04, MB
 FD MAG/WASHER
 REF24
 8/10/16, DCH
 FD MONBOX
 CMON W/"X" CUT
 10/23/17, JLL

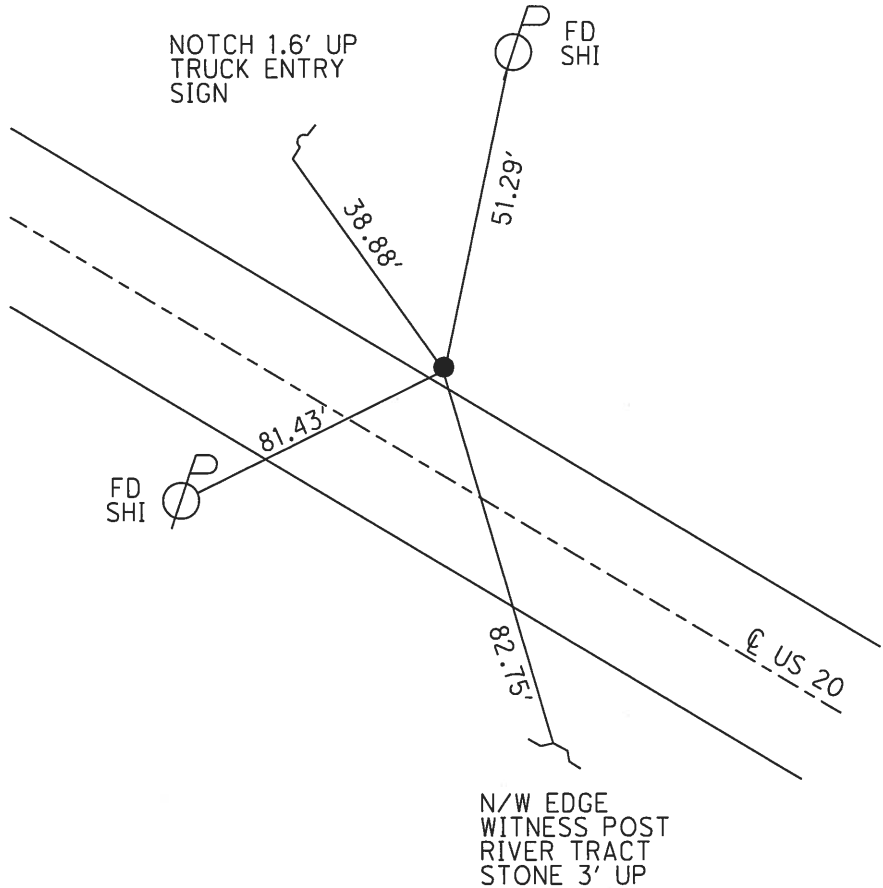


O.D.O.T. DISTRICT 2 SURVEY OFFICE (USE ONLY)

PERSONNEL _____ REFERENCE NO. 26 SHEET 5 OF 23
 NOTES LEU DATE 8/10/16 ROUTE US 20
 H.C. HOMAN WEATHER CLEAR COUNTY WOOD
 R.C. LEU TEMP. 78° TOWNSHIP LAKE
 _____ SECTION RT 29
 _____ T 7 N R 12 E

TYPE MONUMENT CMON
 ON SURFACE - ~~BELOW~~ ON
 LEFT - ℄ PAV'T - ~~RIGHT~~ 14.0'
 2.0' LT TO LT EDGE PAVEMENT
 S.L.M. 395+85
 GRID: NORTHING: 675931.053 EASTING: 1687826.458

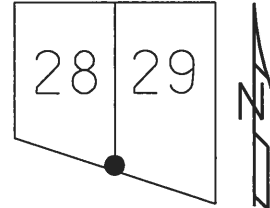


RECORD: P.I.
 CURVE DATA
 1948 PLANS SH 275
 STA 309+77.50
 $\Delta=0^{\circ} 41' 30''$ LT
 $D=0^{\circ} 04'$
 $R=85943.00'$
 $T=518.75'$
 $L=1037.50'$
 $E=1.57'$
 FD CMON
 1953, 1972, 1975
 FD CMON
 4.5" DOWN
 W/"X" CUT IN TOP
 1980
 FD P.K./WASHER
 1992
 SET P.K./WASHER
 1993
 FD P.K./WASHER
 6/24/02, KPM
 FD P.K./WASHER
 REF26
 8/10/19, DCH
 FD CMON
 BROKEN
 USED HIGH POINT
 OF CONC.
 10/23/17, DCH

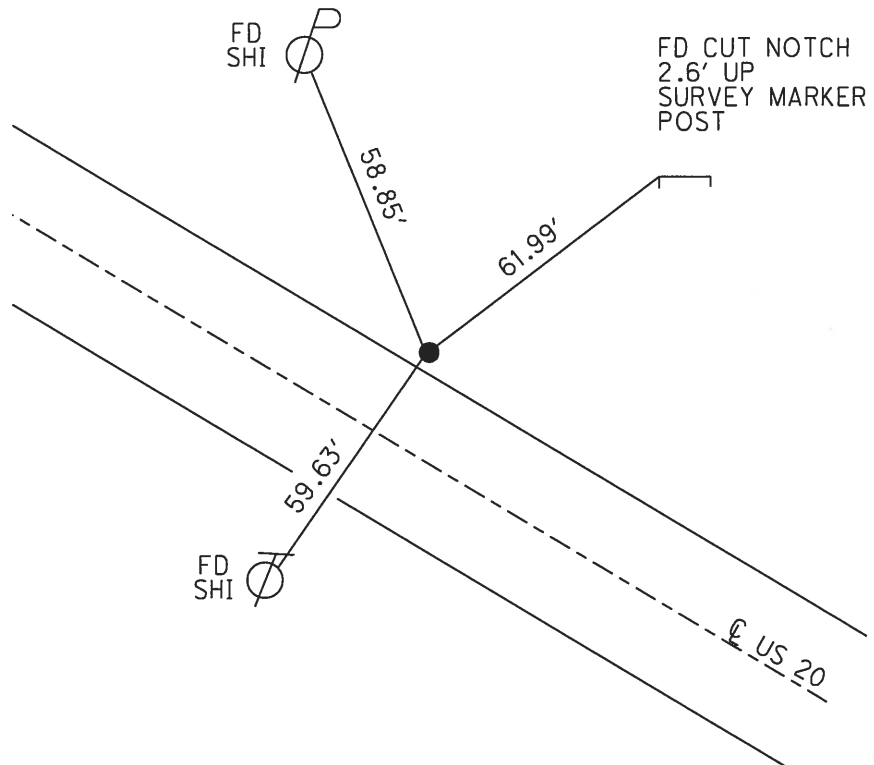

O.D.O.T. DISTRICT 2 SURVEY OFFICE (USE ONLY)


PERSONNEL _____ REFERENCE NO. 27 SHEET 6 OF 23
 NOTES LEU _____ DATE 8/10/19 ROUTE US 20
 H.C. HOMAN _____ WEATHER CLEAR COUNTY WOOD
 R.C. LEU _____ TEMP. 78° TOWNSHIP LAKE
 _____ SECTION RT 32
 _____ T 7 N R 12 E

TYPE MONUMENT MAG/WASHER
 ON SURFACE - ~~BELOW~~ ON _____
 LEFT - ℄ PAV'T - ~~RIGHT~~ 13.0'
 1.0' LT TO LT EDGE PAVEMENT
 S.L.M. 407+99

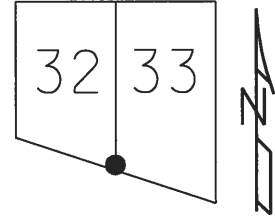

GRID: NORTHING: 675326.074 EASTING: 1688877.221



RECORD: P.I.
 STA 321+90.56
 $\Delta = 0^\circ 13' 35''$ LT
 ℄ R/W
 FD CMON
 BROKEN OFF
 1953
 FD P.K. NAIL
 1972, 1975
 FD CMON
 13" DOWN
 SET PUNCHED HOLE
 IN CENTER
 1980
 FD P.K./WASHER
 1992
 SET P.K./WASHER
 1993
 FD P.K./WASHER
 6/24/02, KPM
 SET MAG/WASHER
 3/4/04, MB
 FD MAG/WASHER
 REF27
 8/10/16
 FD MONBOX
 CMON W/HOLE
 10/23/17, DCH

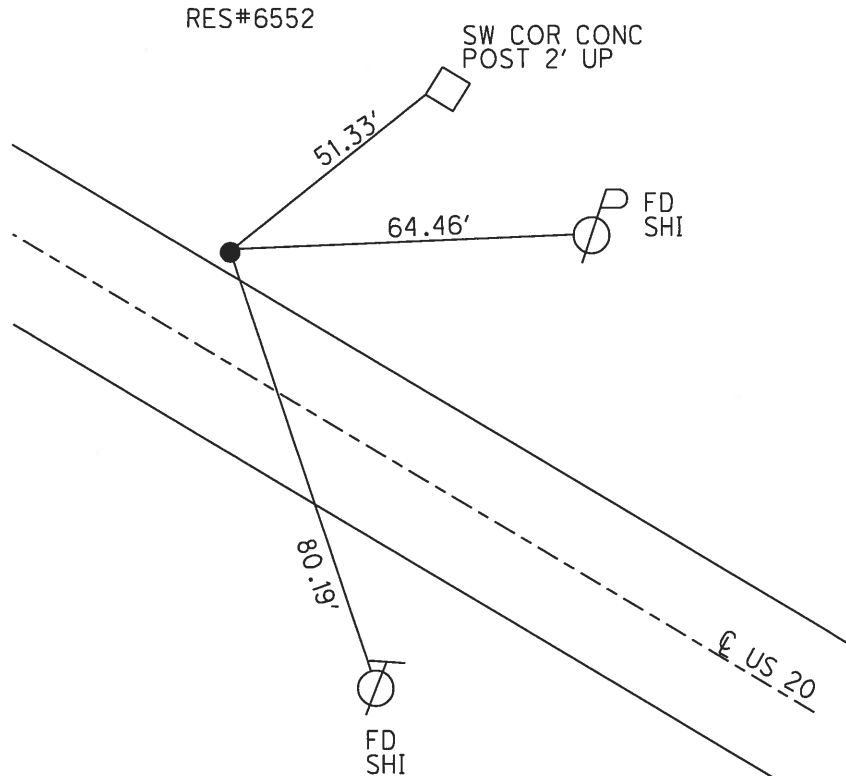

O.D.O.T. DISTRICT 2 SURVEY OFFICE (USE ONLY)

PERSONNEL _____ REFERENCE NO. 28 SHEET 7 OF 23
 NOTES LEU _____ DATE 8/10/16 ROUTE US 20
 H.C. HOMAN _____ WEATHER CLEAR COUNTY WOOD
 R.C. LEU _____ TEMP. 78° TOWNSHIP TROY
 _____ SECTION RT 34
 _____ T 6 N R 12 E

TYPE MONUMENT MAG/WASHER
 ON SURFACE - ~~BELOW~~ ON _____
 LEFT - ℄ PAV'T - ~~RIGHT~~ 12.7'
0.3' LT TO LT EDGE PAVEMENT
 S.L.M. 422+80
 GRID: NORTHING: 674586.667 EASTING: 1690162.505

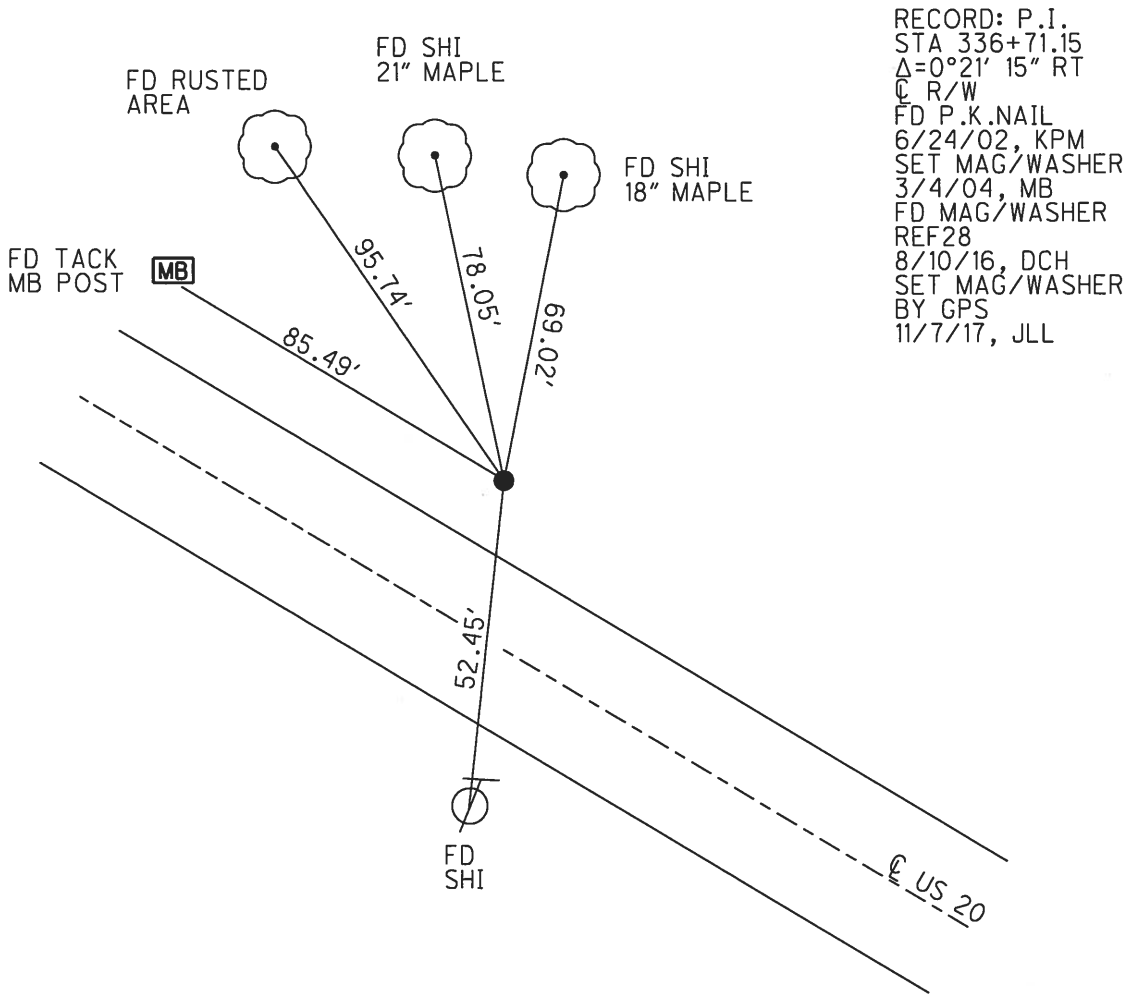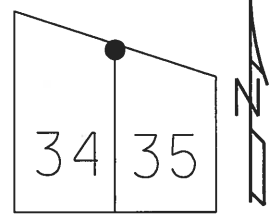


RECORD: P.I.
 STA 336+71.15
 $\Delta=0^{\circ}21' 15''$ RT
 ℄ R/W
 FD P.K.NAIL
 6/24/02, KPM
 SET MAG/WASHER
 3/4/04, MB
 FD MAG/WASHER
 REF28
 8/10/16, DCH
 SET MAG/WASHER
 BY GPS
 11/7/17, JLL


O.D.O.T. DISTRICT 2 SURVEY OFFICE (USE ONLY)

PERSONNEL	REFERENCE NO.	<u>30</u>	SHEET	<u>8</u>	OF	<u>23</u>
NOTES	LEU	DATE	<u>8/10/16</u>	ROUTE	<u>US 20</u>	
H.C.	<u>HOMAN</u>	WEATHER	<u>CLEAR</u>	COUNTY	<u>WOOD</u>	
R.C.	<u>LEU</u>	TEMP.	<u>78°</u>	TOWNSHIP	<u>TROY</u>	
				SECTION	<u>RT 35</u>	
				T	<u>6</u>	R
					<u>N</u>	<u>12</u>
					<u>E</u>	

TYPE MONUMENT MAG/WASHER
 ON SURFACE - ~~BELOW~~ ON
 LEFT - ☉ PAV'T - ~~RIGHT~~ 6.6'
5.5' TO LT EDGE PAVEMENT
 S.L.M. 436+65.6

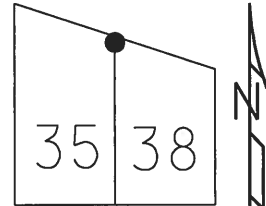

GRID: NORTHING: 673897.056 EASTING: 1691366.406


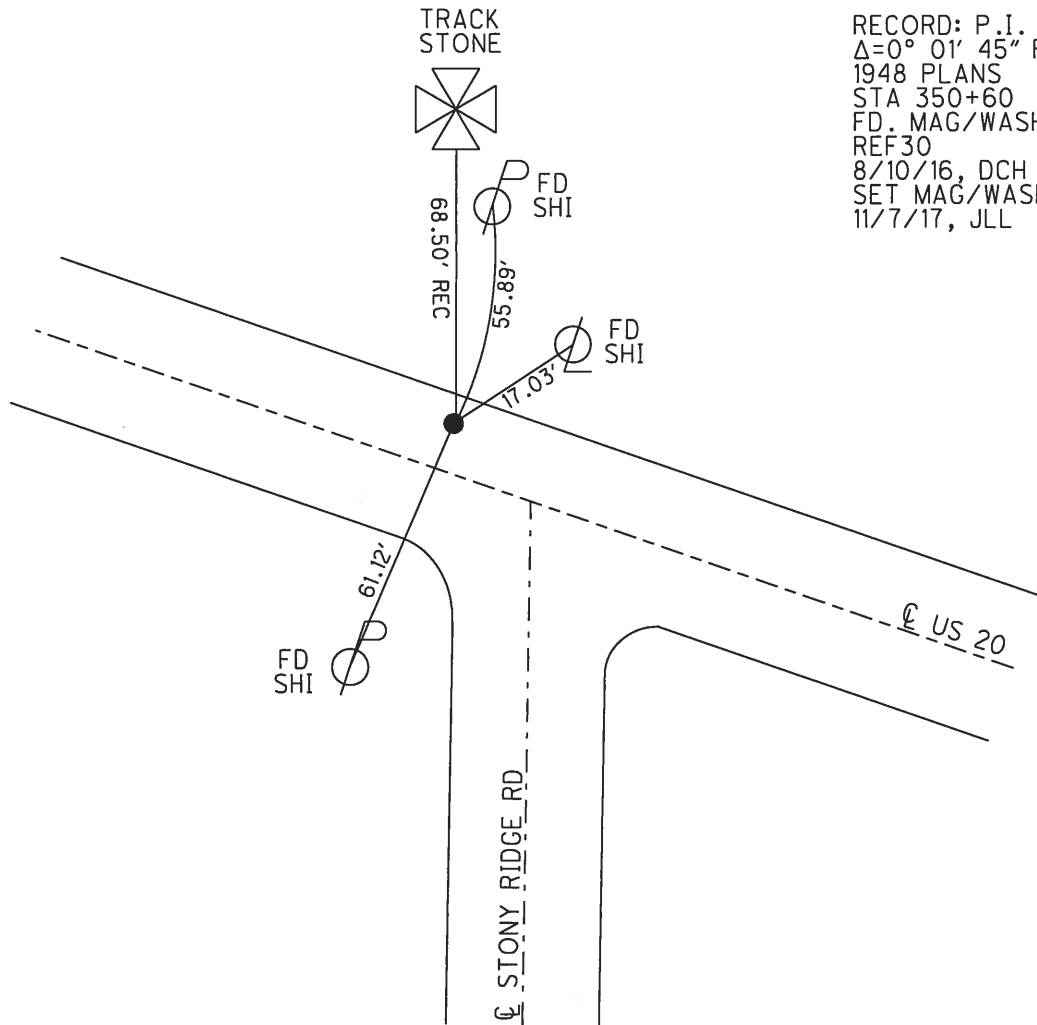


RECORD: P.I.
 $\Delta=0^{\circ} 01' 45''$ RT.
 1948 PLANS
 STA 350+60
 FD. MAG/WASHER
 REF30
 8/10/16, DCH
 SET MAG/WASHER
 11/7/17, JLL

O.D.O.T. DISTRICT 2 SURVEY OFFICE (USE ONLY)

PERSONNEL	REFERENCE NO.	30 A	SHEET	9	OF	23
NOTES	LEU	DATE	8/10/16	ROUTE	US 20	
H.C.	HOMAN	WEATHER	CLEAR	COUNTY	WOOD	
R.C.	LEU	TEMP.	72°	TOWNSHIP	TROY	
				SECTION	RT 37	
					T 6 N R 12 E	

TYPE MONUMENT MAG/WASHER
 ON SURFACE - ~~BELOW~~ ON
 LEFT - ℄ PAV'T - ~~RIGHT~~ 4.0'
15.4' TO RT EDGE PAVEMENT
 S.L.M. 439+63
 GRID: NORTHING: 673750.643 EASTING: 1691618.729

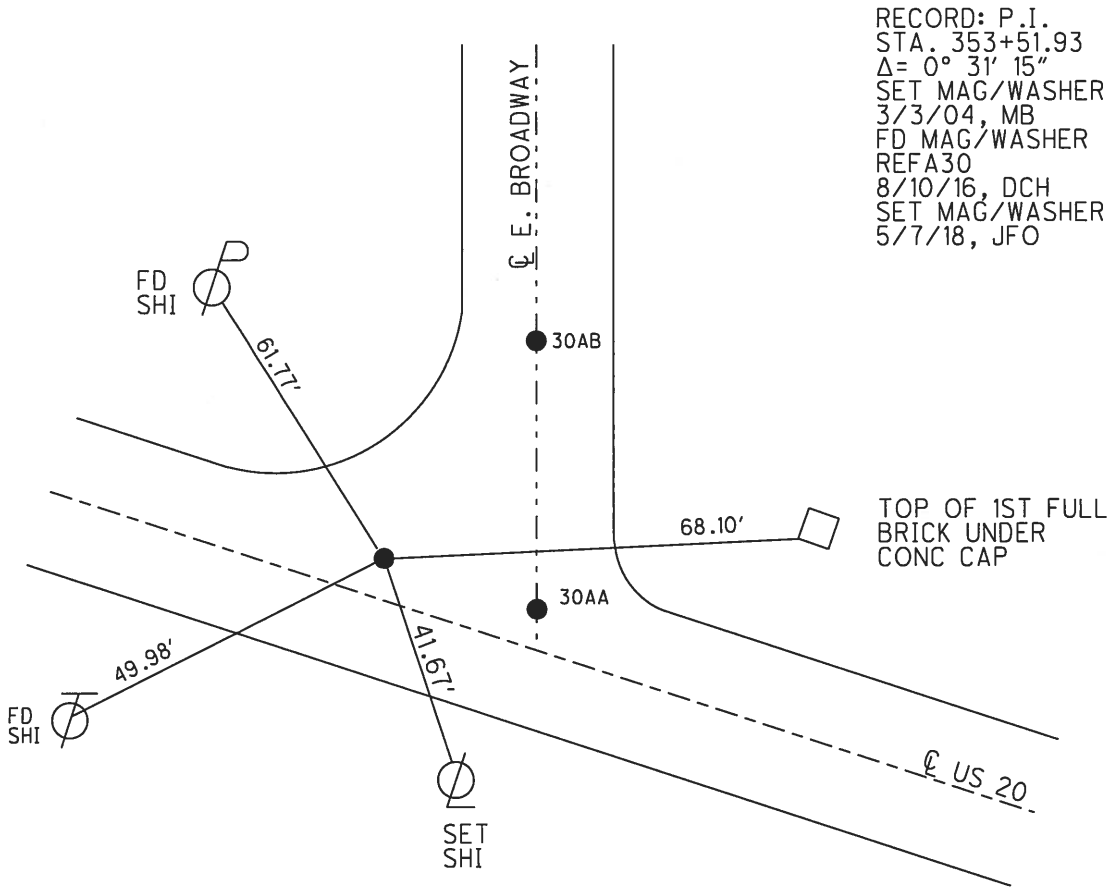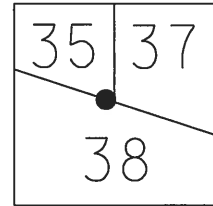


RECORD: P.I.
 STA. 353+51.93
 $\Delta = 0^\circ 31' 15''$
 SET MAG/WASHER
 3/3/04, MB
 FD MAG/WASHER
 REFA30
 8/10/16, DCH
 SET MAG/WASHER
 5/7/18, JFO

DISTANCE:
 30A-30AA=35.32'
 30AA-30AB=69.41'
 30AB-30A=59.91'

O.D.O.T. DISTRICT 2 SURVEY OFFICE (USE ONLY)

PERSONNEL _____ REFERENCE NO. 30 AA SHEET 10 OF 23
 NOTES LEU DATE 8/10/16 ROUTE US 20
 H.C. HOMAN WEATHER CLEAR COUNTY WOOD
 R.C. LEU TEMP. 72° TOWNSHIP TROY
 _____ SECTION RT 37
 _____ T 6 N R 12 E


TYPE MONUMENT MAG/WASHER
 ON SURFACE - ~~BELOW~~ ON
 LEFT - CL PAV'T - ~~RIGHT~~ 4.0'
15.4' TO RT EDGE PAVEMENT
 S.L.M. 439+98

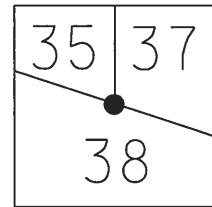

GRID: NORTHING: 673732.886 EASTING: 1691649.260

RECORD:
 SET MAG/WASHER
 3/3/04, MB
 FD MAG/WASHER
 REFAA30
 8/10/16, DCH
 SET MAG/WASHER
 5/7/18, JFO


DISTANCE:
 30A-30AA=35.32'
 30AA-30AB=69.41'
 30AB-30A=59.91'

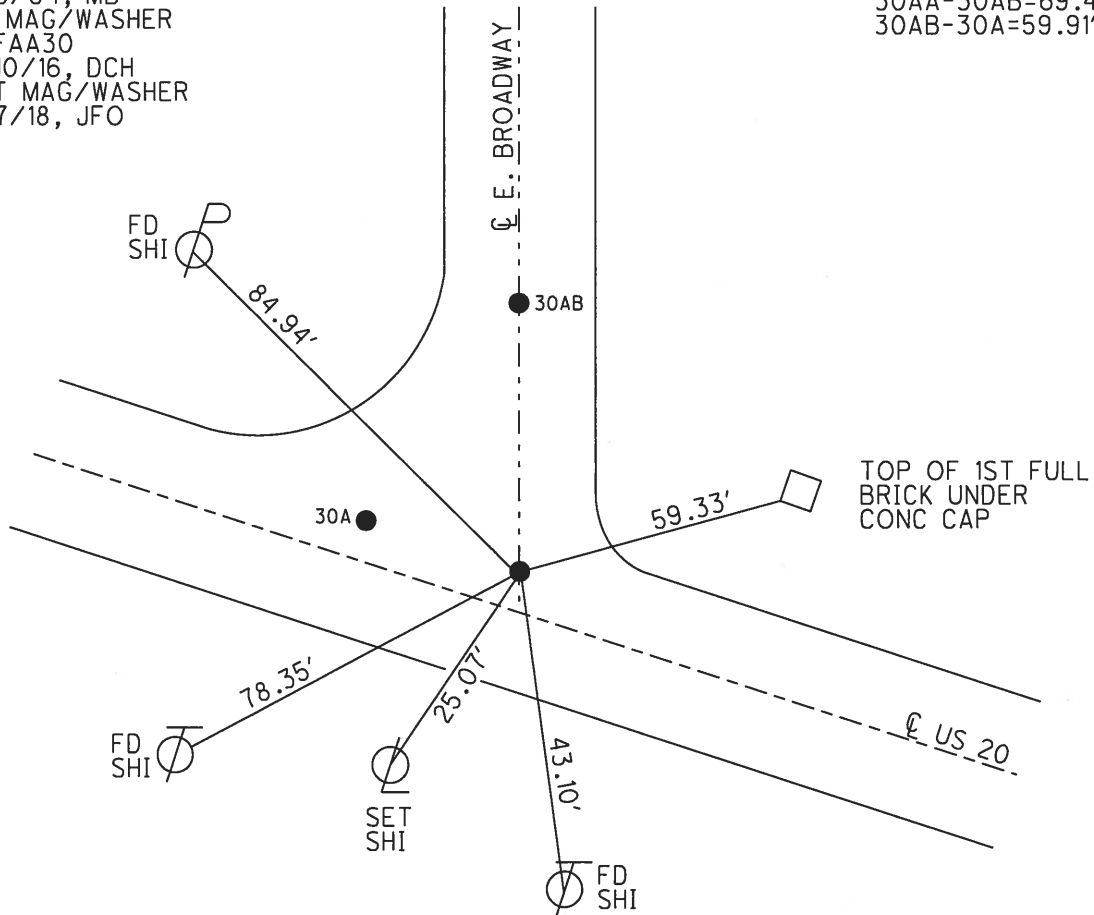

O.D.O.T. DISTRICT 2 SURVEY OFFICE (USE ONLY)


PERSONNEL	REFERENCE NO.	<u>30 AB</u>	SHEET	<u>11</u>	OF	<u>23</u>
NOTES	<u>LEU</u>	DATE	<u>8/10/16</u>	ROUTE	<u>US 20</u>	
H.C.	<u>HOMAN</u>	WEATHER	<u>CLEAR</u>	COUNTY	<u>WOOD</u>	
R.C.	<u>LEU</u>	TEMP.	<u>85°</u>	TOWNSHIP	<u>TROY</u>	
				SECTION	<u>RT 37</u>	
				T	<u>6</u>	N
				R	<u>12</u>	E

TYPE MONUMENT MAG/WASHER
~~ON SURFACE~~ - BELOW 10"
 LEFT - ☉ PAV'T - ~~RIGHT~~ 72'
 TO EDGE PAVEMENT
 S.L.M. 439+98

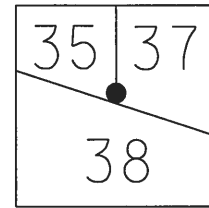

GRID: NORTHING: 673802.273 EASTING: 1691649.006

RECORD:
 SET MAG/WASHER
 3/3/04, MB
 SET MAG/WASHER
 REFAB30
 8/10/16, DCH
 FD MAG/WASHER
 5/7/18, JFO

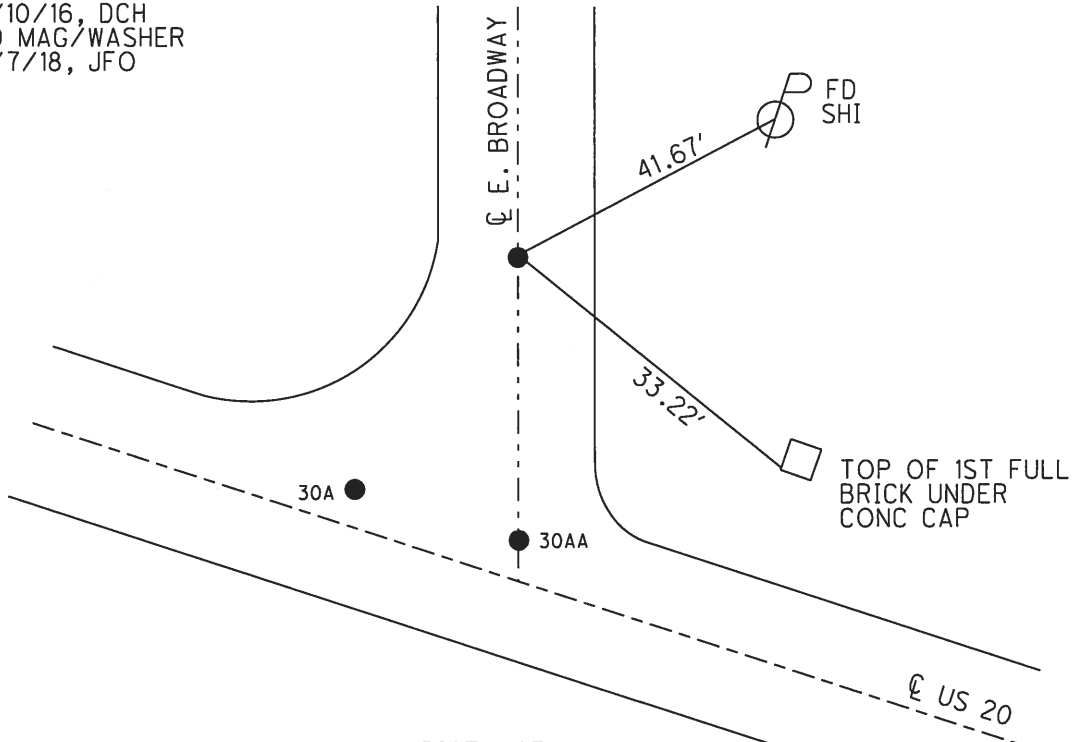


DISTANCE:
 30A-30AA=35.32'
 30AA-30AB=69.41'
 30AB-30A=59.91'


O.D.O.T. DISTRICT 2 SURVEY OFFICE (USE ONLY)

PERSONNEL _____ REFERENCE NO. 30 B SHEET 12 OF 23
 NOTES LEU DATE 8/9/16 ROUTE US 20
 H.C. HOMAN WEATHER CLEAR COUNTY WOOD
 R.C. LEU TEMP. 85° TOWNSHIP TROY
 _____ SECTION RT 37
 _____ T 6 N R 12 E

TYPE MONUMENT MAG/WASHER
 ON SURFACE - ~~BELOW~~ ON
 LEFT - ☉ PAV'T - ~~RIGHT~~ 1.0'
10.7' TO LT EDGE PAVEMENT
 S.L.M. 443+99
 GRID: NORTHING: 673529.362 EASTING: 1691994.099

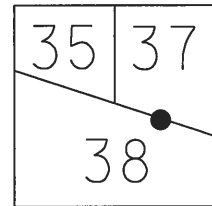


RECORD: P.T.
 1948 CURVE DATA
 $\Delta=0^{\circ} 41' 30''$ RT
 $R=85943.70'$
 $T=518.75$
 $L=1037.50'$
 $E=1.57'$
 SET MAG/WASHER
 3/4/04, MB
 FD MAG/WASHER
 REFB30
 8/9/16, DCH
 SET MAG/WASHER
 5/7/18, JFO

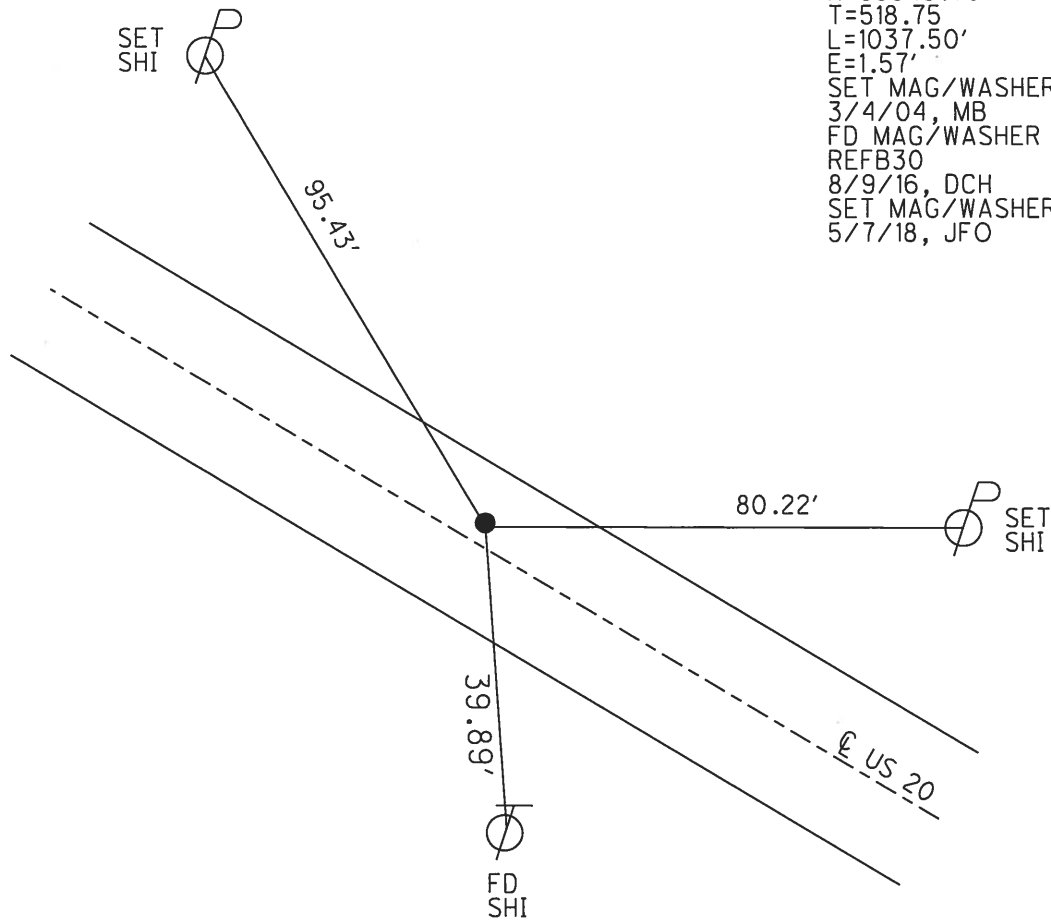


O.D.O.T. DISTRICT 2 SURVEY OFFICE (USE ONLY)

PERSONNEL	REFERENCE NO.	<u>31</u>	SHEET	<u>13</u>	OF	<u>23</u>
NOTES	LEU	DATE	<u>8/9/16</u>	ROUTE	<u>US 20</u>	
H.C.	<u>HOMAN</u>	WEATHER	<u>CLEAR</u>	COUNTY	<u>WOOD</u>	
R.C.	<u>LEU</u>	TEMP.	<u>85°</u>	TOWNSHIP	<u>TROY</u>	
				SECTION	<u>RT 37</u>	
				T	<u>6</u>	N
				R	<u>12</u>	E

TYPE MONUMENT MAG/WASHER
 ON SURFACE - ~~BELOW~~ ON
 LEFT - ℄ PAV'T - ~~RIGHT~~ 2.3'
9.8' TO LT EDGE PAVEMENT
 S.L.M. 449+74
 GRID: NORTHING: 673235.109 EASTING: 1692490.407

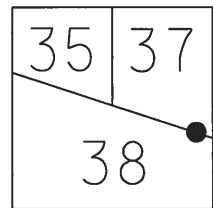

RECORD: P.I.
 STA 363+64.83
 $\Delta = 0^\circ 12' 45''$ RT
 R/W LINE
 SET MAG/WASHER
 3/4/04, MB
 FD MAG/WASHER
 REF31
 8/9/16, DCH
 SET MAG/WASHER
 5/7/18, JFO

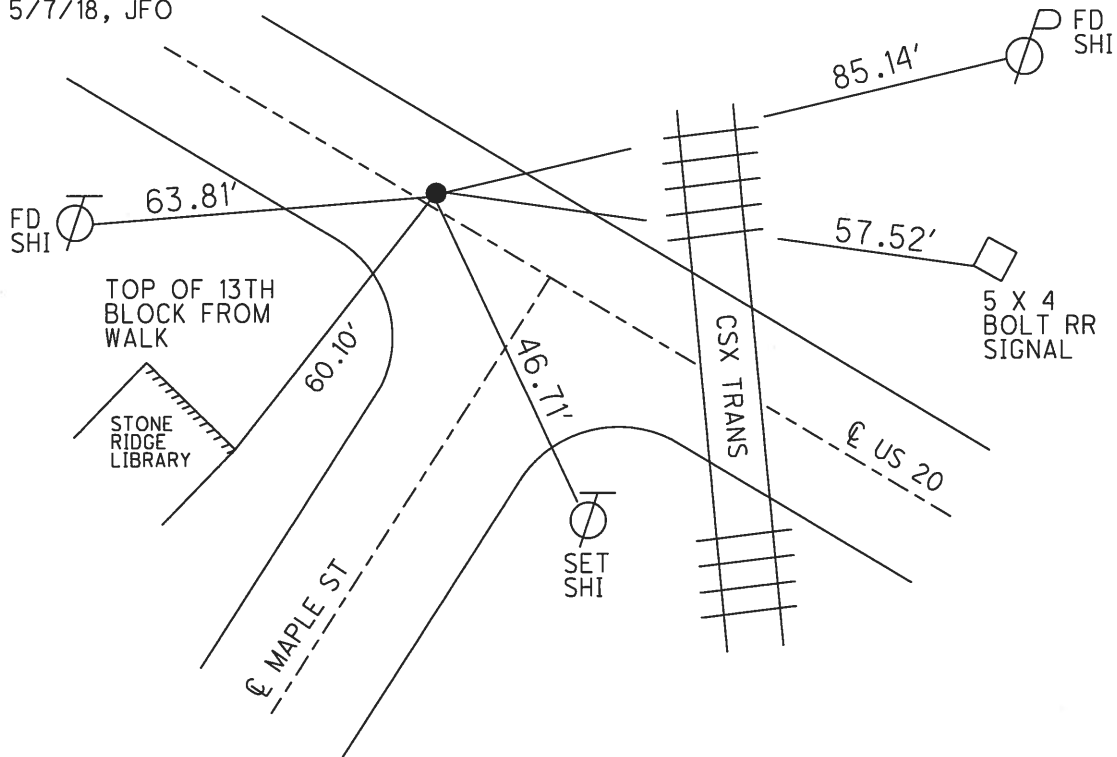



O.D.O.T. DISTRICT 2 SURVEY OFFICE (USE ONLY)

PERSONNEL _____ REFERENCE NO. 33 SHEET 14 OF 23

NOTES	<u>LEU</u>	DATE	<u>8/9/16</u>	ROUTE	<u>US 20</u>
H.C.	<u>HOMAN</u>	WEATHER	<u>SUNNY</u>	COUNTY	<u>WOOD</u>
R.C.	<u>LEU</u>	TEMP.	<u>69°</u>	TOWNSHIP	<u>TROY</u>
				SECTION	<u>42</u>
				T <u>6</u> N	R <u>12</u> E

TYPE MONUMENT _____ P.K.NAIL _____
 ON SURFACE - ~~BELOW~~ _____ ON _____
 LEFT - C PAV'T - ~~RIGHT~~ _____ 4.8' _____
 - TO - _____ EDGE PAVEMENT _____
 S.L.M. _____ 468+38 _____

GRID: NORTHING: 672280.395 EASTING: 1694091.653

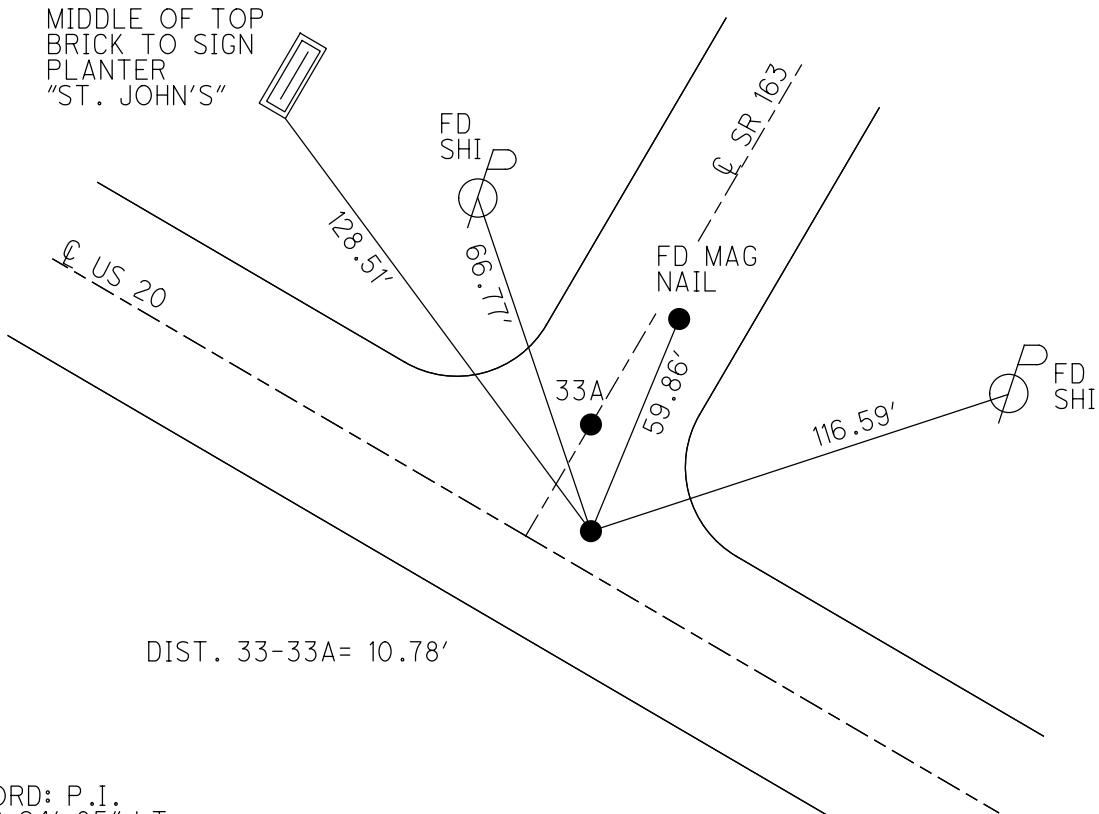
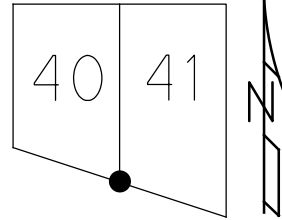


RECORD: P.I.
 $\Delta=0^{\circ} 24' 05''$ LT
 PLAN STA. 382+29.25
 FD P.K./WASHER
 8/1/13, SDC
 FD P.K.NAIL
 REF33
 8/9/16, DCH
 SET MAG/WASHER
 5/7/18
 6/17/19, JFO

O.D.O.T. DISTRICT 2 SURVEY OFFICE (USE ONLY)

PERSONNEL _____ REFERENCE NO. 33 A SHEET 15 OF 23
 NOTES LEU DATE 8-9-16 ROUTE US 20
 H.C. HOMAN WEATHER SUNNY COUNTY WOOD
 R.C. LEU TEMP. 70° TOWNSHIP TROY
 SECTION RT 41
 T 6 N R 12 E

TYPE MONUMENT FD. MAG/WASHER
 ON SURFACE - ~~BELOW~~ ON
 LEFT - ☉ PAV'T - RIGHT -
- TO - EDGE PAVEMENT
 S.L.M. 468+00 ±
 Grid: Northing: 672291.0334 Easting: 1694090.047

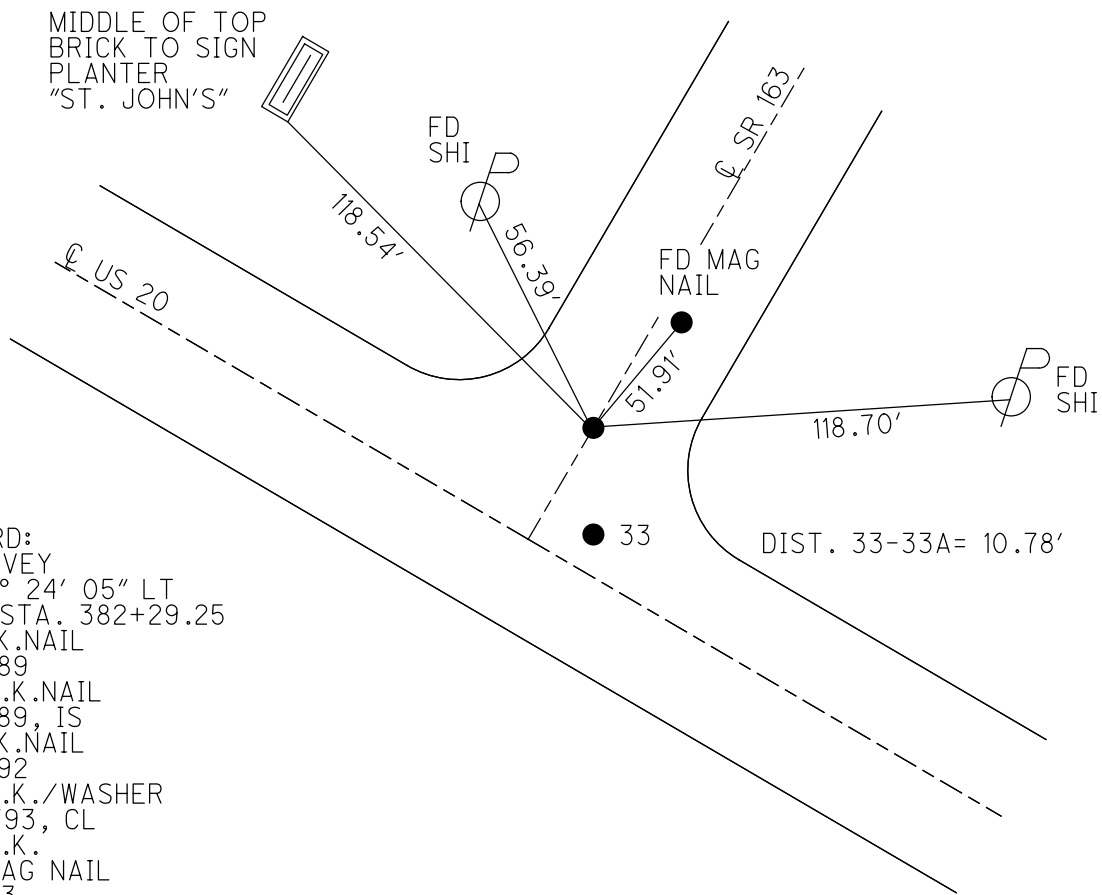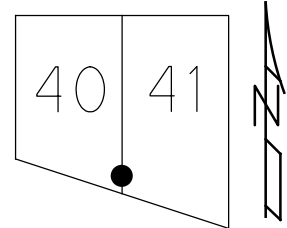


RECORD:
 ☉ SURVEY
 $\Delta = 0^\circ 24' 05''$ LT
 PLAN STA. 382+29.25
 FD P.K.NAIL
 5/16/89
 SET P.K.NAIL
 7/31/89, IS
 FD P.K.NAIL
 5/13/92
 SET P.K./WASHER
 6/29/93, CL
 DNF P.K.
 SET MAG NAIL
 REFB33
 8/1/13, SDC
 SET MAG/WASHER
 NEWREFB33
 8/21/14, EBW
 SET MAG/WASHER
 6/17/19, JFO


O.D.O.T. DISTRICT 2 SURVEY OFFICE (USE ONLY)

PERSONNEL _____ REFERENCE NO. 35 SHEET 16 OF 23
 NOTES LEU DATE 8-9-16 ROUTE US 20
 H.C. HOMAN WEATHER CLEAR COUNTY WOOD
 R.C. LEU TEMP. 69° TOWNSHIP TROY
 SECTION RT 44
 T 6 N R 12 E

TYPE MONUMENT MAG NAIL
 ON SURFACE - ~~BELOW~~ ON _____
 LEFT - ☉ PAV'T - ~~RIGHT~~ 13.4'
 TO _____ EDGE PAVEMENT
 S.L.M. 497+25

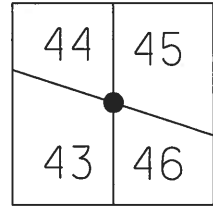

GRID: NORTHING: 670818.723 EASTING: 1696581.924

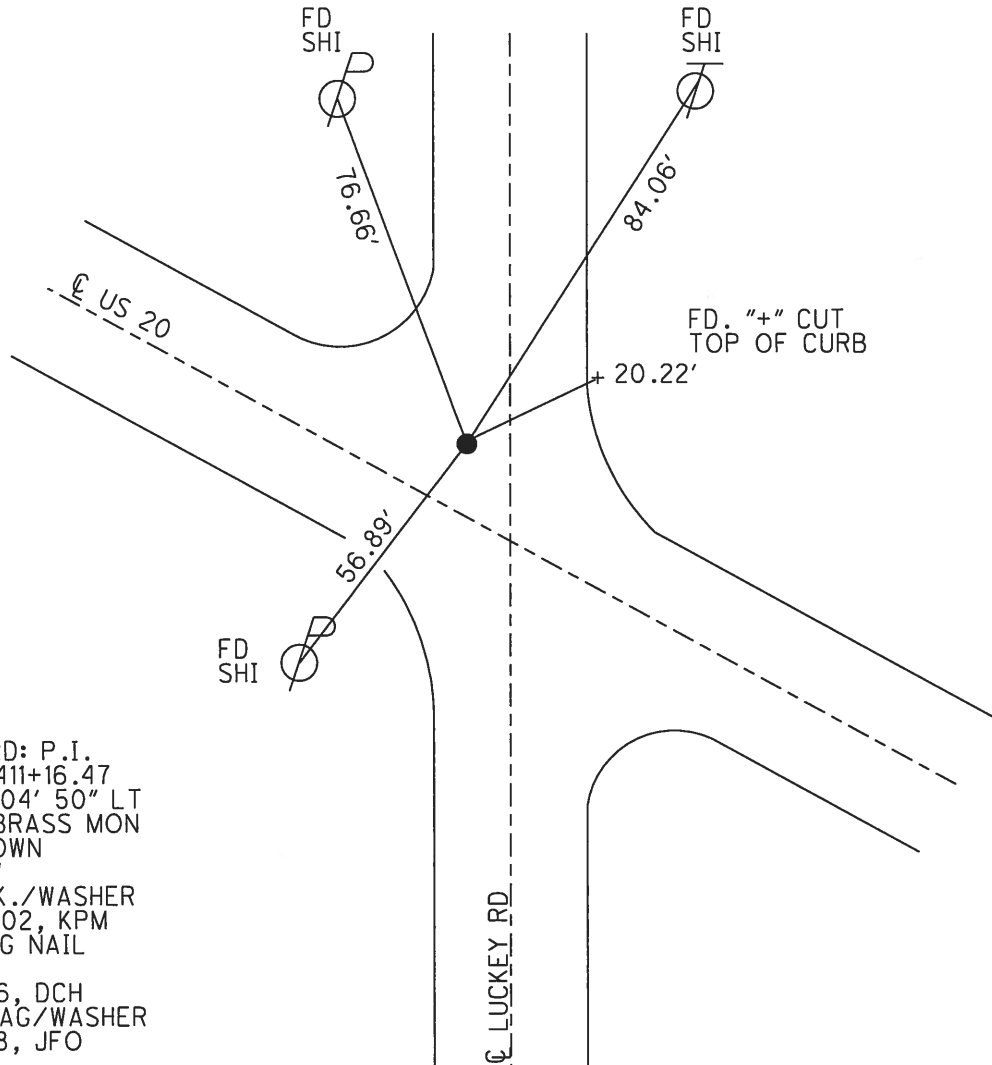


RECORD: P.I.
 STA. 411+16.47
 $\Delta = 1^{\circ}04' 50''$ LT
 ADJ. BRASS MON
 6"± DOWN
 ☉ R/W
 FD P.K./WASHER
 6/25/02, KPM
 FD MAG NAIL
 REF35
 8/9/16, DCH
 SET MAG/WASHER
 5/7/18, JFO


O.D.O.T. DISTRICT 2 SURVEY OFFICE (USE ONLY)

PERSONNEL _____ REFERENCE NO. 36 SHEET 17 OF 23
 NOTES MICHALAK DATE 6/25/02 ROUTE US 20
 H.C. MOSE WEATHER CLEAR COUNTY WOOD
 R.C. SIEFRING TEMP. 95° TOWNSHIP TROY
BEAUMONT SECTION RT 45
 T 6 N R 12 E

TYPE MONUMENT _____ LG. R.R. SPIKE _____
~~ON SURFACE~~ - BELOW 4"
 LEFT - Q PAV'T - ~~RIGHT~~ 15.1'
 3.0' LT TO LT EDGE PAVEMENT
 S.L.M. 512+39
 GRID: NORTHING: _____ EASTING: _____

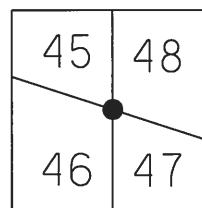


RECORD: P.I.
 STA. 426+31.06
 $\Delta = 0^\circ 03' 30''$ RT MEAS.
 $\Delta = 0^\circ 03' 10''$ PLANS
 Q R/W
 FD LG.R.R.SPIKE
 4" DOWN
 6/25/02, KPM
 D.N.F.
 8/11/16, DCH

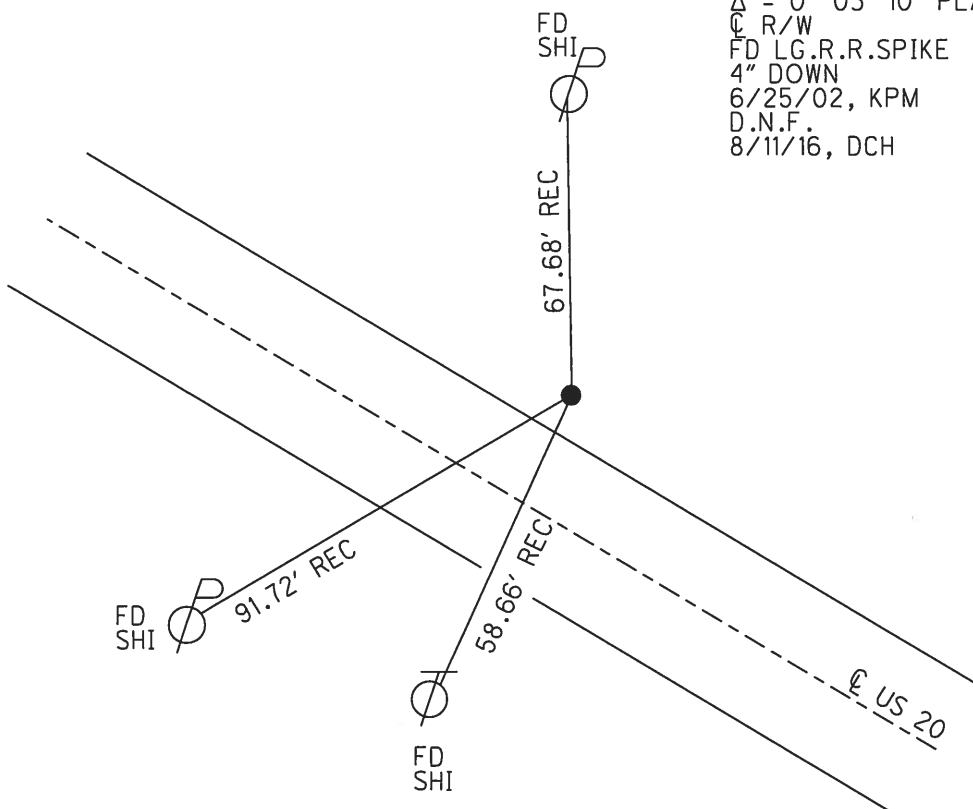


O.D.O.T. DISTRICT 2 SURVEY OFFICE (USE ONLY)

PERSONNEL _____ REFERENCE NO. 36 A SHEET 18 OF 23
 NOTES LEU DATE 8/9/16 ROUTE US 20
 H.C. HOMAN WEATHER CLEAR COUNTY WOOD
 R.C. LEU TEMP. 69° TOWNSHIP TROY
 _____ SECTION RT 48
 _____ T 6 N R 12 E

TYPE MONUMENT _____ P.K./WASHER _____
 ON SURFACE - ~~BELOW~~ _____ ON _____
 LEFT - ☉ PAV'T - ~~RIGHT~~ _____ 14.2' _____
2.5' TO LT EDGE PAVEMENT _____
 S.L.M. _____ 516+96 _____
 GRID: NORTHING: 669852.452 EASTING: 1698300.257

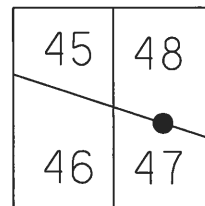


RECORD:
 PLAN STA. 516+82.33
 1970 PLANS
 WOO. 20-.970
 SAN. 20-0./00
 R/W PLANS
 FD SM.R.R.SPIKE
 6/25/02, KPM
 SET P.K./WASHER
 11/6/02, MB
 FD P.K./WASHER
 REFA36
 8/9/16, DCH
 SET MAG/WASHER
 5/7/18, JFO

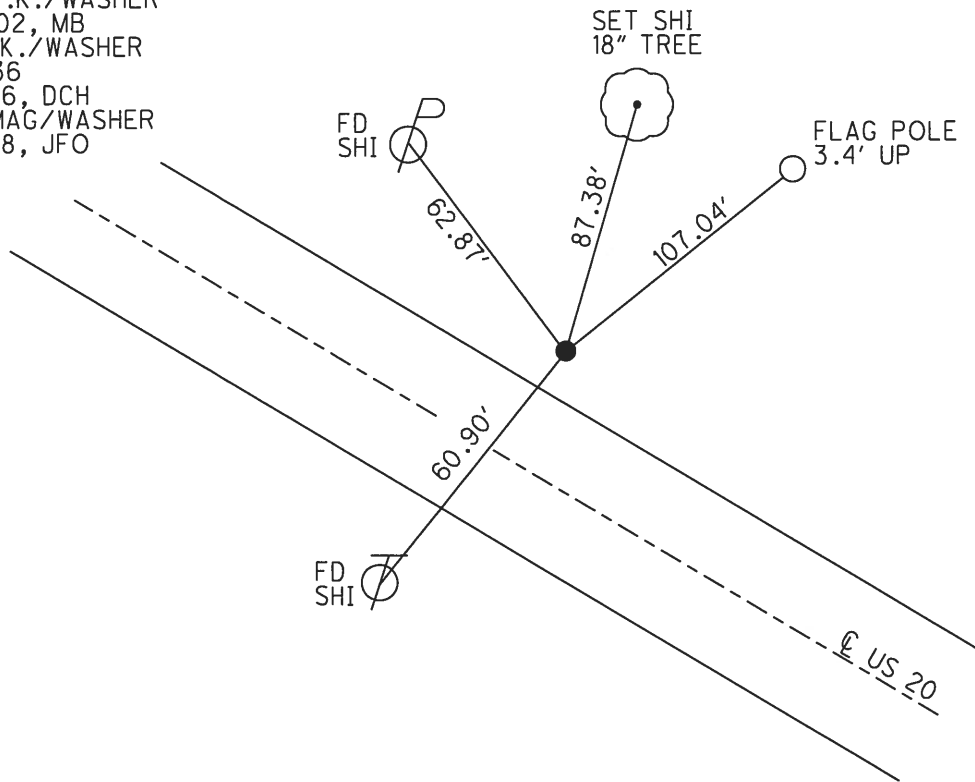


O.D.O.T. DISTRICT 2 SURVEY OFFICE (USE ONLY)

PERSONNEL _____ REFERENCE NO. 37 SHEET 19 OF 23
 NOTES LEU DATE 8/9/16 ROUTE US 20
 H.C. HOMAN WEATHER CLEAR COUNTY WOOD
 R.C. LEU TEMP. 69° TOWNSHIP TROY
 _____ SECTION RT 48
 T 6 N R 12 E

TYPE MONUMENT SM.R.R. SPIKE
~~ON SURFACE~~ - BELOW 6"
 LEFT - ℄ PAV'T - ~~RIGHT~~ 14.5'
2.3' TO LT EDGE PAVEMENT
 S.L.M. 527+78
 GRID: NORTHING: 669321.403 EASTING: 1699243.821

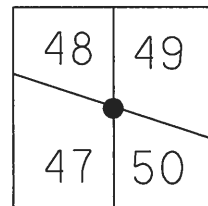


RECORD:
 PLAN STA 527+65.12
 FD SM.R.R.SPIKE
 6/25/02, KPM
 FD SM.R.R. SPIKE
 6" BELOW REF37
 8/9/16, DCH
 SET MAG/WASHER
 5/7/18, JFO

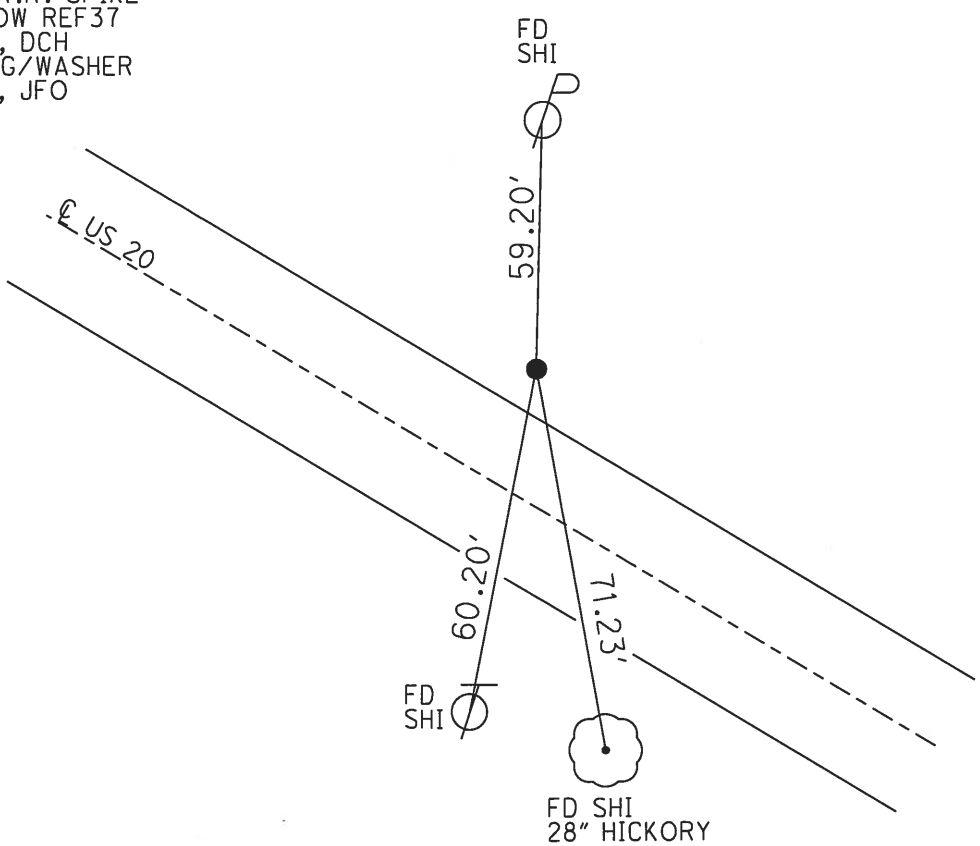


O.D.O.T. DISTRICT 2 SURVEY OFFICE (USE ONLY)

PERSONNEL _____ REFERENCE NO. 38 SHEET 20 OF 23
 NOTES ODONNELL DATE 5/7/18 ROUTE SR 20
 H.C. LEU WEATHER SUNNY COUNTY WOOD
 R.C. SEAMAN TEMP. 62° TOWNSHIP TROY
 SECTION RT 49
 T 6 N R 12 E

TYPE MONUMENT MAG/WASHER
 ON SURFACE - ~~BELOW~~ ON
 LEFT - C PAV'T - ~~RIGHT~~ 13.9'
2.1' TO LT EDGE PAVEMENT
 S.L.M. 542+40.50

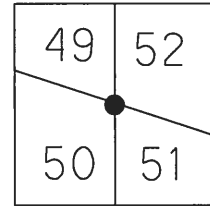

Grid: Northing: 668583.556 Easting: 1700554.631

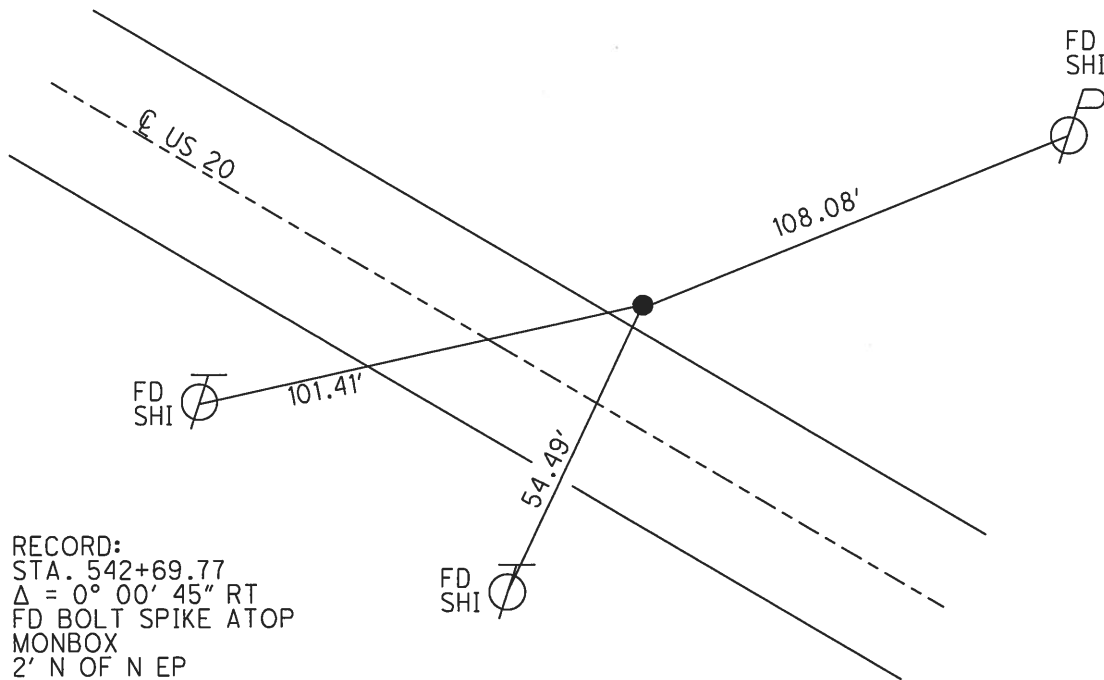


RECORD:
 STA. 542+69.77
 $\Delta = 0^{\circ} 00' 45''$ RT
 FD BOLT SPIKE ATOP
 MONBOX
 2' N OF N EP
 5/21/80, CRONIN
 FD MONBOX
 W/1" IPIN
 REF38
 8/26/14, EBW
 FD MONBOX
 W/1" IPIN
 2" DOWN
 8/11/16, DCH
 SET MAG/WASHER
 W/GPS
 5/7/18, JFO


O.D.O.T. DISTRICT 2 SURVEY OFFICE (USE ONLY)

PERSONNEL _____ REFERENCE NO. 39 SHEET 21 OF 23
 NOTES LEU _____ DATE 8/11/16 ROUTE SR 20
 H.C. HOMAN WEATHER PTLY CLOUDY COUNTY WOOD
 R.C. LEU TEMP. 79° TOWNSHIP TROY
 _____ SECTION RT 52
 _____ T 6 N R 12 E

TYPE MONUMENT 3" DISK
 ON SURFACE - ~~BELOW~~ ON _____
 LEFT - ☉ PAV'T - ~~RIGHT~~ 16.29'
3.3' TO IT EDGE PAVEMENT
 S.L.M. 557+81.03

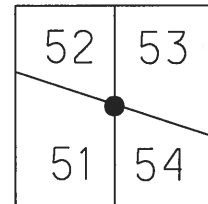

Grid: Northing: 667826.793 Easting: 1701896.517

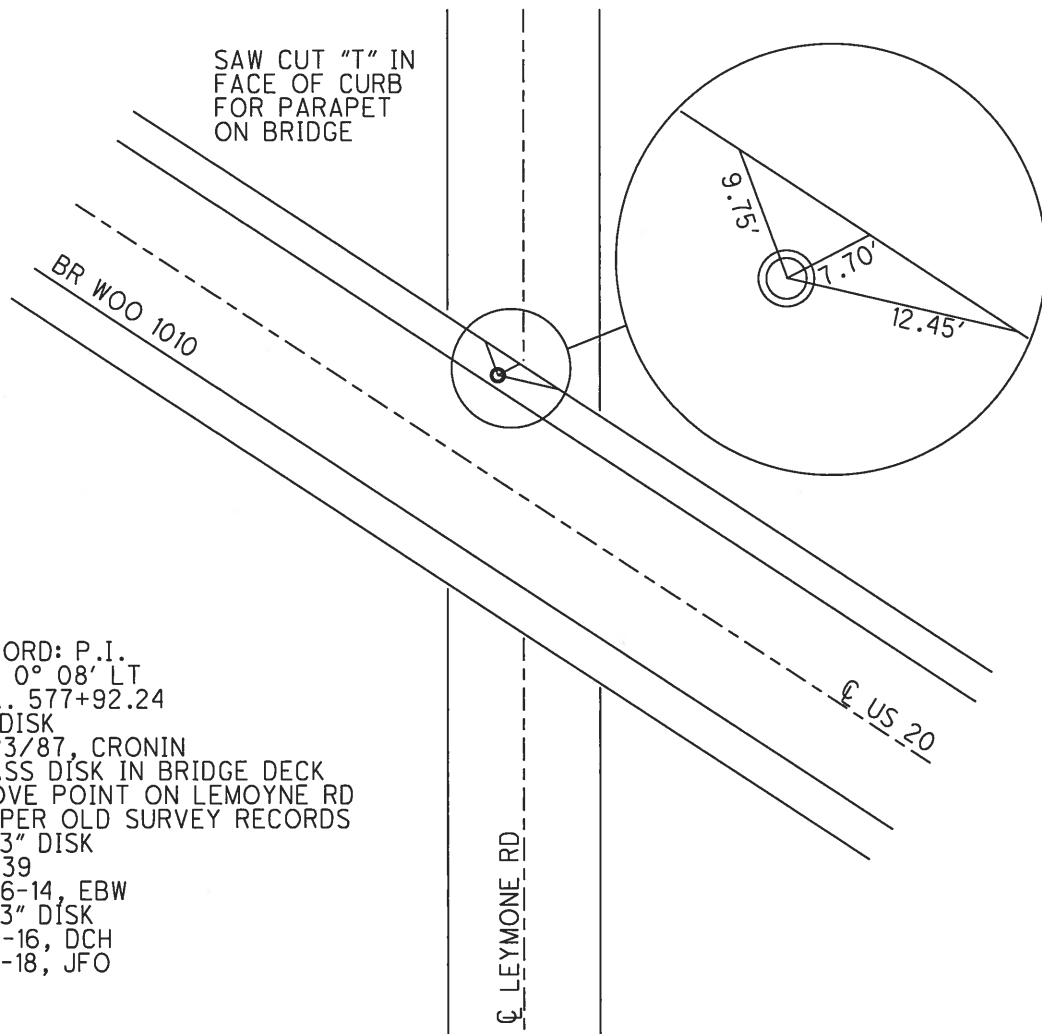


RECORD: P.I.
 $\Delta = 0^{\circ} 08' \text{ LT}$
 STA. 577+92.24
 FD DISK
 6/23/87, CRONIN
 BRASS DISK IN BRIDGE DECK
 ABOVE POINT ON LEMOYNE RD
 AS PER OLD SURVEY RECORDS
 FD 3" DISK
 REF 39
 8-26-14, EBW
 FD 3" DISK
 8-11-16, DCH
 5-7-18, JFO


O.D.O.T. DISTRICT 2 SURVEY OFFICE (USE ONLY)

PERSONNEL _____ REFERENCE NO. 39A SHEET 22 OF 23
 NOTES LEU DATE 8/11/16 ROUTE SR 20
 H.C. HOMAN WEATHER PTLY CLOUDY COUNTY WOOD
 R.C. LEU TEMP. 79° TOWNSHIP TROY
 SECTION RT 52
 T 6 N R 12 E

TYPE MONUMENT MAG NAIL
 ON SURFACE - BELOW ON
 LEFT - ☉ PAV'T - ~~RIGHT~~ 1.5'
- TO - EDGE PAVEMENT
 S.L.M. 50+00 REC., F/LEMOYNE RD.
 Grid: Northing: - Easting: -

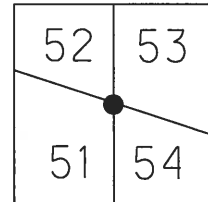

NOTE: POINT ON LEMOYNE RD.

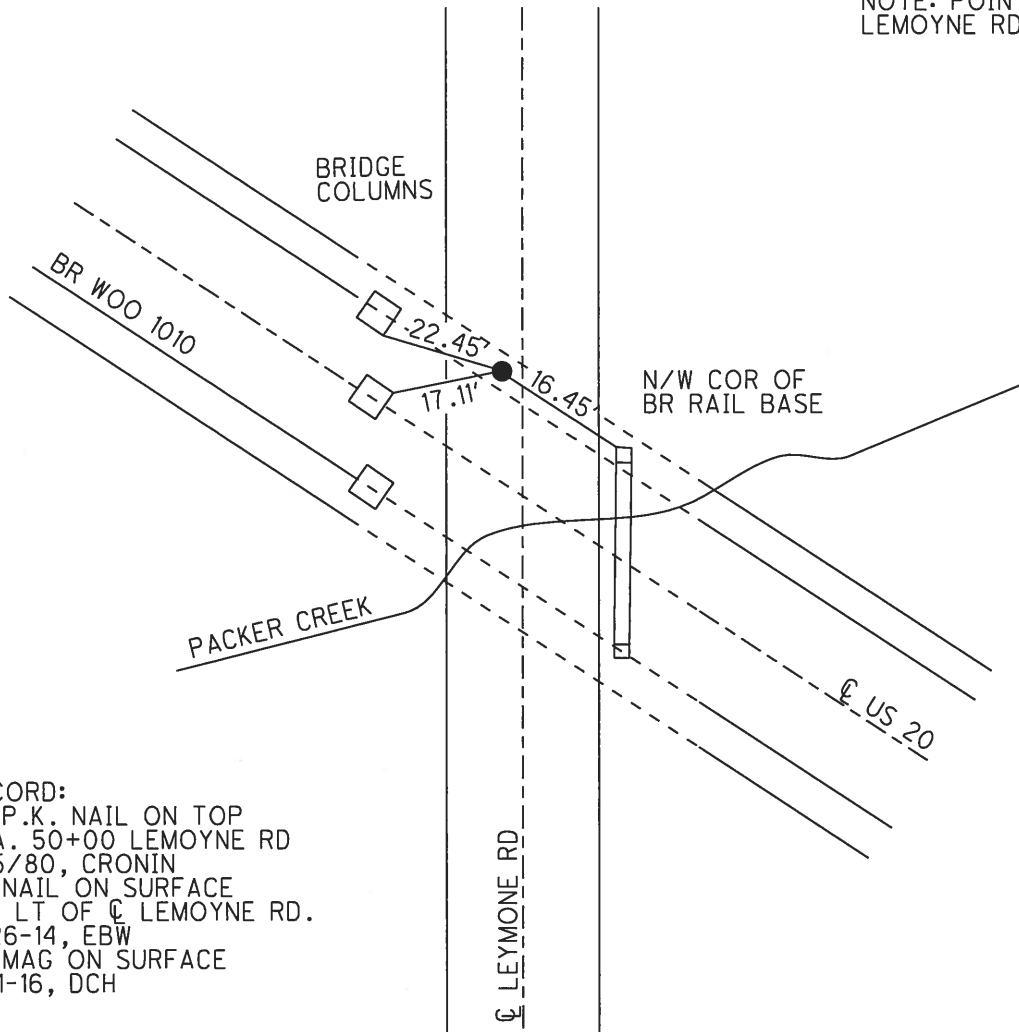


RECORD:
 FD P.K. NAIL ON TOP
 STA. 50+00 LEMOYNE RD
 6/5/80, CRONIN
 FD NAIL ON SURFACE
 1.5' LT OF ☉ LEMOYNE RD.
 8-26-14, EBW
 FD MAG ON SURFACE
 8-11-16, DCH


O.D.O.T. DISTRICT 2 SURVEY OFFICE (USE ONLY)

PERSONNEL _____ REFERENCE NO. 41 SHEET 23 OF 23
NOTES WESTFALL DATE 8-26-14 ROUTE US 20
H.C. _____ WEATHER FAIR COUNTY WOOD
R.C. _____ TEMP. 50° TOWNSHIP TROY
SECTION 56
T 6 N R 12 E

TYPE MONUMENT 5/8" IPIN
ON SURFACE - ~~BELOW~~ ON
~~LEFT~~ - Q PAV'T - RIGHT 3.7'
2.3' TO LT EDGE PAVEMENT
S.L.M. 587+71.99
GRID: NORTHING: 666364.212 EASTING: 1704505.516

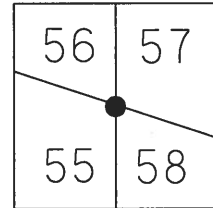

RECORD:
FD MONBOX
W/1" IPIN
5/2/96, TMR
FD 5/8" IPIN
ON TOP
CONC. BARRIOR
REF41
8/26/14, EBW

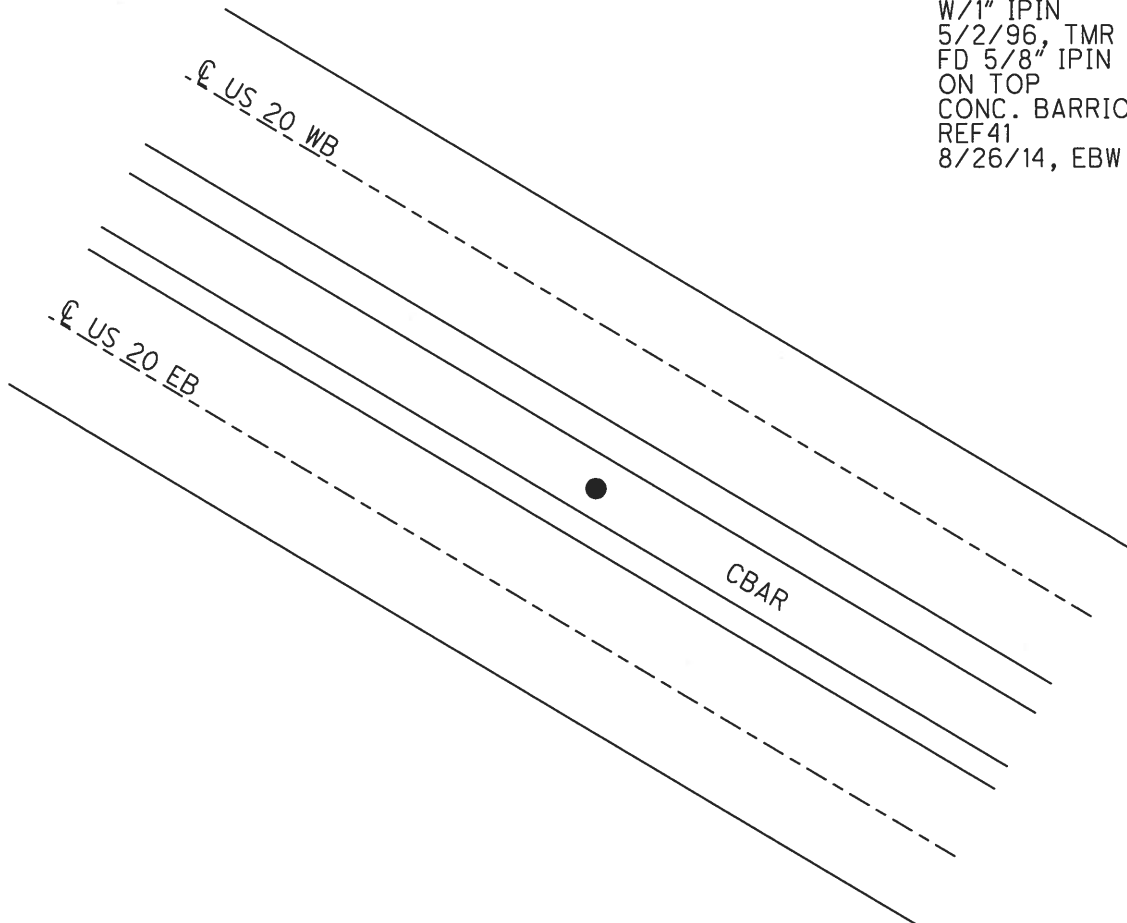

O.D.O.T. DISTRICT 2 SURVEY OFFICE (USE ONLY)

PERSONNEL

REFERENCE NO. 41 A

SHEET 1 OF 12

NOTES LOEHRKE
 H.C. ROUSOS
 R.C. CANTERBURY

DATE 5/2/76
 WEATHER FAIR
 TEMP. 50°

ROUTE US 20
 COUNTY WOOD
 TOWNSHIP TROY
 SECTION RT 60
 T 6 N R 12 E

DWG BY NIESE PID _____

TYPE MONUMENT SM.R.R.SPIKE

ON SURFACE - ~~BELOW~~ ON

OFFSET CL PAVEMENT 14.2' LT : ~~RT~~

1.5' LT OF LT EDGE PAVEMENT

STATION: 605+69


HORZ.DATUM: _____ GEOID: _____

GRID: NORTHING: _____ EASTING: _____

RT 60	RT 61
RT 59	RT 62



RECORD:
 FD SM.R.R.SPIKE
 5/2/96, CL
 SET P.K./WASHER
 7/8/96

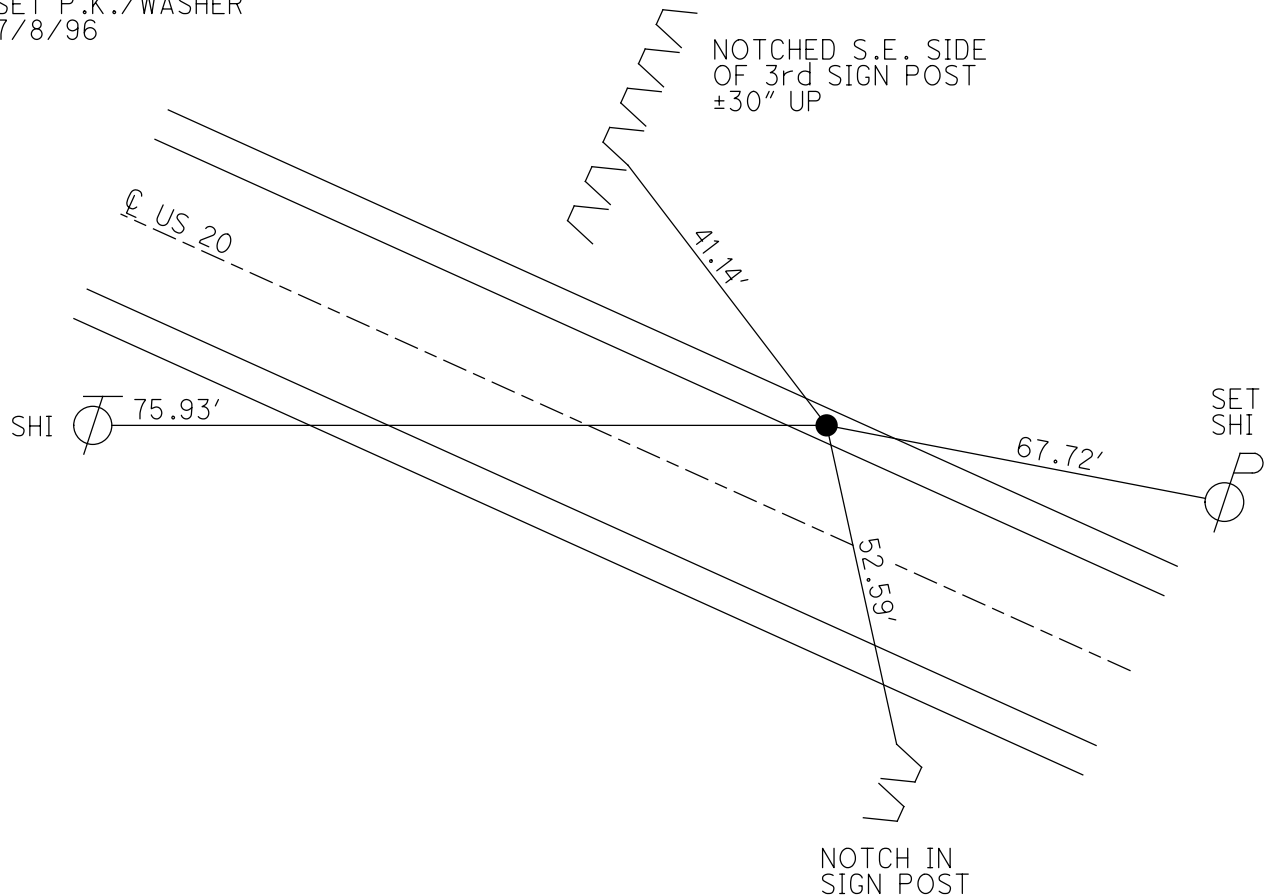

O.D.O.T. DISTRICT 2 SURVEY OFFICE (USE ONLY)

PERSONNEL

REFERENCE NO. 43

SHEET 2 OF 12

NOTES LOEHRKE

DATE 5/2/96

ROUTE US 20

H.C. ROUSOS

WEATHER NICE

COUNTY WOOD

R.C. CANTERBURY

TEMP. 50°

TOWNSHIP TROY

SECTION RT 60

DWG BY NIESE

PID _____

T 6 N R 12 E

TYPE MONUMENT SM.R.R.SPIKE

ON SURFACE - ~~BELOW~~ ON

OFFSET \odot PAVEMENT 12.6' LT : ~~RT~~

2.0' LT OF LT EDGE PAVEMENT


STATION: 618+74

HORZ.DATUM: _____


GEOID: _____

GRID: NORTHING: _____

EASTING: _____

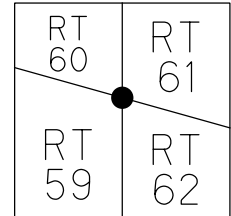

RECORD
 STA 618+59.20
 $\Delta = 00^{\circ}16'00''$ LT
 FD SM.R.R.SPIKE
 5/2/96, CL
 SET P.K./WASHER
 7/8/96

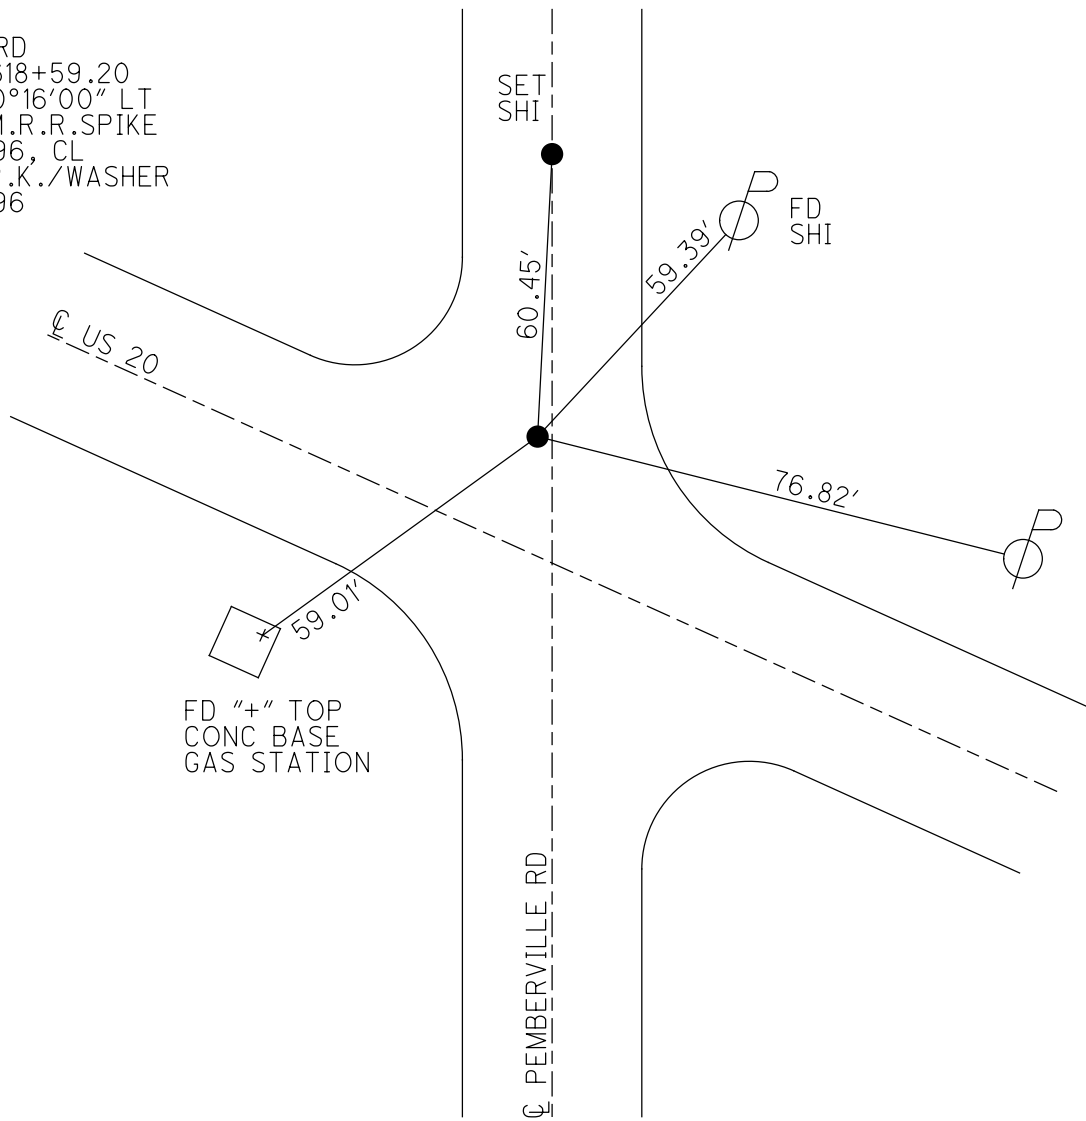

O.D.O.T. DISTRICT 2 SURVEY OFFICE (USE ONLY)

PERSONNEL _____ REFERENCE NO. 44 SHEET 3 OF 12
 NOTES LOEHRKE DATE 5/2/96 ROUTE US 20
 H.C. ROUSOS WEATHER FAIR COUNTY WOOD
 R.C. CANTERBURY TEMP. 52° TOWNSHIP TROY
 SECTION RT 61
 DWG BY NIESE PID _____ T 6 N R 12 E

TYPE MONUMENT SM.R.R.SPIKE

ON SURFACE - ~~BELOW~~ ON _____

OFFSET CL PAVEMENT 13.1' LT : ~~RT~~

1.6' LT OF LT EDGE PAVEMENT

STATION: 630+13


HORZ.DATUM: _____ GEOID: _____

GRID: NORTHING: _____ EASTING: _____

RT 60	RT 61
RT 59	RT 62



RECORD: P.O.T.
 STA 630+26.53
 FD SM.R.R.SPIKE
 5/2/96, CL
 SET P.K./WASHER
 7/8/96, CL

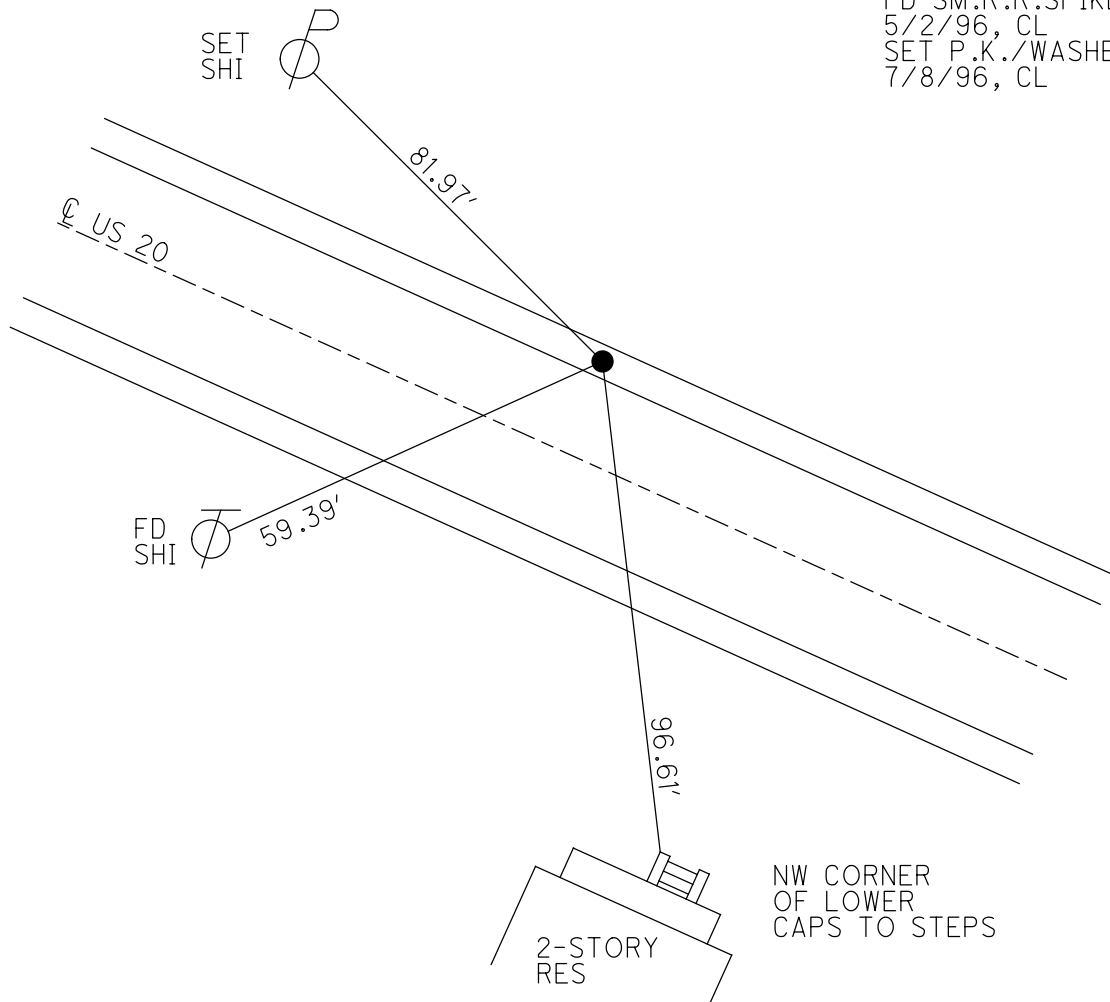

O.D.O.T. DISTRICT 2 SURVEY OFFICE (USE ONLY)

PERSONNEL _____

REFERENCE NO. 45

SHEET 4 OF 12

NOTES LOEHRKE

DATE 5/2/96

ROUTE US 20

H.C. ROUSOS

WEATHER FAIR

COUNTY WOOD

R.C. CANTERBURY

TEMP. 50°

TOWNSHIP TROY

SECTION RT 64

DWG BY NIESE

PID _____

T 6 N R 12 E

TYPE MONUMENT SM.R.R.SPIKE

ON SURFACE - ~~BELOW~~ ON

OFFSET Q PAVEMENT 12.7' LT : ~~RT~~

1.2' LT OF LT EDGE PAVEMENT

STATION: 643+18

HORZ.DATUM: _____

GEOID: _____


GRID: NORTHING: _____

EASTING: _____

64	RT 65
RT 63	RT 66



RECORD: P.O.T.
 STA 642+94.10
 FD SM.R.R.SPIKE
 5/2/96, CL
 SET P.K./WASHER
 7/8/96, CL

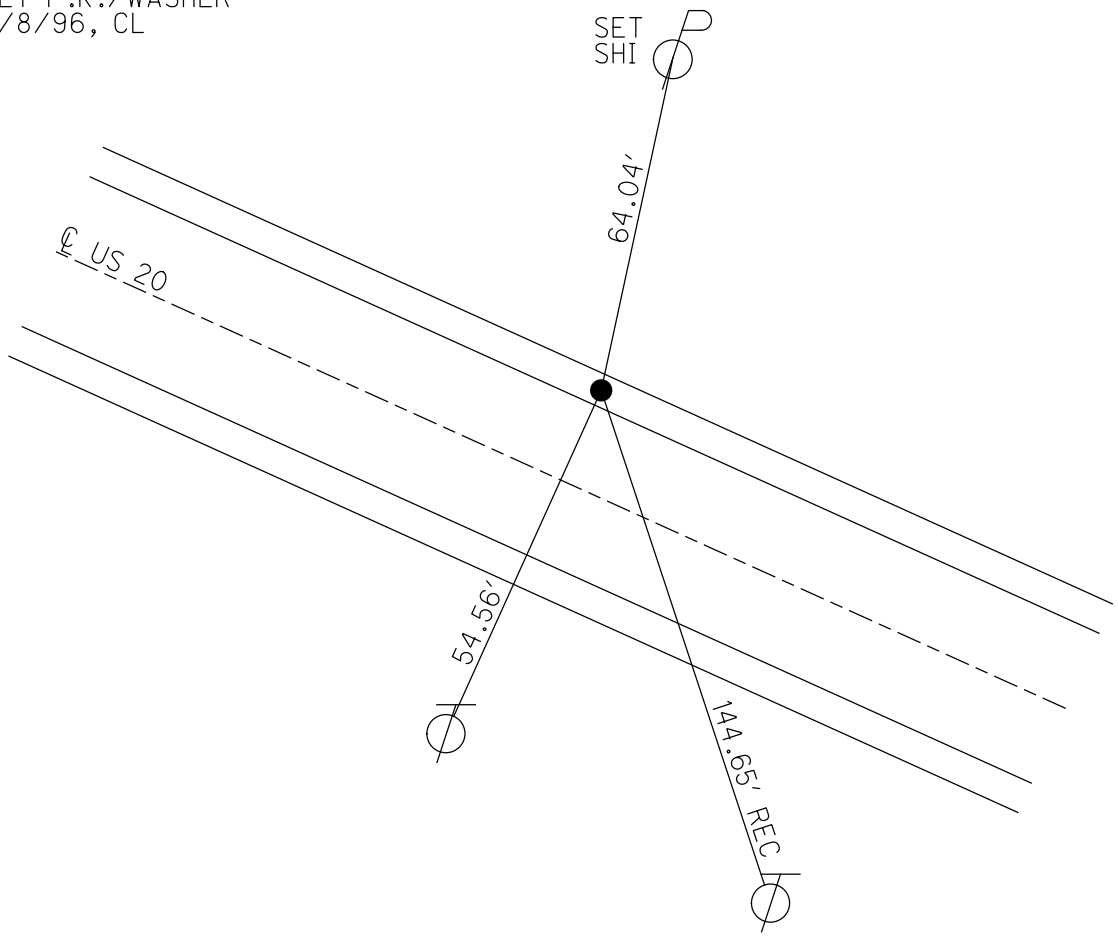

O.D.O.T. DISTRICT 2 SURVEY OFFICE (USE ONLY)

PERSONNEL _____ REFERENCE NO. 46 SHEET 5 OF 12
 NOTES LOEHRKE DATE 5/2/96 ROUTE US 20
 H.C. ROUSOS WEATHER FAIR COUNTY WOOD
 R.C. CANTERBURY TEMP. 50° TOWNSHIP TROY
 SECTION RT 65
 DWG BY NIESE PID _____ T 6 N R 12 E

TYPE MONUMENT SM.R.R.SPIKE

ON SURFACE - ~~BELOW~~ ON


OFFSET Q PAVEMENT 13.1' LT : ~~RT~~

1.3' LT OF LT EDGE PAVEMENT


STATION: 655+56

HORIZ.DATUM: _____ GEOID: _____

GRID: NORTHING: _____ EASTING: _____

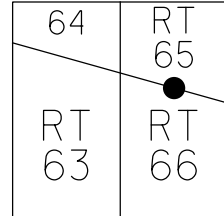

RECORD: P.O.T.
 STA 655+35.95
 FD SM.R.R.SPIKE
 5/2/96, CL
 SET P.K./WASHER
 7/8/96, CL

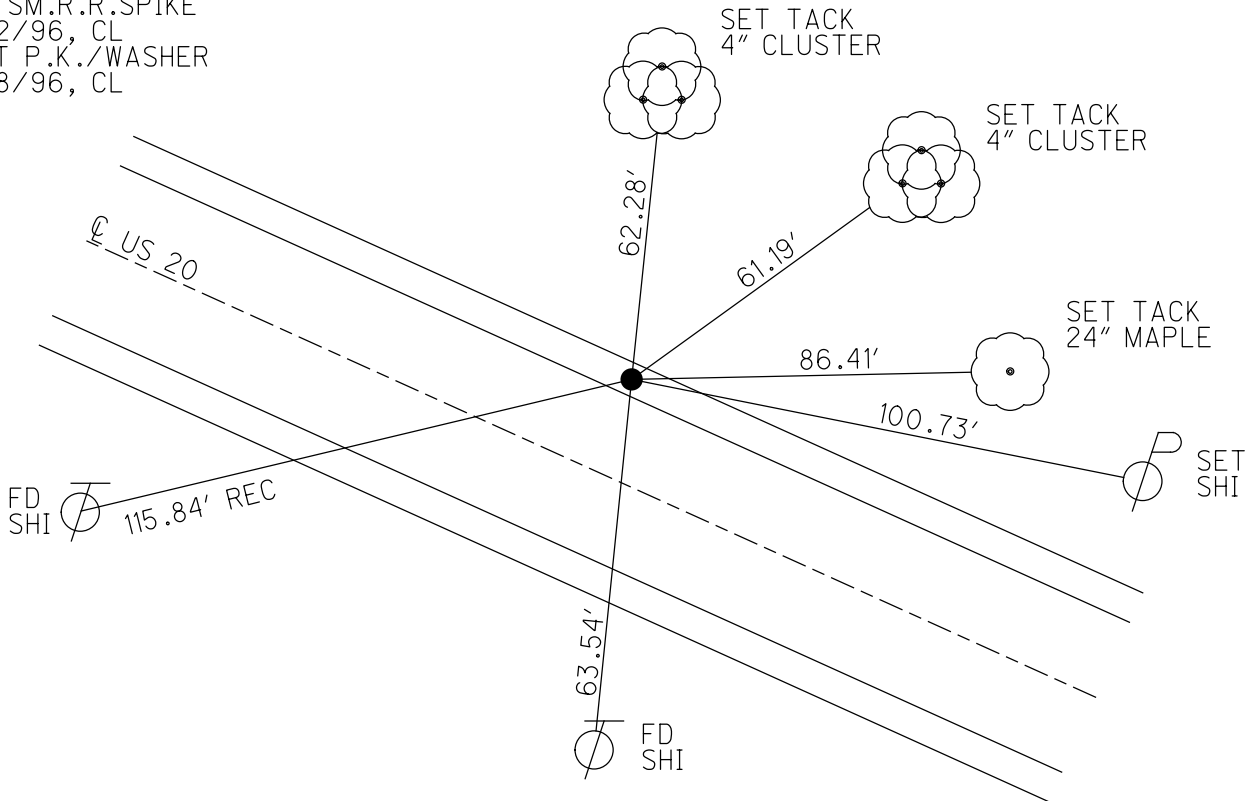

O.D.O.T. DISTRICT 2 SURVEY OFFICE (USE ONLY)

PERSONNEL

REFERENCE NO. 47

SHEET 6 OF 12

NOTES LOEHRKE DATE 5/2/96
 H.C. ROUSOS WEATHER FAIR
 R.C. CANTERBURY TEMP. 50°

ROUTE US 20
 COUNTY WOOD
 TOWNSHIP TROY
 SECTION RT 68
 T 6 N R 12 E

DWG BY NIESE PID _____

TYPE MONUMENT SM.R.R.SPIKE

ON SURFACE - ~~BELOW~~ ON


OFFSET ϕ PAVEMENT 13.2' LT : ~~RT~~

2.3' LT OF LT EDGE PAVEMENT


STATION: 679+26

HORZ.DATUM: _____ GEOID: _____

GRID: NORTHING: _____ EASTING: _____

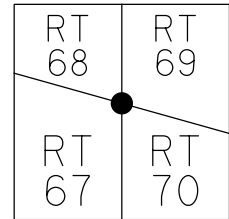


RECORD:
 STA 679+03.80
 $\Delta = 00^{\circ}21'10''$ RT
 FD SM.R.R.SPIKE
 5/2/96, CL
 SET P.K./WASHER
 7/8/96

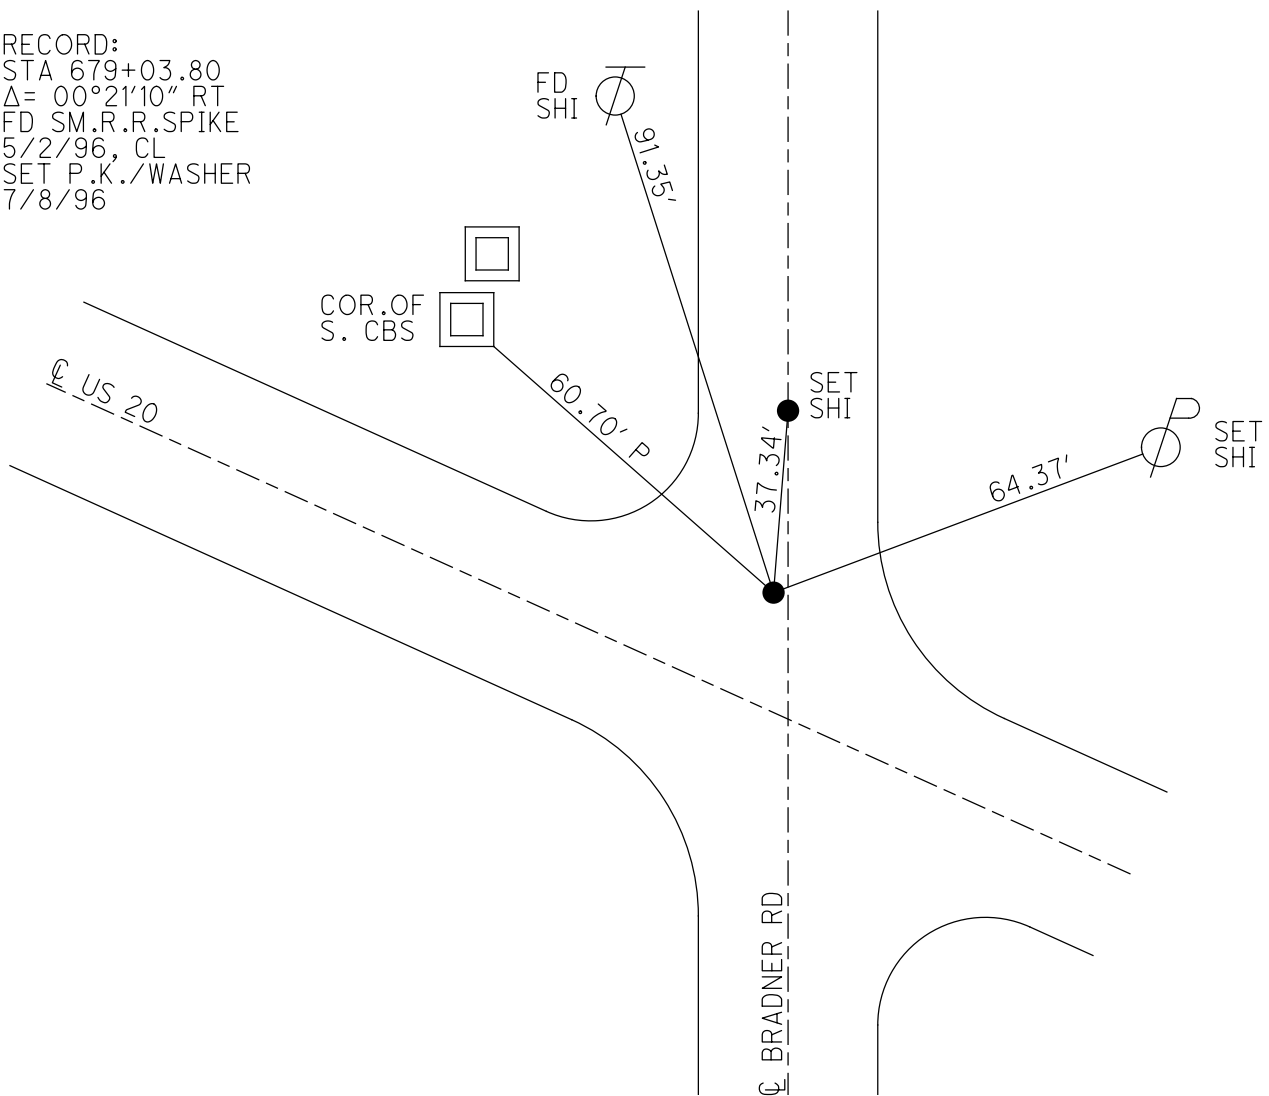

O.D.O.T. DISTRICT 2 SURVEY OFFICE (USE ONLY)


PERSONNEL _____ REFERENCE NO. 48 SHEET 7 OF 12
 NOTES LOEHRKE DATE 5/2/96 ROUTE US 20
 H.C. ROUSOS WEATHER FAIR COUNTY WOOD
 R.C. CANTERBURY TEMP. 50° TOWNSHIP TROY
 DWG BY NIESE PID _____ SECTION RT 72
 T 6 N R 12 E

TYPE MONUMENT SM.R.R.SPIKE
 ON SURFACE - ~~BELOW~~ ON
 OFFSET \varnothing PAVEMENT 13.0' LT : ~~RT~~
 1.6' LT OF LT EDGE PAVEMENT
 STATION: 694+21

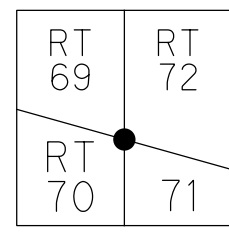

HORIZ.DATUM: _____ GEOID: _____
 GRID: NORTHING: _____ EASTING: _____



RECORD: P.O.T.
 STA 693+96.93
 FD SM.R.R.SPIKE
 5/2/96, CL
 SET P.K./WASHER
 7/8/96

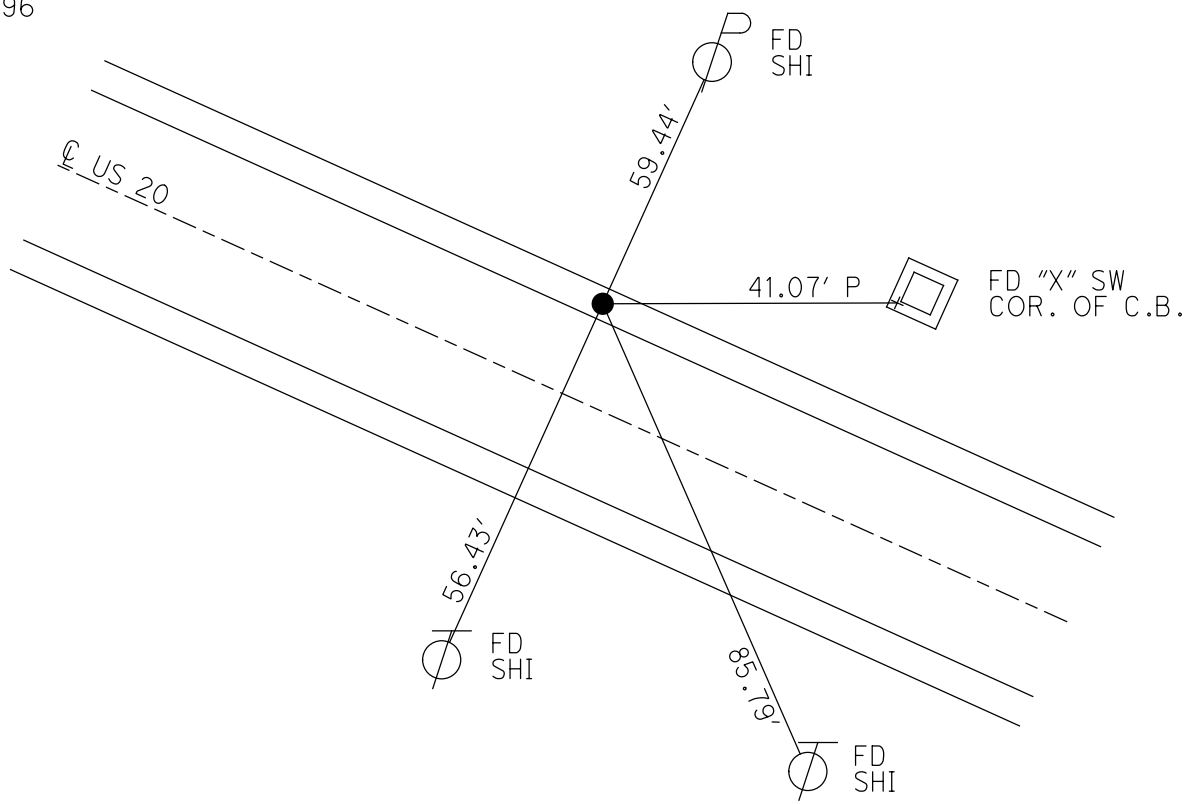

O.D.O.T. DISTRICT 2 SURVEY OFFICE (USE ONLY)


PERSONNEL _____ REFERENCE NO. 49 SHEET 8 OF 12
 NOTES LOEHRKE DATE 5/2/96 ROUTE US 20
 H.C. ROUSOS WEATHER FAIR COUNTY WOOD
 R.C. CANTERBURY TEMP. 50° TOWNSHIP TROY
 DWG BY NIESE PID _____ SECTION RT 73
 T 6 N R 12 E

TYPE MONUMENT SM.SPIKE
 ON SURFACE - ~~BELOW~~ ON
 OFFSET CL PAVEMENT 13.0' LT : ~~RT~~
1.6' TO LT EDGE PAVEMENT
 STATION: 714+45

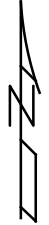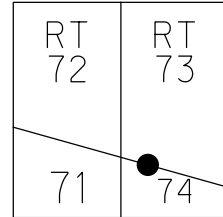

HORIZ.DATUM: _____ GEOID: _____
 GRID: NORTHING: _____ EASTING: _____

RECORD:
 STA 714+18.92
 STA 713+94.78
 FD SM.SPIKE
 5/2/96, CL
 SET P.K./WASHER
 7/8/96, MDB

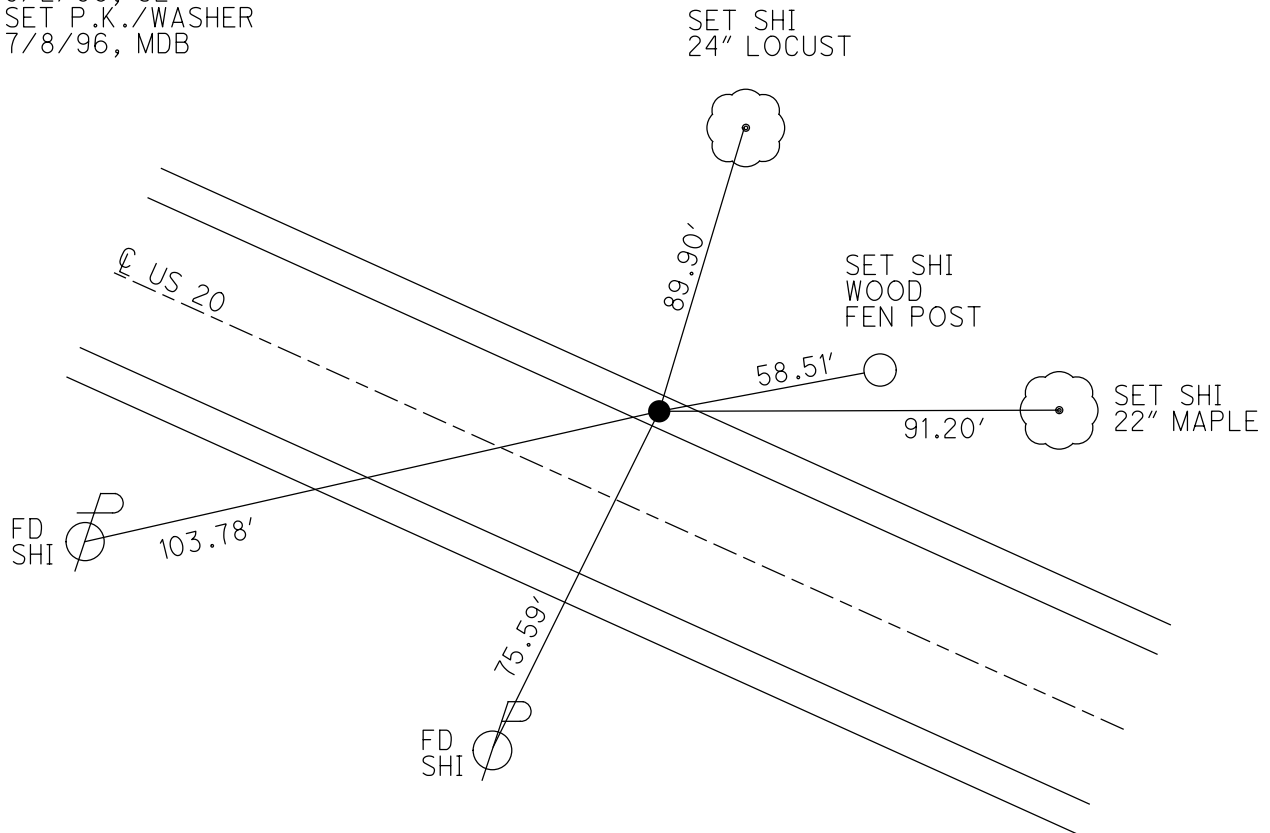

O.D.O.T. DISTRICT 2 SURVEY OFFICE (USE ONLY)

PERSONNEL _____

REFERENCE NO. 49 A

SHEET 9 OF 12

NOTES LOEHRKE

DATE 5/2/96

ROUTE US 20

H.C. ROUSOS

WEATHER FAIR

COUNTY WOOD

R.C. CANTERBURY

TEMP. 50°

TOWNSHIP TROY

SECTION RT 73

DWG BY NIESE PID _____

T 6 N R 12 E

TYPE MONUMENT NAIL/SHINER

ON SURFACE - ~~BELOW~~ ON

OFFSET CL PAVEMENT 13.3' LT : ~~RT~~

2.2' TO LT EDGE PAVEMENT

STATION: 721+49

HORIZ.DATUM: _____

GEOID: _____


GRID: NORTHING: _____

EASTING: _____

RT 72	RT 73
71	74 ●



RECORD:
 STA 721+00
 FD NAIL/SHINER
 5/2/96, CL
 SET P.K./WASHER
 7/8/96, CL

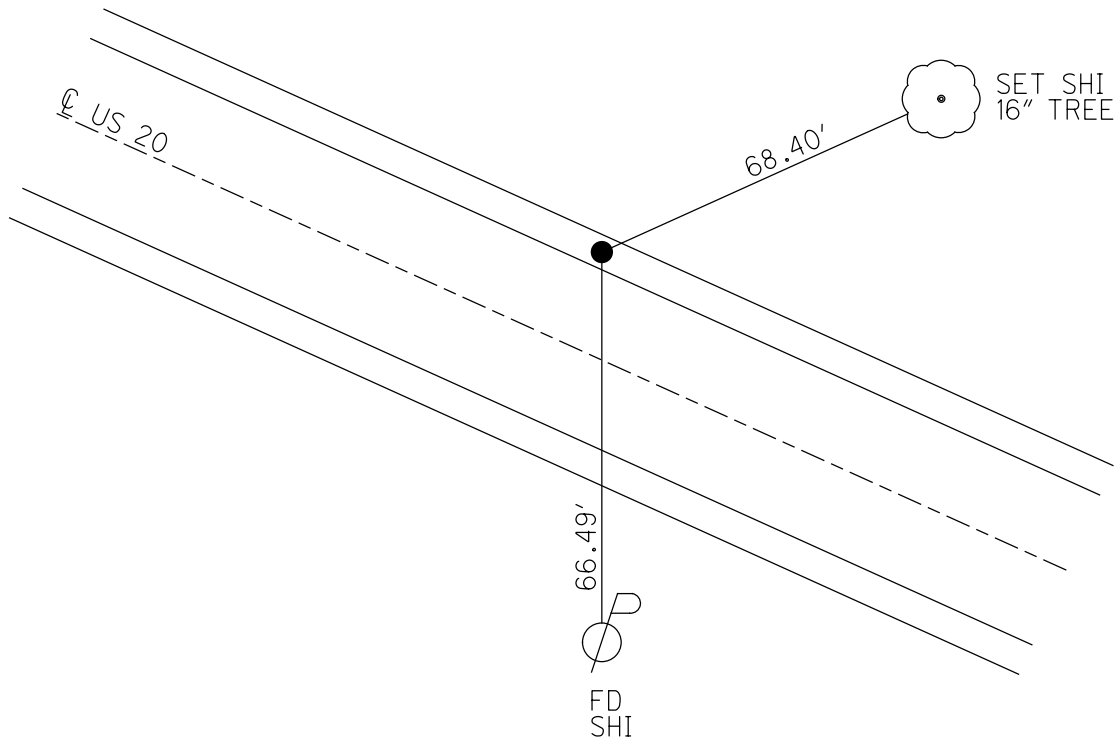


O.D.O.T. DISTRICT 2 SURVEY OFFICE (USE ONLY)


PERSONNEL _____ REFERENCE NO. 50 SHEET 10 OF 12
 NOTES LOEHRKE DATE 5/2/96 ROUTE US 20
 H.C. ROUSOS WEATHER FAIR COUNTY WOOD
 R.C. CANTERBURY TEMP. 50° TOWNSHIP TROY
 SECTION RT 76
 DWG BY NIESE PID _____ T 6 N R 12 E

TYPE MONUMENT P.K. NAIL
 ON SURFACE - ~~BELOW~~ ON
 OFFSET CL PAVEMENT 13.2' LT : ~~RT~~
1.5' TO LT EDGE PAVEMENT
 STATION: 724+38

HORZ. DATUM: _____ GEOID: _____
 GRID: NORTHING: _____ EASTING: _____

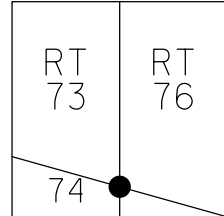

RECORD:
 STA 727+17.26
 FD P.K. NAIL
 5/2/96, CL
 SET P.K./WASHER
 7/8/96, CL

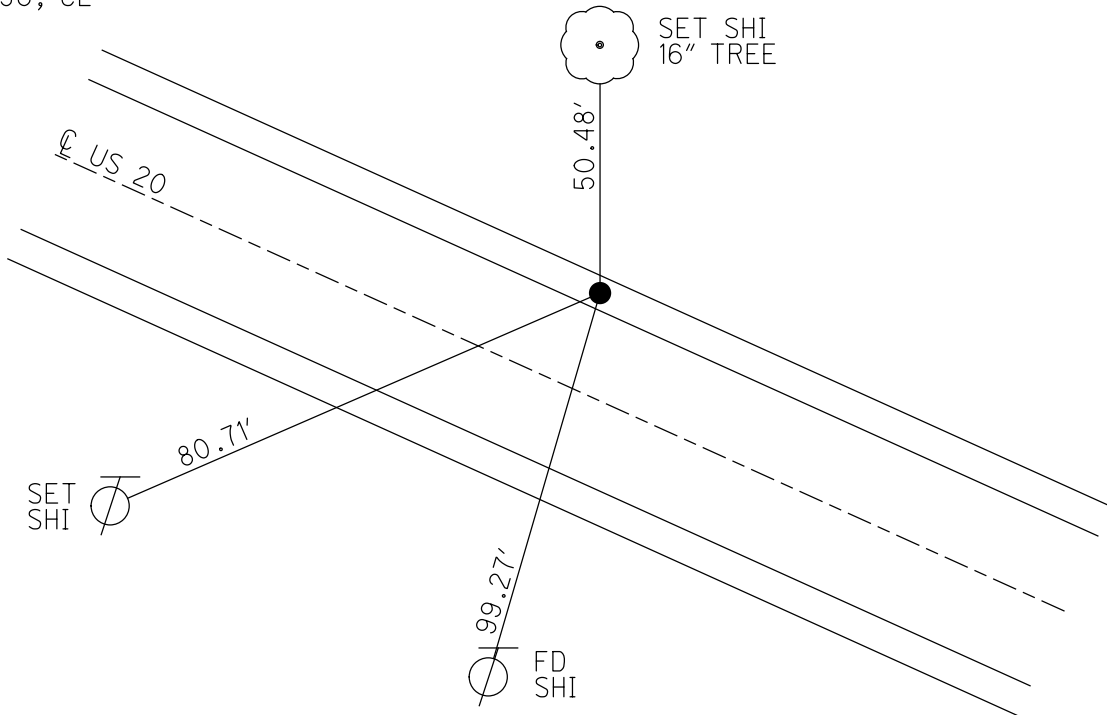

O.D.O.T. DISTRICT 2 SURVEY OFFICE (USE ONLY)

PERSONNEL

REFERENCE NO. 50 A

SHEET 11 OF 12

NOTES LOEHRKE

DATE 5/2/96

ROUTE US 20

H.C. ROUSOS

WEATHER FAIR

COUNTY WOOD

R.C. CANTERBURY

TEMP. 60°

TOWNSHIP TROY

SECTION 76

DWG BY NIESE PID _____

T 6 N R 12 E

TYPE MONUMENT SM.R.R.SPIKE

ON SURFACE - ~~BELOW~~ ON

OFFSET \odot PAVEMENT 13.0' LT : ~~RT~~

1.7' TO LT EDGE PAVEMENT


STATION: 727+27.43

HORZ.DATUM: _____


GEOID: _____

GRID: NORTHING: _____

EASTING: _____

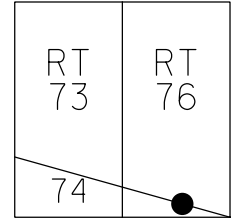

RECORD:
 STA 727+17.26
 FD SM.R.R.SPIKE
 5/2/96, CL
 SET P.K./WASHER
 7/8/96, CL

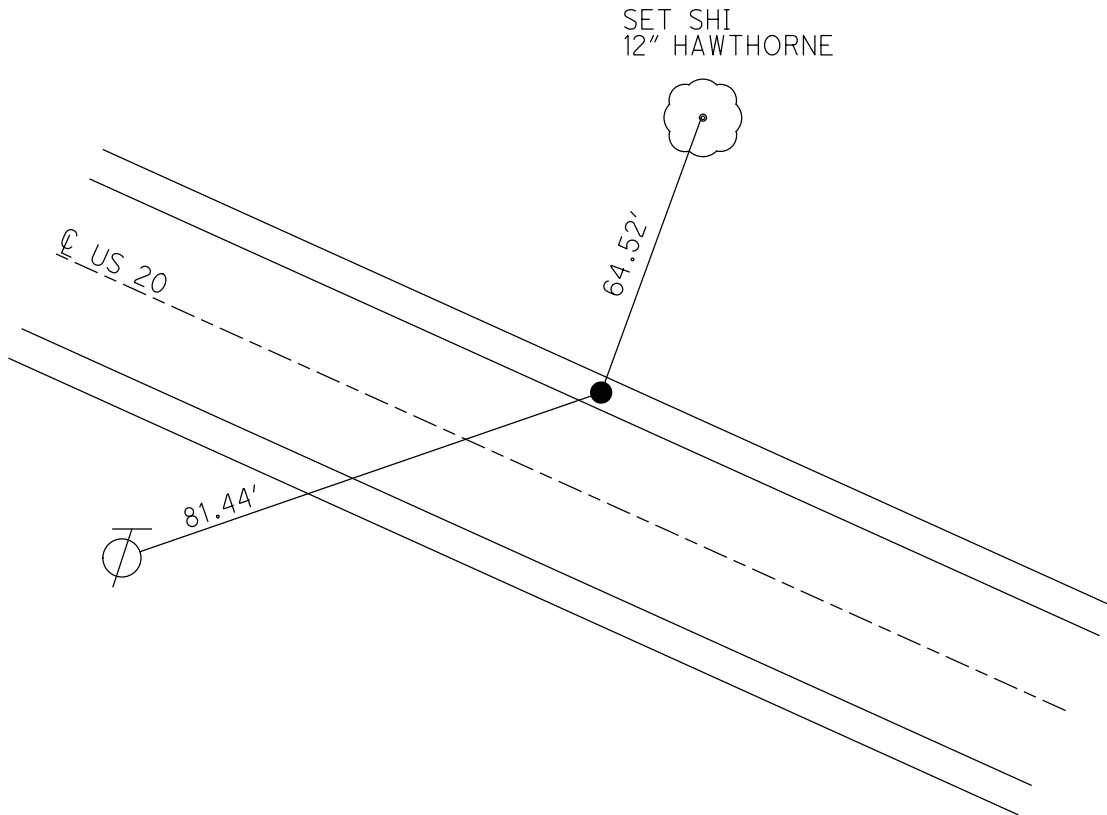

O.D.O.T. DISTRICT 2 SURVEY OFFICE (USE ONLY)

PERSONNEL _____

REFERENCE NO. 51

SHEET 12 OF 12

NOTES LOEHRKE

DATE 5/2/96

ROUTE US 20

H.C. ROUSOS

WEATHER FAIR

COUNTY WOOD

R.C. CANTERBURY

TEMP. 50°

TOWNSHIP TROY

SECTION RT 76

DWG BY NIESE

PID _____

T 6 N R 12 E

TYPE MONUMENT SM.R.R.SPIKE

ON SURFACE - ~~BELOW~~ ON

OFFSET Q PAVEMENT 12.7' LT : ~~RT~~

2.0' TO LT EDGE PAVEMENT


STATION: 739+62

HORZ.DATUM: _____

GEOID: _____

GRID: NORTHING: _____

EASTING: _____

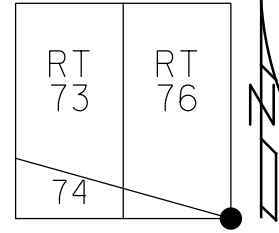

RECORD
 STA 739+72.80
 $\Delta = 00^{\circ}00'00''$
 FD SM.R.R.SPIKE
 5/2/96, CL
 SET P.K./WASHER
 7/8/96, CL

