

O.D.O.T. DISTRICT 2 SURVEY OFFICE (USE ONLY)

PERSONNEL

REFERENCE NO. 1 A

SHEET 2 OF 15

NOTES RHOADES

DATE 4/9/14

ROUTE US 20

H.C. ROUSOS

WEATHER CLEAR

COUNTY WOOD

R.C. HOMAN

TEMP. 41°

TOWNSHIP PERRYSBURG

GABLE

SECTION 12 MILE RESERVE

DWG BY NIESE

PID _____

T 4 N

TYPE MONUMENT MONBOX

ON SURFACE - ~~BELOW~~ ON

OFFSET Q PAVEMENT _____ LT : RT

_____ TO _____ EDGE PAVEMENT



STATION: 24+47

HORZ.DATUM: _____

GEOID: _____

GRID: NORTHING: 690404.886

EASTING: 1656011.473

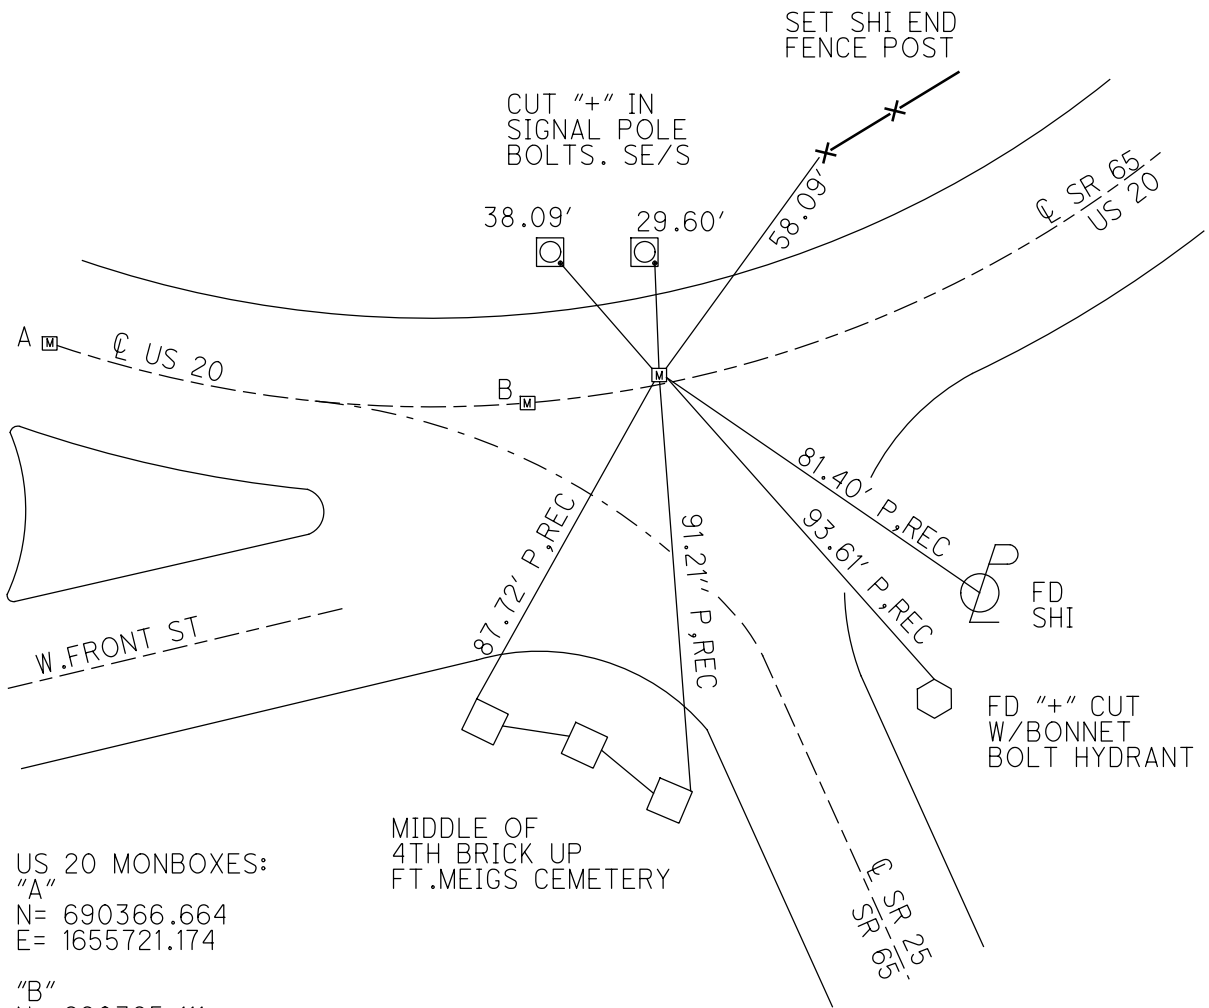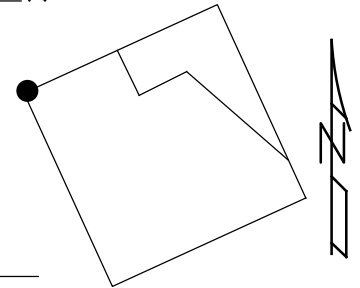

US 20 MONBOXES:

"A"
N= 690366.664
E= 1655721.174

"B"
N= 690395.111
E= 1655991.073

MIDDLE OF
4TH BRICK UP
FT. MEIGS CEMETERY

O.D.O.T. DISTRICT 2 SURVEY OFFICE

PERSONNEL _____

REFERENCE NO. _____

SHEET _____ OF _____

NOTES BARNHISEL

H.C. Homan

R.C. Beaumont

DATE 9/05/02

WEATHER SUNNY

TEMP. +70°

ROUTE 65 & US 20

COUNTY WOOD

TOWNSHIP Perrysburg

SECTION _____

T. _____ R. _____



TYPE MONUMENT Max Box

ON SURFACE - BELOW yes

LEFT- & PAV'T. - RIGHT _____

18.3' TO LT EDGE PAVEMENT curb

S.L.M. 24+47

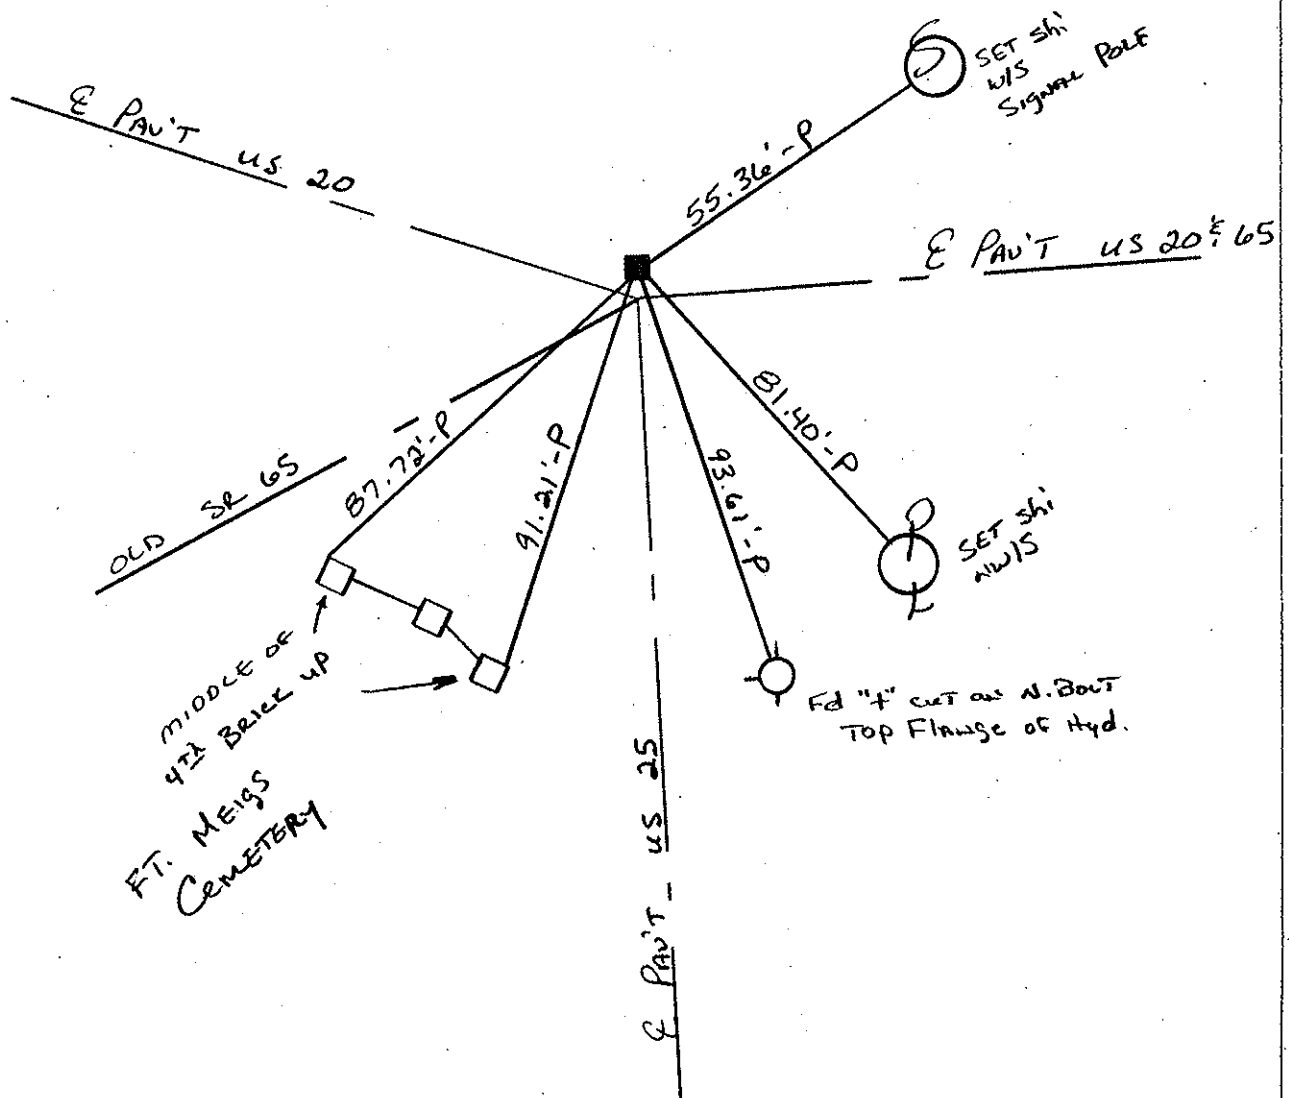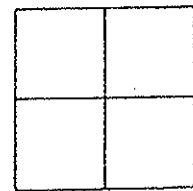


County WOOD S.R. 65 E US 20

Township PERRYSBURG

Section _____

T N, R E

Personnel LOEHRKE 


Hoffman RC

LOEHRKE HC

Date 6-4-85

Weather PT CLOUDY

Temp. + 70

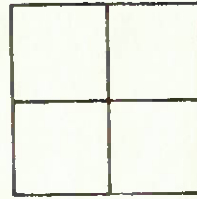


Mon. Box No L.D. ON & PAUT SR 25 N.

STA 24+28.80

18.25 Rt of Lt. CURBING


NOT COVER

SLM 24+47

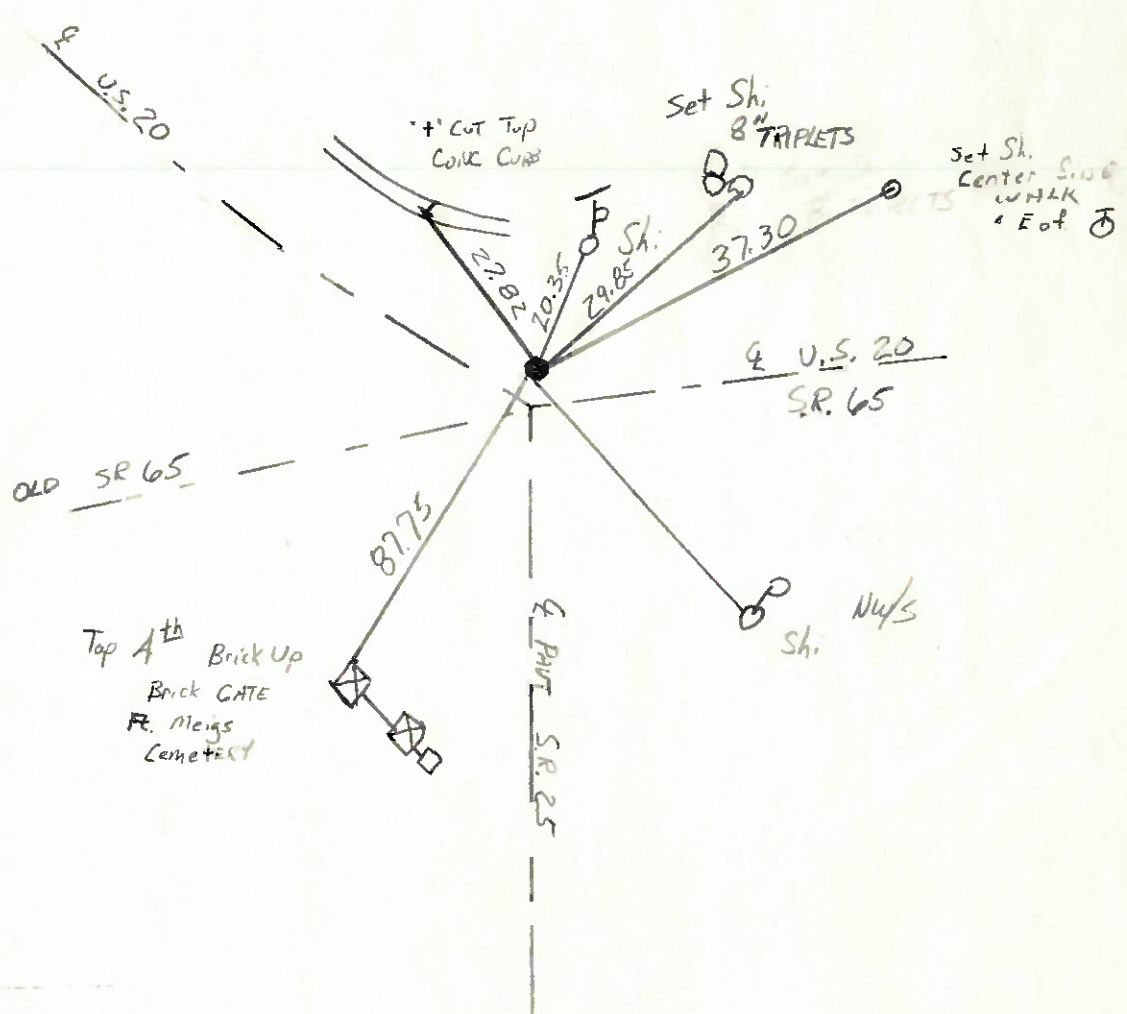

PERSONNEL	TITLE	PERSONNEL	TITLE	COUNTY	DATE	WEATHER	TEMP.
Stone				Wood	9 April 75	Cloudy	33°
Michalak				#20			
Dennis				Perryburg			
Curtis							

DESCRIPTION: References to Central Points JOB NO. _____

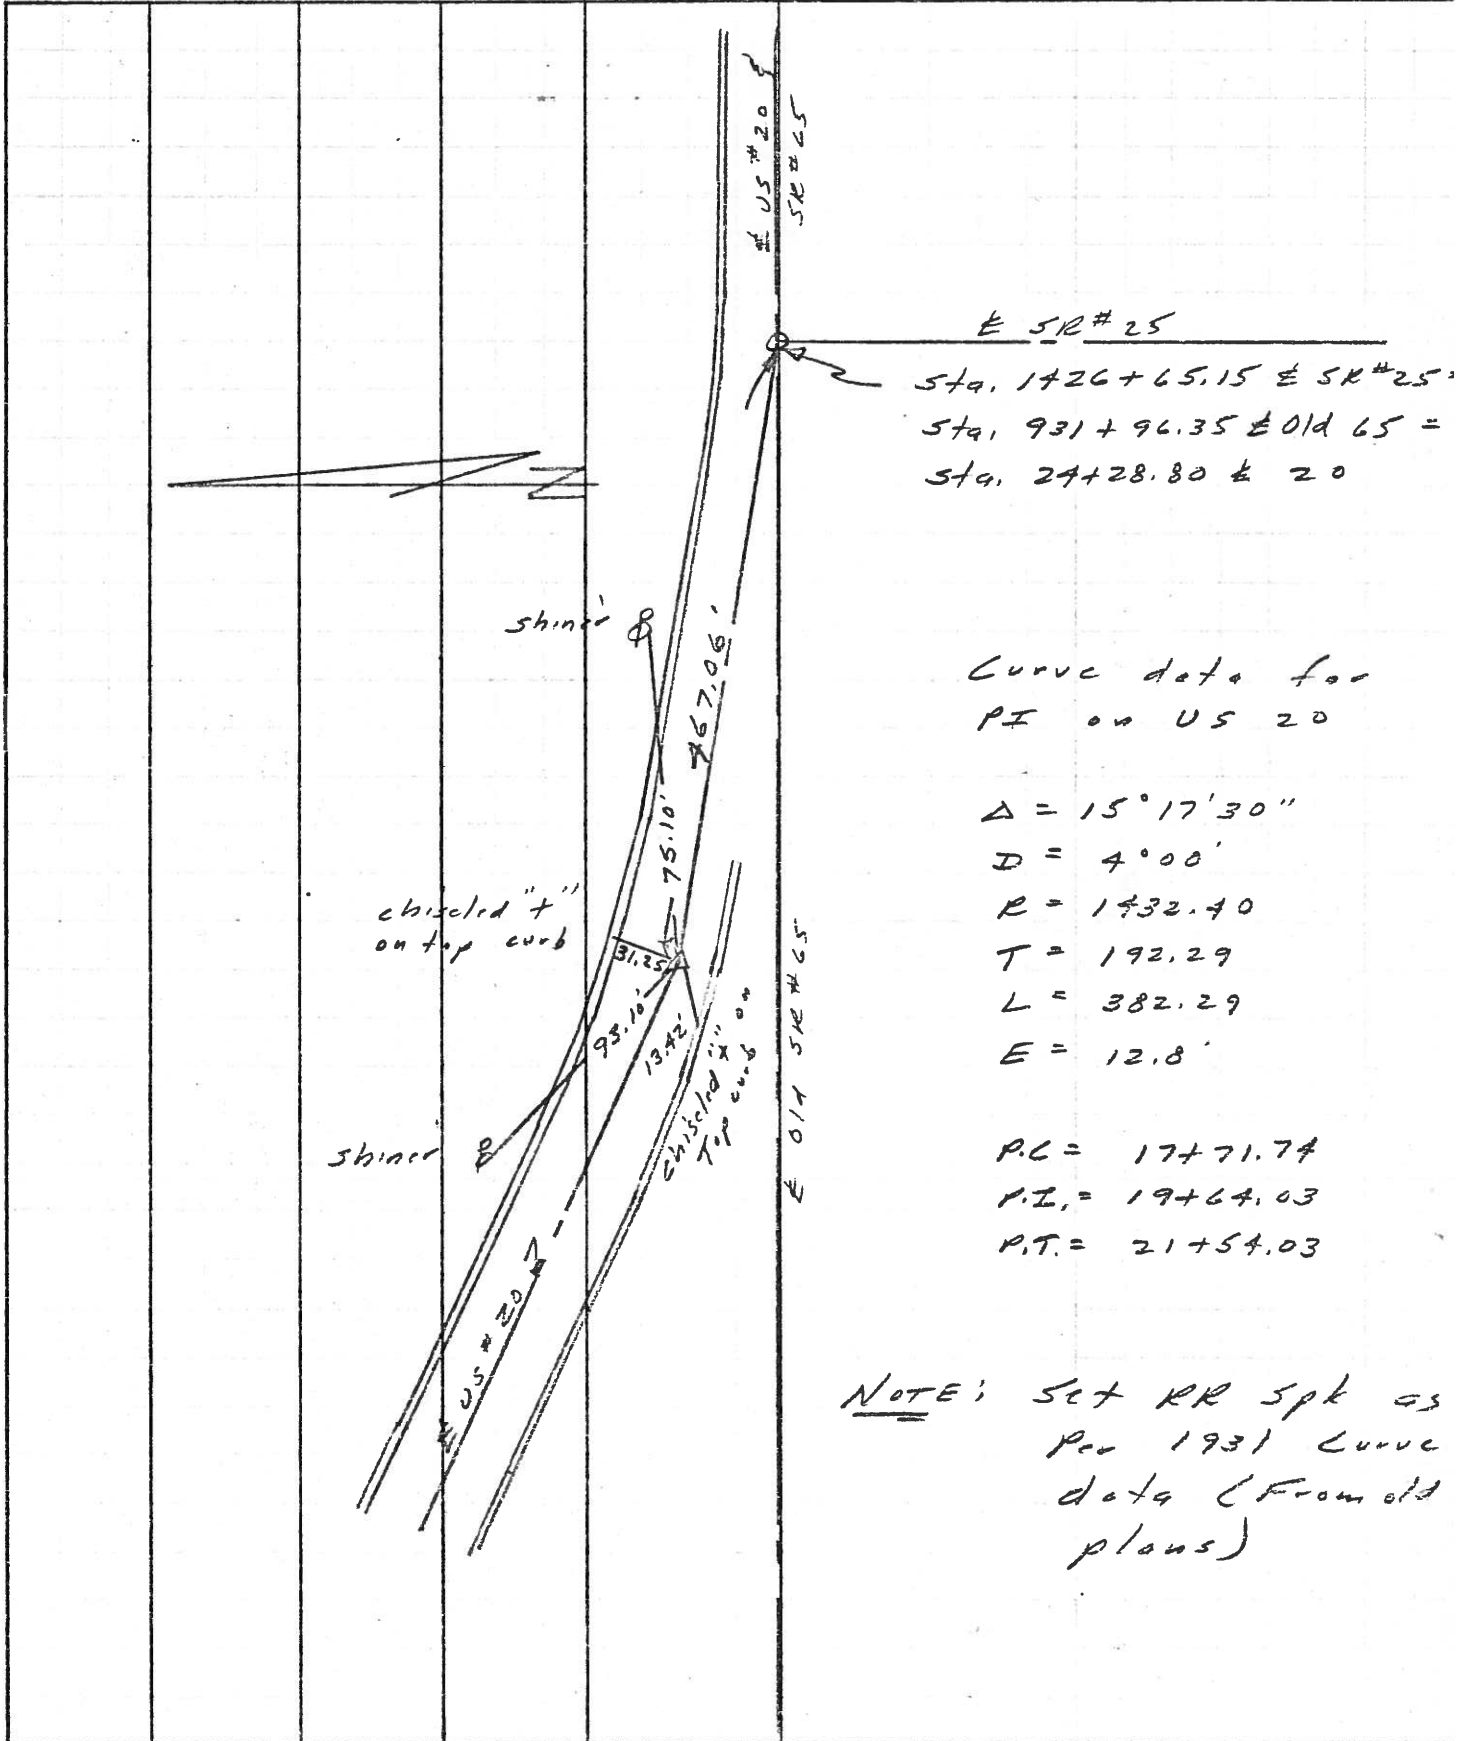

NOTE: Set RR Spt as per 1931 Curve data (From old plans)