

O.D.O.T. DISTRICT 2 SURVEY OFFICE (USE ONLY)

PERSONNEL

REFERENCE NO. 3

SHEET 4 OF 15

NOTES BURNSIDE

DATE 2/27/20

ROUTE US 20

H.C. SMITH

WEATHER CLOUDY

COUNTY WOOD

R.C. HOFFMAN

TEMP. 32°

TOWNSHIP PERRYSBURG

SECTION 12 MILE RESERVE

DWG BY NIESE

PID _____

T 4 N

TYPE MONUMENT P.K. NAIL

ON SURFACE - ~~BELOW~~ ON

OFFSET ☉ PAVEMENT ON LT : RT

- TO - EDGE PAVEMENT


STATION: 91+34.4

HORZ.DATUM: _____


GEOID: _____

GRID: NORTHING: _____

EASTING: _____

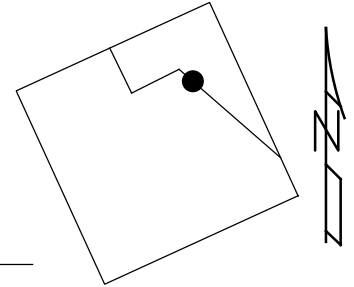

RECORD:
FD P.K. NAIL
2/27/70, BURNSIDE

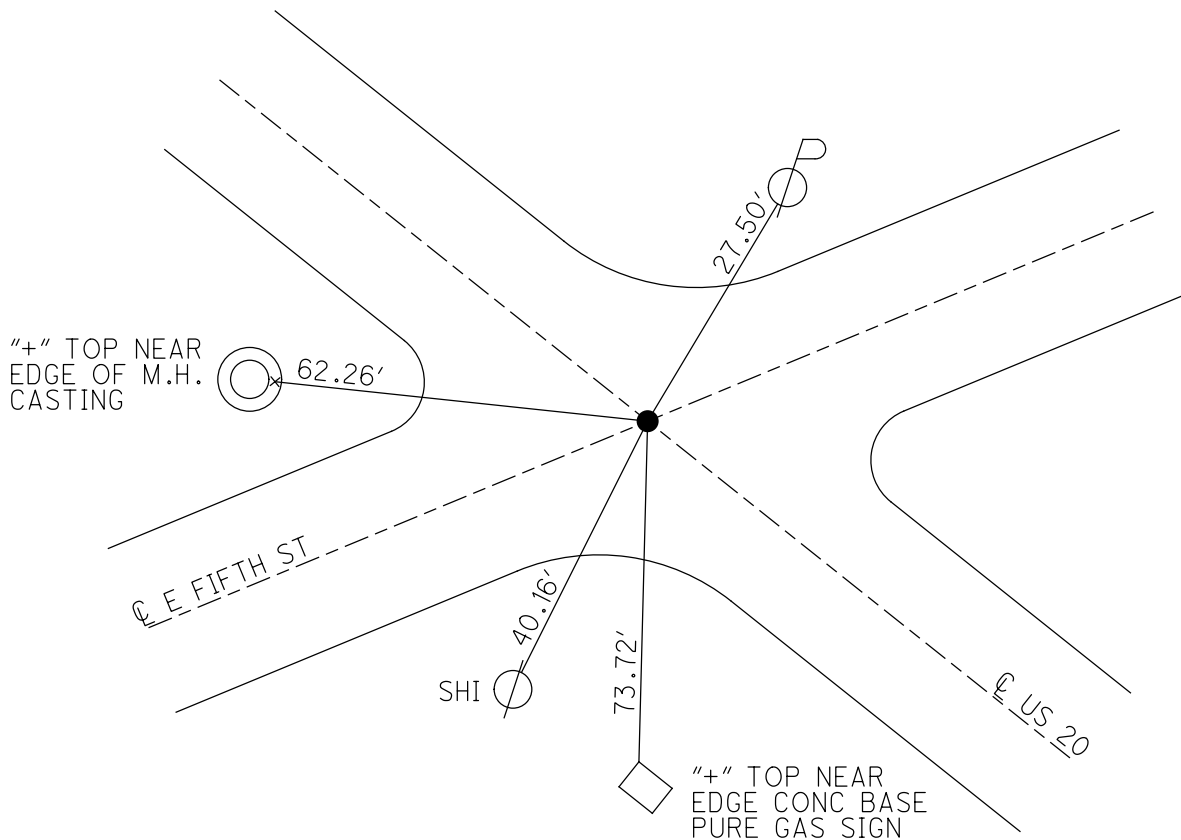

PERSONNEL	TITLE	PERSONNEL	TITLE
BURNSIDE			
SMITH			
HOFFMAN			

COUNTY WOOD DATE 2-27-70
 S. R. U.S.#20 WEATHER CLOUDY
 SEC. PERRYSBURG CORP. TEMP. +32°

DESCRIPTION CONTROL TIES (SANDUSKY ST) JOB NO. _____
 LEFT CENTER LINE RIGHT

