


O.D.O.T. DISTRICT 2 SURVEY OFFICE (USE ONLY)


PERSONNEL _____ REFERENCE NO. 4 SHEET 1 OF 13

NOTES	<u>ROUSOS</u>	DATE	<u>4/16/02</u>	ROUTE	<u>US 20</u>
H.C.	<u>HOMAN</u>	WEATHER	<u>SUNNY</u>	COUNTY	<u>WOOD</u>
R.C.	<u>ROUSOS</u>	TEMP.	<u>85°</u>	TOWNSHIP	<u>PERRYSBURG</u>
				SECTION	<u>5</u>
				T	<u>4</u> N
				R	<u>11</u> E

TYPE MONUMENT _____ LG. R.R. SPIKE _____
 ON SURFACE - BELOW _____ 2" _____
 LEFT - Q PAV'T - RIGHT _____ ON _____
 _____ TO _____ EDGE PAVEMENT _____
 S.L.M. _____ 102+32 _____
 GRID: NORTHING: _____ EASTING: _____

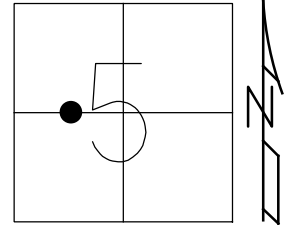


RECORD:
 R.R. SPK
 08-16-88, MB
 FD R.R. SPIKE
 4-16-02, DH

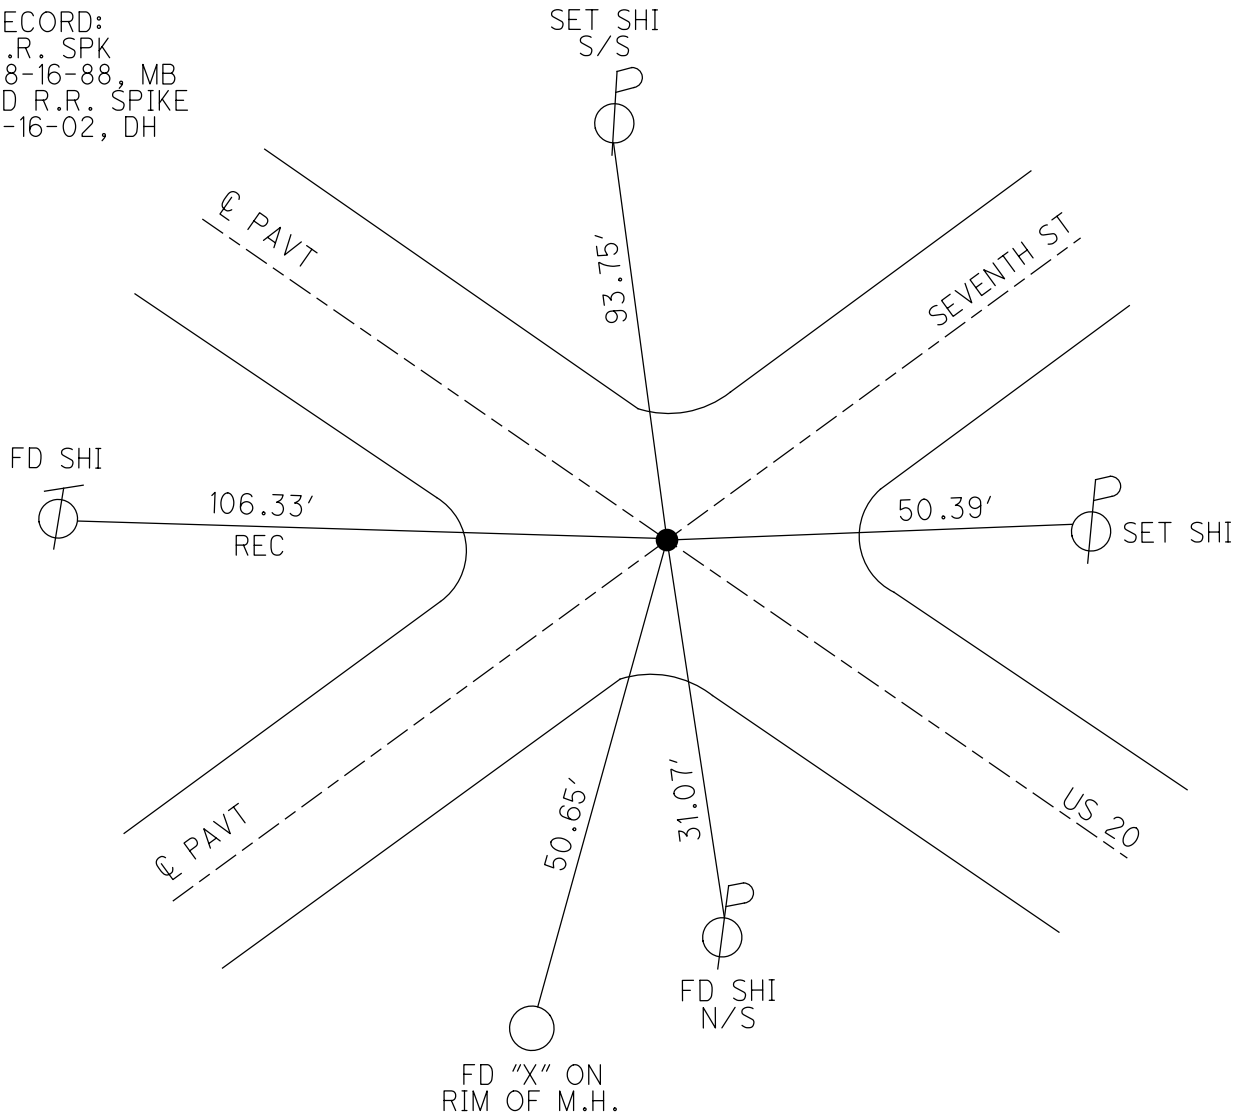

O.D.O.T. DISTRICT 2 SURVEY OFFICE (USE ONLY)


PERSONNEL	REFERENCE NO. <u>4</u>	SHEET <u>1</u> OF <u>13</u>
NOTES <u>BARNHISEL</u>	DATE <u>05-04-88</u>	ROUTE <u>US 20</u>
H.C. <u>REED</u>	WEATHER <u>SUNNY</u>	COUNTY <u>WOOD</u>
R.C. <u>LOEHRKE</u>	TEMP. <u>55°</u>	TOWNSHIP <u>PERRYSBURG</u>
<u>HOFFMAN</u>		SECTION <u>5</u>
		T. <u>4</u> N R. <u>11</u> E

TYPE MONUMENT _____ LG. R.R. SPIKE _____
 ON SURFACE - BELOW _____ 2" _____
 LEFT - ϕ PAV'T - RIGHT _____ ON _____
 _____ TO _____ EDGE PAVEMENT _____
 S.L.M. _____ 102+32 _____
 Grid: Northing: _____ Easting: _____

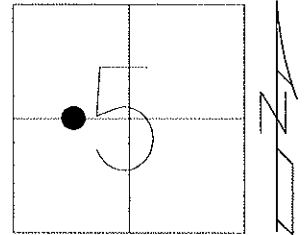

SET SM. R.R. SPK
 08-16-88
 MB

SET SHI
 S/S

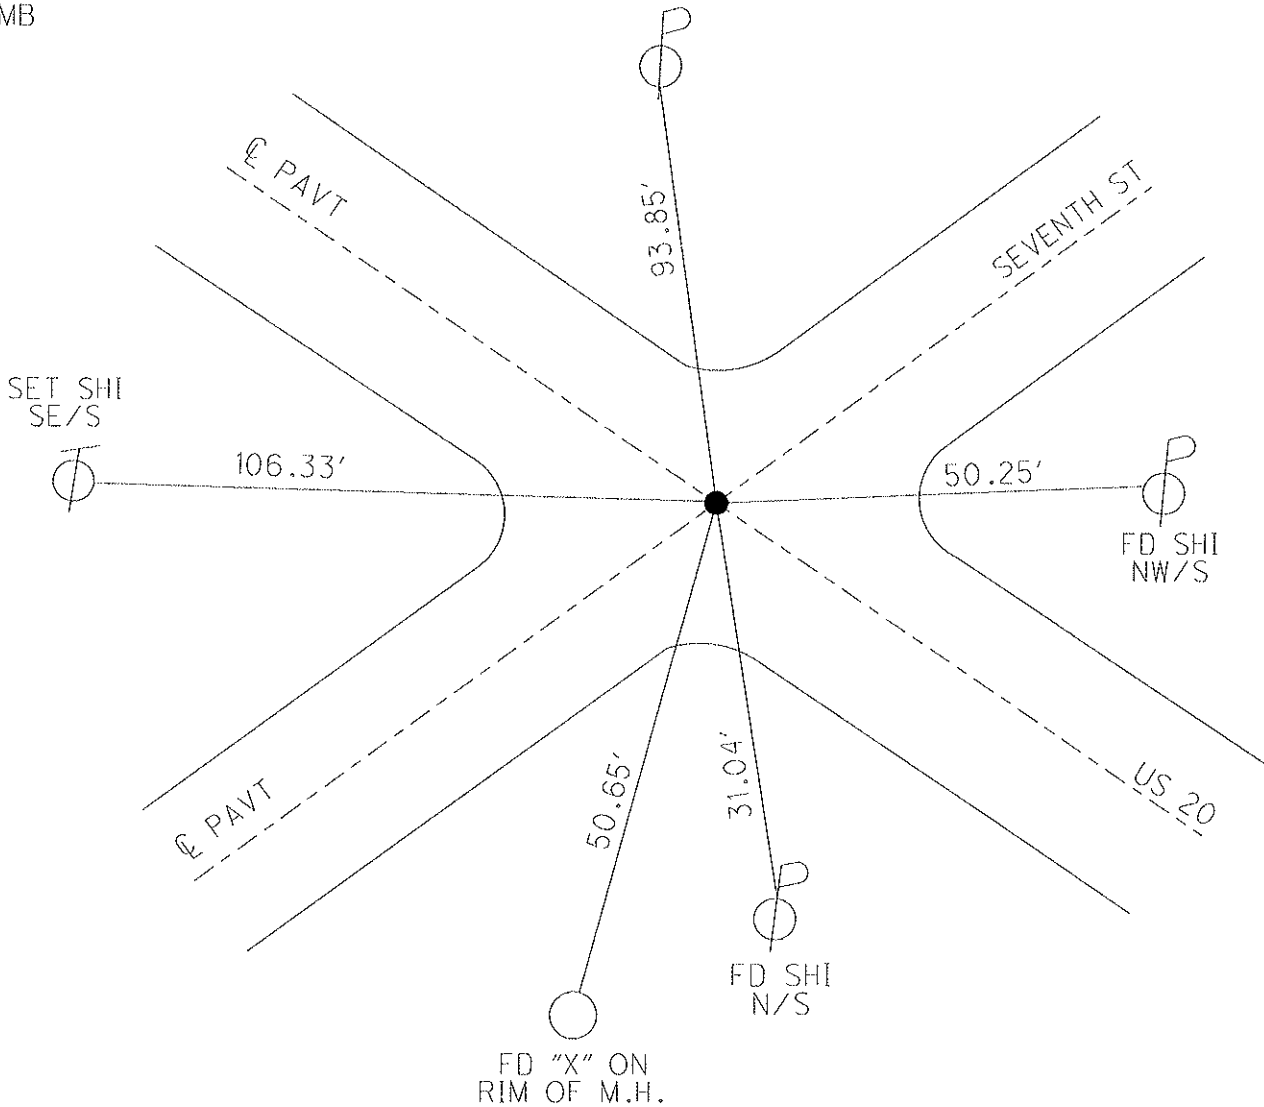

O.D.O.T. DISTRICT 2 SURVEY OFFICE

PERSONNEL

REFERENCE NO. 54

SHEET _____ OF _____

NOTES BARNHISEL

H.C. Reed

DATE 5-4-88

ROUTE U.S. 20

R.C. Loehrke

WEATHER Sunny

COUNTY WOOD

Hoffman

TEMP. +55°

TOWNSHIP Peeysburg

SECTION _____

T _____ R _____



TYPE MONUMENT Lg RR Spk

ON SURFACE - BELOW 2"

LEFT- & PAV'T. - RIGHT yes

- TO - EDGE PAVEMENT

S.L.M. 102 + 32


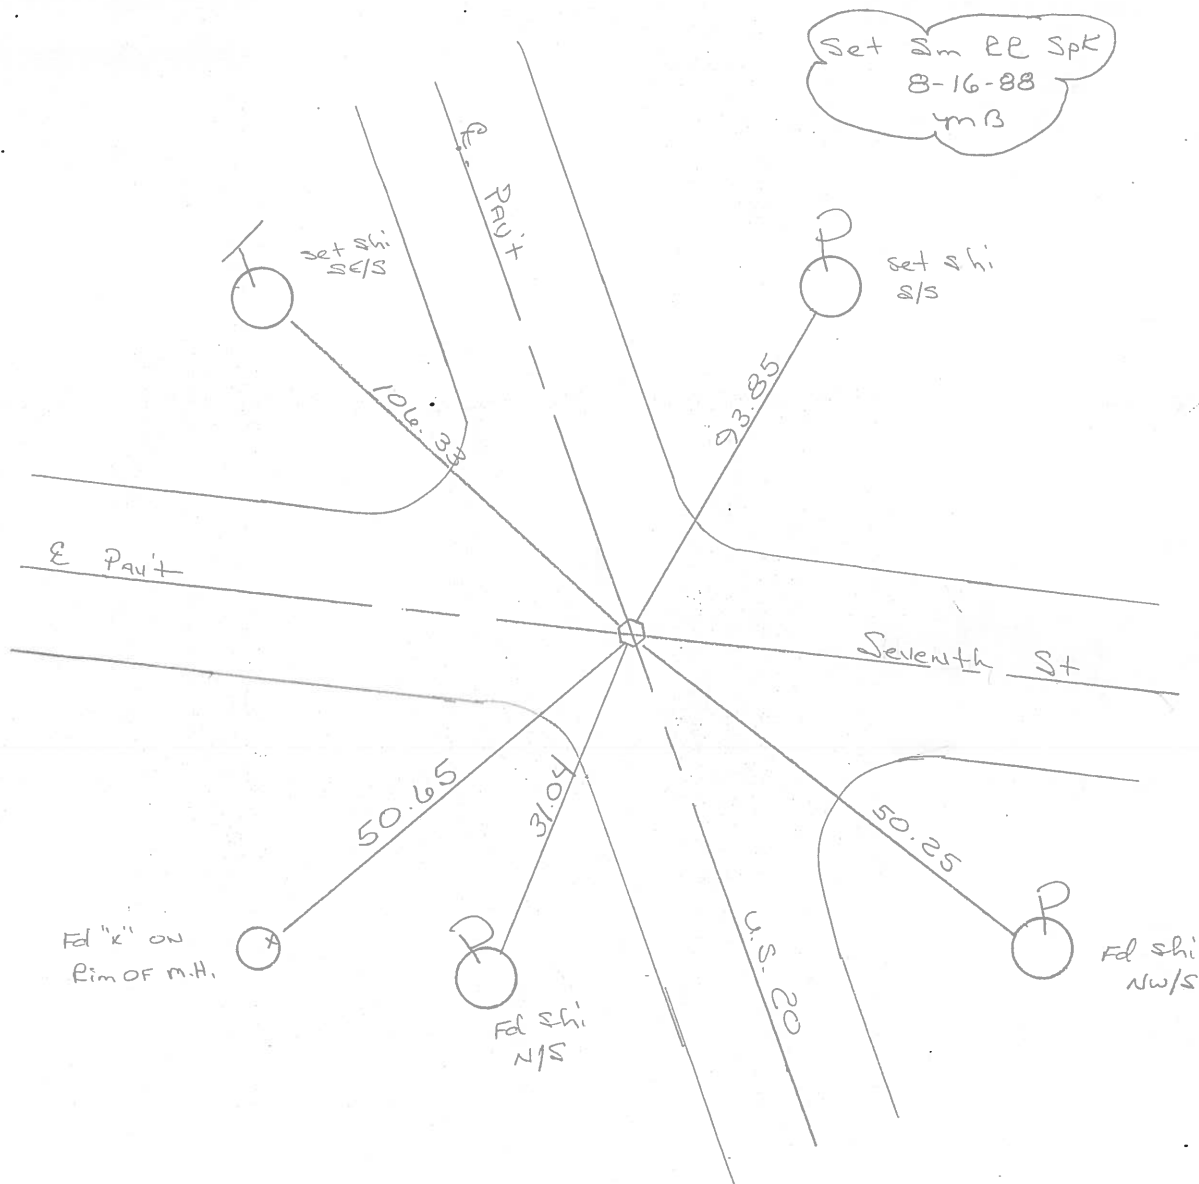
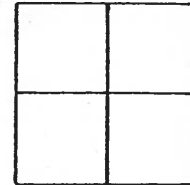


County WOOD ^{U.S.} ~~S.R.~~ 20
Township PERRYSBURG CORP.
Section SANDUSKY ST.
T N, R E

Date 9-7-83
Weather CLEAR
Temp. +70°

Personnel S. HOFFMAN
C. LOEHRKE
J. HOUSEHOLDER
M. BARNHISEL

4

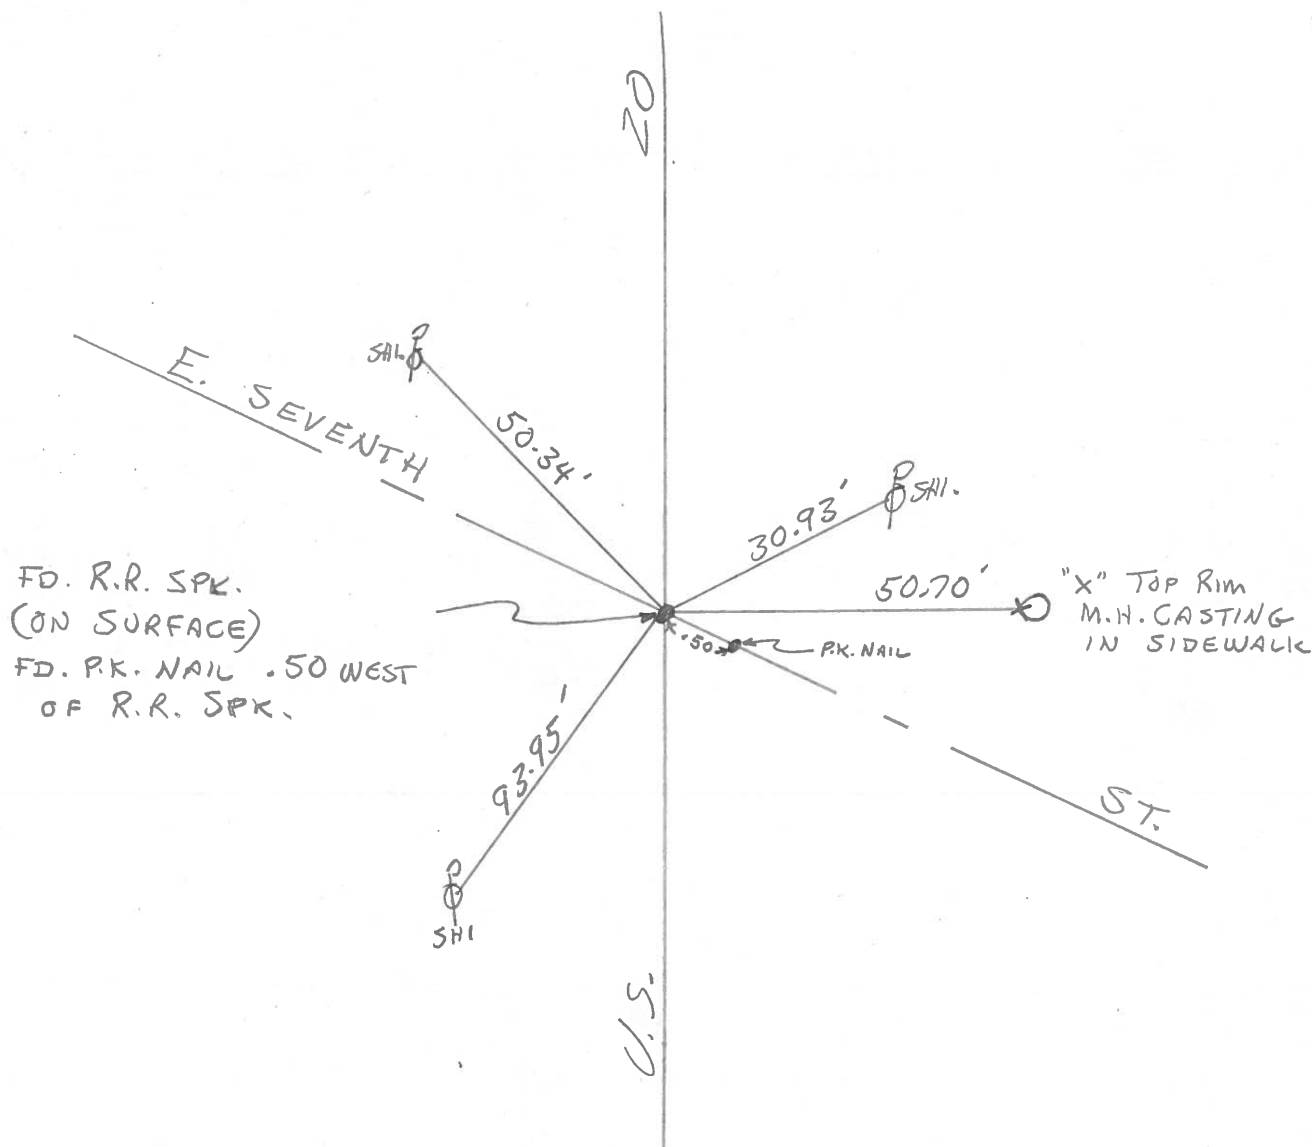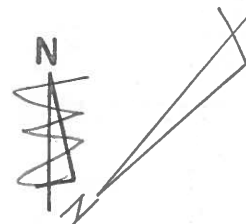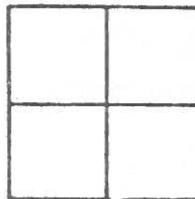

PERSONNEL	TITLE	PERSONNEL	TITLE	COUNTY	DATE
BURNSIDE				Wood	2-27-70
SMITH				S.R. U.S. #20	WEATHER Cloudy
HOFFMAN				SEC. PERRYSBURG CORP.	TEMP. +30°

DESCRIPTION CONTROL TIES (SANDOUSKY ST.) JOB NO.

