



O.D.O.T. DISTRICT 2 SURVEY OFFICE (USE ONLY)

PERSONNEL	REFERENCE NO.	<u>5</u>	SHEET	<u>2</u>	OF	<u>13</u>
NOTES	<u>ROUSOS</u>	DATE	<u>4/16/02</u>	ROUTE	<u>US 20</u>	
H.C.	<u>HOMAN</u>	WEATHER	<u>SUNNY</u>	COUNTY	<u>WOOD</u>	
R.C.	<u>ROUSOS</u>	TEMP.	<u>84°</u>	TOWNSHIP	<u>PERRYSBURG</u>	
				SECTION	<u>5</u>	
				T	<u>4</u>	R
					<u>N</u>	<u>11</u>
					<u>E</u>	

TYPE MONUMENT _____ PK NAIL _____
 ON SURFACE - BELOW _____ ON _____
 LEFT - C PAV'T - RIGHT 3' _____
 - TO - EDGE PAVEMENT _____
 S.L.M. _____ 110+12 _____
 GRID: NORTHING: _____ EASTING: _____

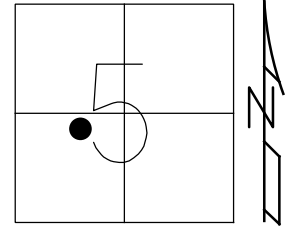


RECORD:
 SET PK & WASHER
 08-16-88, MB
 FD P.K. NAIL
 4-16-02, DH

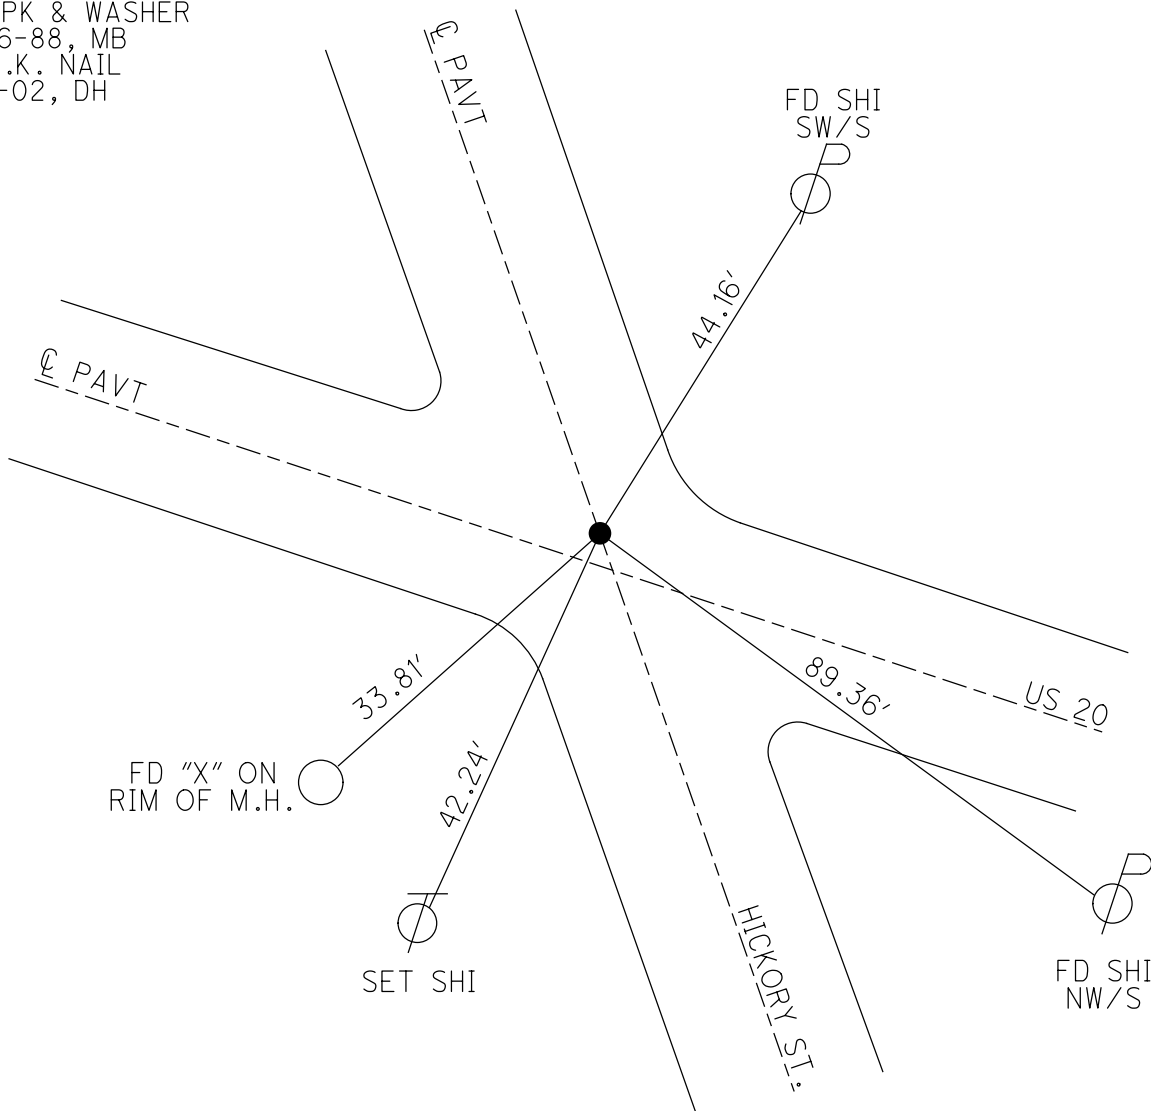


O.D.O.T. DISTRICT 2 SURVEY OFFICE (USE ONLY)

PERSONNEL	REFERENCE NO. <u>5</u>	SHEET <u>2</u> OF <u>13</u>
NOTES <u>BARNHISEL</u>	DATE <u>05-04-88</u>	ROUTE <u>US 20</u>
H.C. <u>REED</u>	WEATHER <u>SUNNY</u>	COUNTY <u>WOOD</u>
R.C. <u>LOEHRKE</u>	TEMP. <u>55°</u>	TOWNSHIP <u>PERRYSBURG</u>
<u>HOFFMAN</u>		SECTION <u>5</u>
		T <u>4</u> N R <u>11</u> E

TYPE MONUMENT SM. PK NAIL
 ON SURFACE - ~~BELOW~~ ON
 LEFT - Q PAV'T - RIGHT 3'
TO EDGE PAVEMENT
 S.L.M. 110+12
 Grid: Northing: _____ Easting: _____

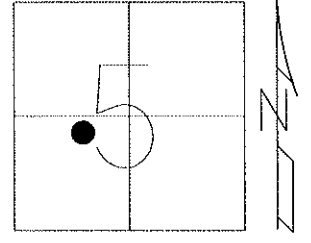

SET PK & WASHER
 08-16-88
 MB

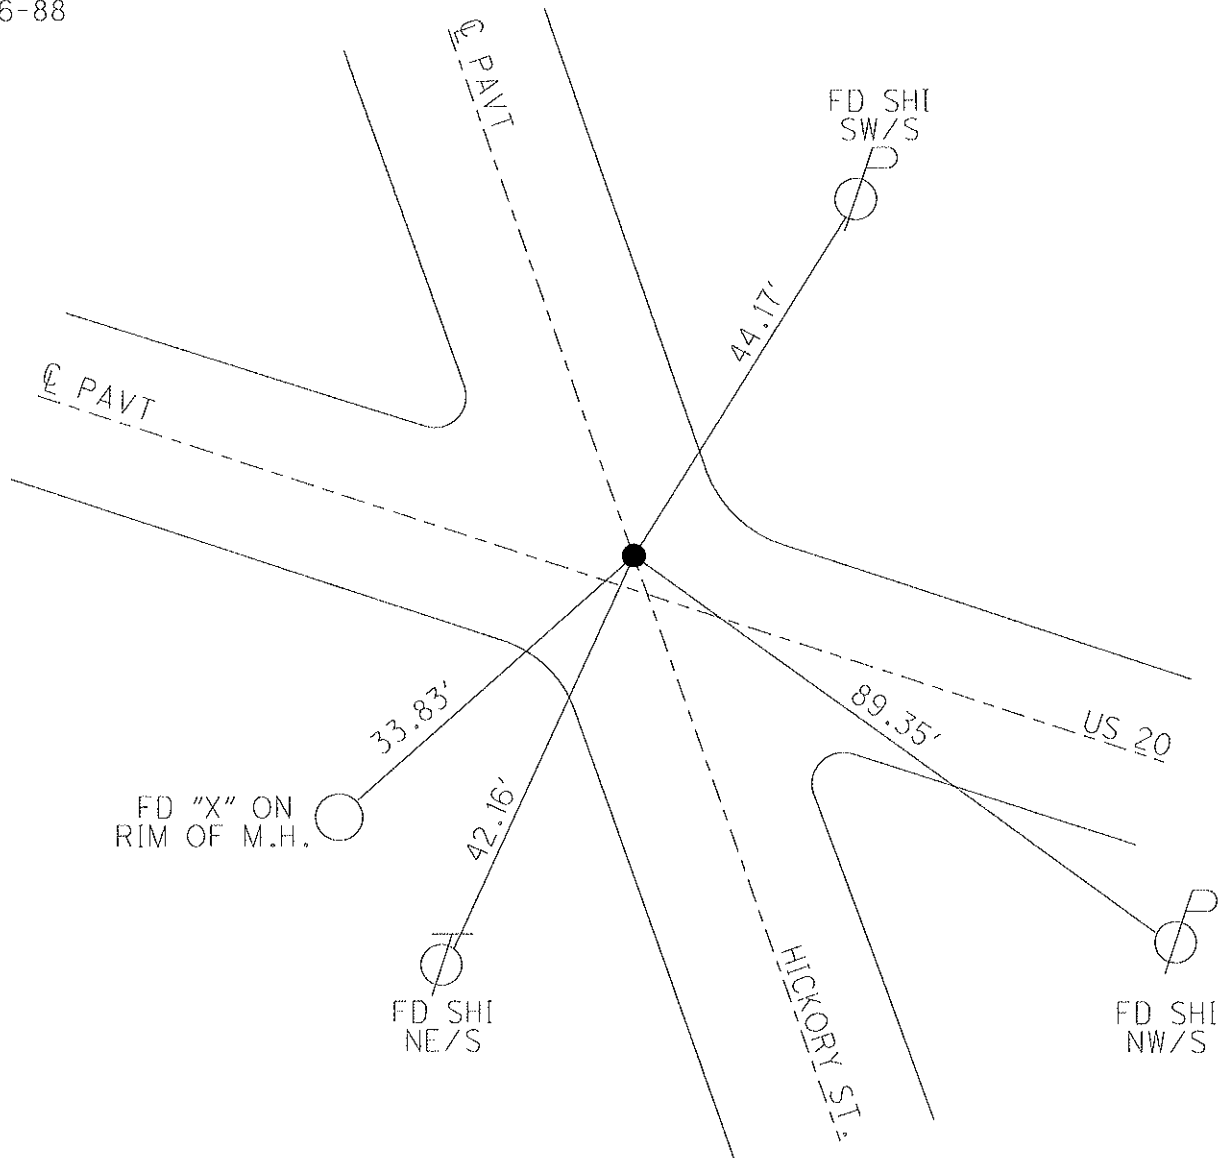

O.D.O.T. DISTRICT 2 SURVEY OFFICE

PERSONNEL _____

REFERENCE NO. _____

SHEET _____ OF _____

NOTES BARNHISEL

H.C. REED

DATE 5-4-88

ROUTE U.S. 20

R.C. Loehrke

WEATHER Sunny

COUNTY Wood

Hoffman

TEMP. +55°

TOWNSHIP Perryburg

SECTION _____

T _____ R _____



TYPE MONUMENT Sm P.K. Nail

ON SURFACE - BELOW yes

LEFT - CL PAV'T. - RIGHT 3' to the East

- TO - EDGE PAVEMENT

S.L.M. 110412

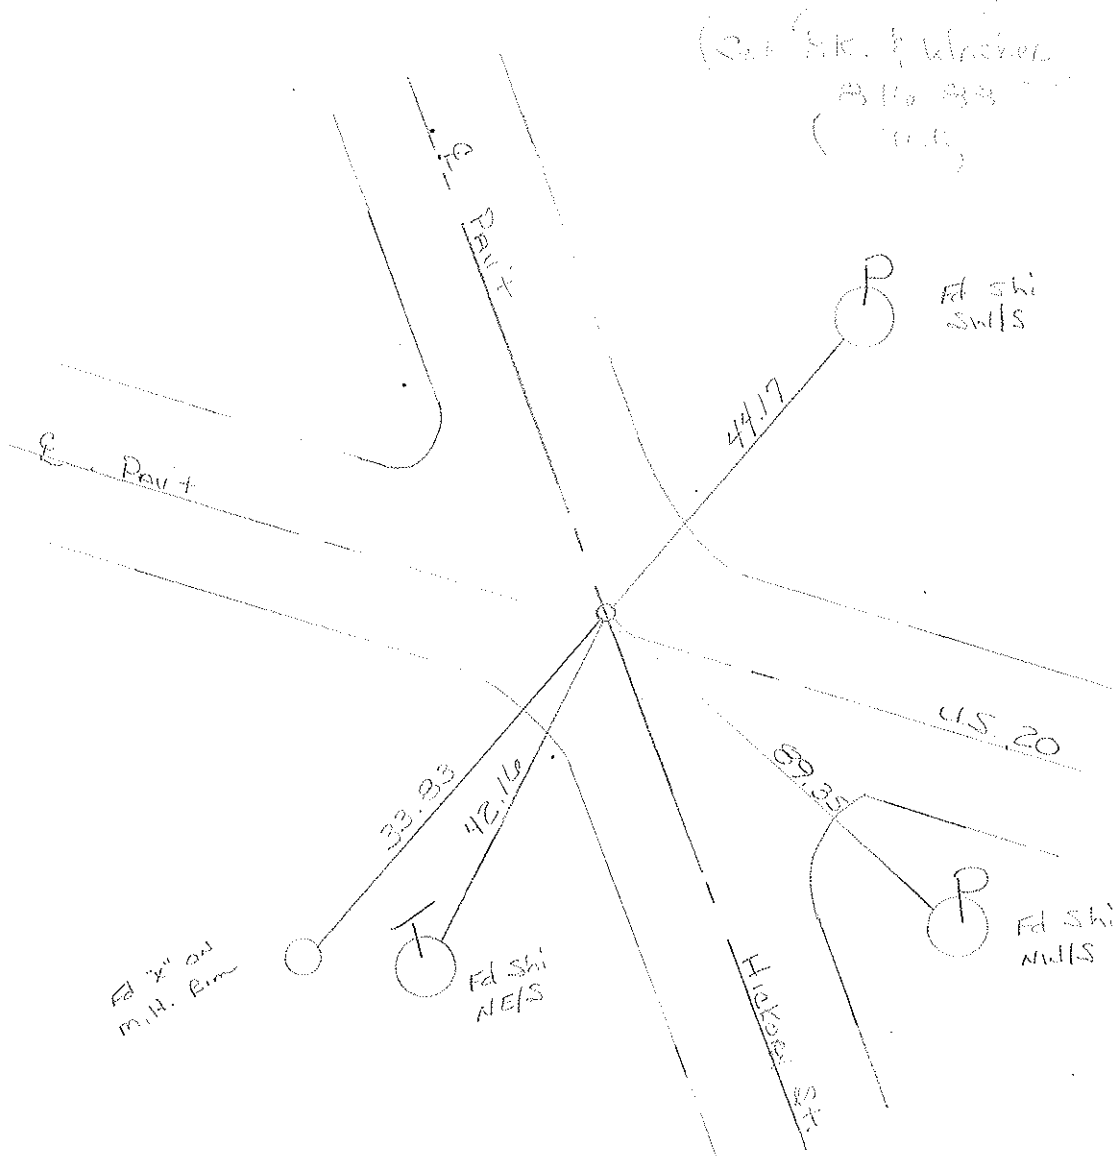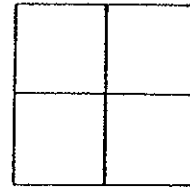

ODOT. DISTRICT 2 SURVEY OFFICE

SHEET 1 OF

County WOOD ^{U.S.} ~~S.R.~~ 20

Date 9-7-83

Township PERRYS BURG CORP.

Weather CLEAR

Section SANDUSKY ST.

Temp. +70°



T N, R E

Personnel S. HOFFMAN

C. LOEHKE


J. HOUSEHOLDER

M. BARNISEL

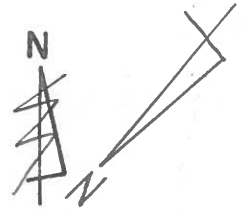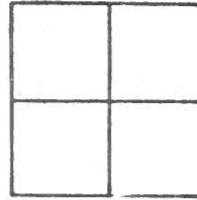

(5)

FD. HOLE WHERE NAIL WAS
NO IRON IN HOLE
(DID NOT DIG)

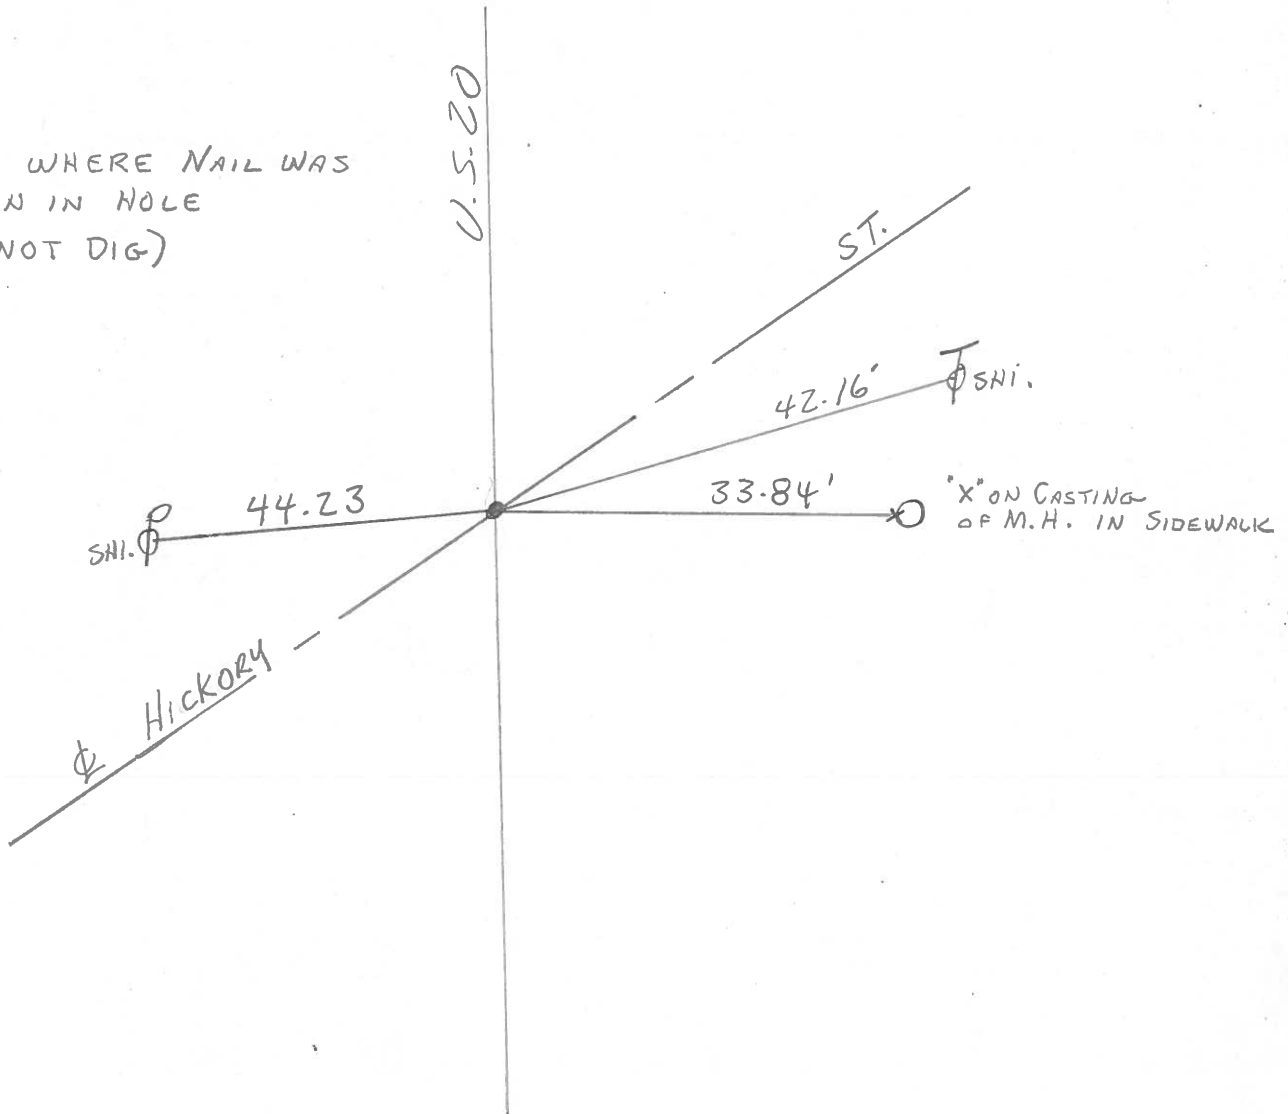

PERSONNEL TITLE PERSONNEL TITLE


BURNSIDE
SMITH
HOFFMANN

COUNTY WOOD DATE 2-27-70

S. R. U.S. #20 WEATHER Cloudy

SEC. PERRYSPURG CORP. TEMP. +30°

DESCRIPTION CONTROL TIES (SANDOUSKY ST.) JOB NO.

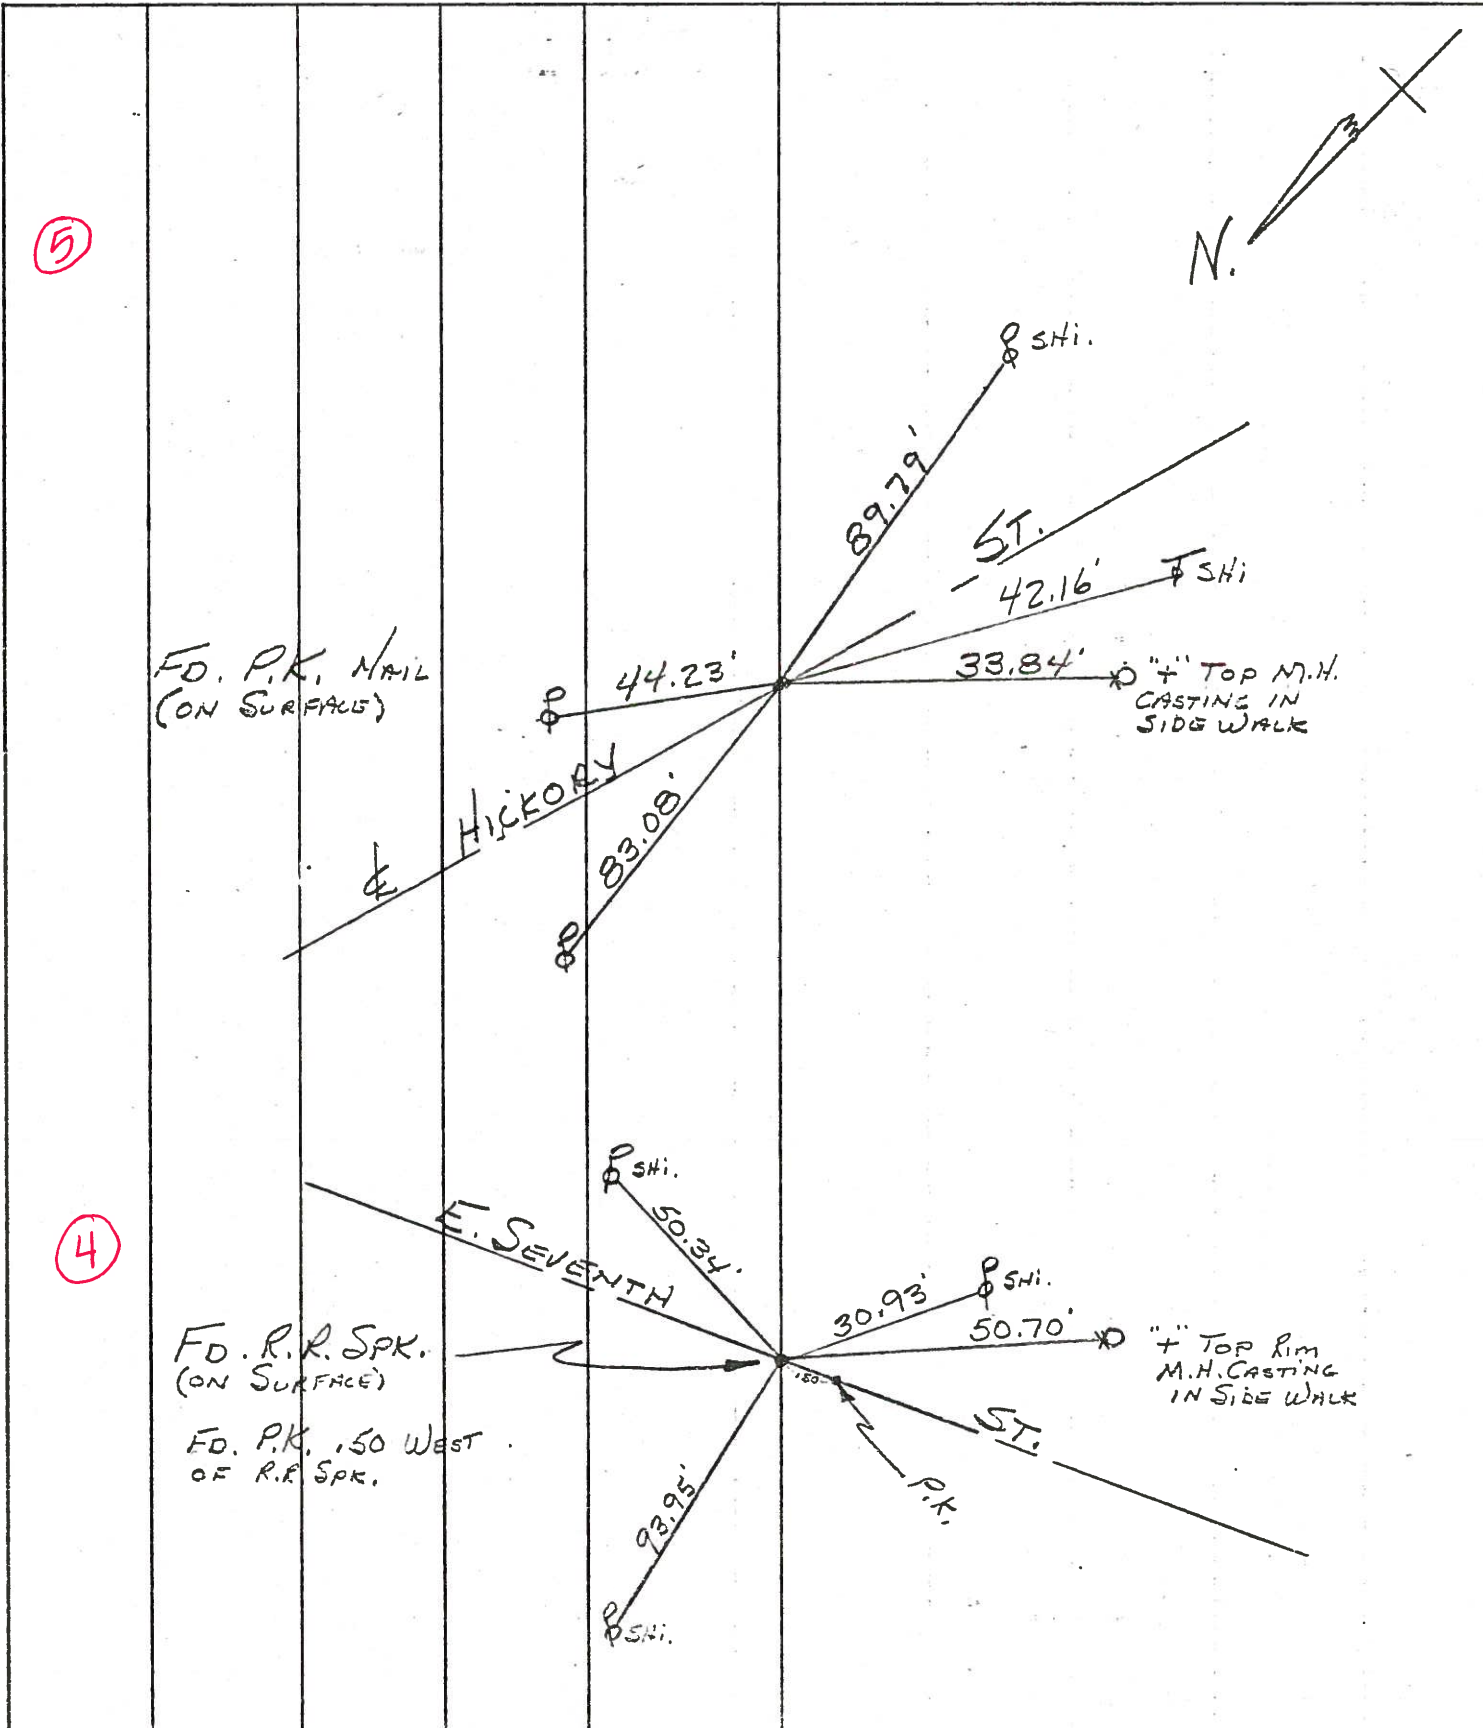

PERSONNEL TITLE PERSONNEL TITLE

BURNSIDE
SMITH
HOFFMAN

COUNTY WOOD DATE 2-27-70

S. R. U.S. #20 WEATHER Cloudy

SEC. PERRYSBURG CORP. TEMP. +30°

DESCRIPTION CONTROL TIES (SANDUSKY ST.) JOB NO.

LEFT CENTER LINE RIGHT

9-7-83
Clear
+70°
soil

