

O.D.O.T. DISTRICT 2 SURVEY OFFICE (USE ONLY)

PERSONNEL

REFERENCE NO. 7

SHEET 4 OF 13

NOTES LEU

DATE 03-13-18

ROUTE US 20

H.C. O'DONNELL

WEATHER CLOUDY

COUNTY WOOD

R.C. AUBLE

TEMP. 31°

TOWNSHIP PERRYSBURG

SEAMAN

SECTION RT 5

DWG BY JAMES PID 102808

T 4 N R 11 E

TYPE MONUMENT MAG/WASHER

ON SURFACE - ~~BELOW~~ ON

OFFSET \odot PAVEMENT 5.0' LT : ~~RT~~

- TO - EDGE PAVEMENT



STATION: 138+77

HORZ.DATUM: NAD83 2011

GEOID: NAVD88 2012A

GRID: NORTHING: 688663.427

EASTING: 1665555.438

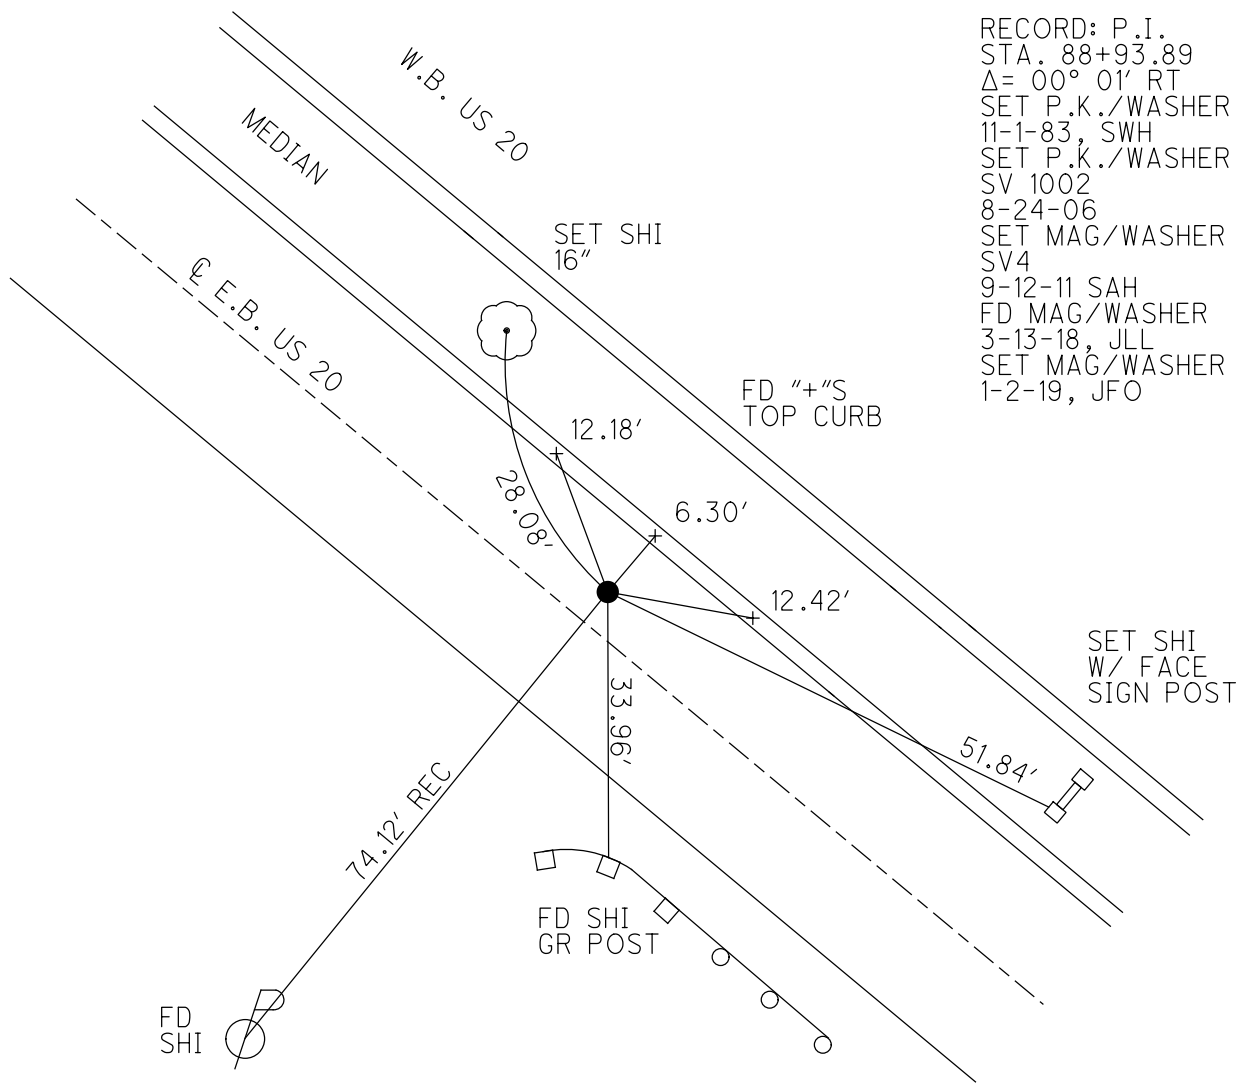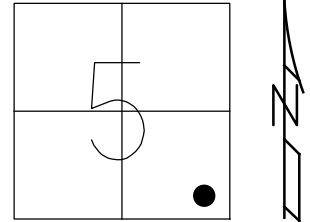

RECORD: P.I.
 STA. 88+93.89
 $\Delta = 00^\circ 01' RT$
 SET P.K./WASHER
 11-1-83, SWH
 SET P.K./WASHER
 SV 1002
 8-24-06
 SET MAG/WASHER
 SV4
 9-12-11 SAH
 FD MAG/WASHER
 3-13-18, JLL
 SET MAG/WASHER
 1-2-19, JFO

O.D.O.T. DISTRICT 2 SURVEY OFFICE (USE ONLY)

PERSONNEL

REFERENCE NO. 7


SHEET 4 OF 13

NOTES HOFFMAN
 H.C. LOEHRKE
 R.C. HOUSEHOLDER
BARNHISEL

DATE 09-07-83
 WEATHER CLEAR
 TEMP. 72°

ROUTE US 20
 COUNTY WOOD
 TOWNSHIP PERRYSBURG
 SECTION 5
T 4 N R 11 E


TYPE MONUMENT PK/WASHER
 ON SURFACE - BELOW ON
 LEFT - ☉ PAV'T - RIGHT 5.0'
TO EDGE PAVEMENT
 S.L.M. 138+77

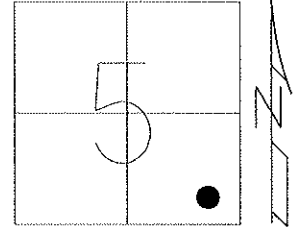

Grid: Northing: _____ Easting: _____

MC - HC
 SAH - RC
 SAH - NOTES

SHOP GPS
 SU-4
 IN WOO-20-4.95
 PID 91544

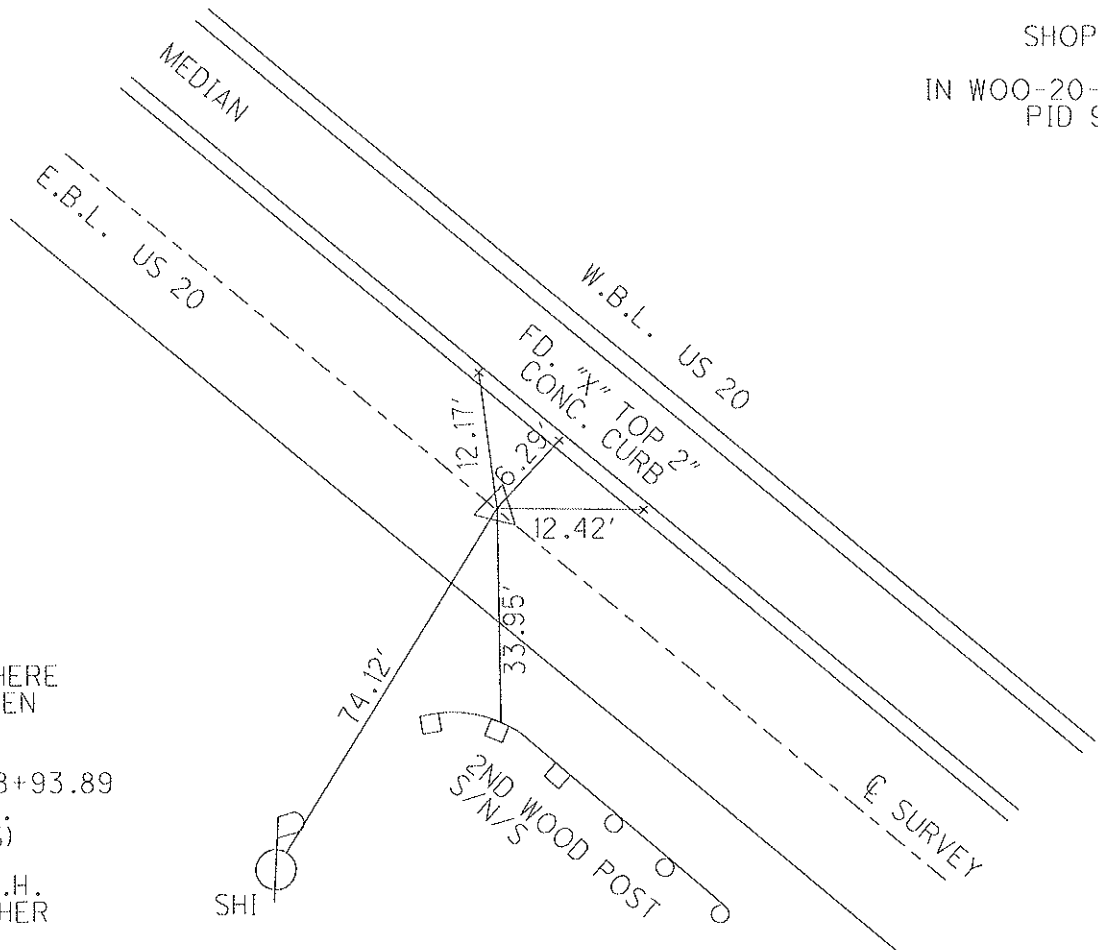

11-01-83
 FD. HOLE WHERE
 NAIL HAS BEEN
 TORN OUT


P.I. STA.=88+93.89
 $\Delta=00^{\circ}01'$ RT.
 (REC & MEAS)

11-01-83 S.W.H.
 SET PK/WASHER

08-24-06
 SET PK/WASHER
 SU 1002

09-12-11 SAH
 SET MAG/WASHER

SHI

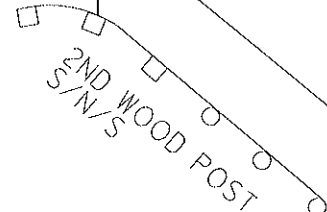

County WOOD U.S. 20
~~S.R.~~

Date 9-7-83

Township PERRYS BURG



Weather CLEAR

Section _____

Temp. +70°

T N, R E

Personnel S. HOFFMAN

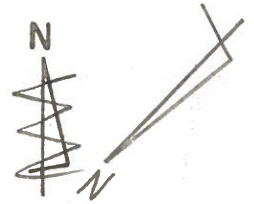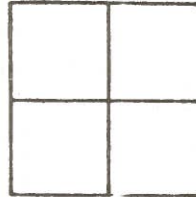

⑦

C. LOENRKE

J. HOUSEHOLDER

M. BARNHISEL

S.L.M. 138+77

FD. HOLE WHERE
 NAIL HAS BEEN
 TORN OUT


P.I. STA. = 88+93.89

A = 0°-01' RT.

(REC & MEAS.)

SET P.K./WASHER

11/1/83
 S.W.H.

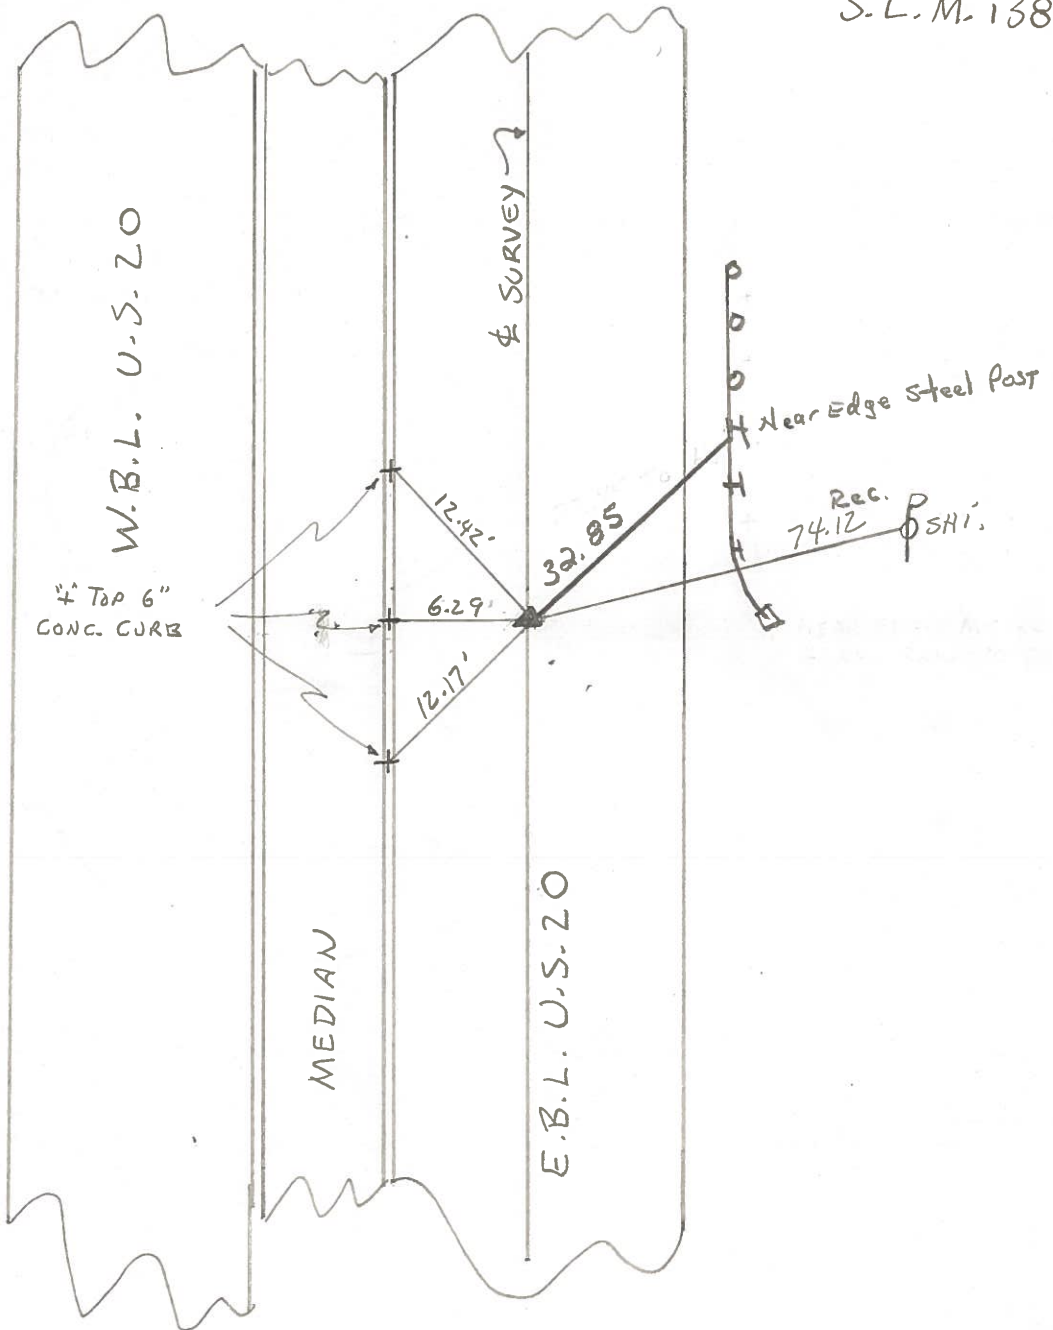

4" TOP 6"
 CONC. CURB

Near Edge Steel Post

Rec. 74.12
 P SHI.

County Wood

Date 12-27-77

Township PERRYSBURG


Weather PT. CLOUDY

Section _____

Temp. +15°

T N, R E

Personnel BURNSIDE

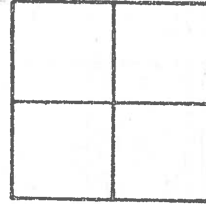

SMITH

KNAPE

MEAD


⑦

9-7-83

SLM = 138 + 77

+700
Clear
sun

Fd HOLE where
nail HAS
BEEN TORN
OUT

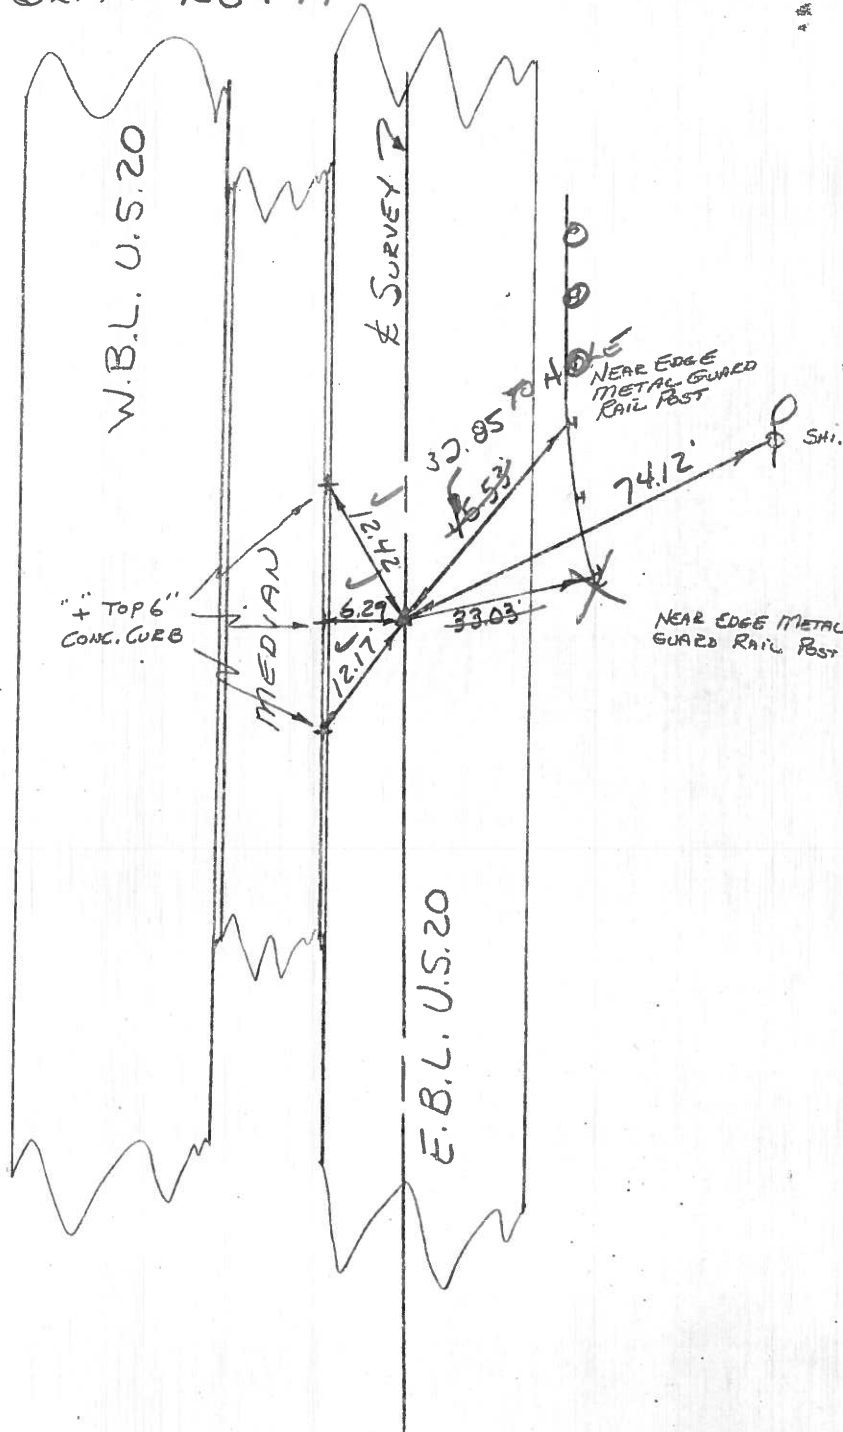

Ed. P.K. NAIL
? I. STA. = 88 + 93.89
∠ = 0° 01' RT. (Rec. & MEA.)

88 + 94
77 + 2.4
11 + 70
127 + 07
138 + 77

County WOOD

Date 12-27-77

Township PERRYSBURG


Weather PT. CLOUDY

Section _____

Temp. +15°

T N, R E

Personnel BURNSIDE

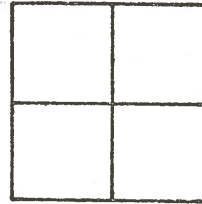


SMITH

KNAPE

MEAD

7

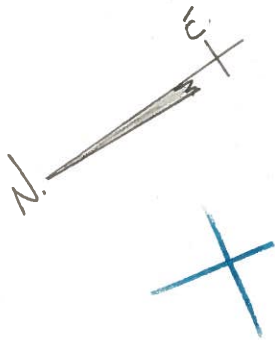

FD. P.K. NAIL
P.I. STA. = 88+93.89
Δ = 0°-01' Rt. (Rec. & MEA.)

