

O.D.O.T. DISTRICT 2 SURVEY OFFICE (USE ONLY)

PERSONNEL

REFERENCE NO. 9

SHEET 6 OF 13

NOTES HOFFMAN

DATE 9/7/83

ROUTE US 20

H.C. LOERHKE

WEATHER CLEAR

COUNTY WOOD

R.C. HOUSEHOLDER

TEMP. 70°

TOWNSHIP PERRYSBURG

BARNHISEL

SECTION 9

DWG BY JAMES

PID 102808

T 4 N R 11 E

TYPE MONUMENT P.K./WASHER

ON SURFACE - ~~BELOW~~ ON

OFFSET ☉ PAVEMENT \_\_\_\_\_ LT : RT

- TO - EDGE PAVEMENT


STATION: 160+51

HORZ.DATUM: \_\_\_\_\_


GEOID: \_\_\_\_\_

GRID: NORTHING: \_\_\_\_\_

EASTING: \_\_\_\_\_

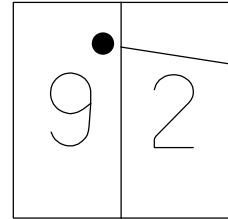

RECORD:  
FD P.K./WASHER  
9-7-83, CL  
SET P.K./WASHER  
11-1-83  
DNF  
9-12-11, SAH  
3-13-18, JFO

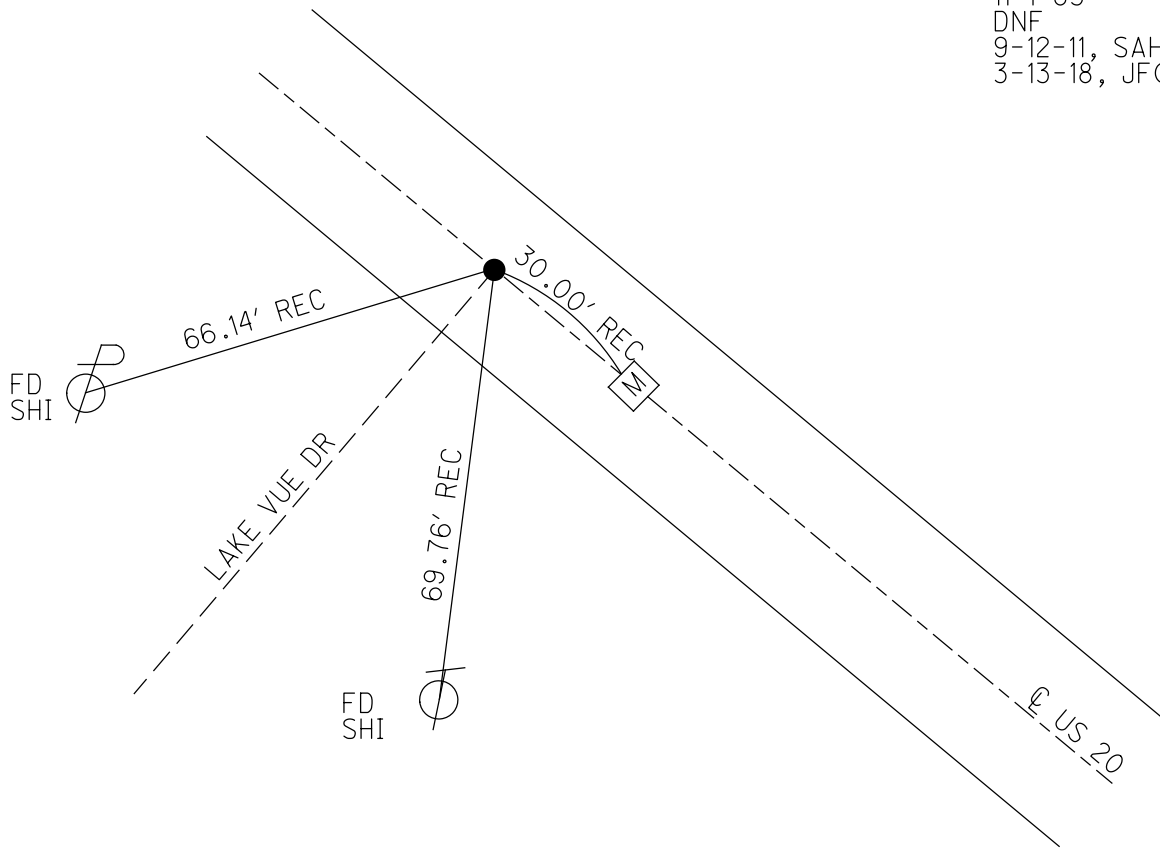

O.D.O.T. DISTRICT 2 SURVEY OFFICE (USE ONLY)

PERSONNEL

REFERENCE NO. 9

SHEET 6 OF 13

NOTES HOFFMAN

DATE 09-07-83

ROUTE US 20

H.C. LOEHRKE

WEATHER CLEAR

COUNTY WOOD

R.C. HOUSEHOLDER

TEMP. 70°

TOWNSHIP PERRYSBURG

BARNHISEL

SECTION 9

T 4 N R 11 E

TYPE MONUMENT PK/WASHER

ON SURFACE - BELOW ON


LEFT - ℄ PAV'T - RIGHT           

           TO            EDGE PAVEMENT

S.L.M. 160+51

Grid: Northing: 687596.27 Easting: 1667462.53

●		4
9	2	
		3

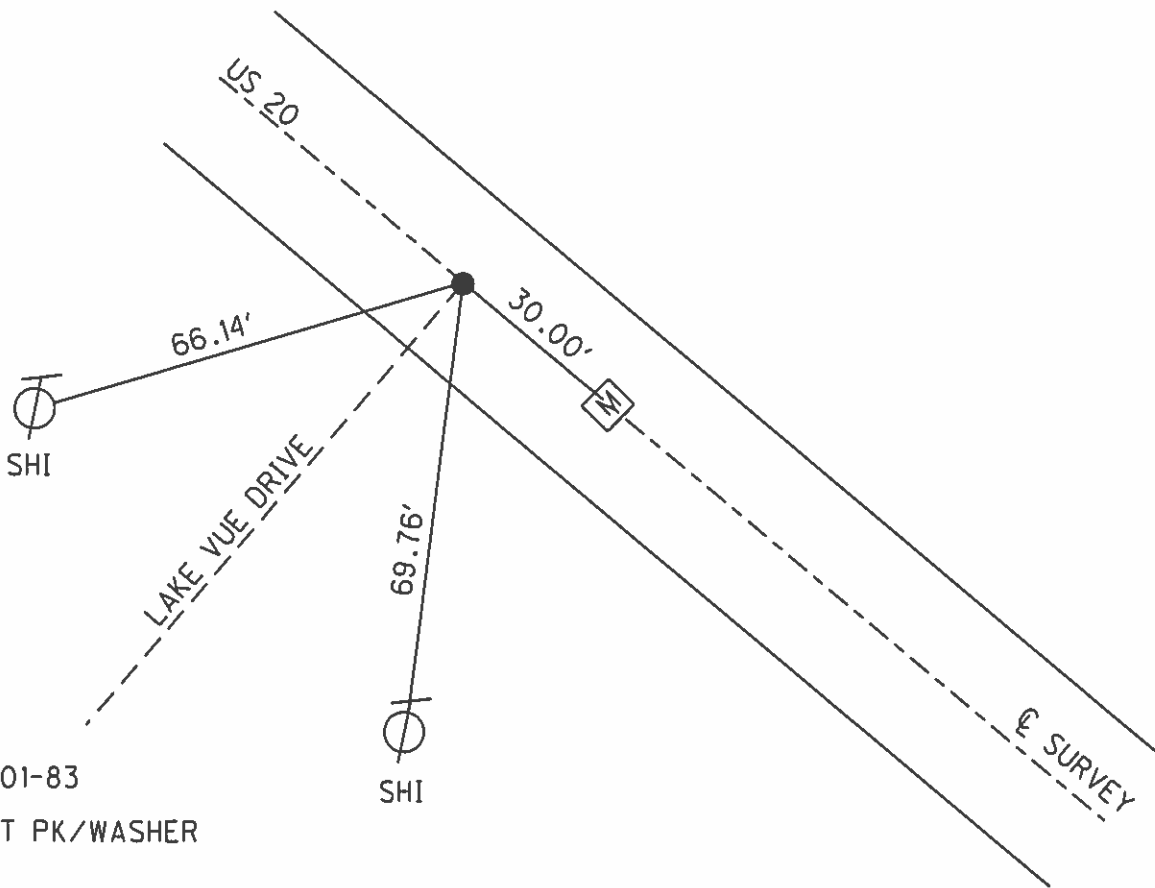

11-01-83

SET PK/WASHER

09-12-11

DNF 9 SAH

TIES DO NOT CROSS

County WOOD <sup>U.S.</sup> ~~S.R.~~ 20

Date 9-7-83

Township PERRYSBURG



Weather CLEAR

Section \_\_\_\_\_

Temp. +70°

T N, R E

Personnel HOFFMAN

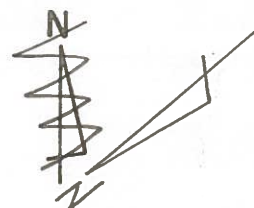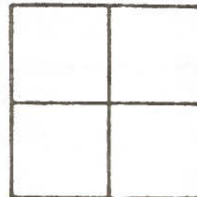


LOEHRKE

HOUSE HOLDER

BARNHISEL

(9)

(10)

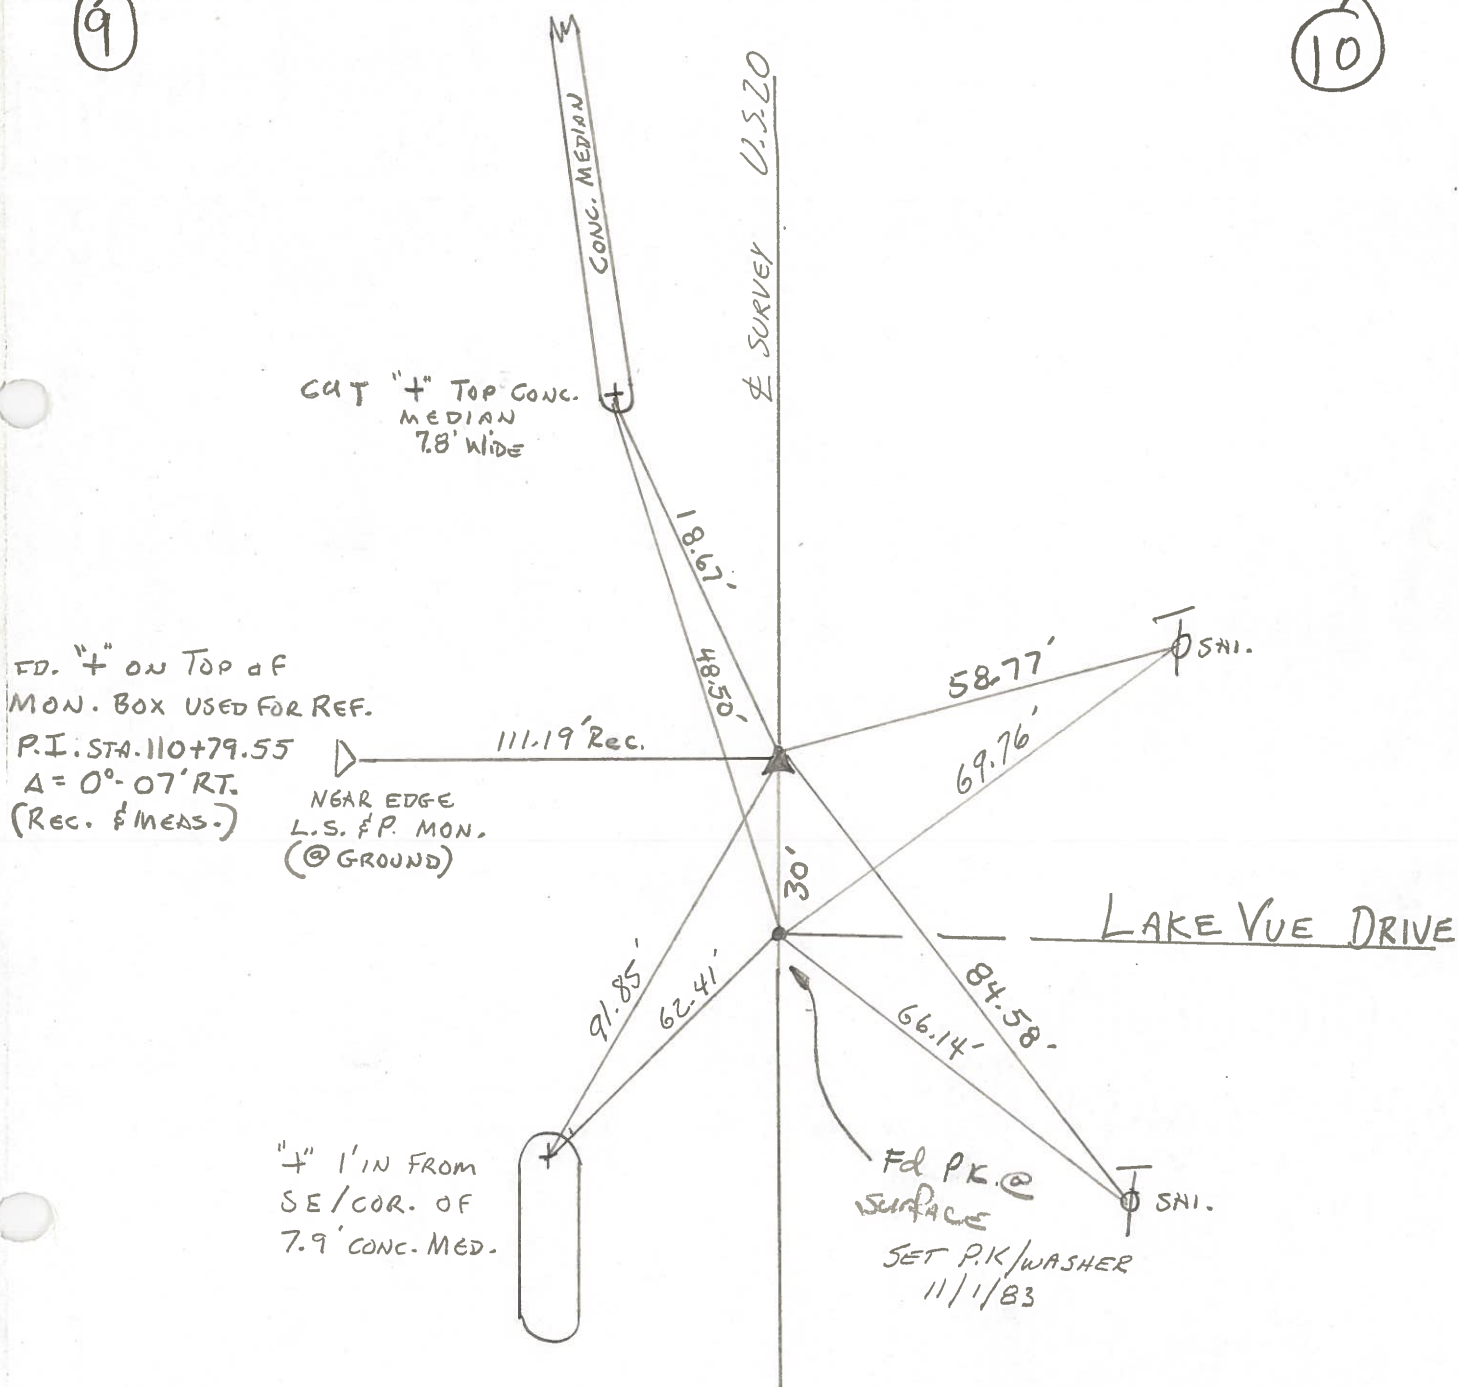

OD.O.T. DISTRICT 2 SURVEY OFFICE

Sht. 4 of 5

County WOOD

Date 12-27-77

Township PERRYSBURG

Weather CLEAR

Section \_\_\_\_\_

Temp. +14°

T N, R E



Personnel BURNSIDE

SMITH

KNAPE

MEAD

(9) (10)

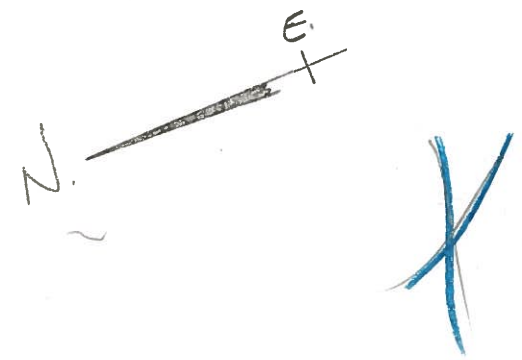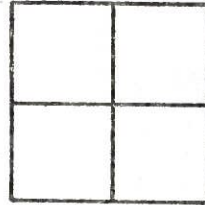


9-7-83

clear  
+70°  
SWL

Fd BOX @ surface

SLM = 160 +63

Fd "t" ON TOP - USED FOR LG.  
10N. Box  
I. STA. 110 + 79.55  
A = 0° 07' RT.  
REC. & MEA.)

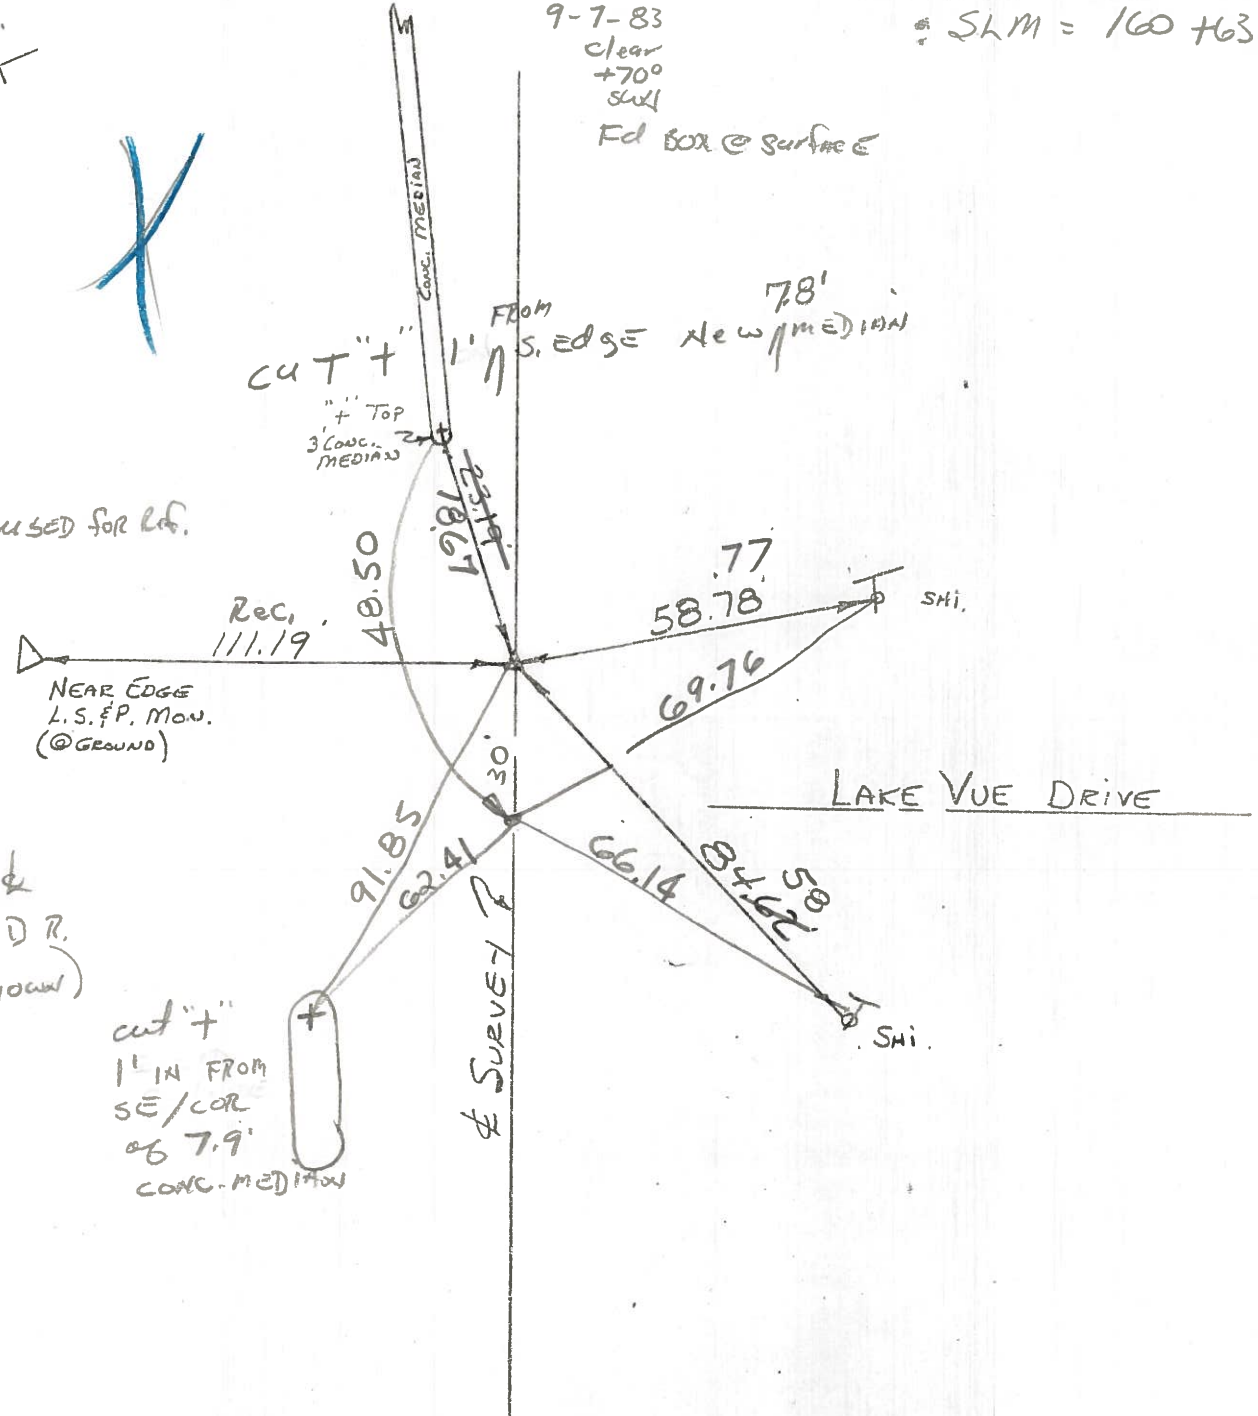

Fd P.K. @ &  
LAKE VUE DR.  
(ORIGIN UNKNOWN)

cut "t"  
1" IN FROM  
SE/COR  
of 7.9'  
CONC. MEDIAN