

O.D.O.T. DISTRICT 2 SURVEY OFFICE (USE ONLY)

PERSONNEL

REFERENCE NO. 10

SHEET 7 OF 13

NOTES HOFFMAN

DATE 9/7/83

ROUTE US 20

H.C. LOEHRKE

WEATHER CLEAR

COUNTY WOOD

R.C. HOUSEHOLDER

TEMP. 70°

TOWNSHIP PERRYSBURG

BARNHISEL

SECTION 9

DWG BY JAMES PID 83592, 102808

T 4 N R 11 E

TYPE MONUMENT MONBOX

ON SURFACE - ~~BELOW~~ ON

OFFSET \odot PAVEMENT _____ LT : RT

- TO - EDGE PAVEMENT


STATION: 160+91.49

HORZ.DATUM: NAD83 2011


GEOID: NAVD88 2012A

GRID: NORTHING: 687596.207

EASTING: 1667462.539

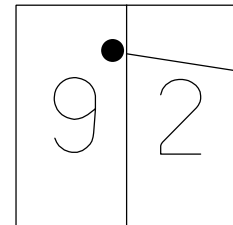

RECORD:
 FD MONBOX
 9/7/83, CL
 FD MONBOX
 SV1006
 9-12-11, SAH
 MONBOX BURIED
 3-13-18, JFO
 FD MONBOX
 W/ 1" IPIN
 REF10
 4-18-18, JFO

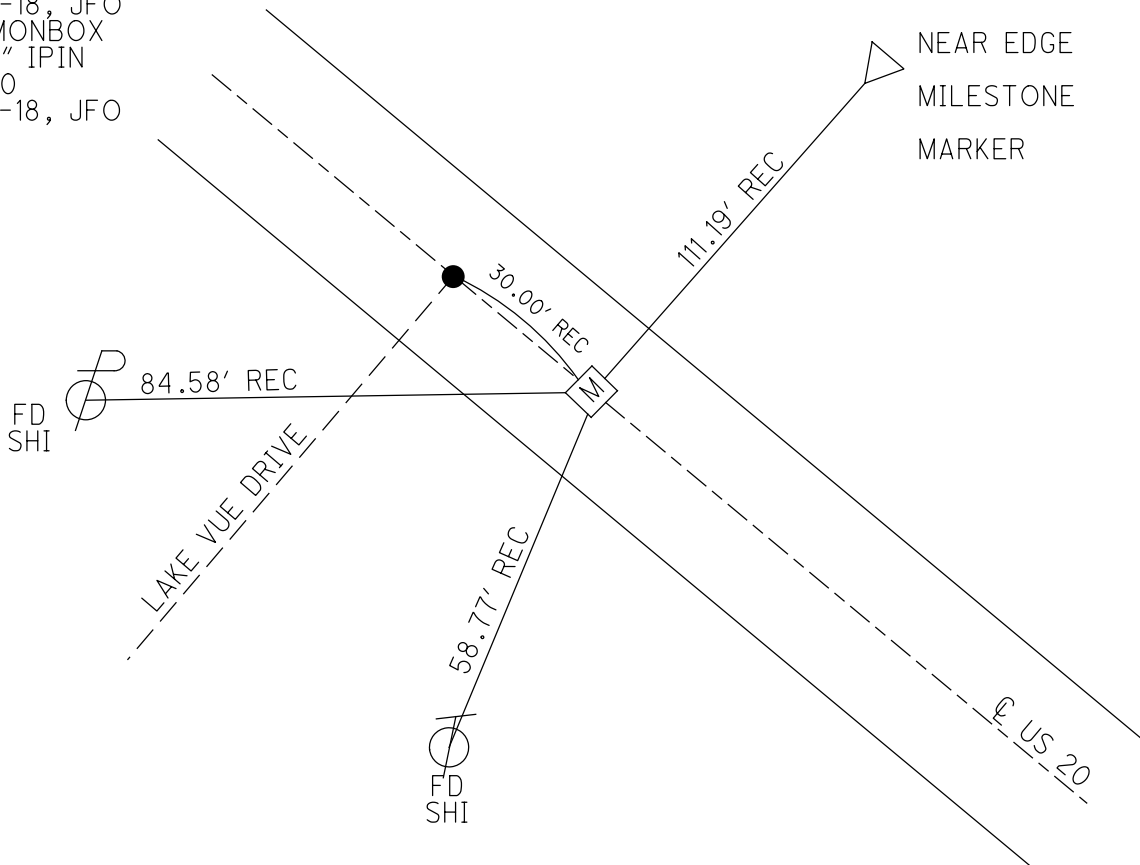

O.D.O.T. DISTRICT 2 SURVEY OFFICE (USE ONLY)

PERSONNEL

REFERENCE NO. 10

SHEET 7 OF 13

NOTES HOFFMAN

DATE 09-07-83

ROUTE US 20

H.C. LOEHRKE

WEATHER CLEAR

COUNTY WOOD

R.C. HOUSEHOLDER

TEMP. 70°

TOWNSHIP PERRYSBURG

BARNISEL

SECTION 9

T 4 N R 11 E

TYPE MONUMENT MONUMENT BOX



ON SURFACE - BELOW ON

LEFT - Q PAV'T - RIGHT

 TO EDGE PAVEMENT

S.L.M. 160+81

Grid: Northing: Easting:

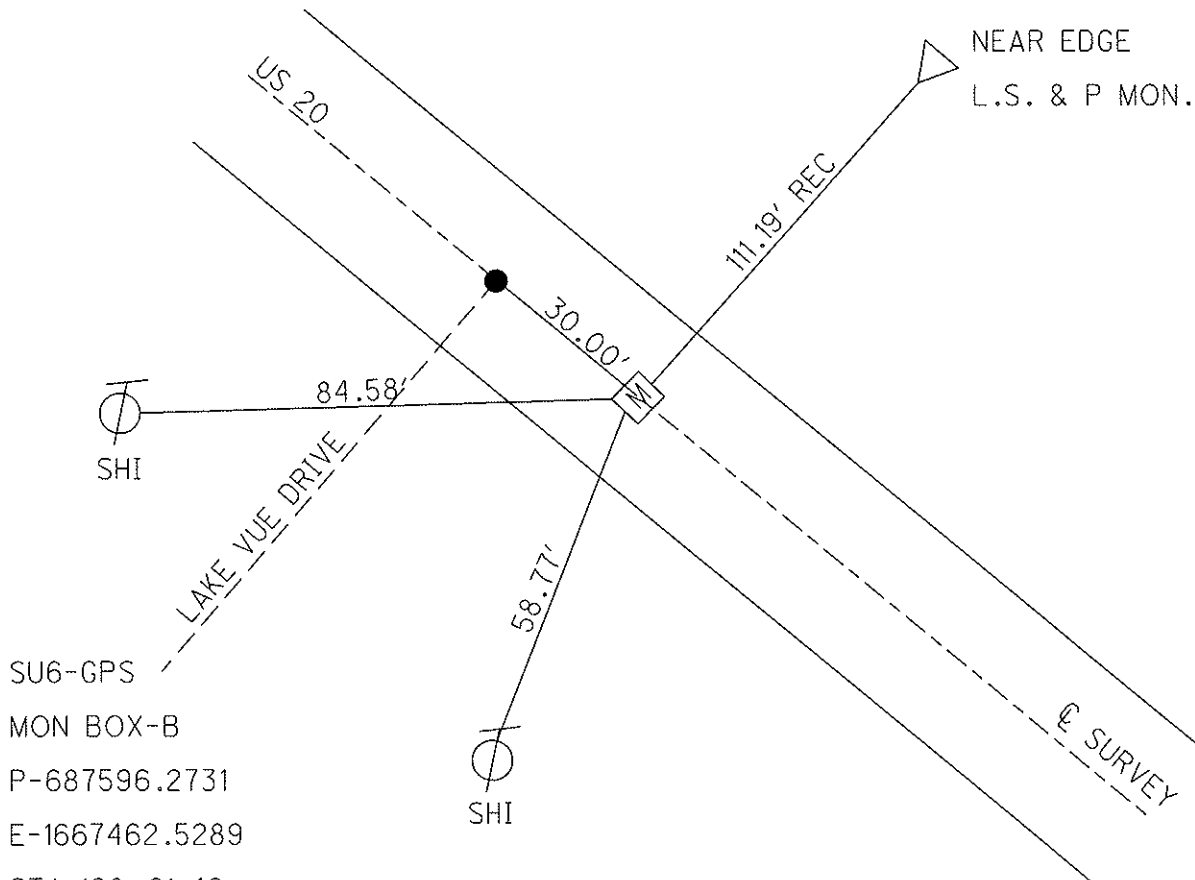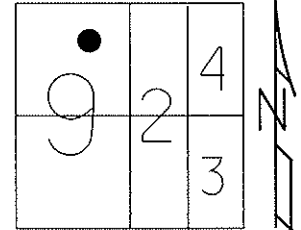

SU6-GPS
 MON BOX-B
 P-687596.2731
 E-1667462.5289
 STA 160+91.49
 SHOT WITH WOO-20-3.52
 PID 83592
 SAH 9-12-11

County Wood ^{U.S.} ~~SR.~~ 20

Date 9-7-83

Township PERRYSBURG


Weather CLEAR

Section _____

Temp. +70°

T N, R E

Personnel HOFFMAN

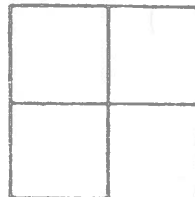


LOEHRKE

HOUSE HOLDER

BARNHISEL

9

10

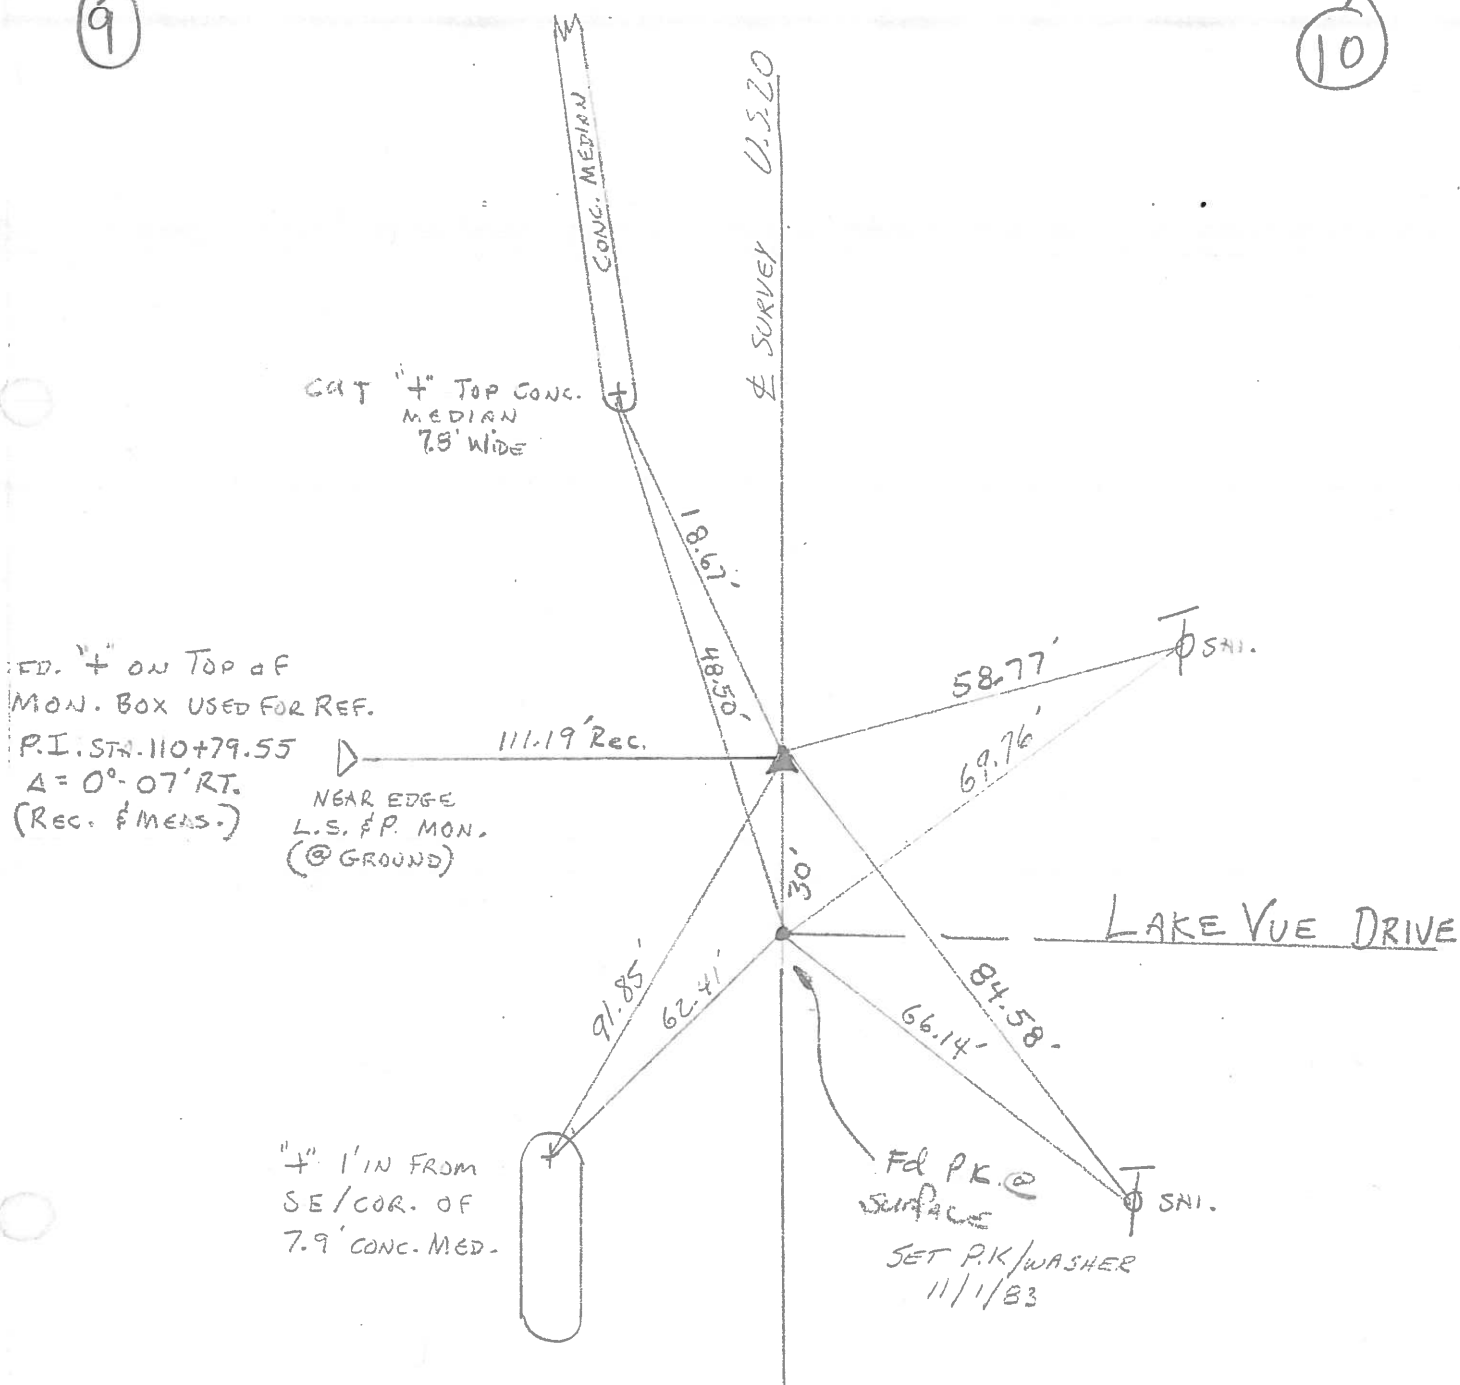

FD. "+" ON TOP OF
MON. BOX USED FOR REF.
P.I. STA. 110+79.55
A = 0°-07' RT.
(REC. & MENS.)
NEAR EDGE
L.S. & P. MON.
(@ GROUND)

"+" 1' IN FROM
SE/COR. OF
7.9' CONC. MED.

Fd PK @
SURFACE
SET P.K./WASHER
11/1/83

County WOOD

Date 12-27-77

Township PERRYSBURG

Weather CLEAR

Section _____

Temp. +14°

T N, R E



Personnel BURNSIDE

SMITH

KNAPE

MEAD

(9) (10)

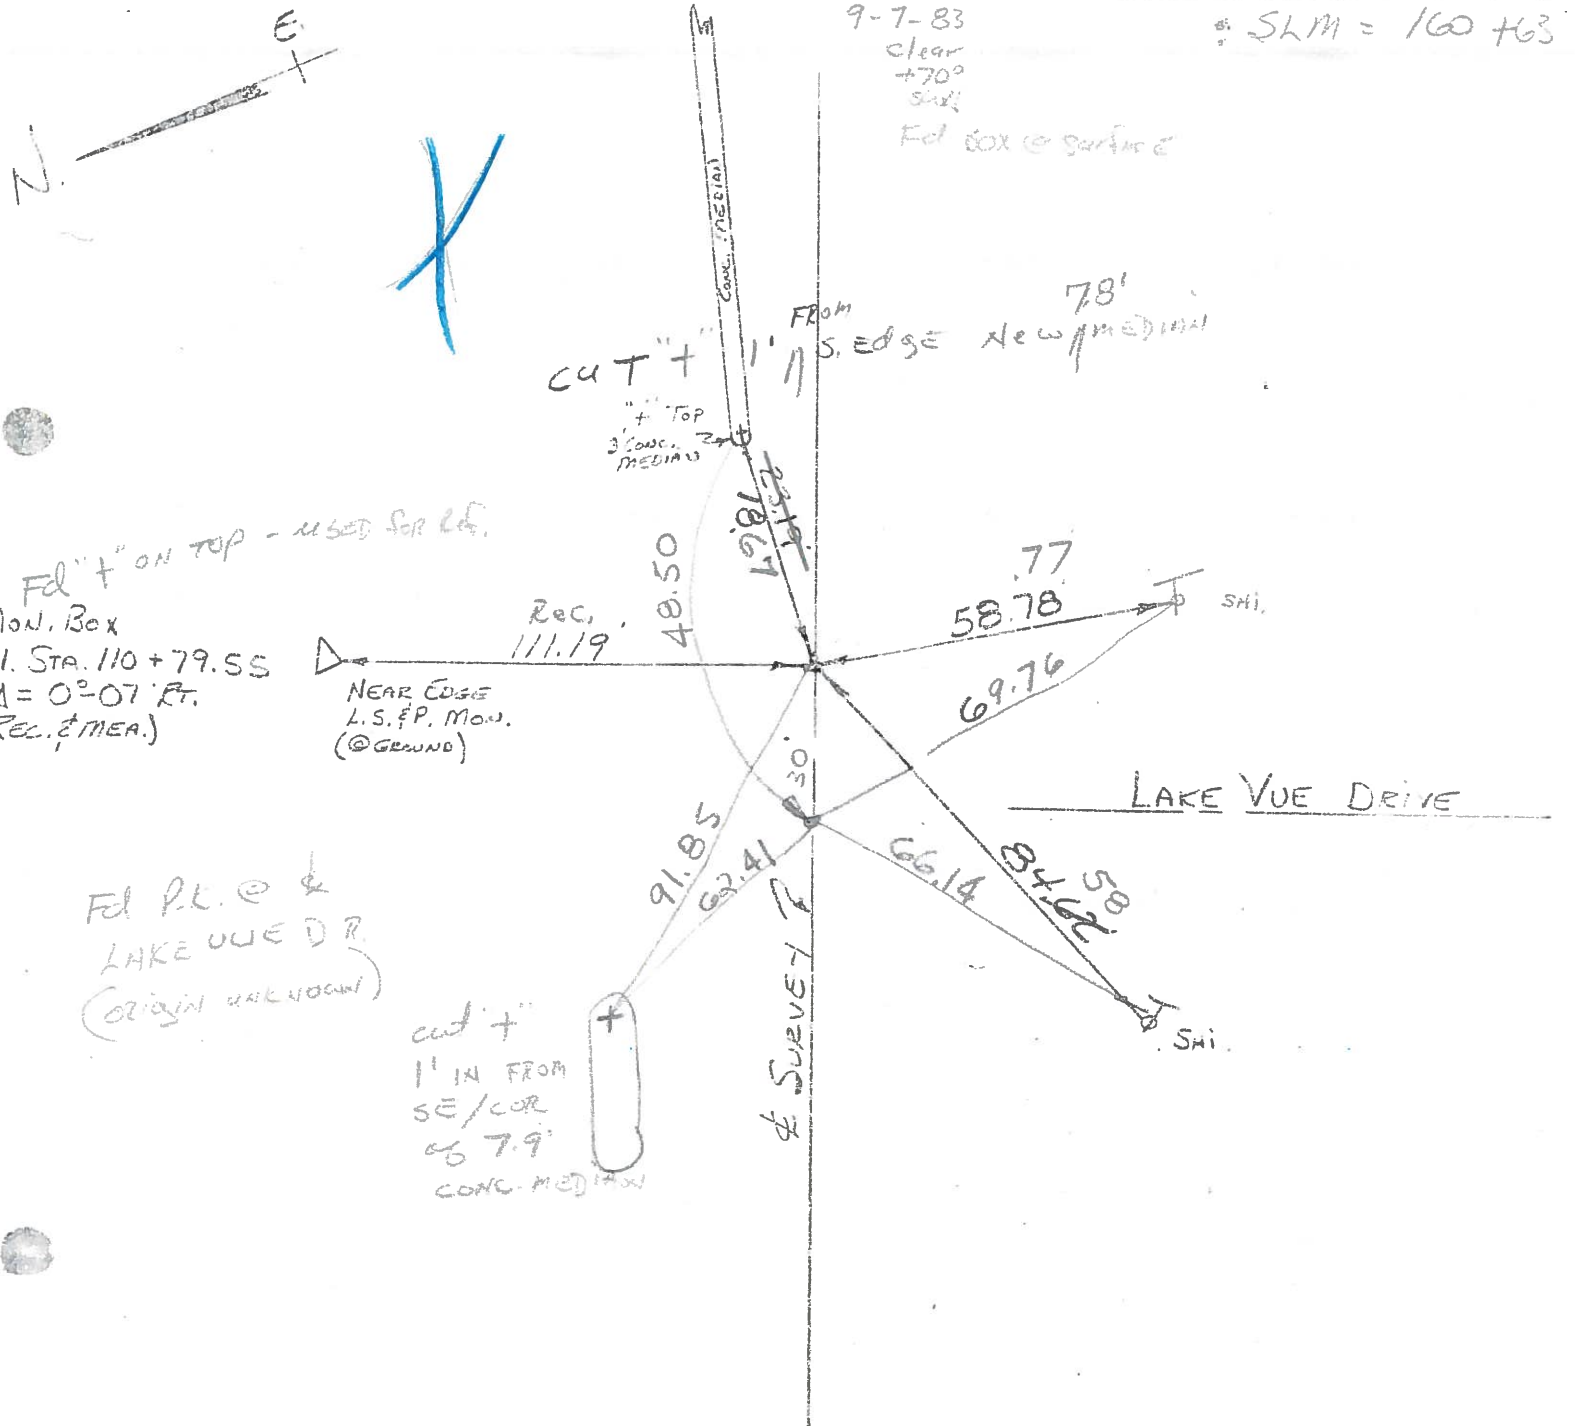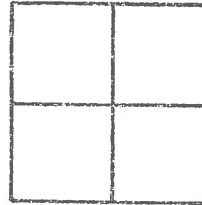

County Wood

Date 12-27-77

Township PERRYSBURG

Weather CLEAR

Section _____

Temp. +14°


T N, R E

Personnel BURNSIDE

SMITH

KNAPE

MEAD

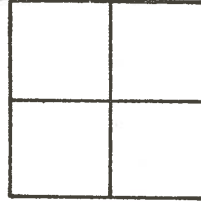

10

