

O.D.O.T. DISTRICT 2 SURVEY OFFICE (USE ONLY)

PERSONNEL

REFERENCE NO. 12

SHEET 8 OF 13

NOTES HOFFMAN
 H.C. LOEHRKE
 R.C. HOUSEHOLDER
BARNHISEL

DATE 9/7/83
 WEATHER CLOUDY
 TEMP. 31°

ROUTE US 20
 COUNTY WOOD
 TOWNSHIP PERRYSBURG
 SECTION 2

DWG BY JAMES PID 83592, 102808

T 4 N R 11 E

TYPE MONUMENT MONBOX

ON SURFACE - ~~BELOW~~ ON

OFFSET 0 PAVEMENT LT : RT

- TO - EDGE PAVEMENT


STATION: 185+86

HORZ. DATUM: NAD83 2011


GEOID: NAVD88 2012A

GRID: NORTHING: 686368.252

EASTING: 1669633.372

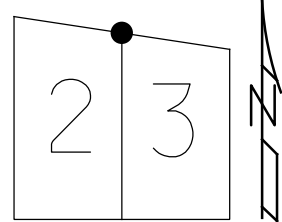

RECORD:
 FD MONBOX
 9/7/83, CL
 FD MONBOX
 SV7
 9-12-11, SAH
 FD MONBOX
 3-13-18, JFO
 FD MONBOX
 W/ 1" IPIN
 REF12
 4-18-18, JFO

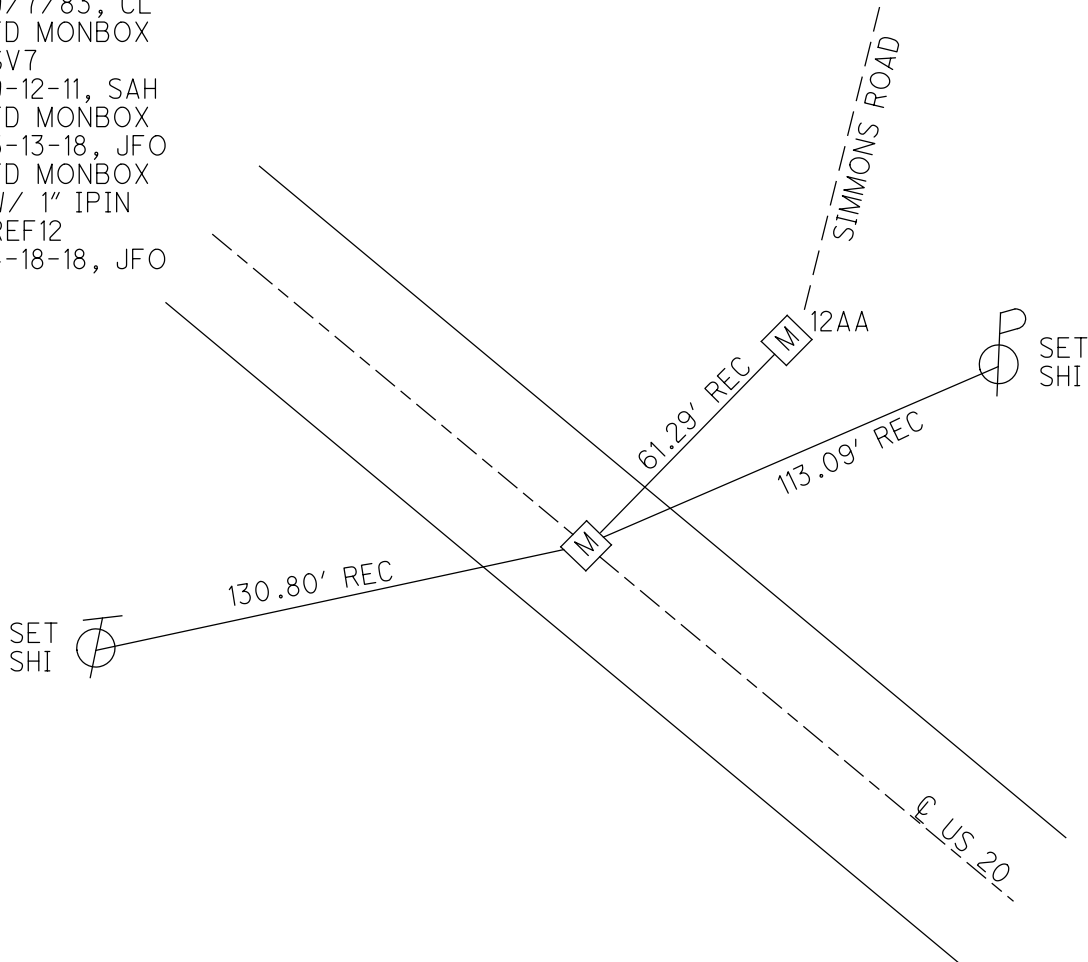

O.D.O.T. DISTRICT 2 SURVEY OFFICE (USE ONLY)

PERSONNEL

NOTES HOFFMAN
 H.C. LOEHRKE
 R.C. HOUSEHOLDER
BARNHISEL

REFERENCE NO. 12

DATE 09-07-83
 WEATHER CLEAR
 TEMP. 70°

SHEET 8 OF 13

ROUTE US 20
 COUNTY WOOD
 TOWNSHIP PERRYSBURG
 SECTION 2
 T 4 N R 11 E

TYPE MONUMENT MONUMENT BOX



ON SURFACE - ~~BELOW~~ ON

LEFT - ☉ PAV'T - RIGHT _____

_____ TO _____ EDGE PAVEMENT

S.L.M. 185+86

Grid: Northing: 686368.2254 Easting: 1669633.3521

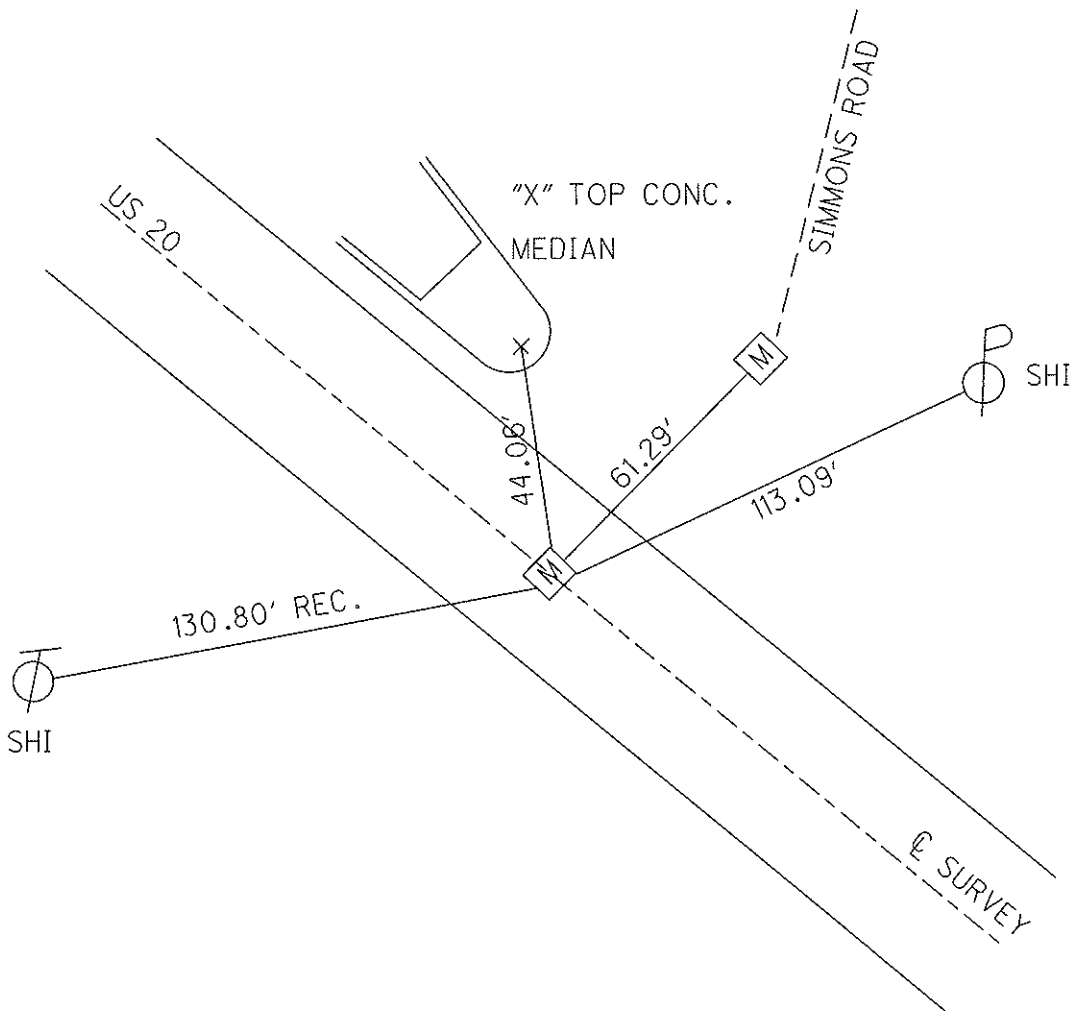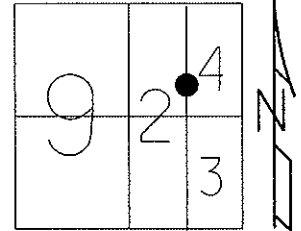

SHOT WITH WOO-20-3.52
 PID 83592
 SU7 - MON BOX
 09-12-11 SAH

ODOT. DISTRICT 2 SURVEY OFFICE

SHEET 7 OF

County Wood U.S. 20
S.R.

Date 9-7-83

Township PERRYSBURG



Weather CLEAR

Section _____

Temp. +70°

T N, R E

Personnel HOFFMAN

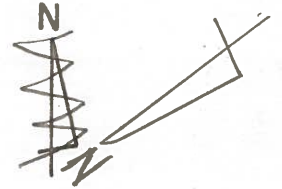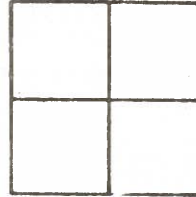


LOEHRKE

HOUSEHOLDER

BARNHISEL

12

12-AA

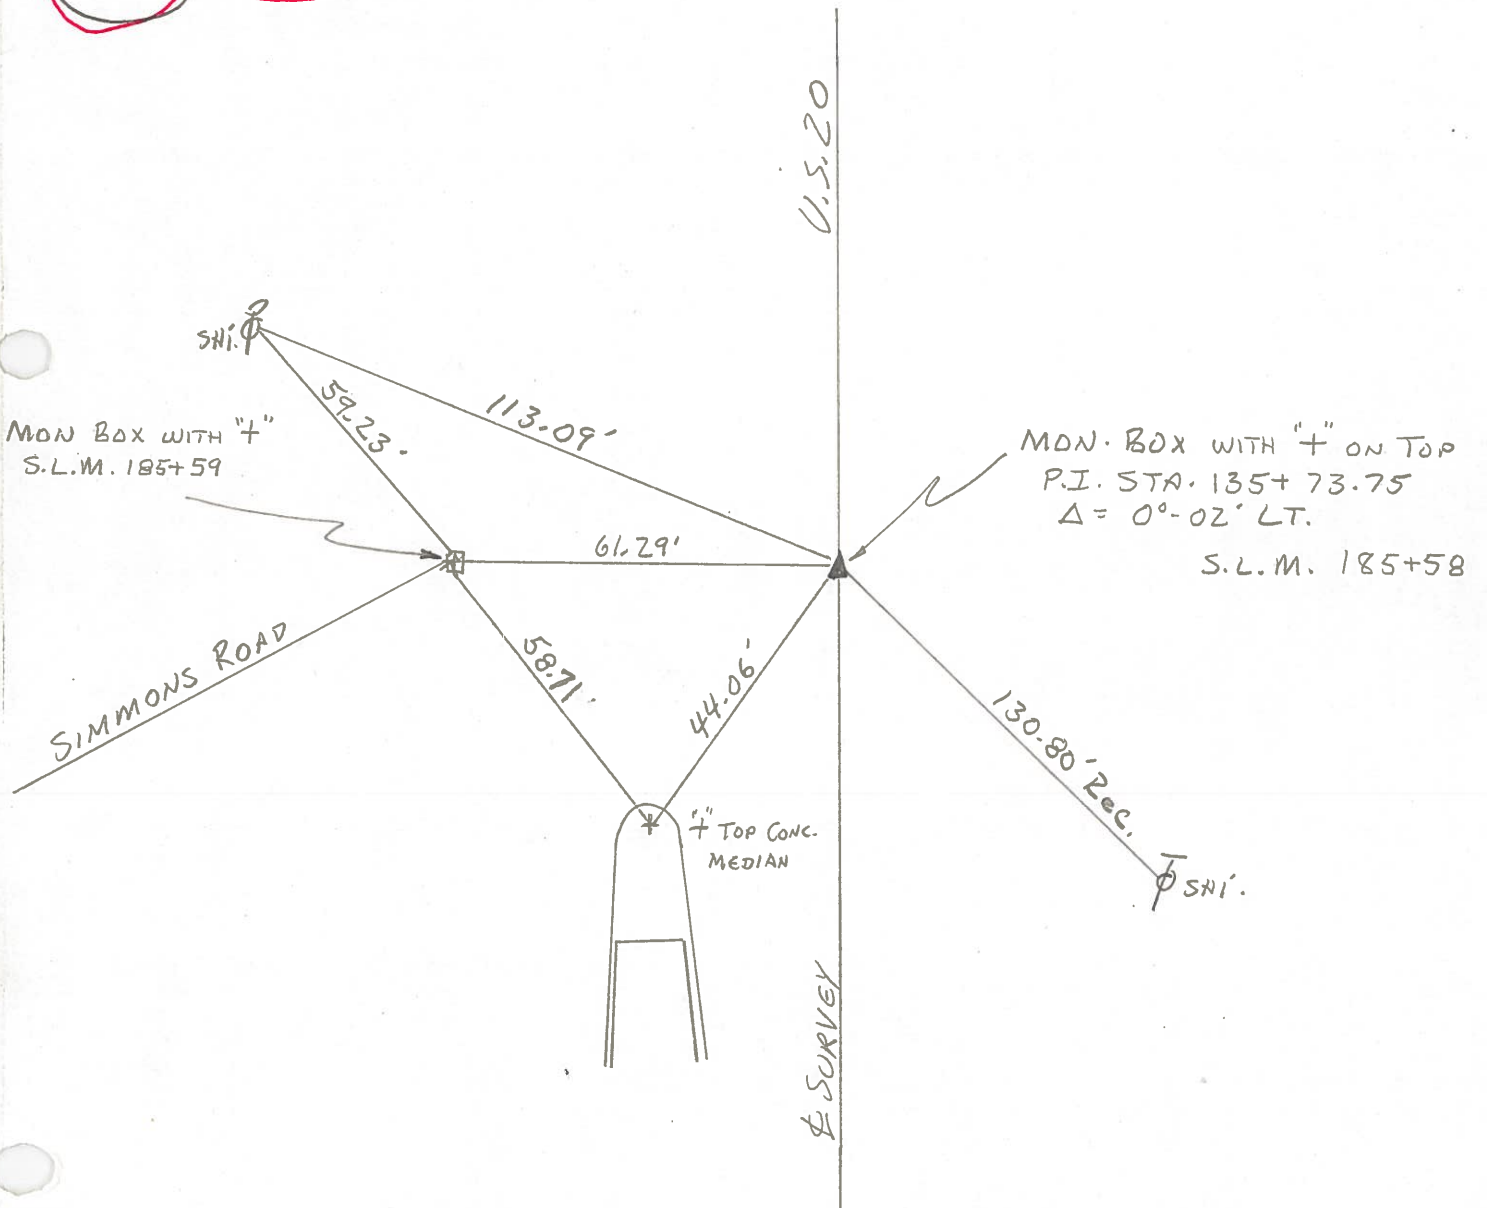

County WOOD

Date 12-27-77

Township PERRYSBURG

Weather PT. CLOUDY

Section _____

Temp. +15°


T N, R E

Personnel BURNSIDE

SMITH

KNAPE

MEAD

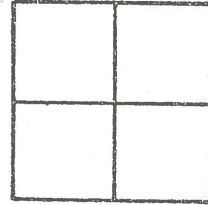

12

12-AA

9-7-83

clear

+700

SLM

Fd BOXES @ surface

N.



Fd
Shi.

Mon. Box / "+"
Lm=185+59

Simmons Rd.

Rec.
78.49

Shi. in
24" CATALPA

59.23
113.09
61.32

29
61.32

58.71

44.06

+ TOP
CONC.
MEDIAN

4 SURVEY 7

Mon. Box / "+"
P.I. STA. 135+73.75
 $\Delta = 0^{\circ}02' LT$

SLM = 185+58

130.80

Shi.

COVER

County Wood

Date 12-27-77

Township PERRYSBURG


Weather PT. CLOUDY

Section _____

Temp. +15°

T N, R E



Personnel BURNSIDE

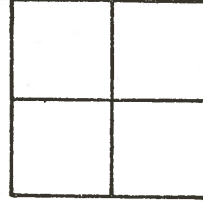

SMITH

KNAPE

MEAD

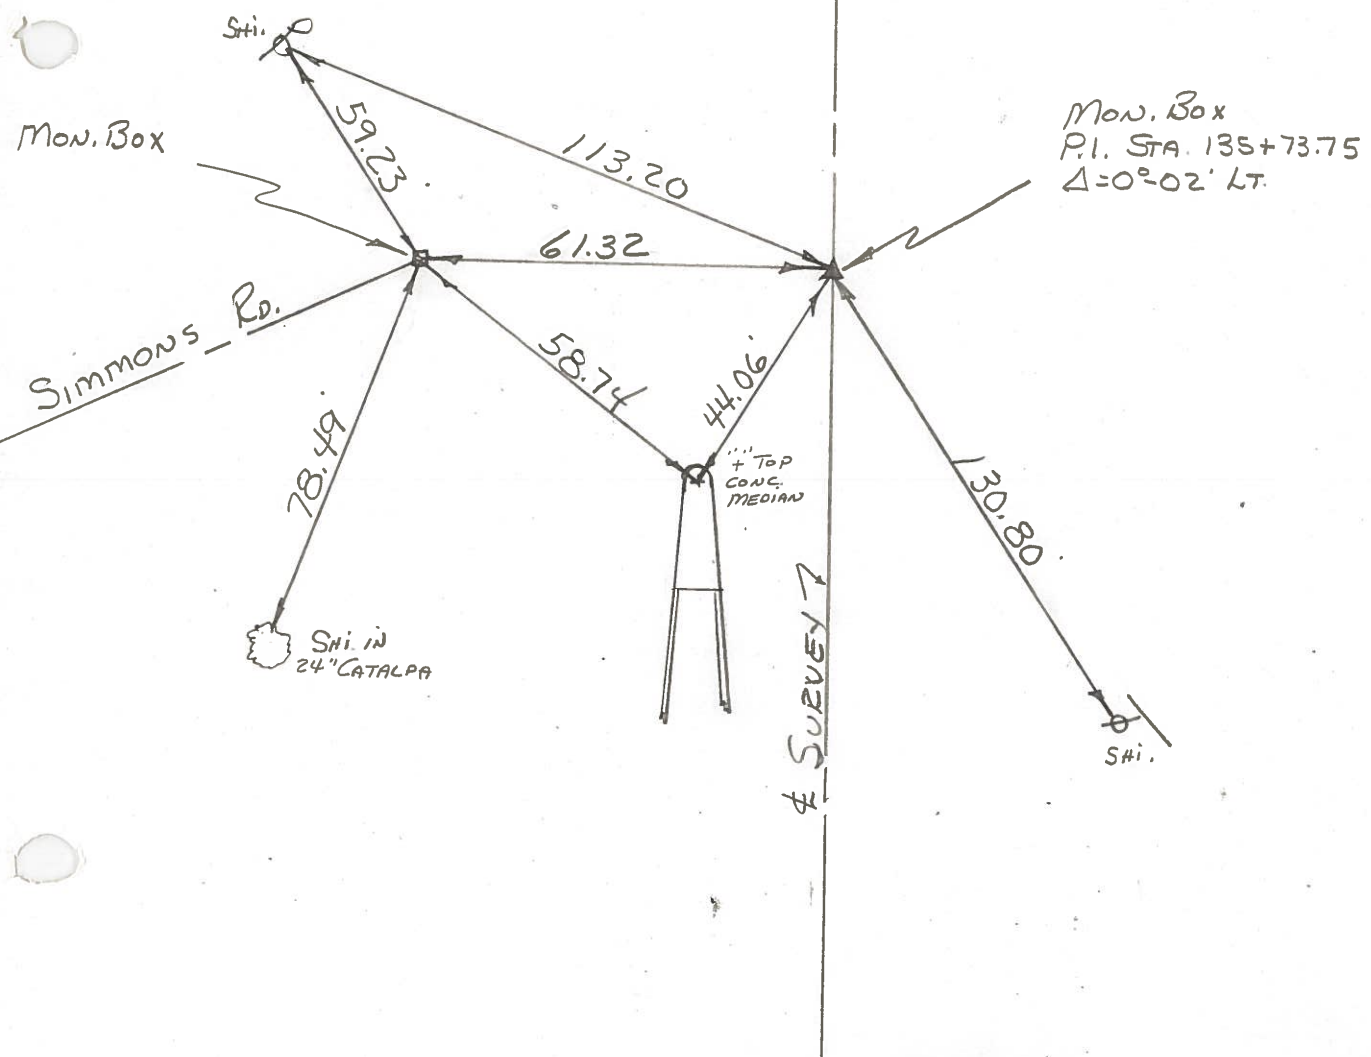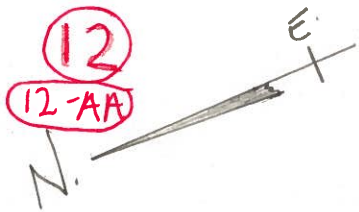

PERSONNEL	TITLE	PERSONNEL	TITLE	COUNTY	DATE	WEATHER	TEMP.
				Wood	3-24-53		
				S. R. U.S. #20	11-3-60		
				SEC.			

DESCRIPTION	LEFT	CENTER LINE	RIGHT	JOB NO.
Sta. 89+47.41 = 174+86.12' X-in Conc. pav't. - P.K. nail O.K.			Shiner in 18" maple W. 115. Shiner in T.P. S.W. 58. Shiner in P.P. E. 77. Stone N.E. 61. N. edge of pave. 19. S. edge of pave. 20	
#338				
Sta. 99+97.7 = 185+36.41 Fd. P.K. Nail.			Shi. in Φ #10701 N.E. 54.30' Shi. in Φ S. 59.23' Shi. in 8" Pine S.W. 73.36' N. edge Pav't 2.3' S. edge Pav't 19.9'	
Sta. 137+64.57				
#339				
Sta. 155+01 = 240+39.71 X-in Conc. pave. - P.K. nail O.K.			Shiner in cor. post N.E. 62. Shiner in T.P. S. 98. Shiner in T.P. S.W. 75. N. edge of pave. 20. S. edge of pave. 20.0	
#340				
Sta. 160+31.81 = 245+70.57 X-in Conc. pave. - P.K. nail O.K.			Shiner in Transformer pole N.N.W. 84.6 Shiner in T.P. S. 71.6 Conc. E/W man. S.S.E. 91.3 Conc. E/W man. N.E. 91.2 0.65' to N. edge pave. 21.30 " S. " " "	
#341				