

O.D.O.T. DISTRICT 2 SURVEY OFFICE (USE ONLY)

PERSONNEL

REFERENCE NO. 12 A

SHEET 10 OF 13

NOTES CRONIN DATE 10/7/81

ROUTE US 20

H.C. RIPPLE WEATHER -

COUNTY WOOD

R.C. GEYMAN TEMP. 45°

TOWNSHIP PERRYSBURG

SCHNEIDER, MOSSER, BARBOUR

SECTION 3

DWG BY JAMES PID 102808

T 4 N R 11 E

TYPE MONUMENT P.K. NAIL

~~ON SURFACE~~ - BELOW 1"


OFFSET \odot PAVEMENT _____ LT : RT

- TO - EDGE PAVEMENT


STATION: _____

HORZ. DATUM: _____ GEOID: _____

GRID: NORTHING: _____ EASTING: _____

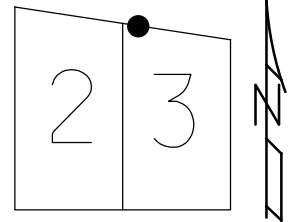

RECORD:
 STA. 144+25±
 FD. P.K. NAIL
 1" DOWN
 5-19-80, DC
 FD P.K. NAIL
 1" DOWN
 10-7-81, DC
 DNF
 9-12-11

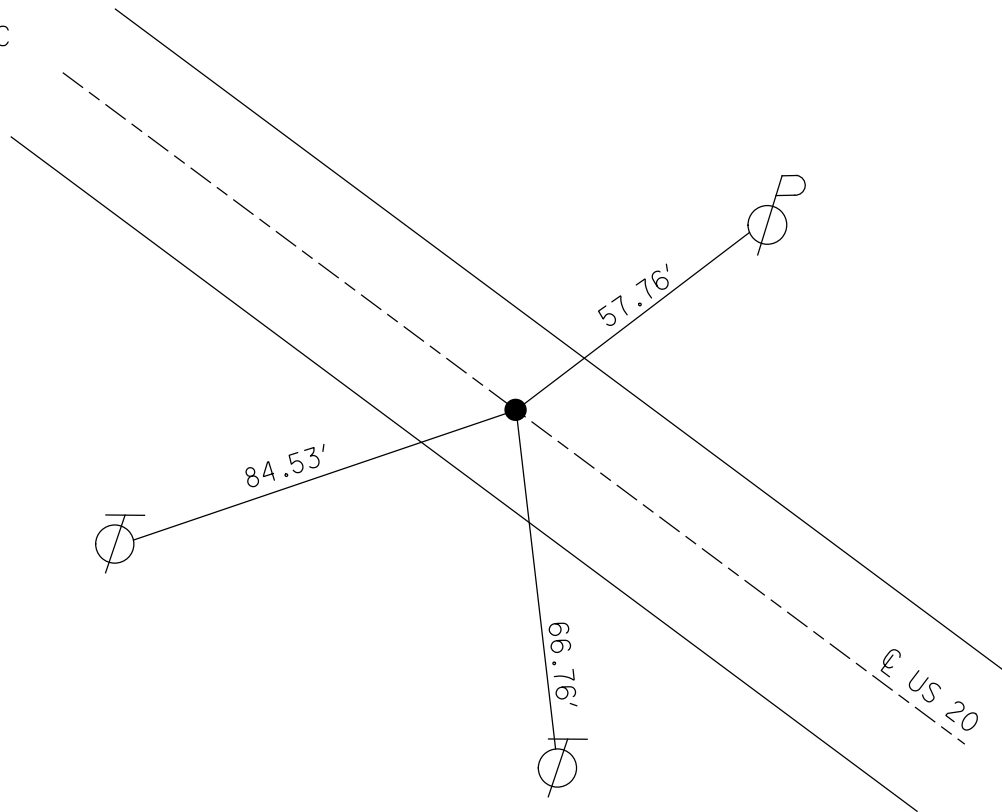

O.D.O.T. DISTRICT 2 SURVEY OFFICE (USE ONLY)

PERSONNEL _____

REFERENCE NO. 12A

SHEET 10 OF 13

NOTES CRONIN

DATE 10-07-81

ROUTE US 20

H.C. RIPPLE

WEATHER _____

COUNTY WOOD

R.C. GEYMAN

TEMP. 45°

TOWNSHIP PERRYSBURG

SCHNEIDER

SECTION 4

MOSSER-BARBOUR

T 4 N R 11 E

TYPE MONUMENT _____ P.K. NAIL _____


ON SURFACE - BELOW _____ 1" _____

LEFT - CL PAV'T - RIGHT _____

_____ TO _____ EDGE PAVEMENT


S.L.M. _____

Grid: Northing: _____ Easting: _____

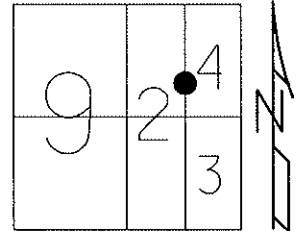

10-07-81
 FD. P.K. NAIL 1" BELOW SURFACE
 BEGIN OLD STA.
 1948 PLANS - (0-48 & 0-48A)
 (BIN 37-A-4)

NOTE: 09-12-11 DNF
 TIES - DO NOT EXIST
 POINT - DOES NOT EXIST
 MCDONALD'S - "X"
 CUT IN PULL BOX
 SU 1010

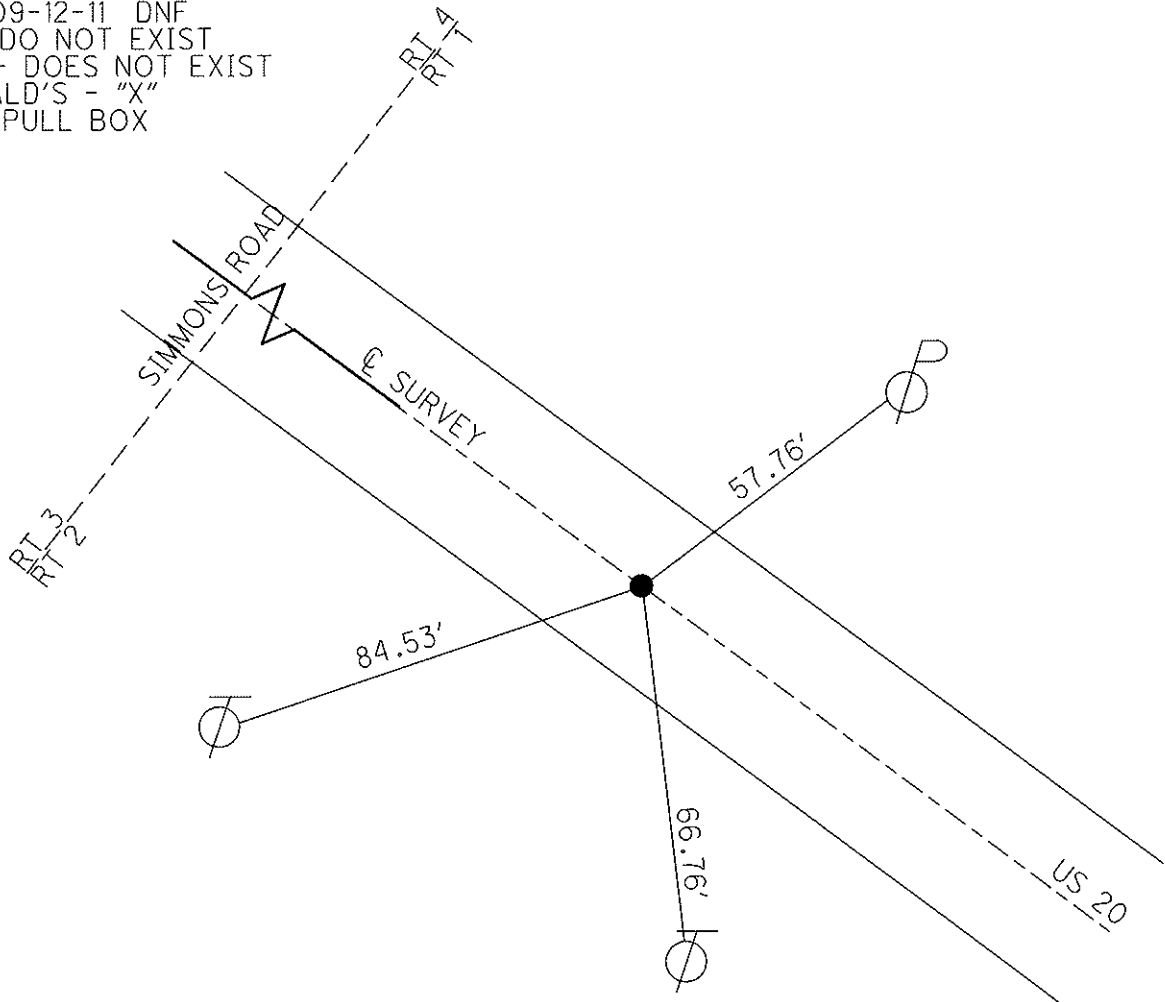

County Wood S.R. U.S. #20

Date 5/19/80

Township Perrysburg

Weather sunny

Section _____


Temp. 60°

T N, R E

Personnel CRONIN SCHNEIDER

RIPPLE MOSSER

GOYMAN BARRON

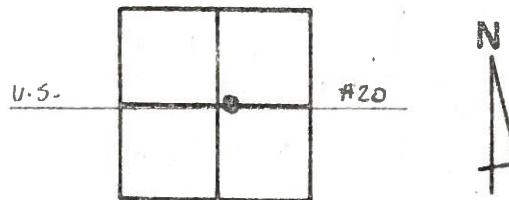

12-A

9-7-83 JOHN
could not FIND
must be beyond project


OK. 10-7-81

⊙ 45°

X



144+25±
Fd. P.K. 1" below surface
BEGIN OLD STA.

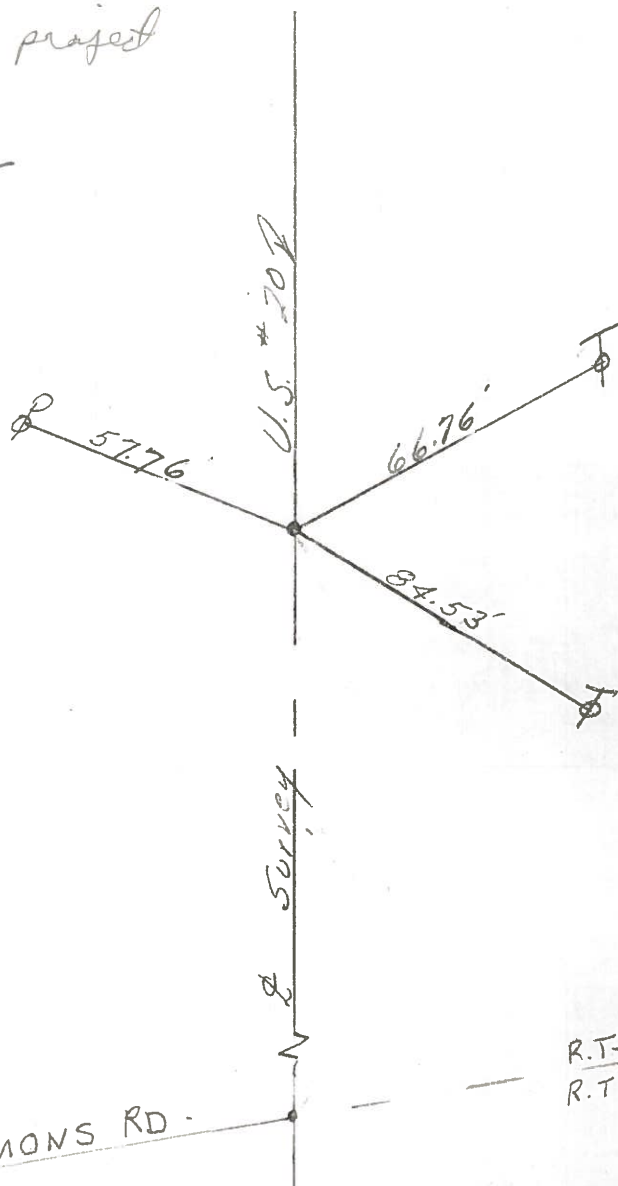

R.T.-4
R.T.-1

SIMMONS RD.

R.T.-3
R.T.-2

144+25
135+74
8+51
185+58
194+09

Q.D.O.T. DISTRICT 2 SURVEY OFFICE

SHEET 9 OF

County WOOD ^{U.S.} ~~S.R.~~ 20

Date O.K. 10-7-81

Township PERRYSBURG

Weather @ 45°

Section _____

Temp. 47.0°

T N, R E

Personnel CROWN


RIPPLE

GEYMAN

SCNEIDER


MOSSER - BARBOUR

14

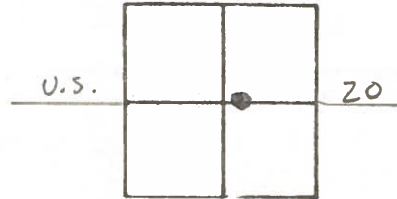

12-A

U.S. 20

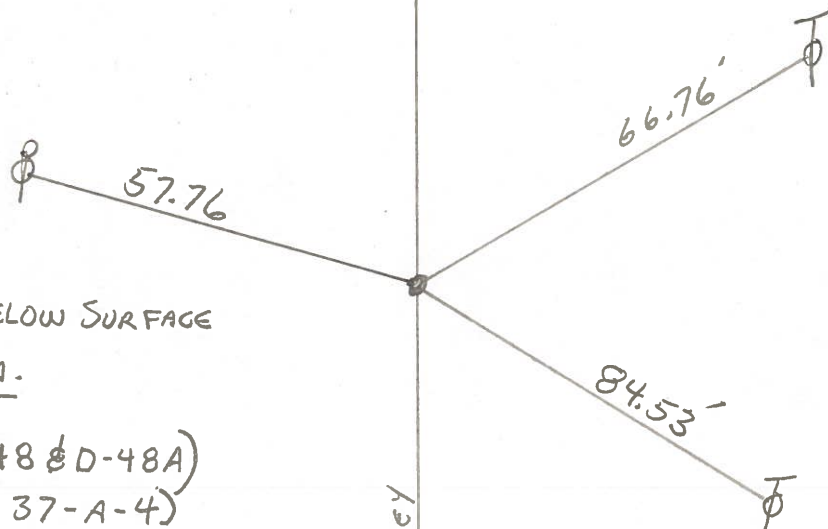

144+25±

FD. P.K. NAIL 1" BELOW SURFACE

BEGIN OLD STA.

1948 PLANS - (D-48 & D-48A)
(BIN 37-A-4)

SURVEY

SIMMONS RD.

R.T.-4
R.T.-1

R.T.-3
R.T.-2

County Wood S.R. U.S. #20

Date 5/19/80

Township Perrysburg

Weather sunny

Section 48

Temp. 60°


T N, R E

Personnel CRONIN SCHNEIDER

RIPPLE MOSSER

GEYMAN BARBOUR

12-A

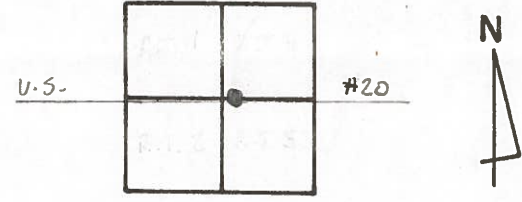


OK. 10-7-81

@ 45°



144+25±
Fd. P.K. 1" below surface
BEGIN OLD STA.

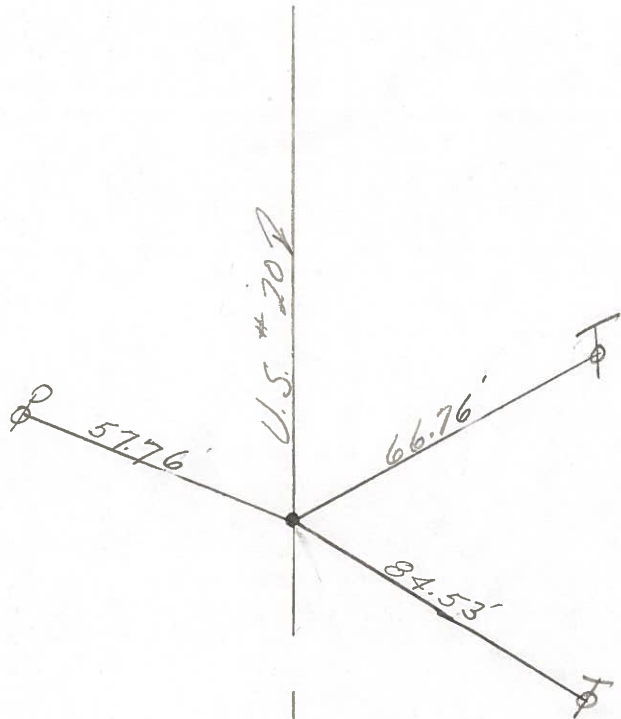

R.T.-4
 R.T.-1

SIMMONS RD.

R.T.-3
 R.T.-2

County Wood S.R. U.S. #20

Date 5/19/80

Township Perrysburg

Weather sunny

Section _____

Temp. 60°


T N, R E

Personnel CRONIN SCHNEIDER


RIHLE MOSSER

GEYMAN BENNETT

~~14~~ 12-A

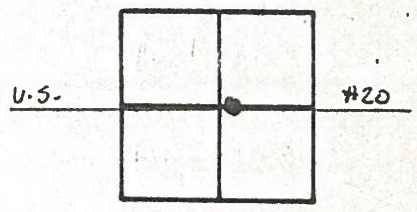

144+2.5±
Ed. P.K. 1" below surface

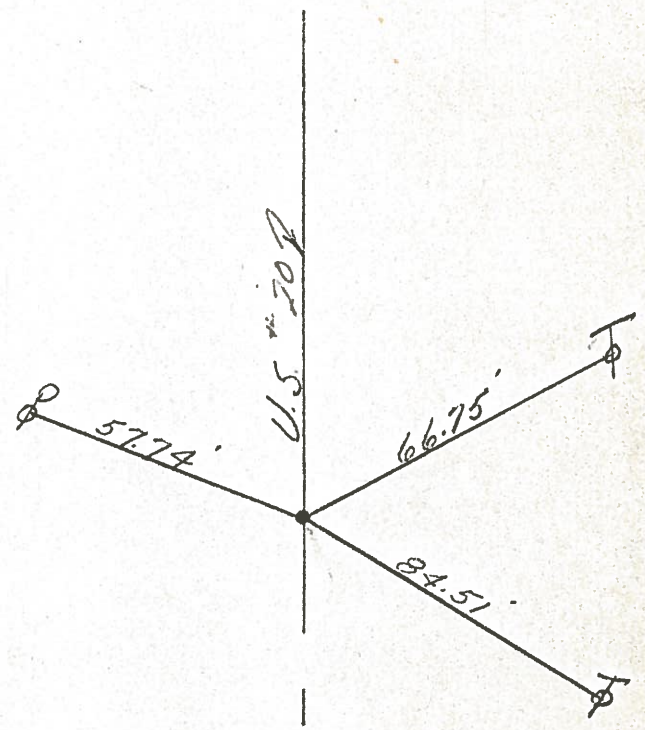


R.T.-4
R.T.-1

SIMMONS RD.
135+ 73.75'

R.T.-3
R.T.-2

PERSONNEL	TITLE	PERSONNEL	TITLE	COUNTY	Wood	DATE	Aug. 17, 1977
Tomasic		Gancarz		S. R.	U. S. 20	Rechecked	Dec-23-77
Neuser				SEC.	Perrysburg TWP.	WEATHER	
Vanyo						TEMP.	
Granata							

DESCRIPTION REF. TIES for Control Pts. (From old 1948 plans - S.H. 275 Sec. C) JOB NO. _____

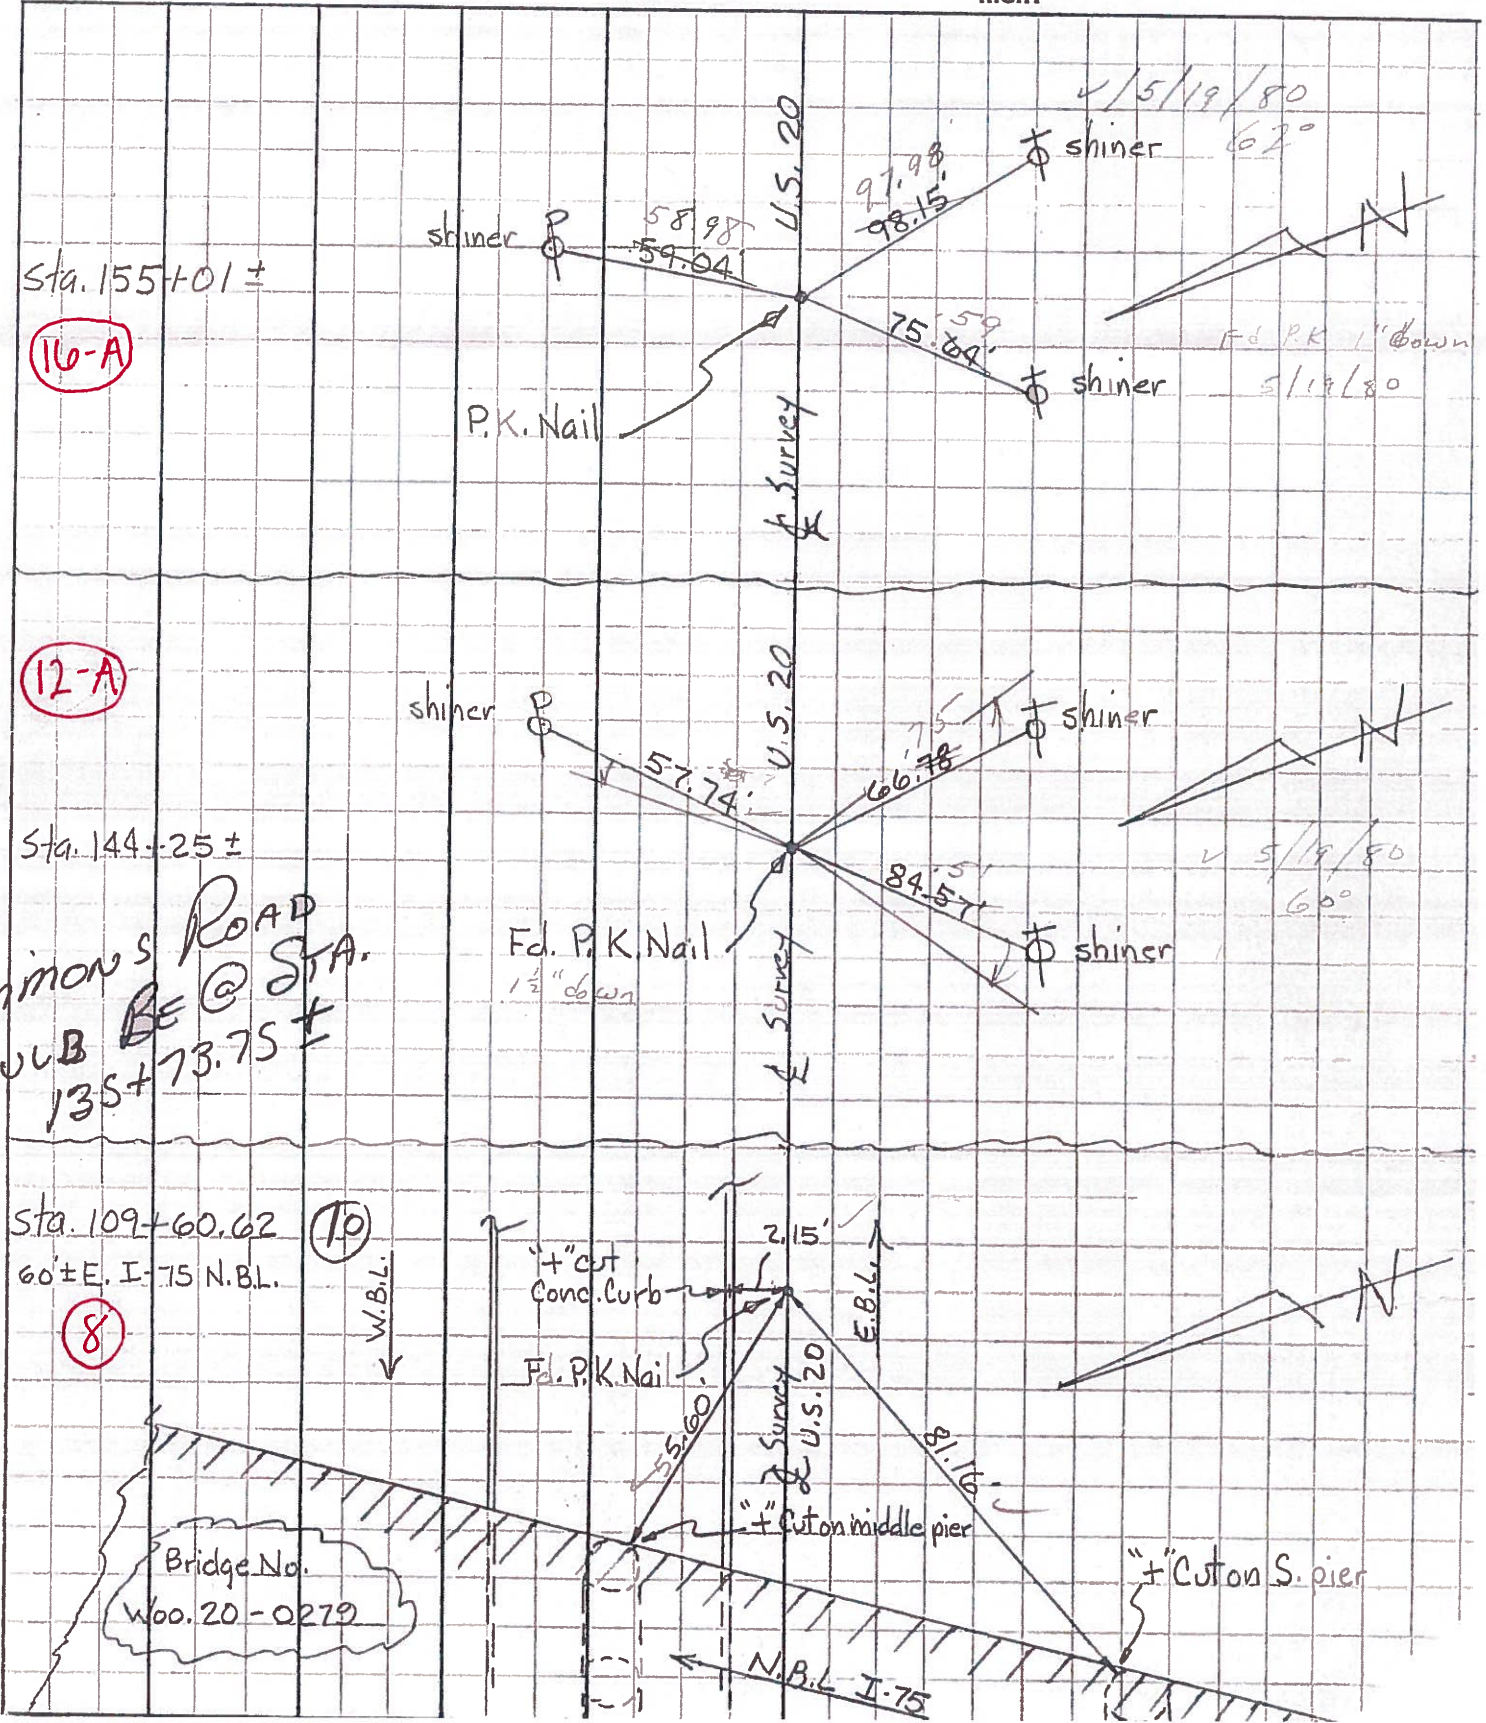

PERSONNEL	TITLE	PERSONNEL	TITLE	COUNTY	DATE
Tomsic		Gancarz		Wood	Aug. 17, 1972
Neuser				U.S. 20	Rechecked Dec-23-7
Vanyo				Perrysburg TWP.	WEATHER
Granata					TEMP.

DESCRIPTION REF. TIES for Control Pts. (from old 1948 plans - S.H. 275 Sec. C)

