



O.D.O.T. DISTRICT 2 SURVEY OFFICE (USE ONLY)

PERSONNEL _____ REFERENCE NO. 19 A SHEET 2 OF 23
 NOTES MALINSKY DATE 6/24/02 ROUTE US 20
 H.C. MOSER WEATHER CLEAR COUNTY WOOD
 R.C. SIEFRING TEMP. 95° TOWNSHIP PERRYSBURG
BEAUMONT SECTION RT 16
 T 4 N R 11 E

TYPE MONUMENT _____ PK/WASHER _____
 ON SURFACE - ~~BELOW~~ _____ ON _____
 LEFT - ☉ PAV'T - ~~RIGHT~~ _____ 83' _____
 _____ TO _____ EDGE PAVEMENT _____
 S.L.M. _____ 292+48 _____
 GRID: NORTHING: _____ - _____ EASTING: _____ - _____

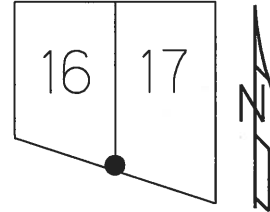

RECORD:
 STA 206+43.18
 $\Delta = 0^\circ 26' 30''$ RT
 $D = 0^\circ 02'$
 $R = 171887.30'$
 $T = 662.51'$
 $L = 1325.00'$
 $E = 1.29'$
 1948 PLANS
 S.H. 275 SEC C
 FD P.K.NAIL
 1972, 1975, 1980, 1992
 SET MAG/WASHER
 3/4/04, MB
 D.N.F. MAG/WASHER
 8-11-16, DCH

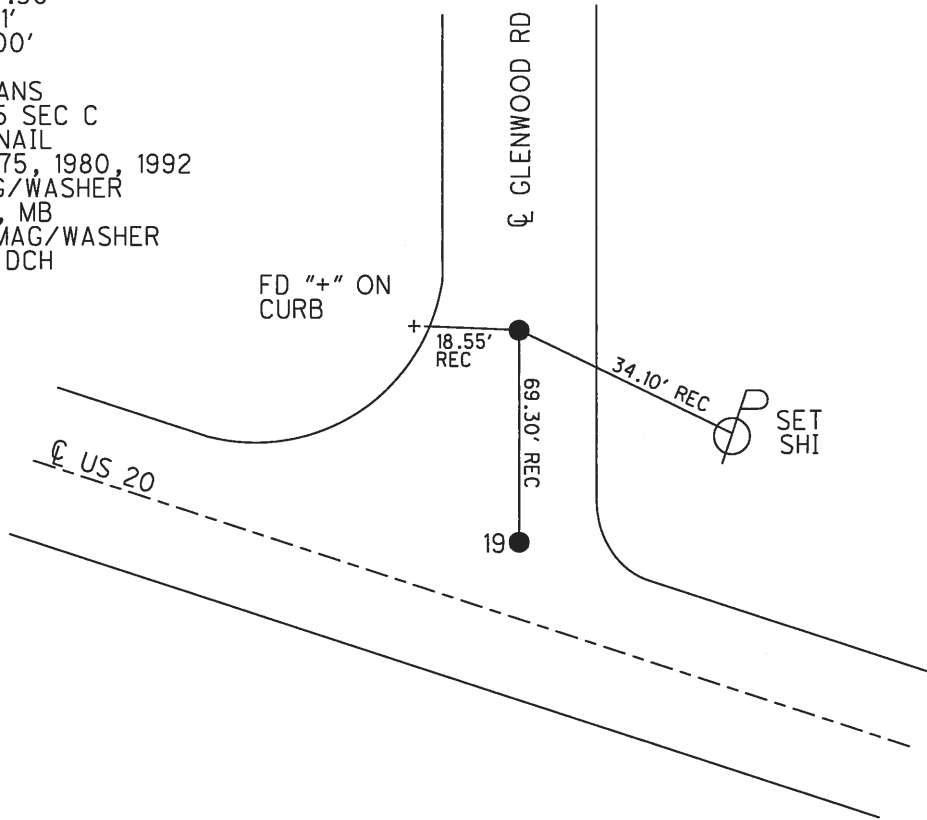

O.D.O.T. DISTRICT 2 SURVEY OFFICE (USE ONLY)

PERSONNEL _____ REFERENCE NO. 19 A SHEET 2 OF 19

NOTES	MALINSKY _____	DATE	<u>6/24/02</u>	ROUTE	<u>US 20</u>
H.C.	MOSER _____	WEATHER	<u>CLEAR</u>	COUNTY	<u>WOOD</u>
R.C.	SIEFRING _____	TEMP.	<u>95°</u>	TOWNSHIP	<u>PERRYSBURG</u>
	BEAUMONT _____			SECTION	<u>RT 16</u>
				T <u>4</u> N	R <u>11</u> E

TYPE MONUMENT _____ PK/WASHER _____


ON SURFACE - ~~BELOW~~ _____ ON _____

LEFT - ℄ PAV'T - ~~RIGHT~~ _____ 83' _____


_____ TO _____ EDGE PAVEMENT

S.L.M. _____ 292+48 _____

GRID: NORTHING: _____ EASTING: _____

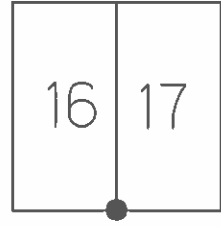


RECORD:
 STA 206+43.18
 $\Delta = 0^\circ 26' 30''$ RT
 $D = 0^\circ 02'$
 $R = 171887.30'$
 $T = 662.51'$
 $L = 1325.00'$
 $E = 1.29'$
 1948 PLANS
 S.H. 275 SEC C
 SET MAG/WASHER
 3/4/04, MB

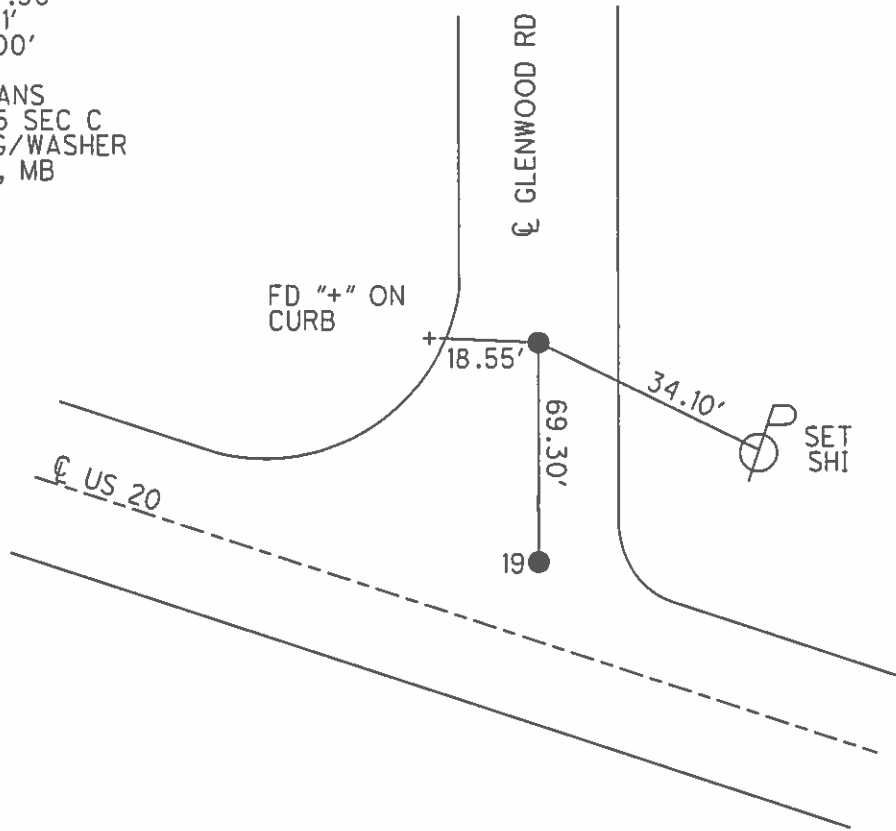

PERSONNEL	TITLE	PERSONNEL	TITLE	COUNTY	DATE
Tomsic		Gancarz		WOOD	Aug. 16, 19-
Neuser				U.S. 20	Rechecked Dec-23
Vanyo					WEATHER
Granata				SEC. Perrysburg TWP.	TEMP.

DESCRIPTION REF. CONTROL Pts. LEFT CENTER LINE RIGHT JOB NO.

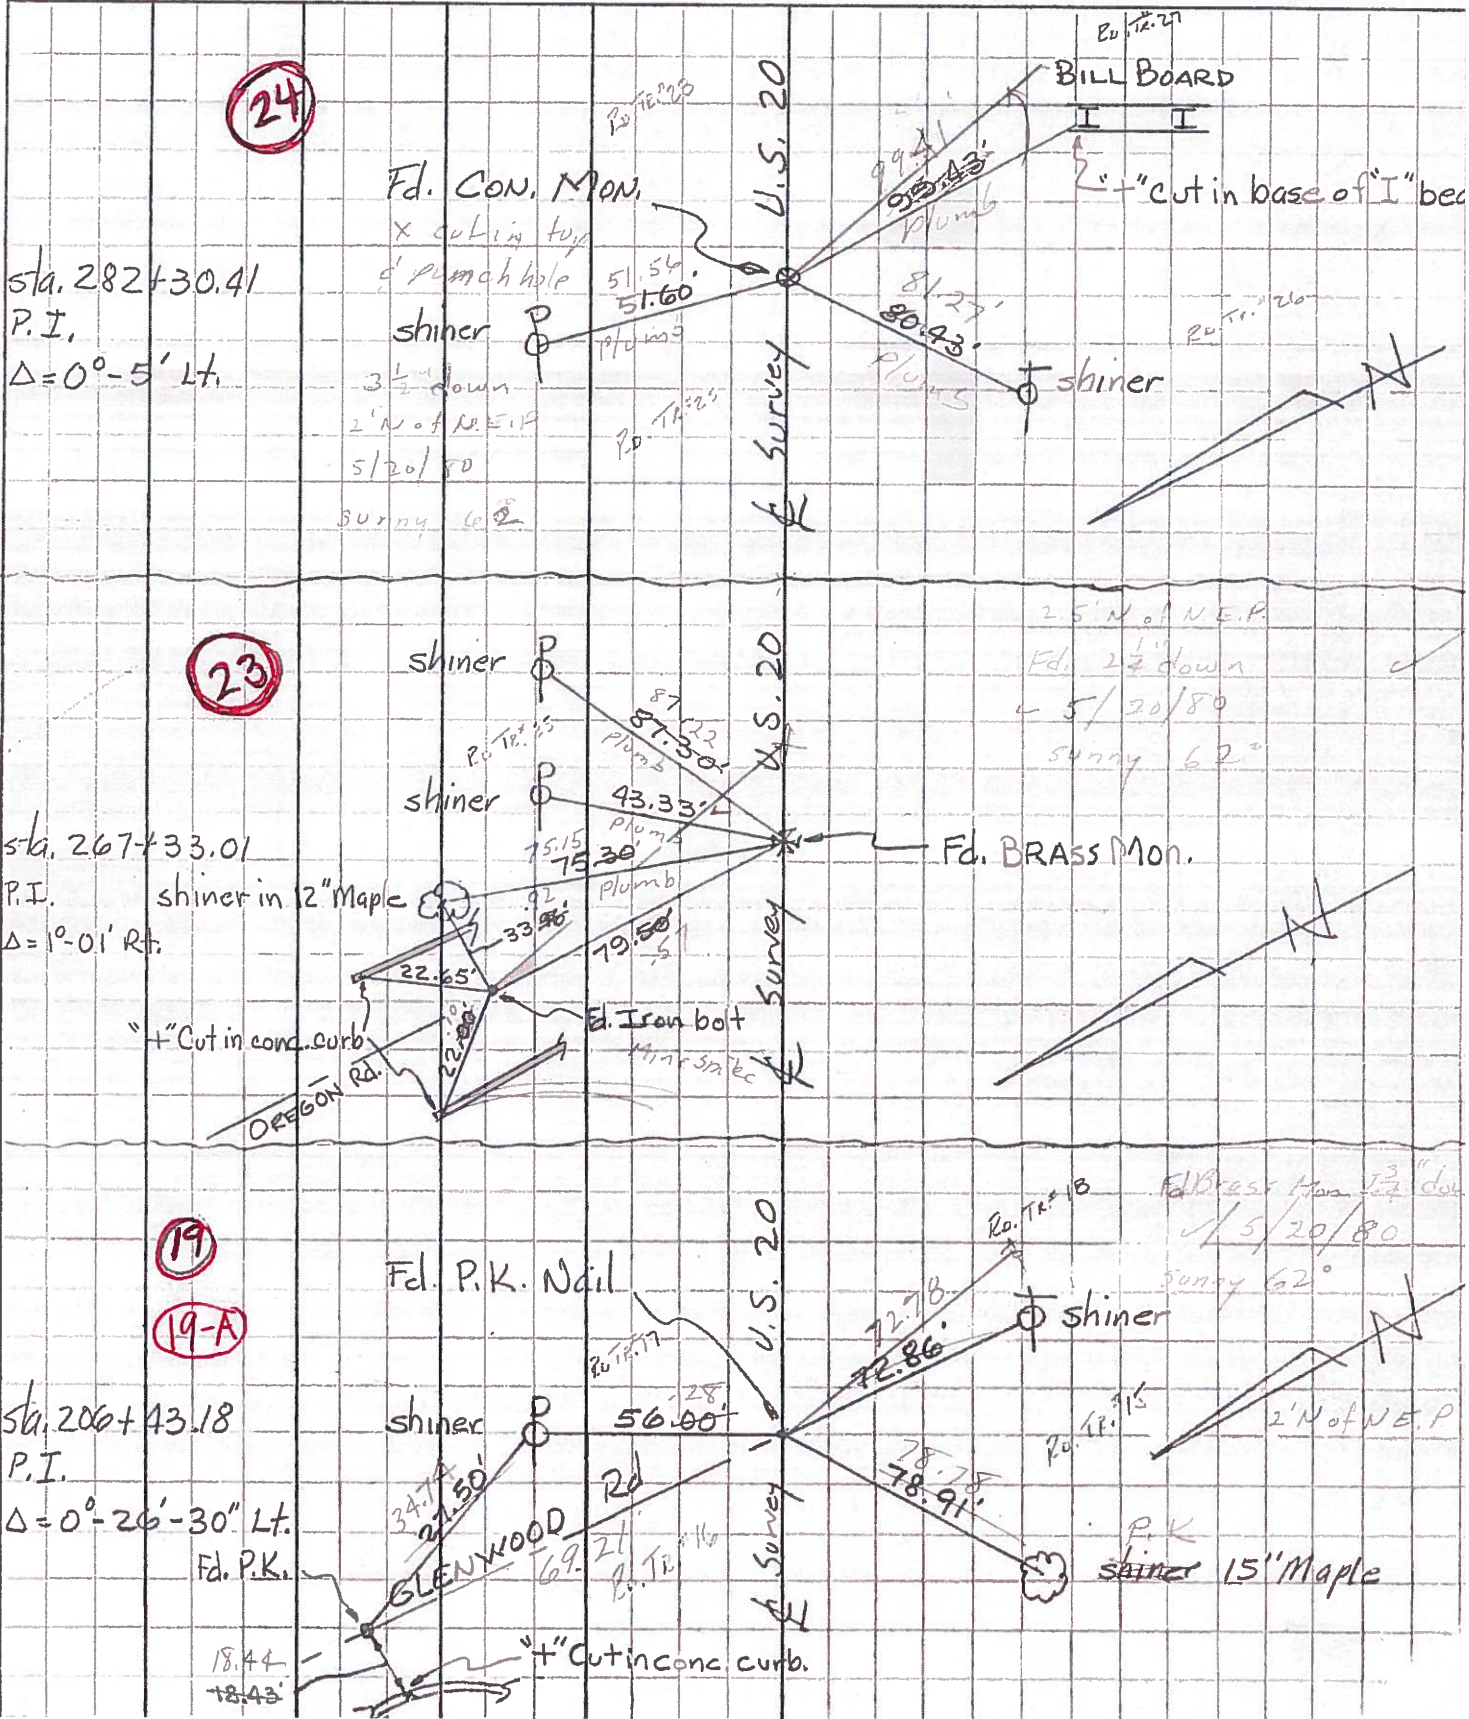

PERSONNEL	TITLE	PERSONNEL	TITLE	COUNTY	WOOD	DATE	Aug. 16, 19-
Tomsic		Gancarz		S.R.	U.S. 20	Rechecked	Dec-23
Neuser				SEC.	Perrysburg TWP.	WEATHER	
Vanyo				TEMP.			
Granata							

DESCRIPTION REF. CONTROL Pts. LEFT CENTER LINE RIGHT JOB NO.

