



O.D.O.T. DISTRICT 2 SURVEY OFFICE (USE ONLY)

PERSONNEL _____ REFERENCE NO. 30 B SHEET 12 OF 23
 NOTES LEU DATE 8/9/16 ROUTE US 20
 H.C. HOMAN WEATHER CLEAR COUNTY WOOD
 R.C. LEU TEMP. 85° TOWNSHIP TROY
 _____ SECTION RT 37
 _____ T 6 N R 12 E

TYPE MONUMENT MAG/WASHER
 ON SURFACE - ~~BELOW~~ ON
 LEFT - ☉ PAV'T - ~~RIGHT~~ 1.0'
10.7' TO LT EDGE PAVEMENT
 S.L.M. 443+99
 GRID: NORTHING: 673529.362 EASTING: 1691994.099

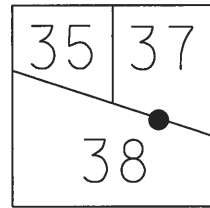


RECORD: P.T.
 1948 CURVE DATA
 $\Delta=0^{\circ} 41' 30''$ RT
 $R=85943.70'$
 $T=518.75$
 $L=1037.50'$
 $E=1.57'$
 SET MAG/WASHER
 3/4/04, MB
 FD MAG/WASHER
 REFB30
 8/9/16, DCH
 SET MAG/WASHER
 5/7/18, JFO

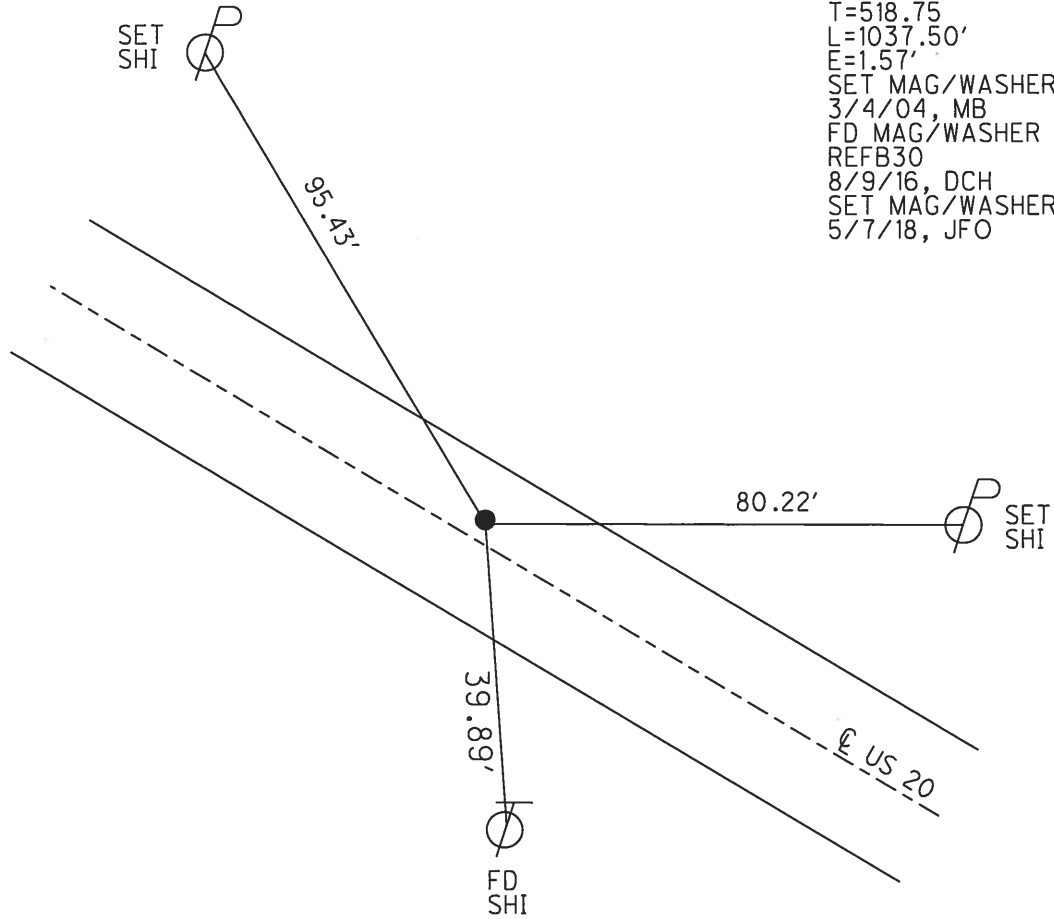

O.D.O.T. DISTRICT 2 SURVEY OFFICE (USE ONLY)


PERSONNEL _____ REFERENCE NO. 30 B SHEET 12 OF 19
 NOTES MICHALAK _____ DATE 6/25/02 ROUTE US 20
 H.C. MOSER _____ WEATHER CLEAR COUNTY WOOD
 R.C. SIEFRING _____ TEMP. 95° TOWNSHIP TROY
 BEAUMONT _____ SECTION RT 37
 T 6 N R 12 E

TYPE MONUMENT _____ P.K./WASHER _____
 ON SURFACE - ~~BELOW~~ _____ ON _____
 LEFT - Q PAV'T - ~~RIGHT~~ 1.0' _____
10.7' TO LT EDGE PAVEMENT _____
 S.L.M. _____ 443+99 _____

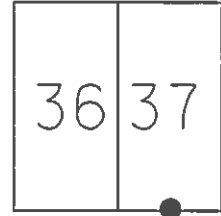

GRID: NORTHING: _____ EASTING: _____

RECORD:
 1948 CURVE DATA
 $\Delta=0^{\circ} 41' 30''$ RT
 $R=85943.70'$
 $T=518.75'$
 $L=1037.50'$
 $E=1.57'$
 SET MAG/WASHER
 3/4/04, MB

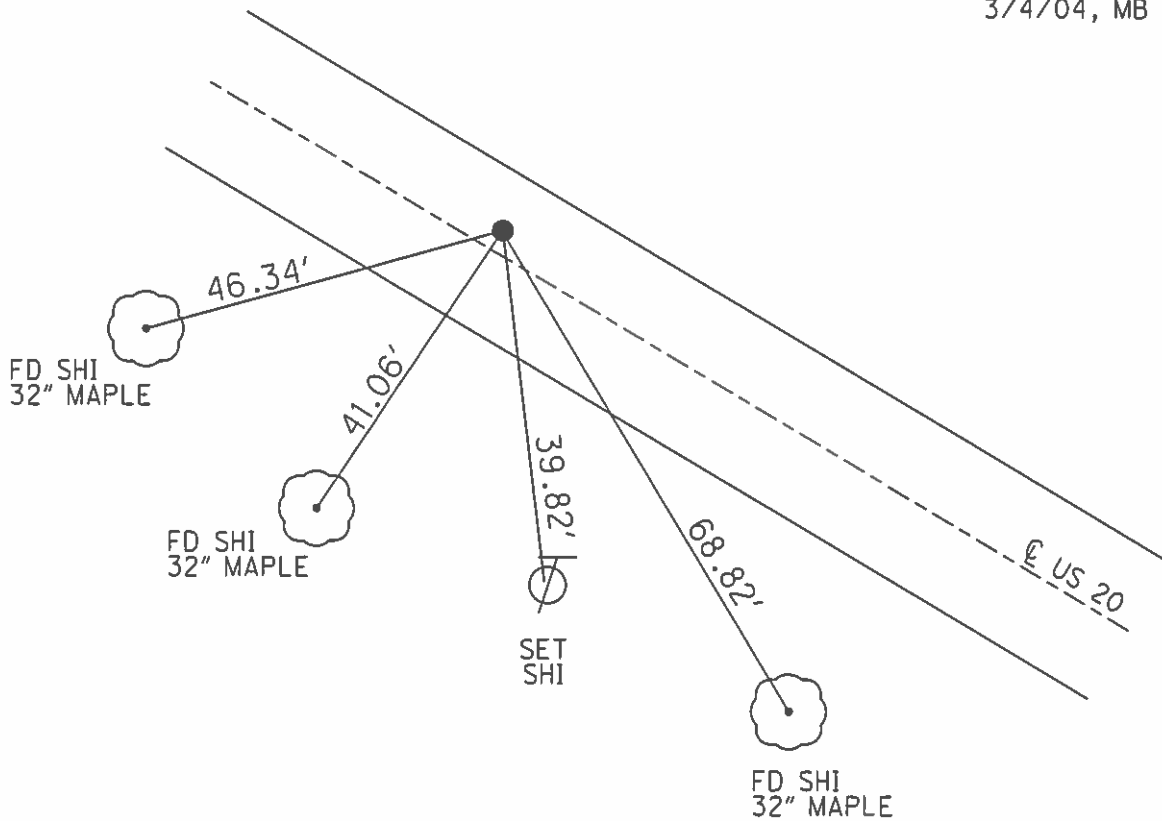

O.D.O.T. DISTRICT 2 SURVEY OFFICE

PERSONNEL _____

REFERENCE NO. 30-8

SHEET 13 OF 19

NOTES LOEHRKE

H.C. CURTIS

DATE 5-13-92

ROUTE U.S. 20

R.C. ROMETO

WEATHER Pt Cloudy

COUNTY Wood

TEMP. +70

TOWNSHIP TROY

SECTION R.T. 37

T. 6 N R 12 E

Reset

6-29-93


TYPE MONUMENT P.K. w/ WASHER

ON SURFACE - ~~BELOW~~ yes

LEFT- & PAVT. - ~~RIGHT~~ 1.0

11.3 TO Lt EDGE PAVEMENT

S.L.M. 443 + 99

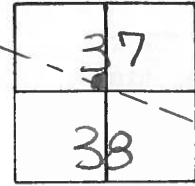

1948 CURVE DATA

$\Delta = 0^\circ 41' 30''$ RT

R = 85943.70'

T = 518.75'

L = 1037.50'

E = 1.57'


Q SURVEY
 Not Q R/W

P.I. Sta 352+69.18 DID NOT FIND

P.C. Sta = 347+50.48

P.T. Sta = 357+87.93

This is the P.T.
 PLAN Sta 357+87.93
 NOT THE P.I.

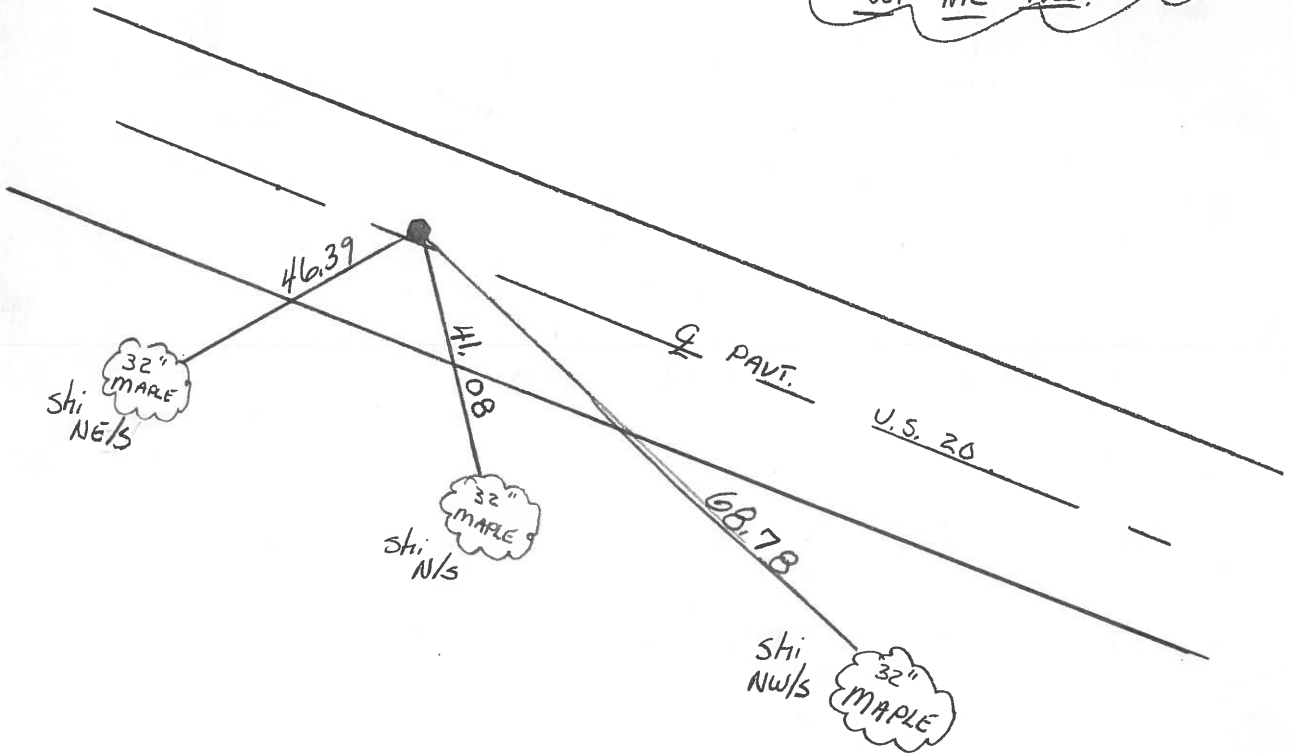

Q.D.O.T. DISTRICT 2 SURVEY OFFICE

Sht. 14 of 30

County Wood S.R. U.S. #20

Township Troy

Section R.T. 37

T N, R E

Personnel CRONIN

RIPPLE

GEYMAN

MOSSER


BARBOUR

30-B

Date 5/21/80 Drawn 5/27/80

Weather sunny

Temp. 65°

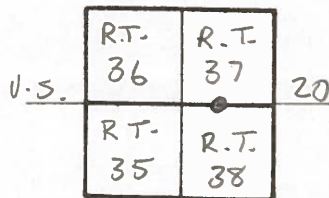


1948 CURVE DATA ON $\frac{1}{2}$ SURVEY
 $\Delta = 0^{\circ}-41'-30''$ RT. (NOT $\frac{1}{2}$ R/W)
 $D = 0^{\circ}-04'$
 $R = 85943.70'$
 $T = 518.75'$
 $L = 1037.50'$
 $E = 1.57$
 $P.I. = 352+69.18$
 $P.C. = 347+50.48$
 $P.T. = 357+87.93$

P.T.

357+87.93


Fd. P.K. $1\frac{1}{2}$ " below surface $\frac{1}{2}$ '
1' N of $\frac{1}{2}$ of pavement.

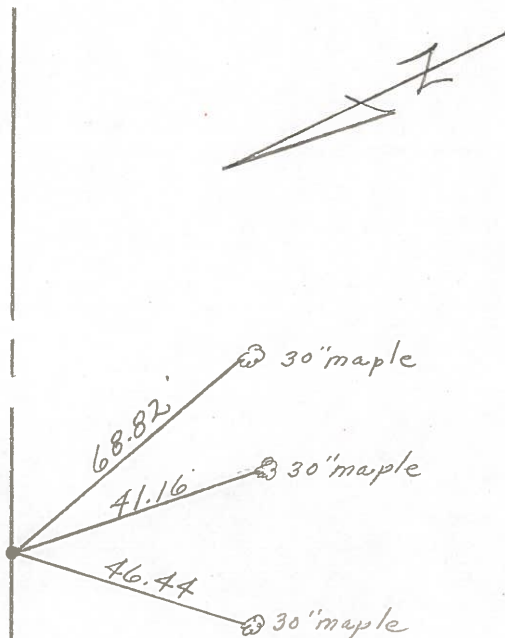

$\frac{1}{2}$ Survey U.S. # 20


PERSONNEL	TITLE	PERSONNEL	TITLE	COUNTY	DATE
Tomisic		Ganlarz		WOOD	Aug. 15, 1977
Neuser				S.-R. U.S. 20	Rechecked - Dec-2
Vanyo					WEATHER
Granata				SEC.	TEMP.

DESCRIPTION REF. Control Pts. LEFT CENTER LINE RIGHT JOB NO.

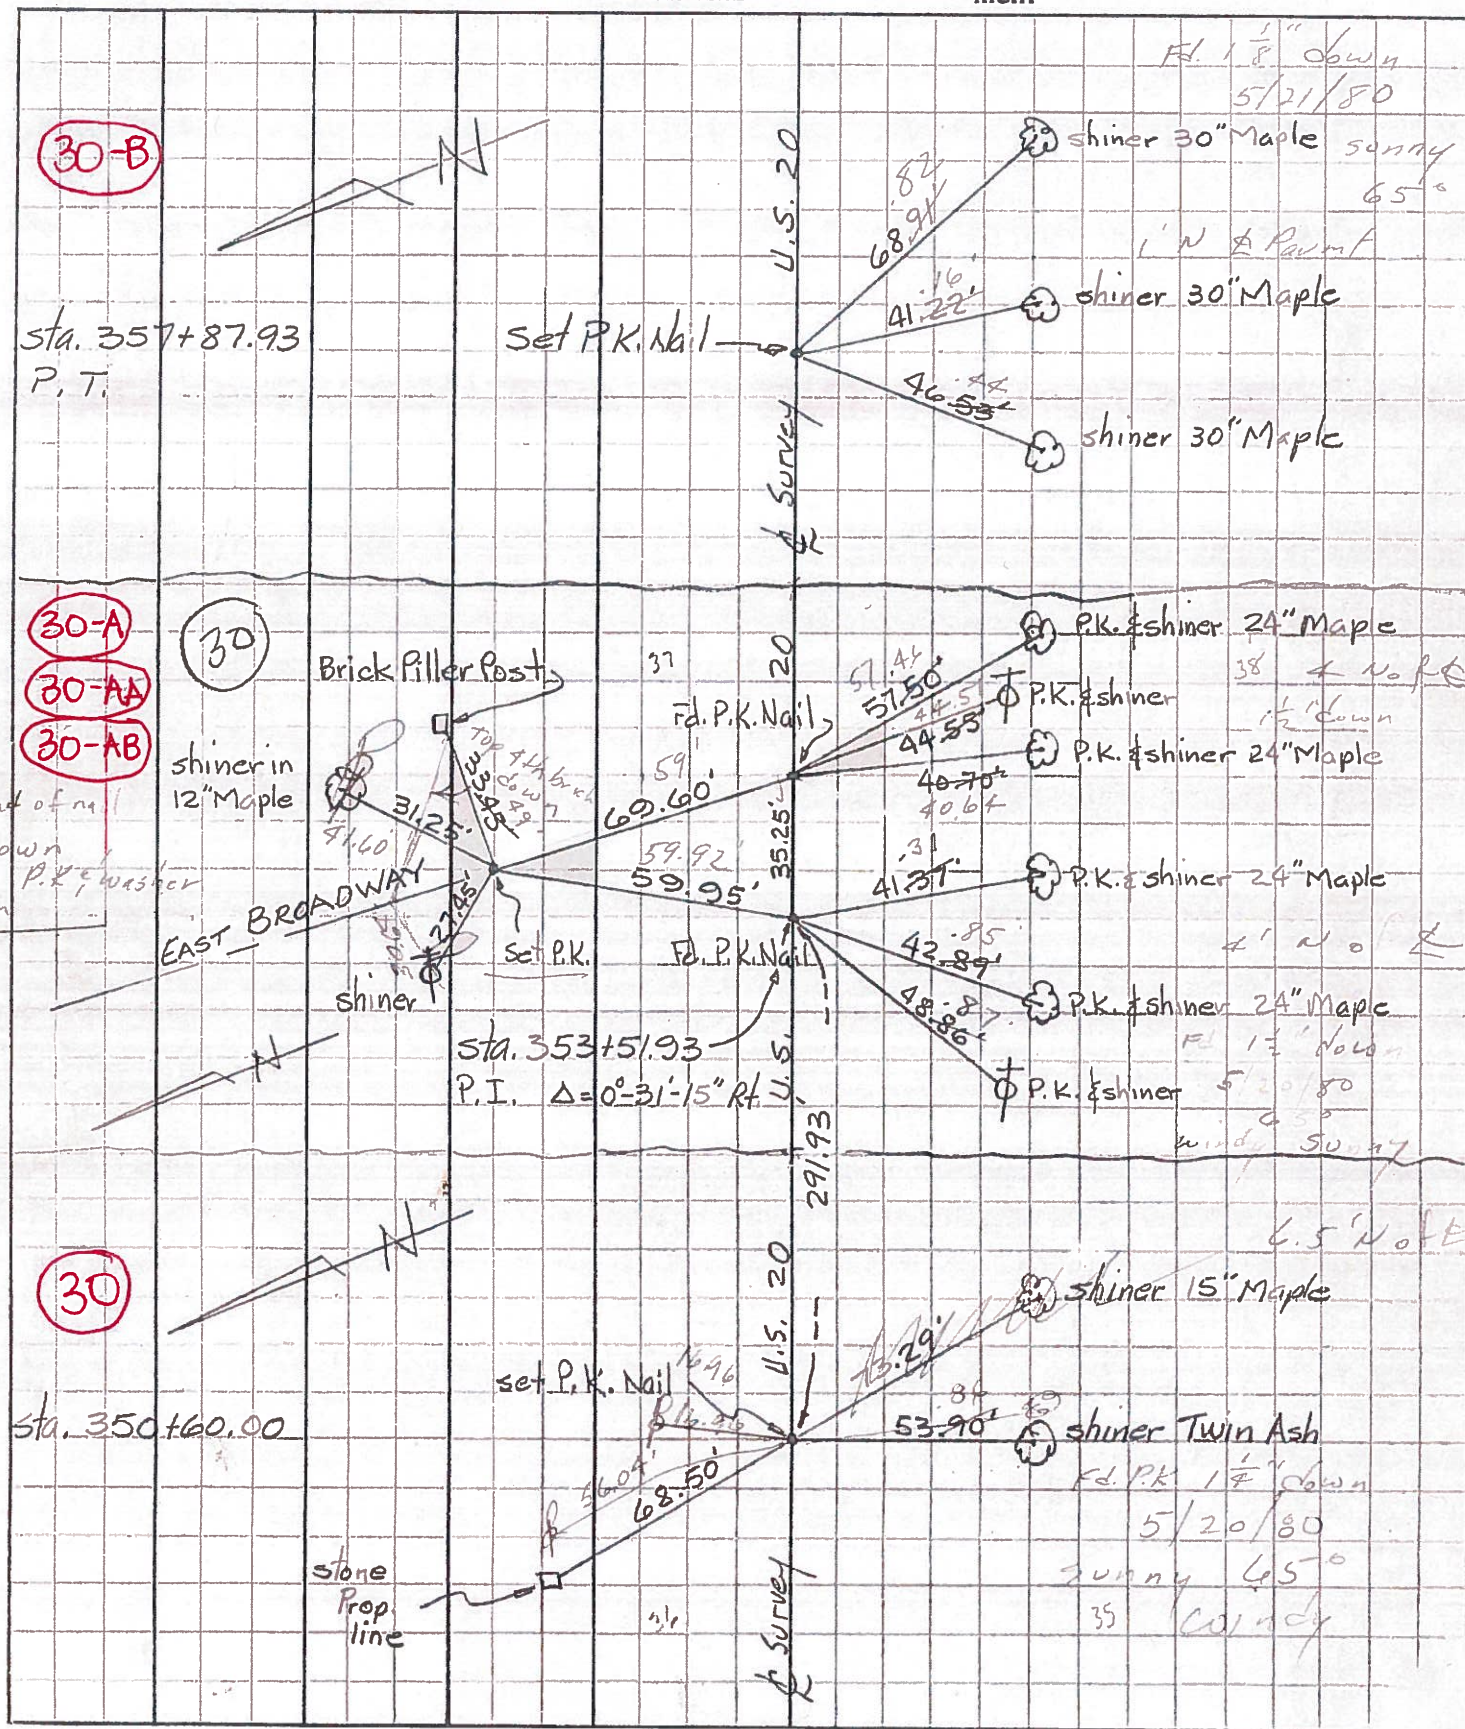

PERSONNEL	TITLE	PERSONNEL	TITLE	COUNTY	Wood	DATE	Aug. 15, 1972
Tomsic		Gancarz		S. R.	U.S. 20	Rechecked	Dec-23
Neuser				SEC.		WEATHER	
Vanyo						TEMP.	
Granata							

DESCRIPTION REF. Control Pts. LEFT CENTER LINE RIGHT JOB NO.

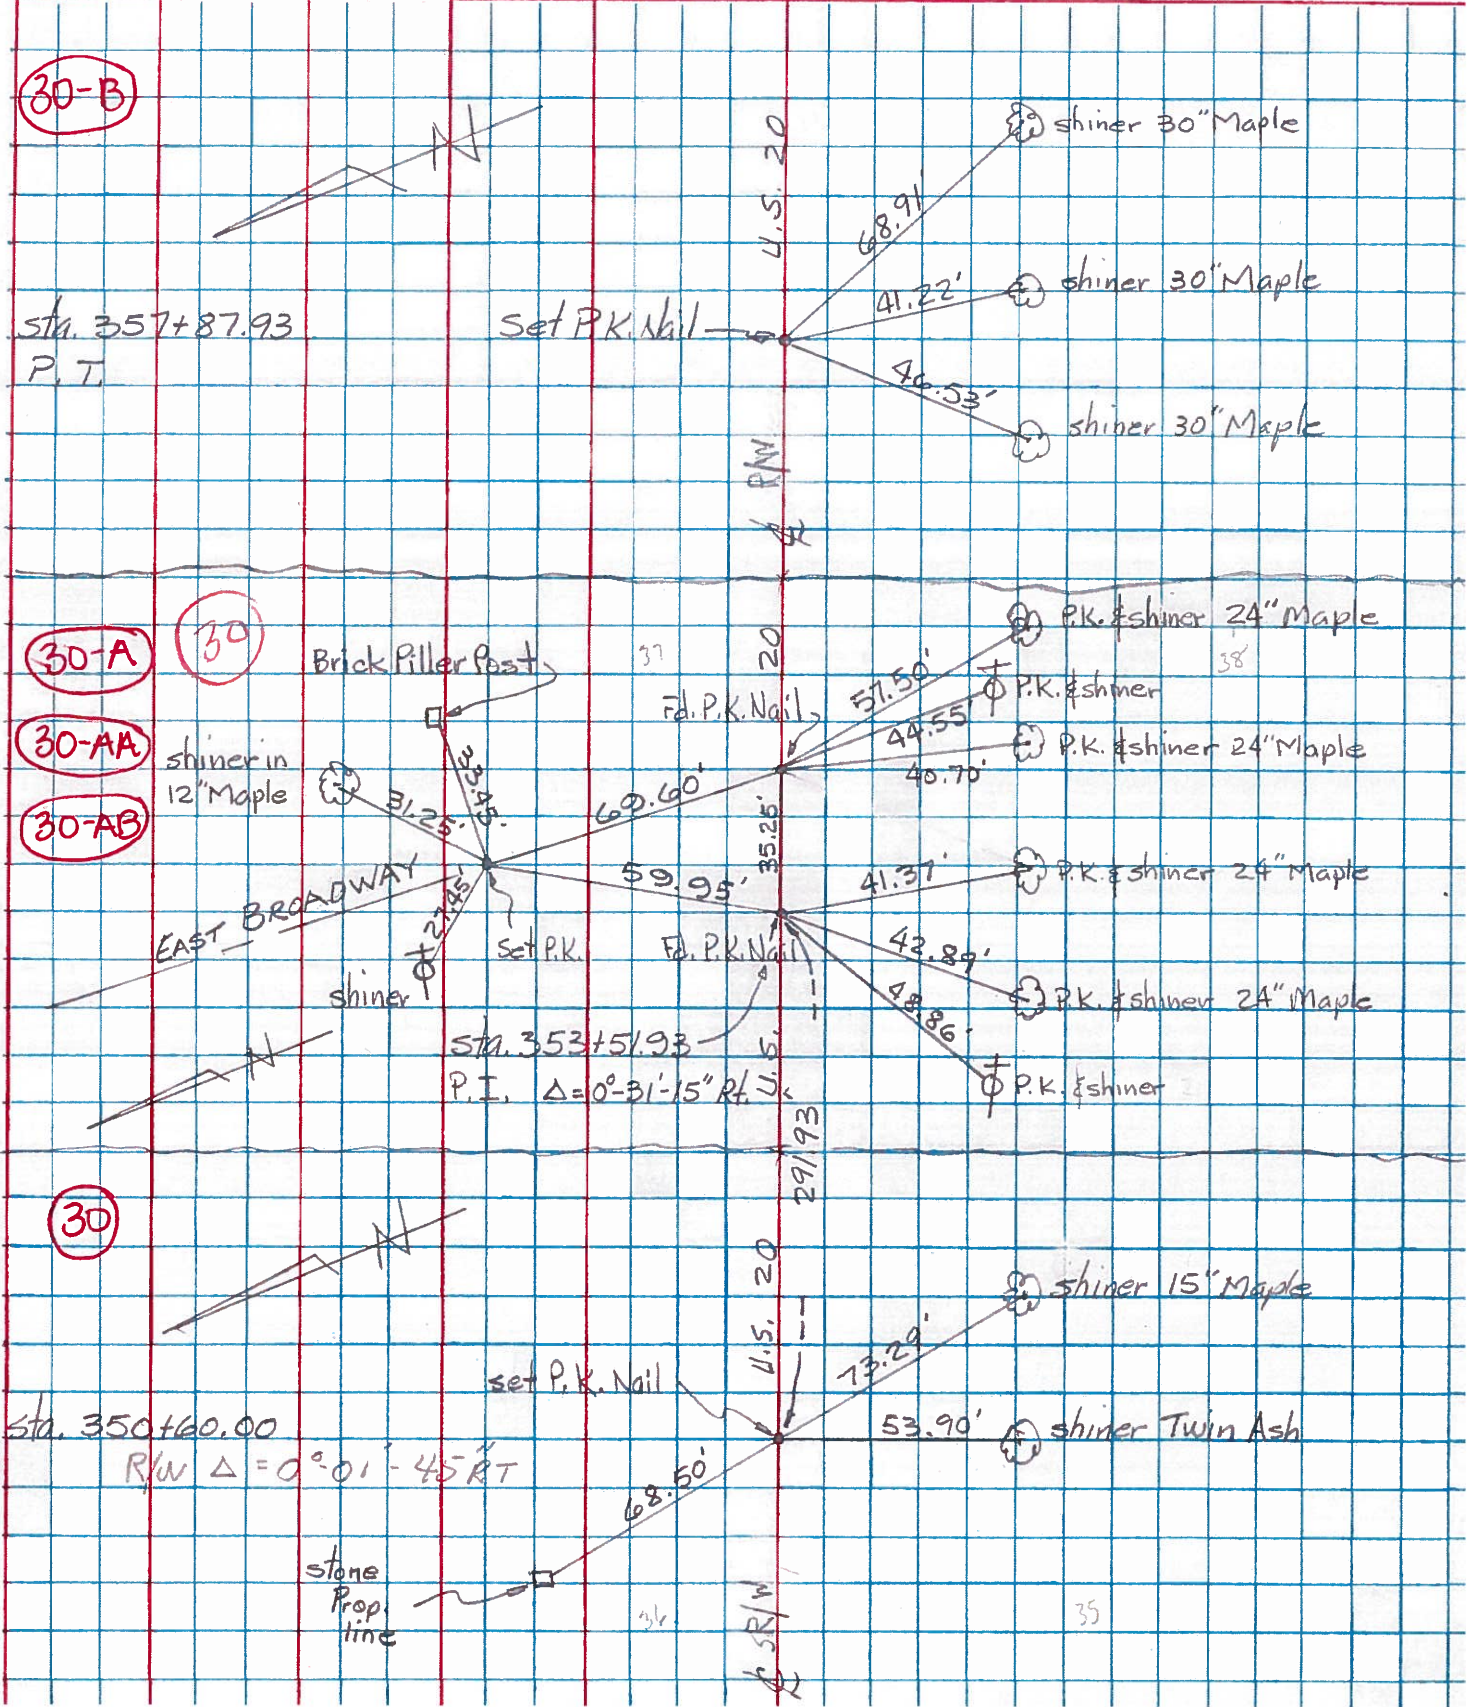


PERSONNEL TITLE PERSONNEL TITLE

COUNTY Wood DATE 3-20-53

S. R. 11.5 #20 WEATHER

SEC. TEMP.

DESCRIPTION Stony Ridge LEFT CENTER LINE RIGHT JOB NO.

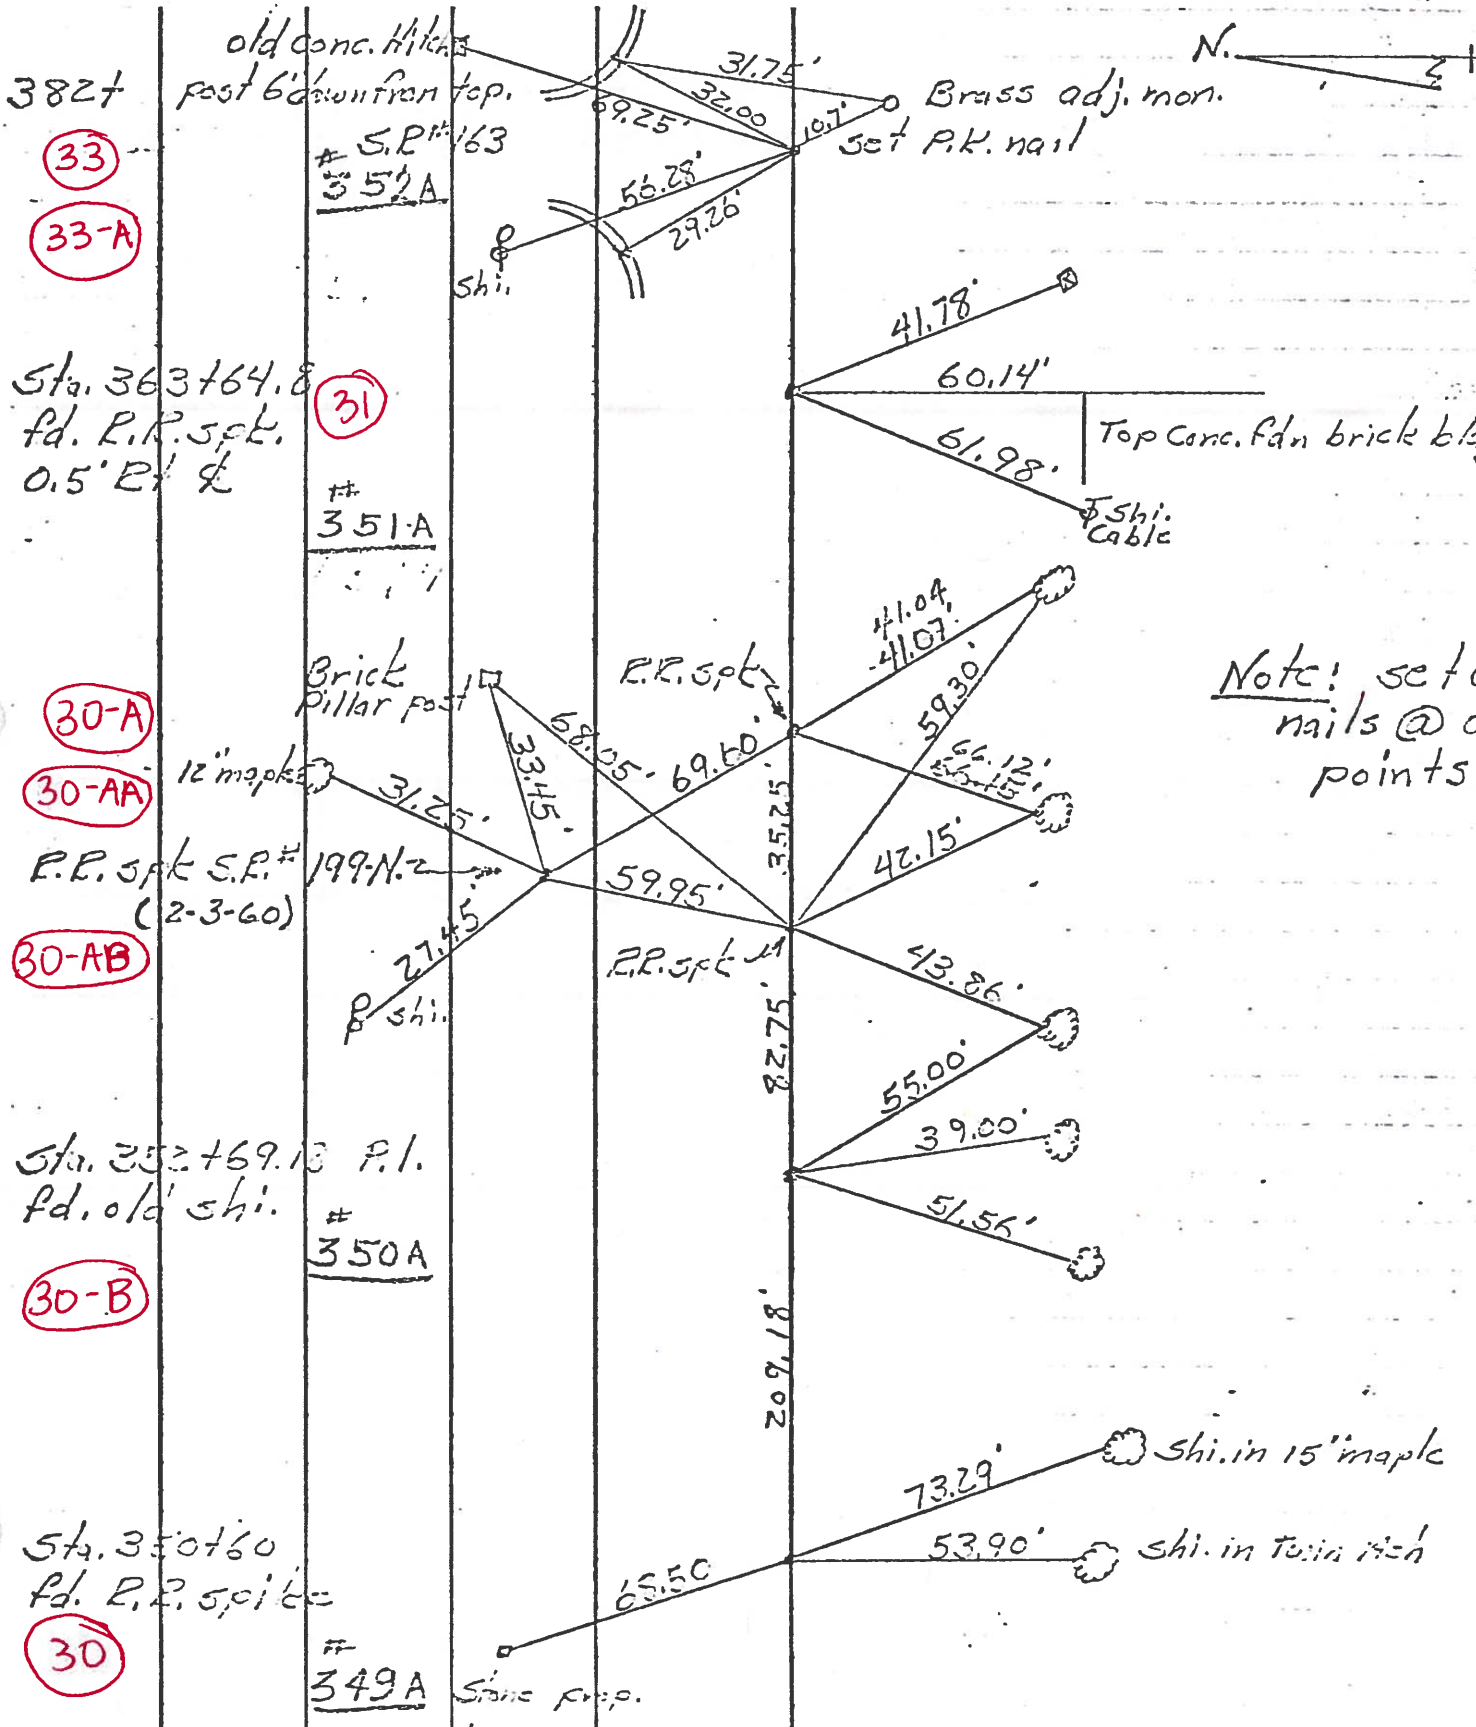

Note: set c nails @ a points