



O.D.O.T. DISTRICT 2 SURVEY OFFICE (USE ONLY)

PERSONNEL _____ REFERENCE NO. 31 SHEET 13 OF 23
 NOTES LEU DATE 8/9/16 ROUTE US 20
 H.C. HOMAN WEATHER CLEAR COUNTY WOOD
 R.C. LEU TEMP. 85° TOWNSHIP TROY
 _____ SECTION RT 37
 _____ T 6 N R 12 E

TYPE MONUMENT MAG/WASHER
 ON SURFACE - ~~BELOW~~ ON
 LEFT - ℄ PAV'T - ~~RIGHT~~ 2.3'
9.8' TO LT EDGE PAVEMENT
 S.L.M. 449+74
 GRID: NORTHING: 673235.109 EASTING: 1692490.407

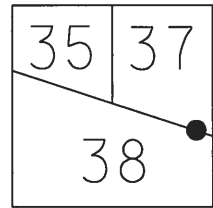


RECORD: P.I.
 STA 363+64.83
 $\Delta = 0^\circ 12' 45''$ RT
 R/W LINE
 SET MAG/WASHER
 3/4/04, MB
 FD MAG/WASHER
 REF31
 8/9/16, DCH
 SET MAG/WASHER
 5/7/18, JFO

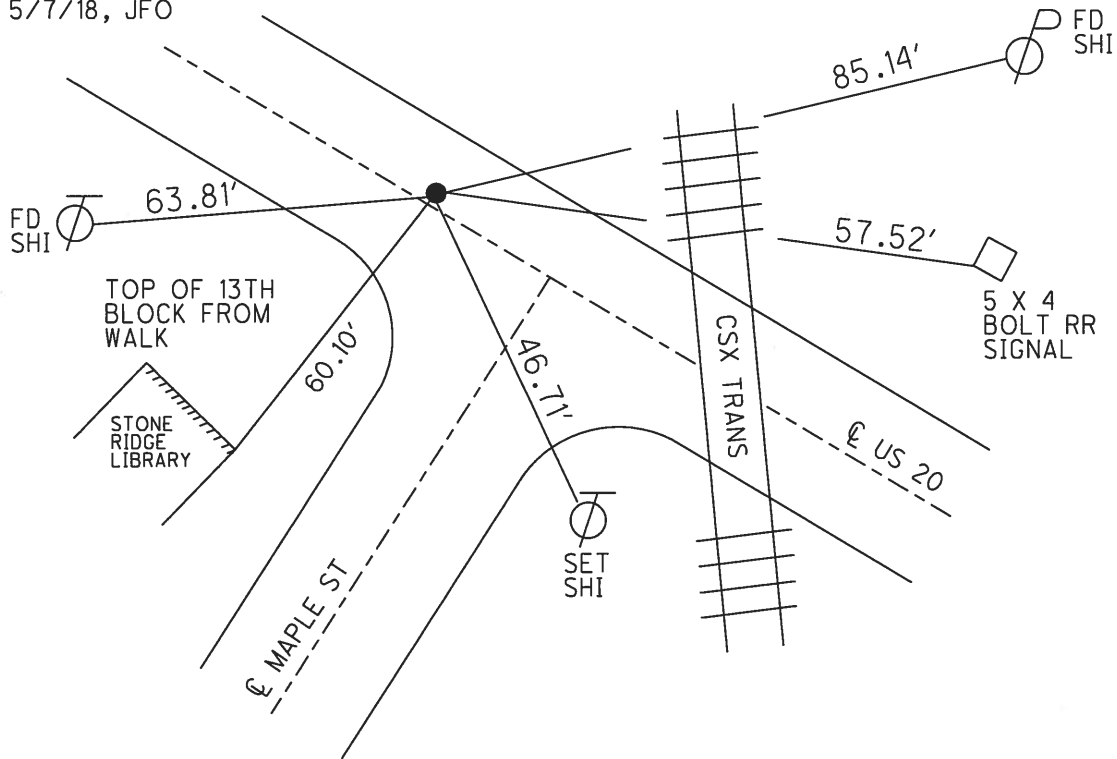


O.D.O.T. DISTRICT 2 SURVEY OFFICE (USE ONLY)

PERSONNEL _____ REFERENCE NO. 31 SHEET 13 OF 19
 NOTES MICHALAK _____ DATE 6/25/02 ROUTE US 20
 H.C. MOSER _____ WEATHER CLEAR COUNTY WOOD
 R.C. SIEFRING _____ TEMP. 95° TOWNSHIP TROY
 _____ BEAUMONT _____ SECTION RT 37
 _____ T 6 N R 12 E

TYPE MONUMENT _____ SM R.R. SPIKE _____
 ON SURFACE - ~~BELOW~~ _____ ON _____
 LEFT - Q PAV'T - ~~RIGHT~~ 2.3' _____
9.8' TO LT EDGE PAVEMENT _____
 S.L.M. _____ 449+74 _____
 GRID: NORTHING: _____ EASTING: _____

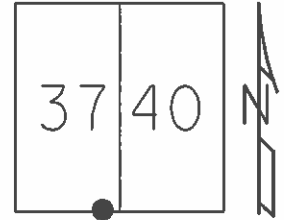

RECORD: P.I.
 STA 363+64.83
 $\Delta = 0^\circ 12' 45''$ RT
 R/W LINE
 SET MAG/WASHER
 3/4/04, MB

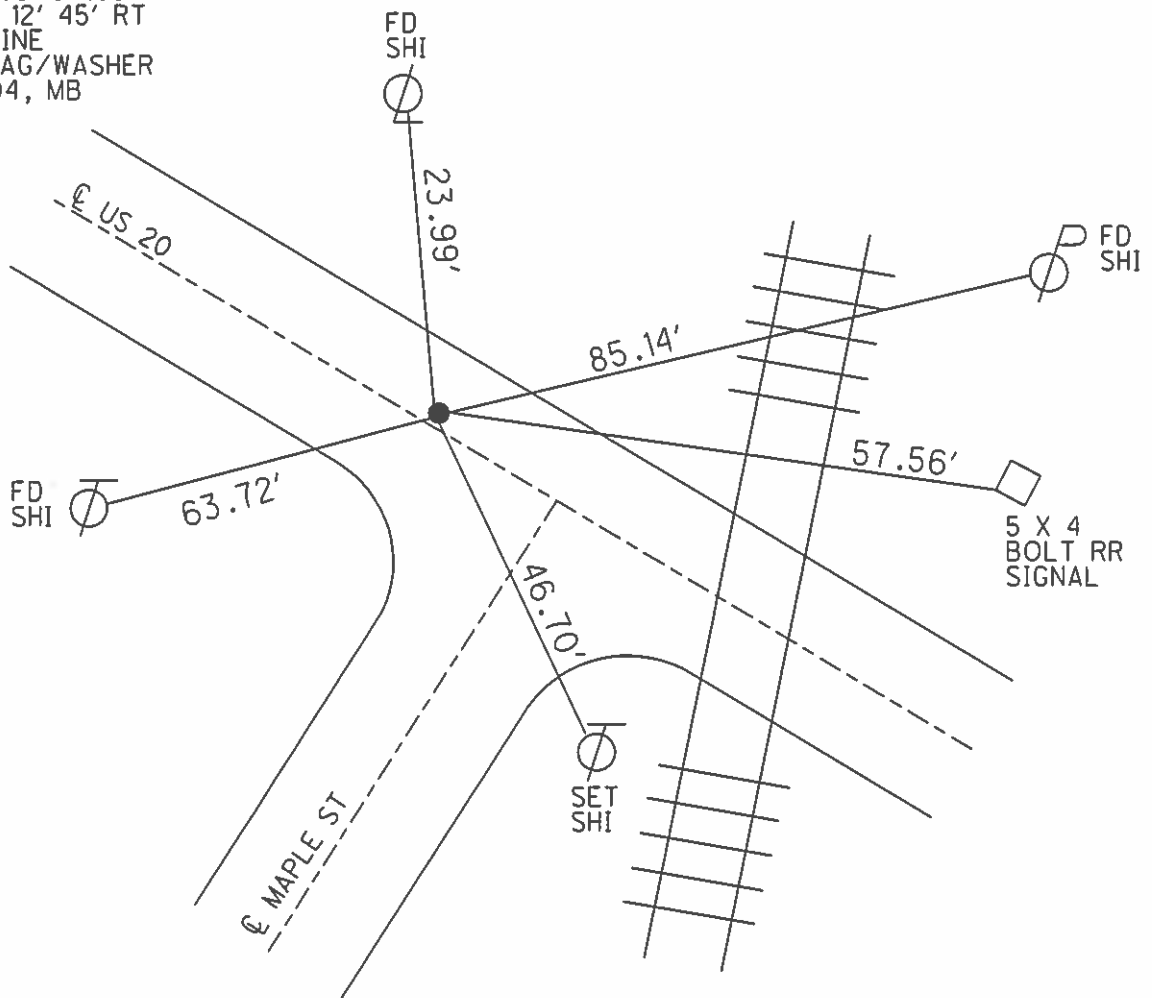

O.D.O.T. DISTRICT 2 SURVEY OFFICE

PERSONNEL

REFERENCE NO. 31

SHEET 14 OF 19

NOTES LOEHRKE

H.C. CURTIS

R.C. ROMERO

DATE 5-13-92

WEATHER Pt Cloudy

TEMP. +70

ROUTE U.S. 20

COUNTY WOOD

TOWNSHIP TROY

SECTION R.T. 37

T. 6 N. R. 12 E


TYPE MONUMENT Sm. R.R. Spike Pt. Exposed

ON SURFACE - ~~BELOW~~ Yes 6-29-93


LEFT - ~~C~~ PAV'T. - RIGHT 20 1/2" Deep

10.4 TO Lt EDGE PAVEMENT

S.L.M. 449+74

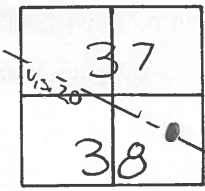

P.I. Sta 363+64.83
 $\Delta = 0^{\circ} - 12' - 45''$ Rt - R/W LINE

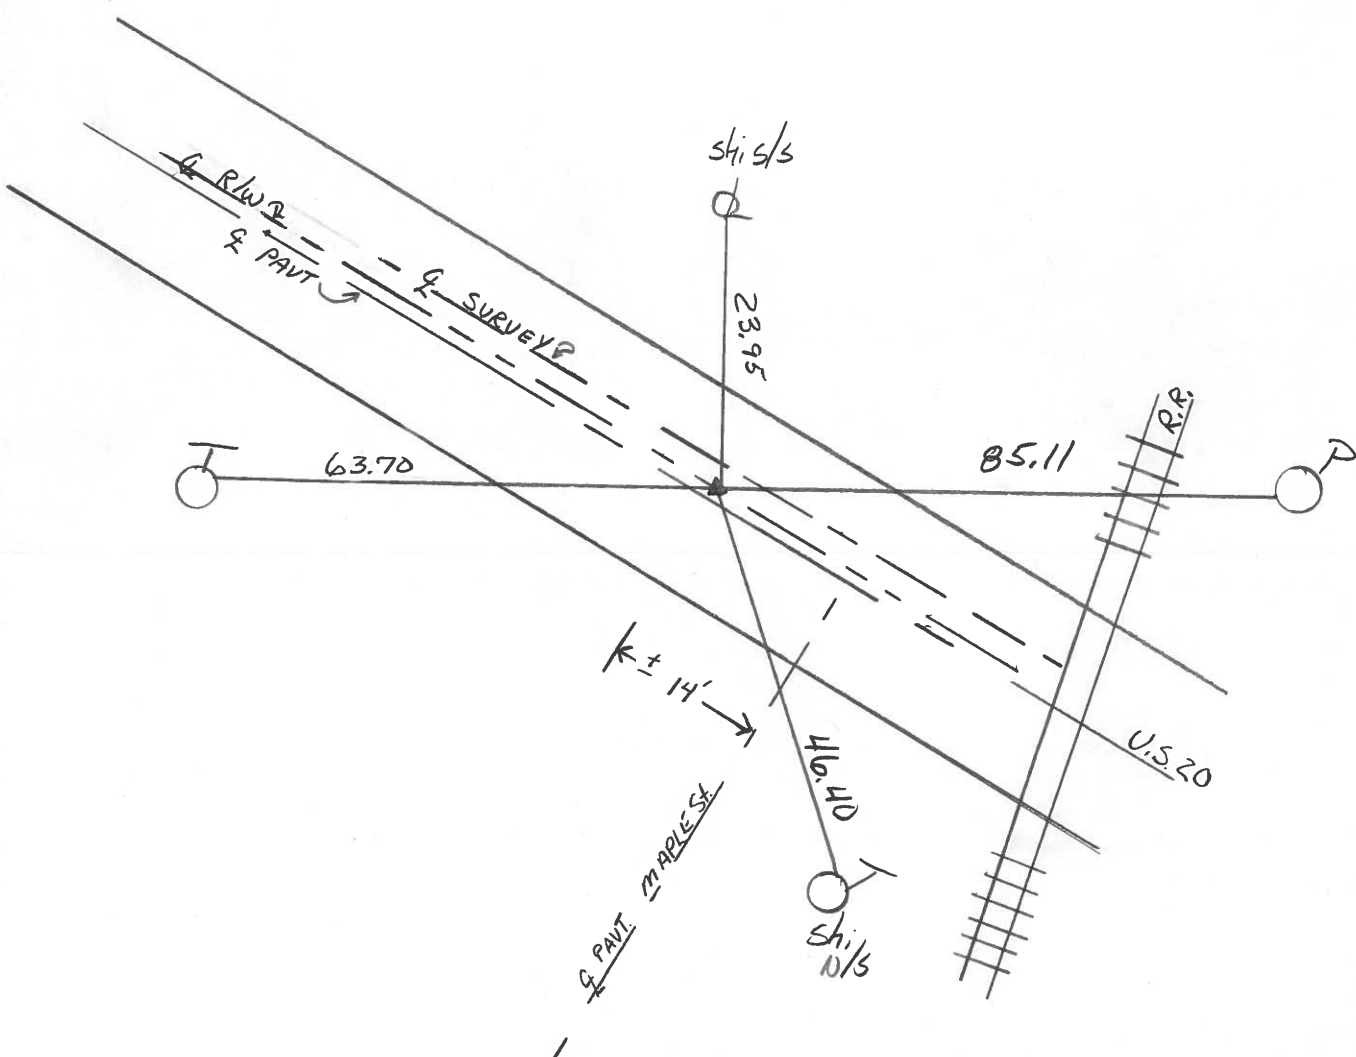

County WOOD S.R. U.S. 20

Township TROY

Section R.T. 37

T6N, R12E

Personnel HOFFMAN

HOUSEHOLDER

LOEHRKE

BARNHISEL

Date 9-9-82


Weather CLEAR

Temp. +65°

R.T. 37	R.T. 40
R.T. 38	R.T. 39



#31

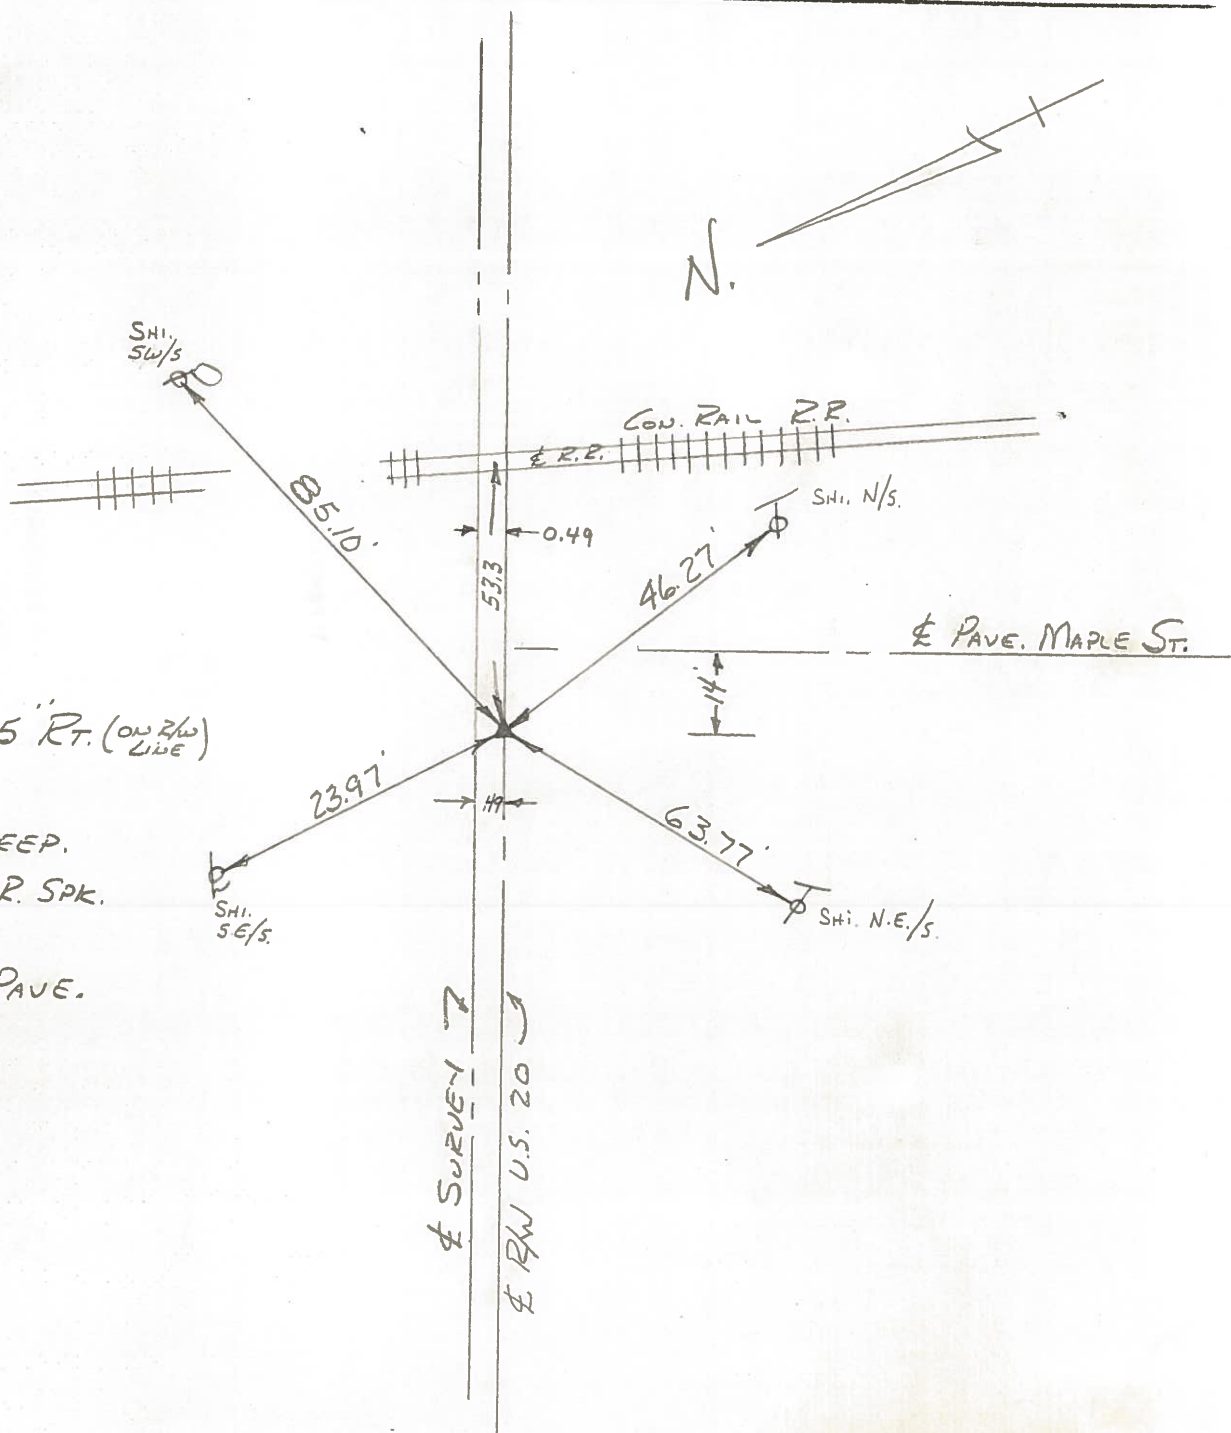

P.I.
 $\Delta = 00^{\circ}12'45''$ RT. (ON RW LINE)
 363+64.83
 FD. P.K. 4" DEEP.
 SET SMALL R.R. SPK.
 ON SURFACE.
 1.8' LT. OF $\&$ PAVE.

County Wood S.R. U.S. #20

Date 5/21/80 Drawn 5/27/80

Township Troy

Weather sunny

Section R.T. 37

Temp. 65°

T&N, RIZE

Personnel CRONIN

RIPPLE

GEYMAN

MOSSER

BARBOUR


R.T. 37	R.T. 40
R.T. 38	R.T. 39



31

1942 ROAD ENDS NO. 216 LE
AT THIS POINT


P.I
 $\Delta = 00^{\circ} 12' 45''$ Rt on R/W LINE
363+64.83
 Ed. P.K $1\frac{1}{2}$ " below surface
1.5' N of E of pavement

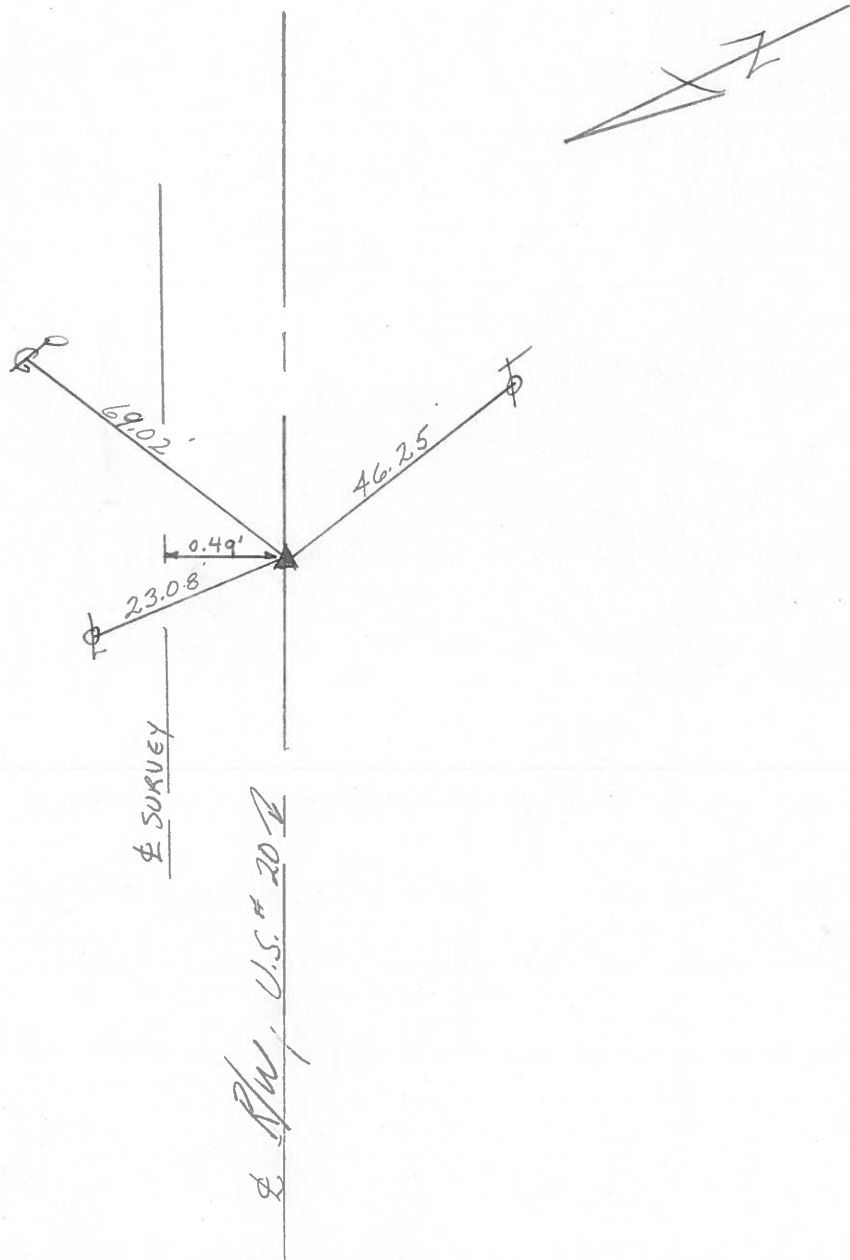

PERSONNEL	TITLE	PERSONNEL	TITLE
Tomsic			
Neuser			
Vanyo			
Granata			


COUNTY WOOD DATE AUG 17, 1972
 S. R. U.S. 20 Rechecked - Dec-23-7
 WEATHER _____
 SEC. _____ TEMP. _____

DESCRIPTION REF. CONTROL Pts. JOB NO. _____

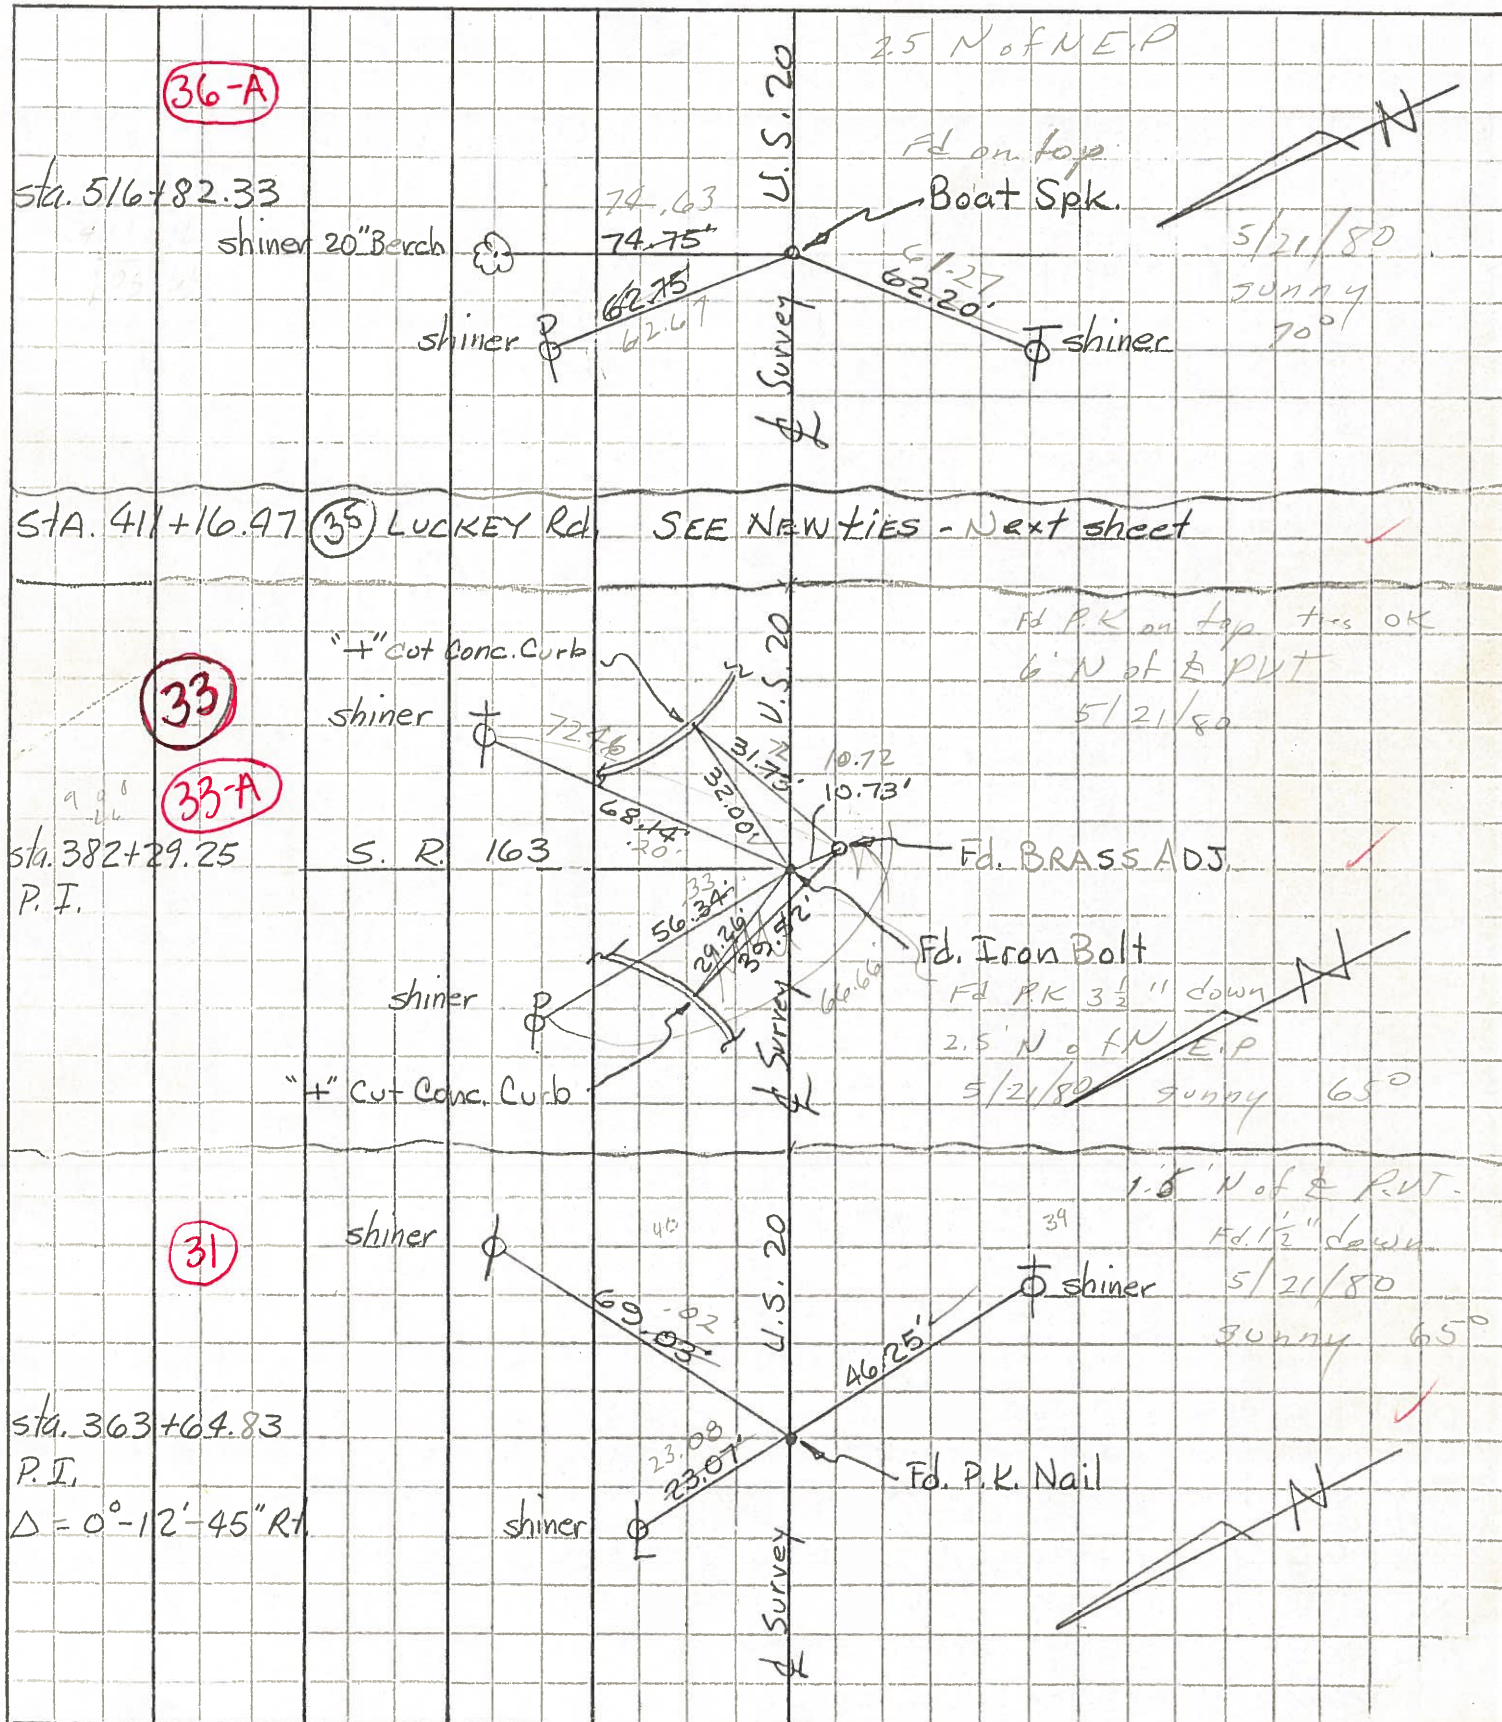

PERSONNEL	TITLE	PERSONNEL	TITLE	COUNTY	DATE
Tomsic				Wood	AUG 17, 1972
Neuser					Rechecked - Dec-23-72
Vanyo				S. R. U.S. 20	WEATHER
Granata				SEC.	TEMP.

DESCRIPTION REF. CONTROL Pts. LEFT CENTER LINE RIGHT JOB NO.

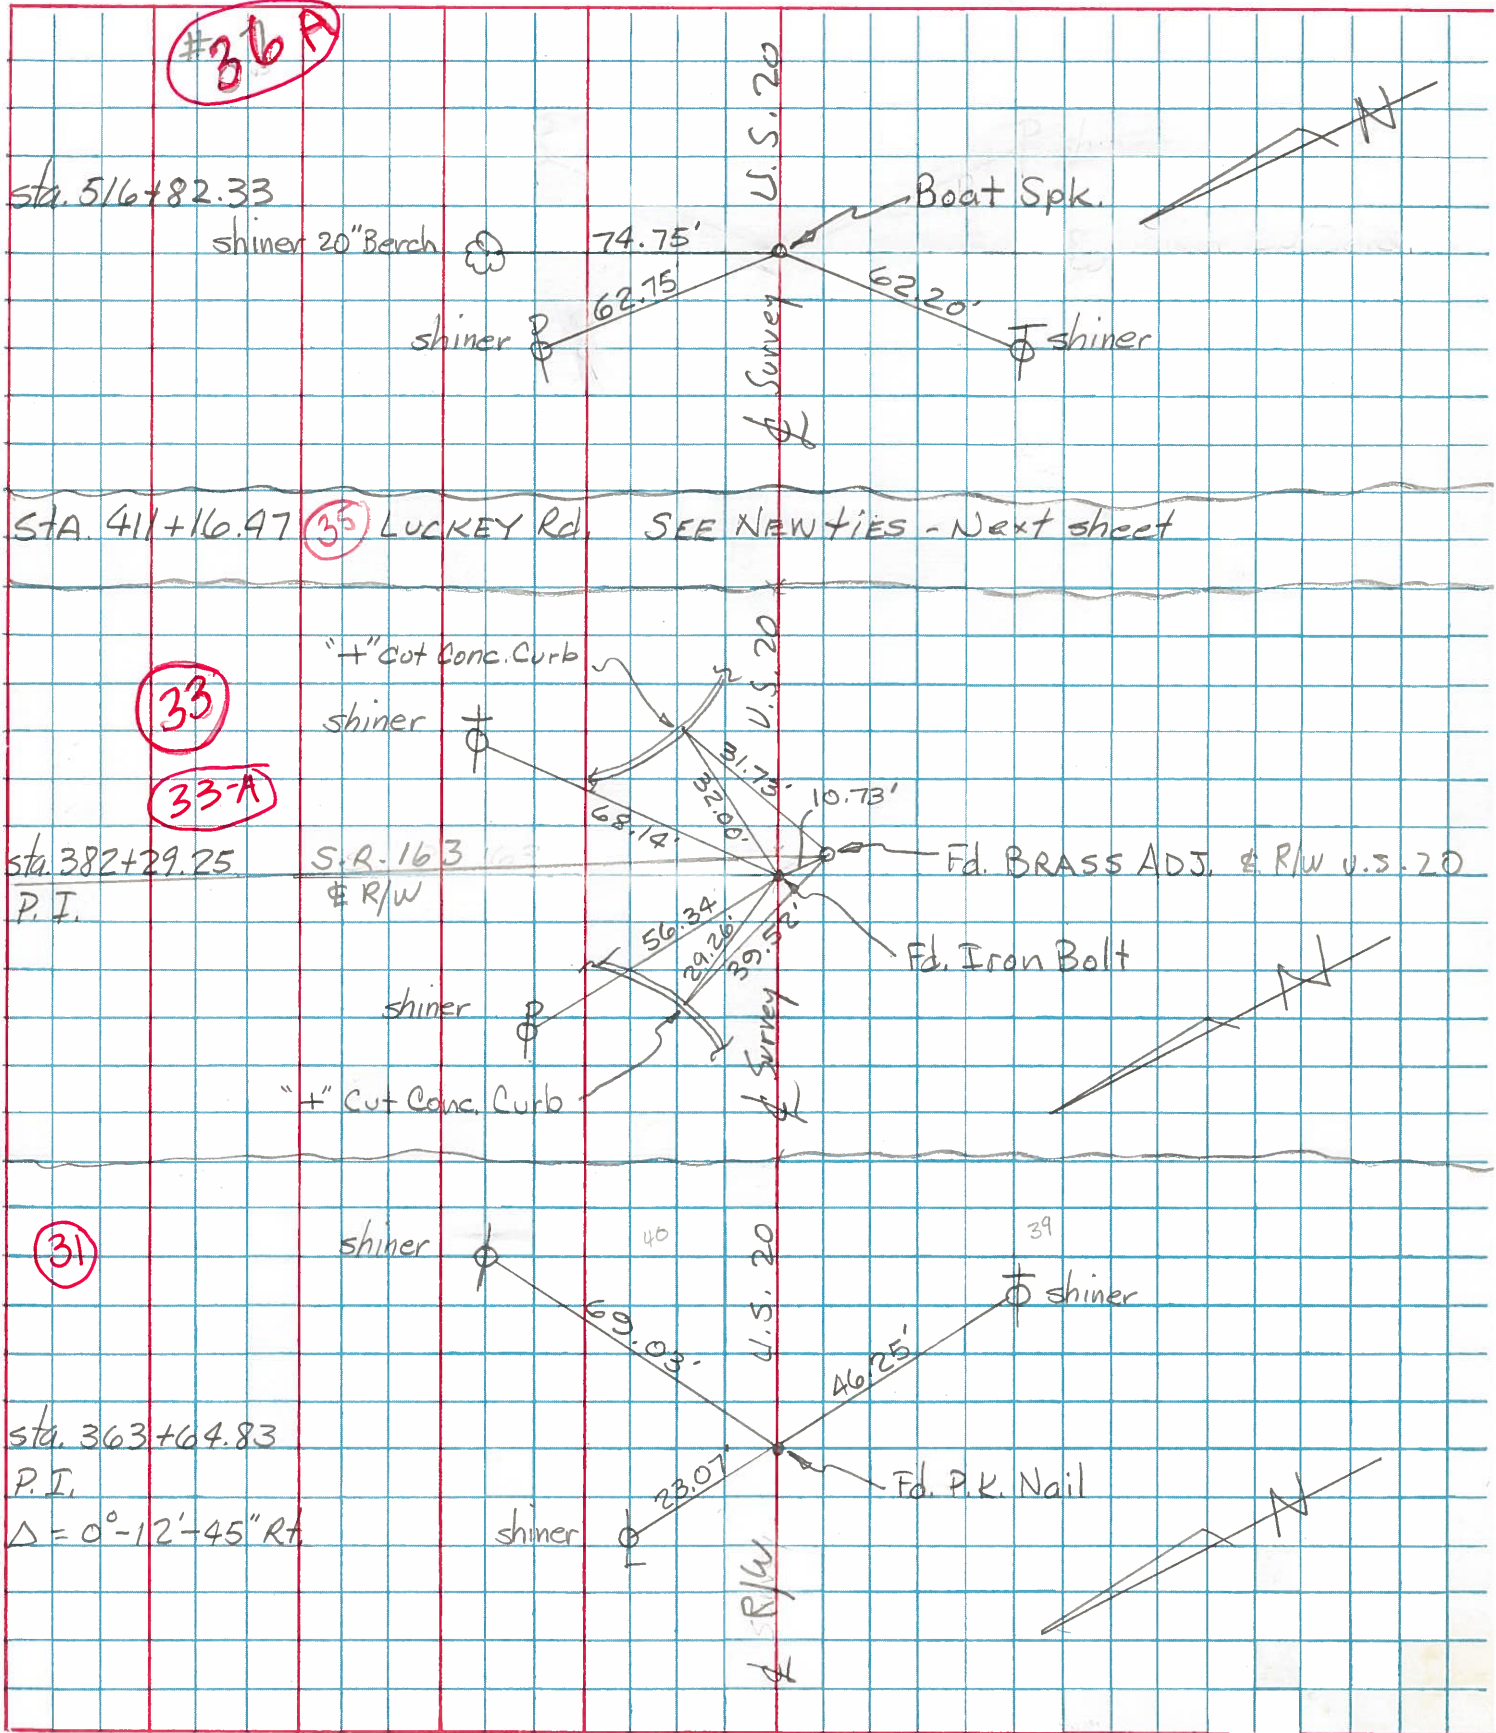


PERSONNEL TITLE PERSONNEL TITLE

COUNTY Wood DATE 3-20-53

S. R. 11.5#20 WEATHER

SEC. TEMP.

DESCRIPTION Stony Ridge JOB NO.

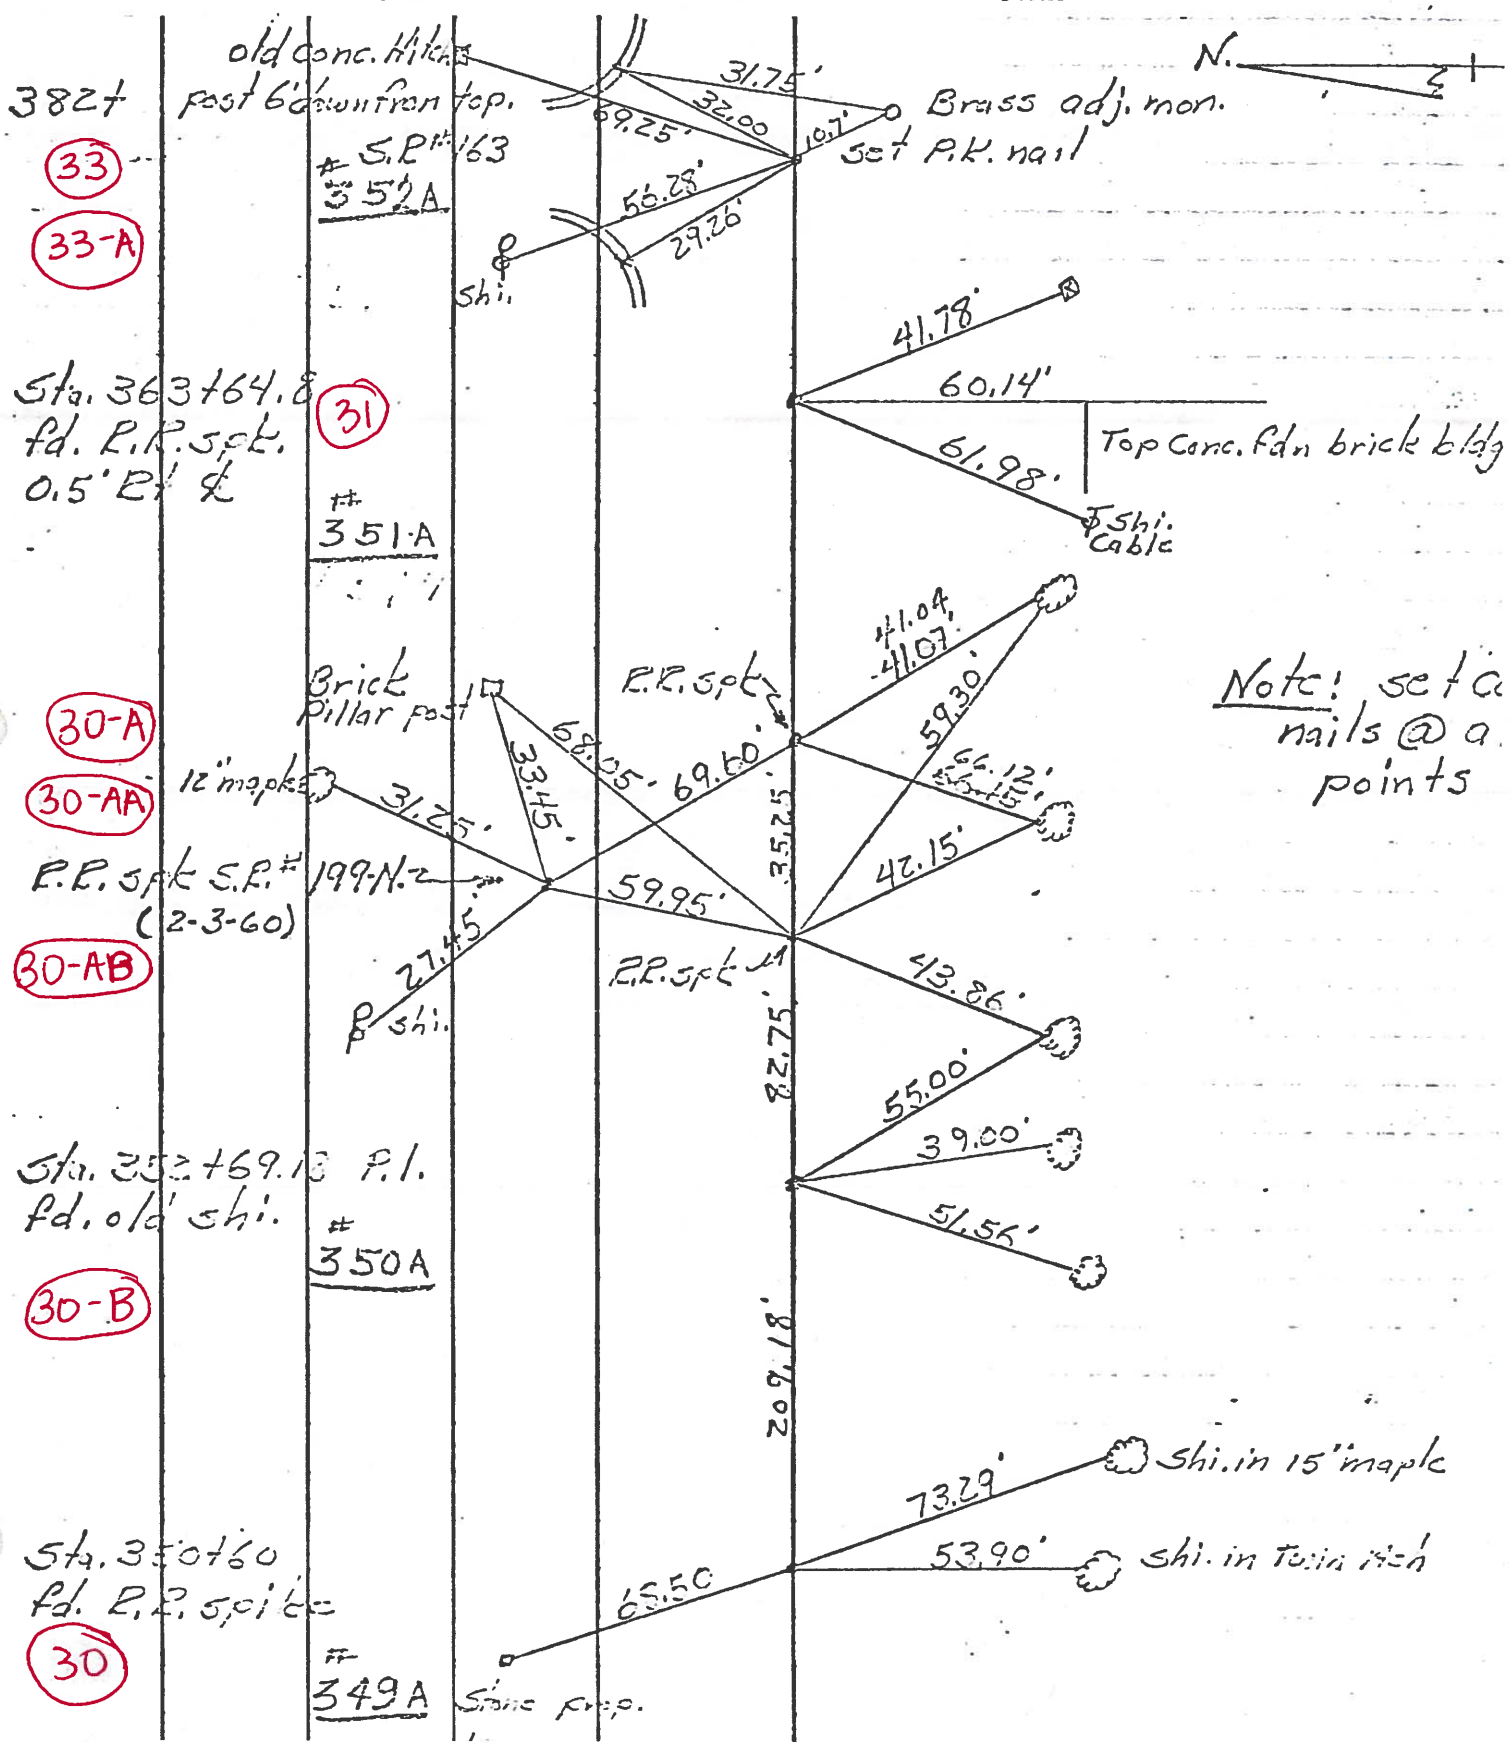

Note! set a nails @ a. points