
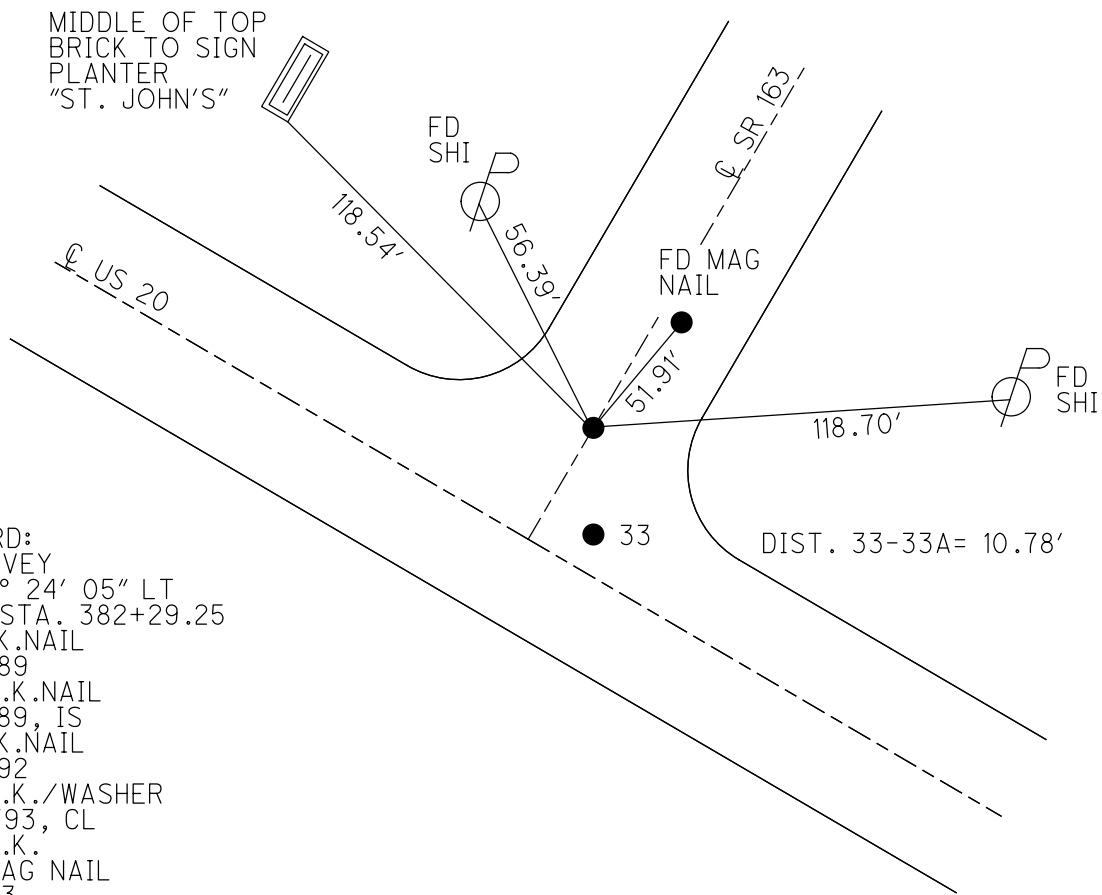


O.D.O.T. DISTRICT 2 SURVEY OFFICE (USE ONLY)

PERSONNEL \_\_\_\_\_ REFERENCE NO. 33 A SHEET 15 OF 23  
 NOTES LEU DATE 8-9-16 ROUTE US 20  
 H.C. HOMAN WEATHER SUNNY COUNTY WOOD  
 R.C. LEU TEMP. 70° TOWNSHIP TROY  
 SECTION RT 41  
 T 6 N R 12 E

TYPE MONUMENT FD. MAG/WASHER  
 ON SURFACE - ~~BELOW~~ ON  
 LEFT - ☉ PAV'T - RIGHT -  
- TO - EDGE PAVEMENT  
 S.L.M. 468+00 ±  
 Grid: Northing: 672291.0334 Easting: 1694090.047

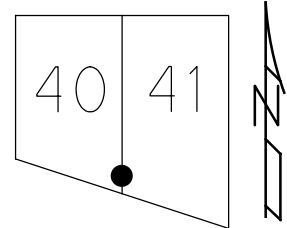


RECORD:  
 ☉ SURVEY  
 $\Delta = 0^\circ 24' 05''$  LT  
 PLAN STA. 382+29.25  
 FD P.K.NAIL  
 5/16/89  
 SET P.K.NAIL  
 7/31/89, IS  
 FD P.K.NAIL  
 5/13/92  
 SET P.K./WASHER  
 6/29/93, CL  
 DNF P.K.  
 SET MAG NAIL  
 REFB33  
 8/1/13, SDC  
 SET MAG/WASHER  
 NEWREFB33  
 8/21/14, EBW  
 SET MAG/WASHER  
 6/17/19, JFO


O.D.O.T. DISTRICT 2 SURVEY OFFICE (USE ONLY)

PERSONNEL \_\_\_\_\_ REFERENCE NO. 33 A SHEET 15 OF 23  
 NOTES LEU DATE 8-9-16 ROUTE US 20  
 H.C. HOMAN WEATHER SUNNY COUNTY WOOD  
 R.C. LEU TEMP. 70° TOWNSHIP TROY  
 SECTION RT 41  
 T 6 N R 12 E

TYPE MONUMENT FD. MAG/WASHER  
 ON SURFACE - ~~BELOW~~ ON \_\_\_\_\_  
 LEFT - ☉ PAV'T - RIGHT - \_\_\_\_\_  
 - TO - EDGE PAVEMENT  
 S.L.M. 468+00 ±

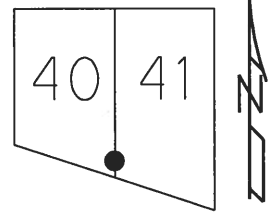

Grid: Northing: 672291.0334 Easting: 1694090.047


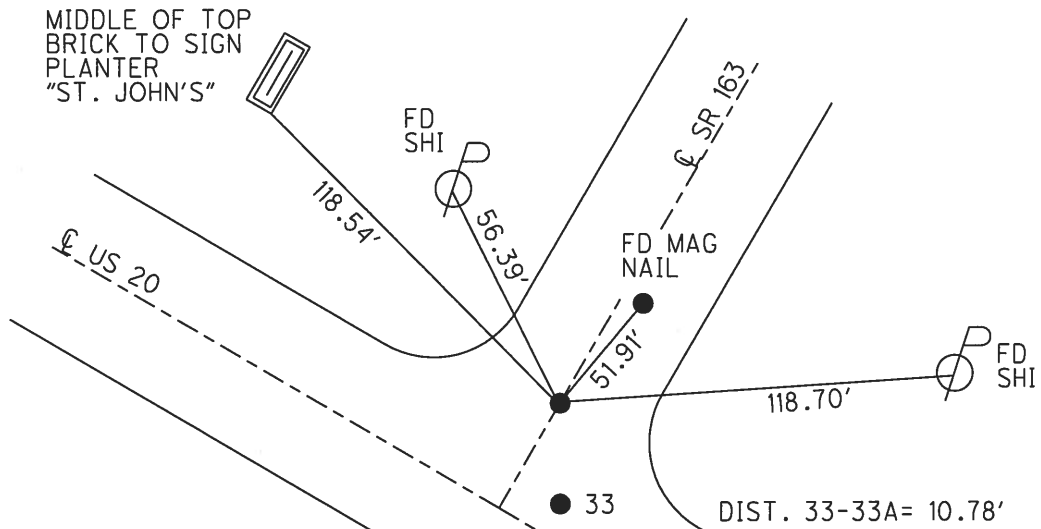


RECORD:  
 ☉ SURVEY  
 Δ = 0° 24' 05" LT  
 PLAN STA. 382+29.25  
 FD P.K.NAIL  
 5/16/89  
 SET P.K.NAIL  
 7/31/89, IS  
 FD P.K.NAIL  
 5/13/92  
 SET P.K./WASHER  
 6/29/93, CL  
 DNF P.K.  
 SET MAG NAIL  
 REFB33  
 8/1/13, SDC  
 SET MAG/WASHER  
 NEWREFB33  
 8/21/14, EBW

O.D.O.T. DISTRICT 2 SURVEY OFFICE (USE ONLY)

PERSONNEL \_\_\_\_\_ REFERENCE NO. 33 A SHEET 15 OF 19  
 NOTES RHOADES DATE 8/1/13 ROUTE US 20  
 H.C. CODER WEATHER CLOUDY COUNTY WOOD  
 R.C. RHOADES TEMP. 80° TOWNSHIP TROY  
 \_\_\_\_\_ SECTION RT 41  
 \_\_\_\_\_ T 6 N R 12 E

TYPE MONUMENT P.K.NAIL  
 ON SURFACE - ~~BELOW~~ ON \_\_\_\_\_  
 LEFT - ☉ PAV'T - RIGHT - \_\_\_\_\_  
 -      TO      EDGE PAVEMENT  
 S.L.M. 468+00 ±  
 Grid: Northing: 672291.008 Easting: 1694090.089

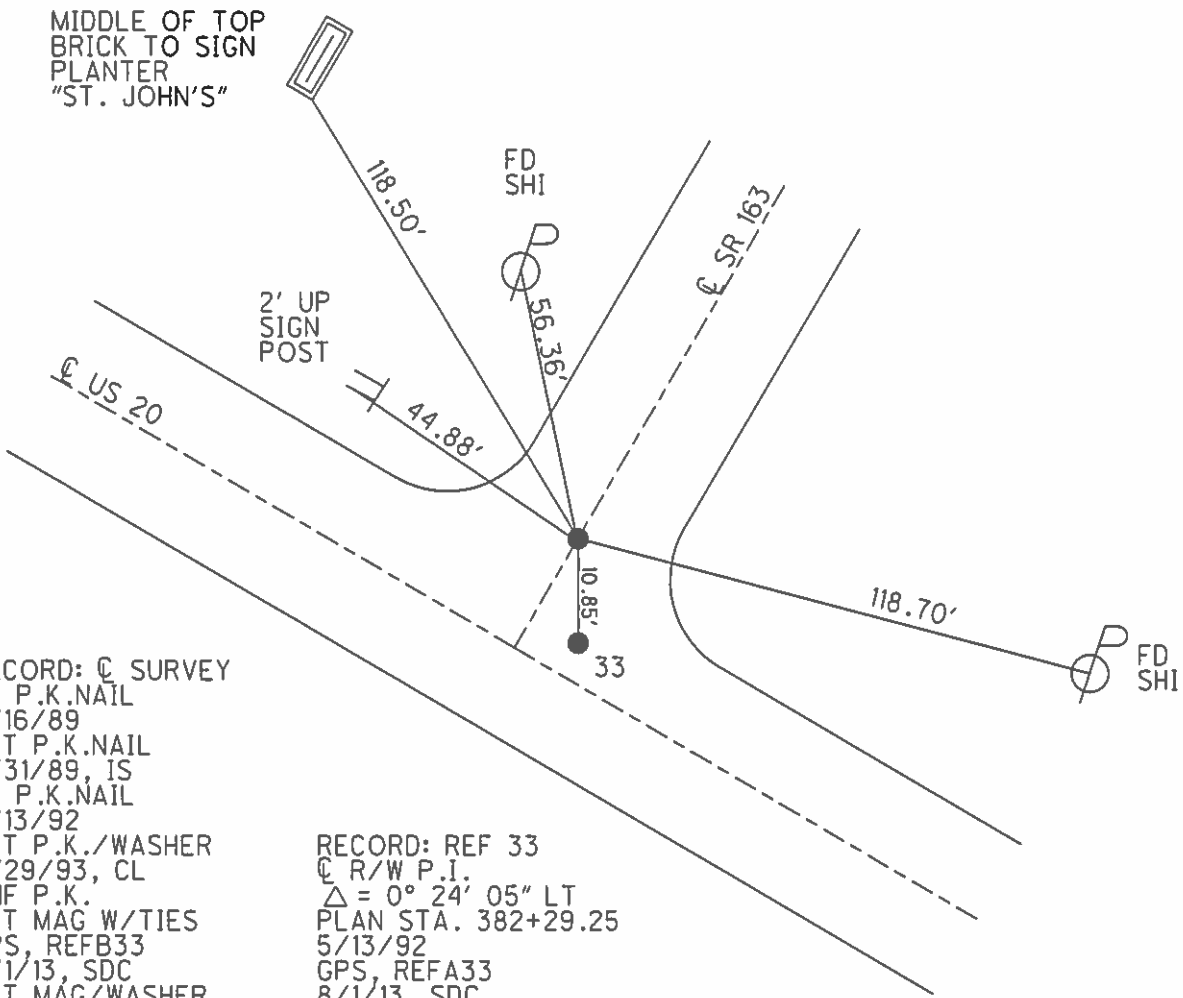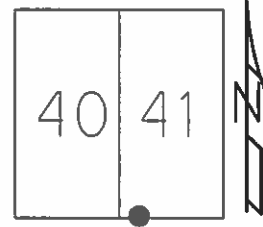

RECORD: ☉ SURVEY  
 FD P.K.NAIL  
 5/16/89  
 SET P.K.NAIL  
 7/31/89, IS  
 FD P.K.NAIL  
 5/13/92  
 SET P.K./WASHER  
 6/29/93, CL  
 DNF P.K.  
 SET MAG W/TIES  
 GPS, REFB33  
 8/1/13, SDC  
 SET MAG/WASHER  
 GPS, NEWREFB33  
 8/21/14, EBW

RECORD: REF 33  
 ☉ R/W P.I.  
 $\Delta = 0^\circ 24' 05''$  LT  
 PLAN STA. 382+29.25  
 5/13/92  
 GPS, REFA33  
 8/1/13, SDC  
 N = 672280.394  
 E = 1694091.589

# O.D.O.T. DISTRICT 2 SURVEY OFFICE

PERSONNEL

REFERENCE NO. 33

SHEET 15 OF 19

NOTES LOEHRKE

H.C. CURTIS

R.G. ROMETO

DATE 5-13-92

WEATHER Pt. Cloudy

TEMP. +70

ROUTE U.S. 20

COUNTY Wood

TOWNSHIP TROY

SECTION R.T. 41

T 6 N R 12 E

Set P.K.'s / WASHERS

TYPE MONUMENT P.K. Nails

6-29-93

ON SURFACE - BELOW Yes

C.L.

LEFT-☉ PAV'T. - RIGHT A = 4.8'

TO EDGE PAVEMENT

S.L.M. 468+38 = Pt A


R.T. 40	R.T. 41
R.T. 39	R.T. 42



Btw - 10.76

Pt. "A" of R/W. P.I.  
 $\Delta = 0^{\circ}24'05''$  - Lt.  
 PLAN Sta 382+29.25


Pt. "B" of SURVEY

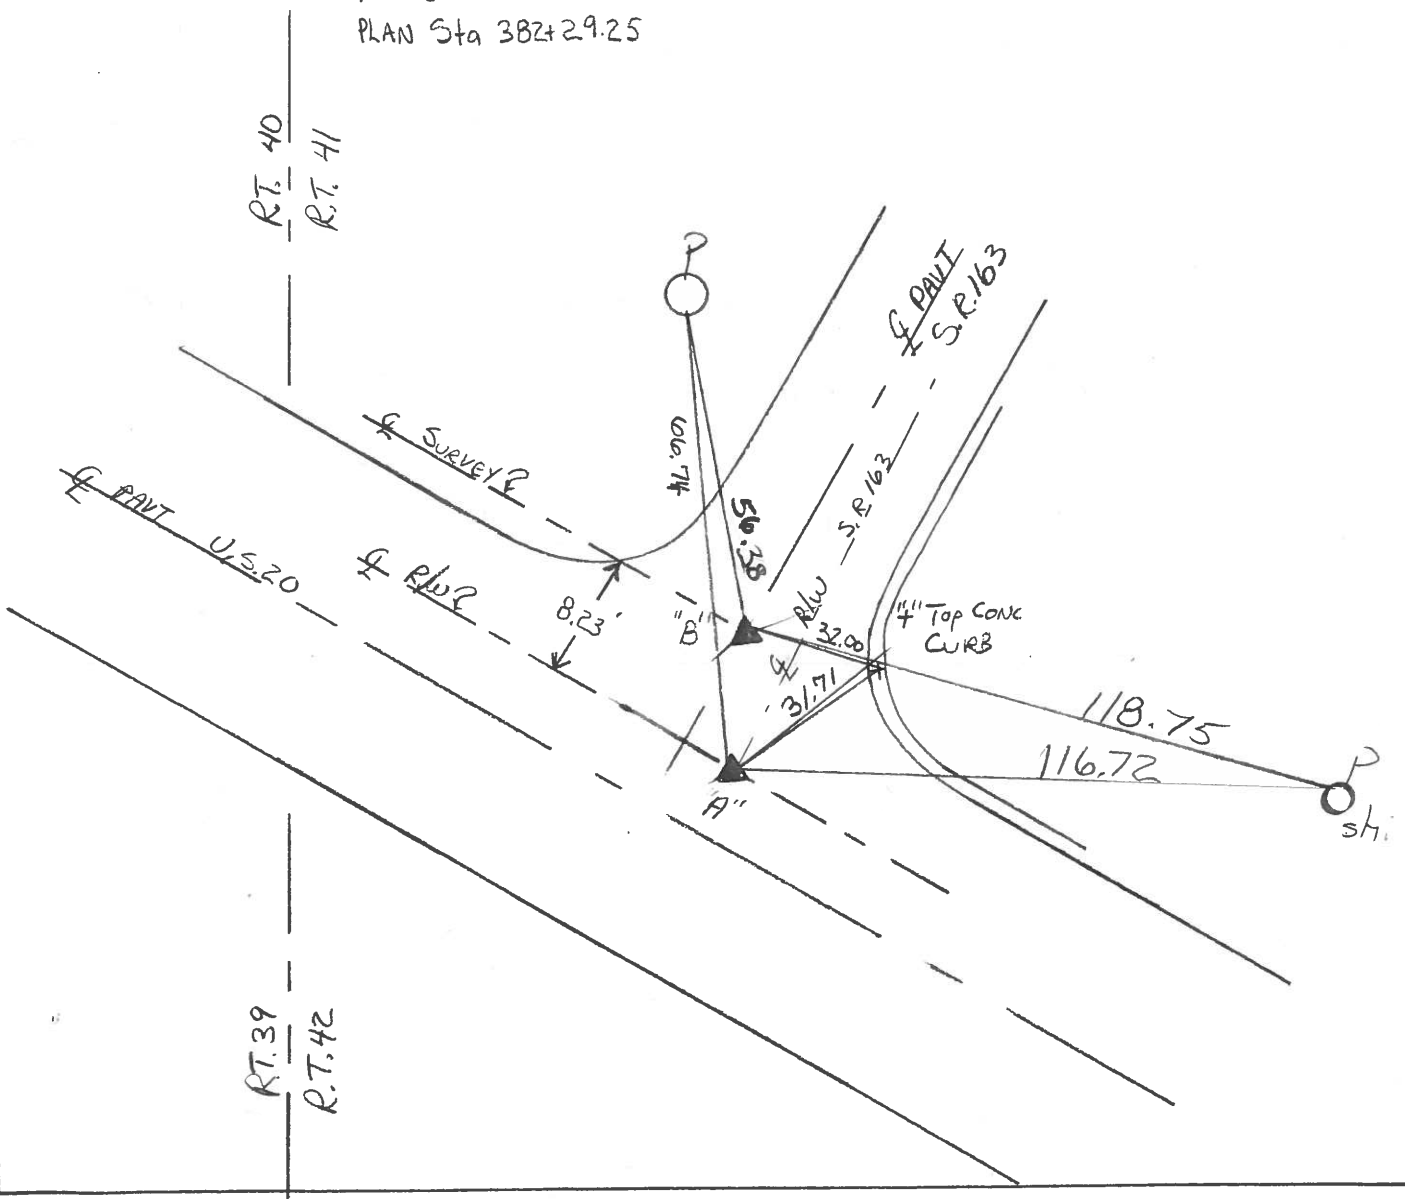

PERSONNEL	TITLE	PERSONNEL	TITLE
Tamasic			
Neuser			
Vanyo			
Granata			

COUNTY Wood DATE Aug 17, 1972  
 S. R. U.S. 20 Rechecked - Dec-23  
 WEATHER \_\_\_\_\_  
 SEC. \_\_\_\_\_ TEMP. \_\_\_\_\_


DESCRIPTION REF. CONTROL Pts. LEFT CENTER LINE RIGHT JOB NO. \_\_\_\_\_

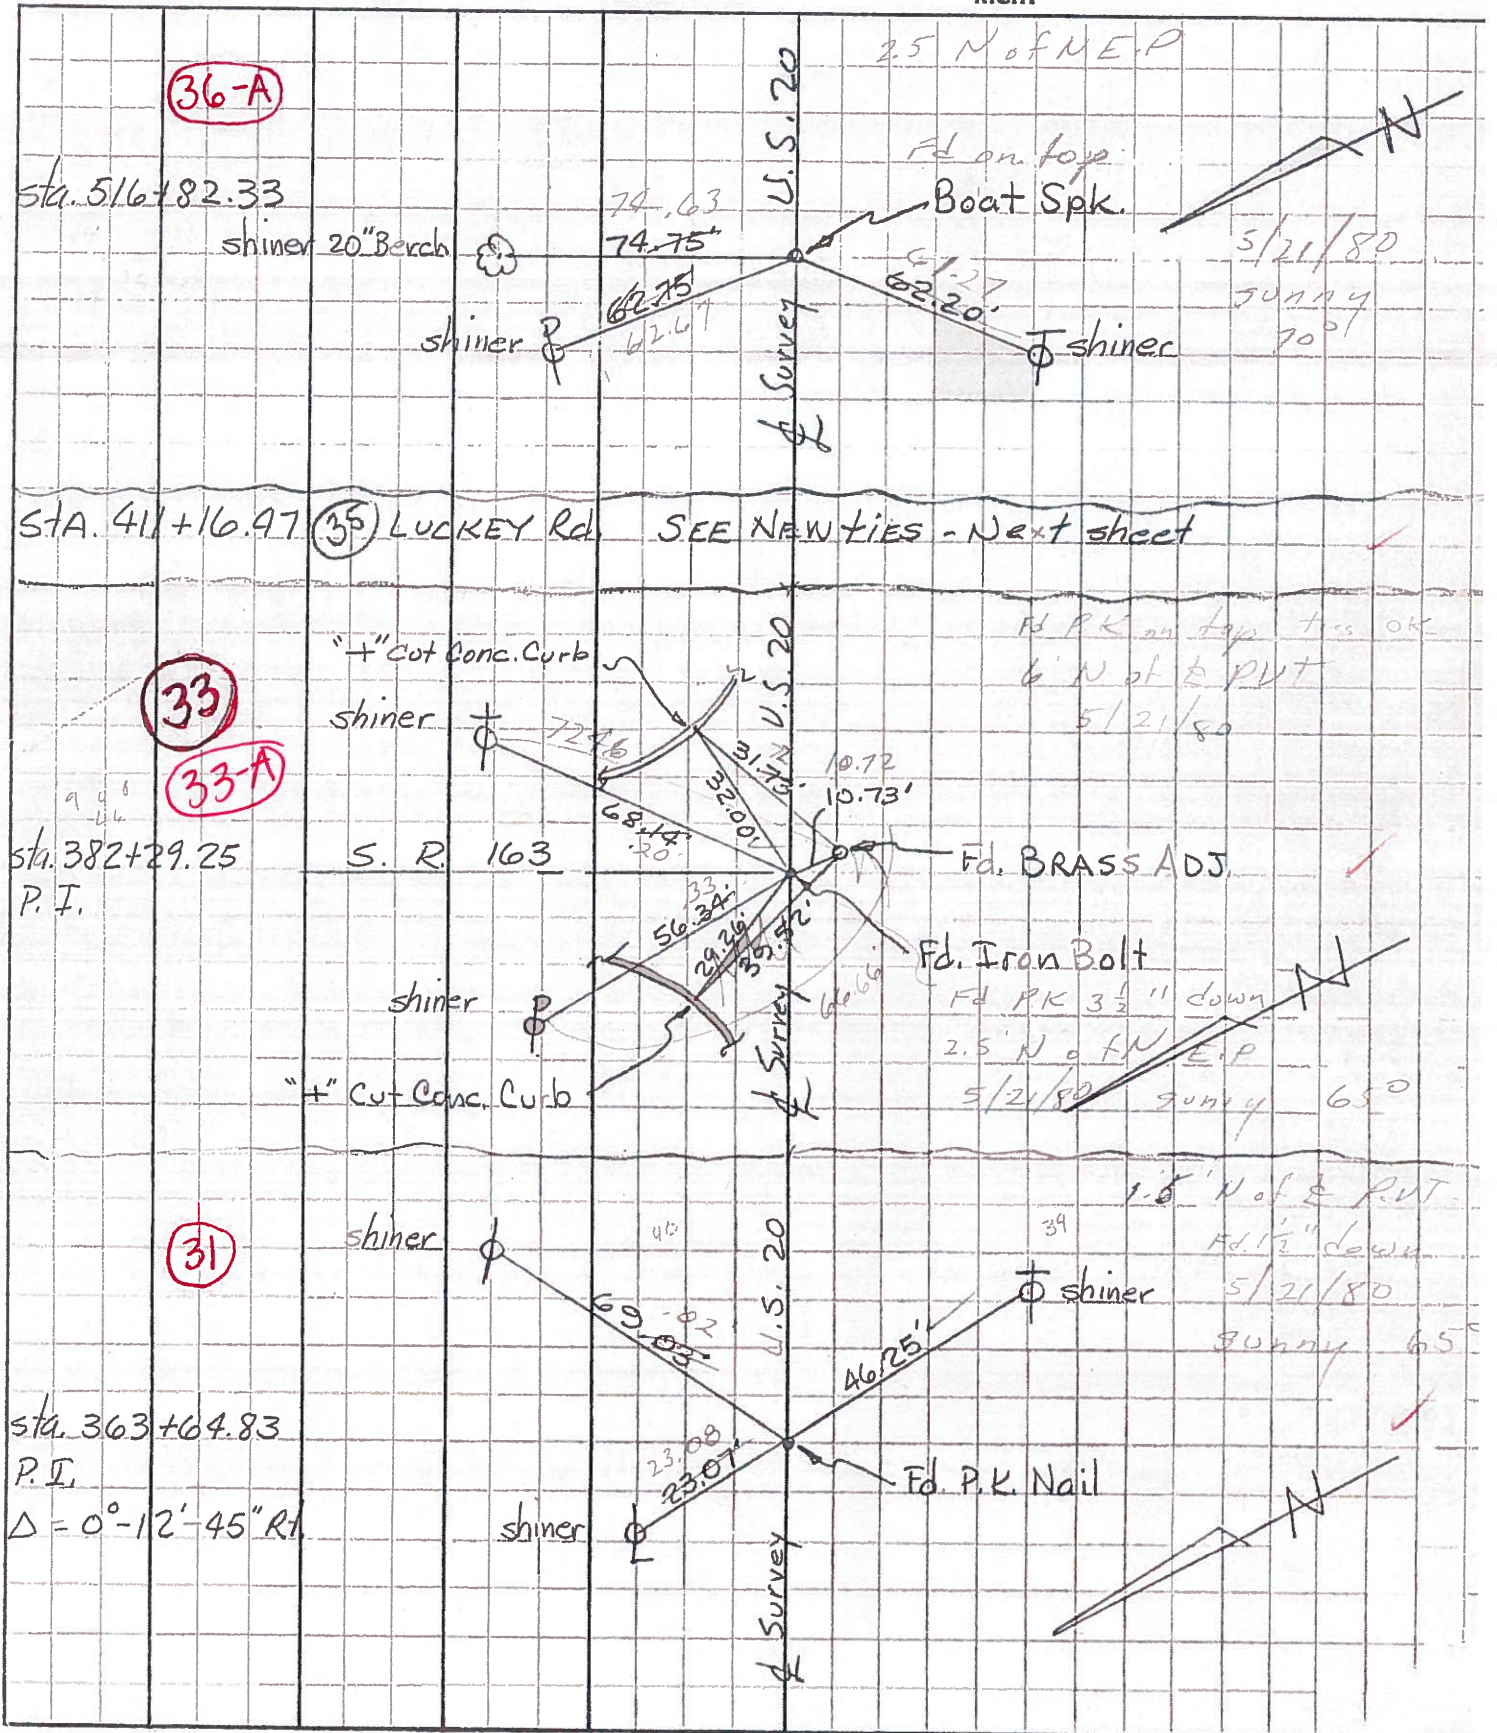



PERSONNEL	TITLE	PERSONNEL	TITLE
Tomsic			
Neuser			
Vanyo			
Granata			

COUNTY Wood DATE AUG 17, 1971  
 S. R. U.S. 20 RECHECKED - Dec-23-  
 SEC. \_\_\_\_\_ WEATHER \_\_\_\_\_  
 TEMP. \_\_\_\_\_

DESCRIPTION REF. CONTROL Pts. LEFT CENTER LINE RIGHT JOB NO.

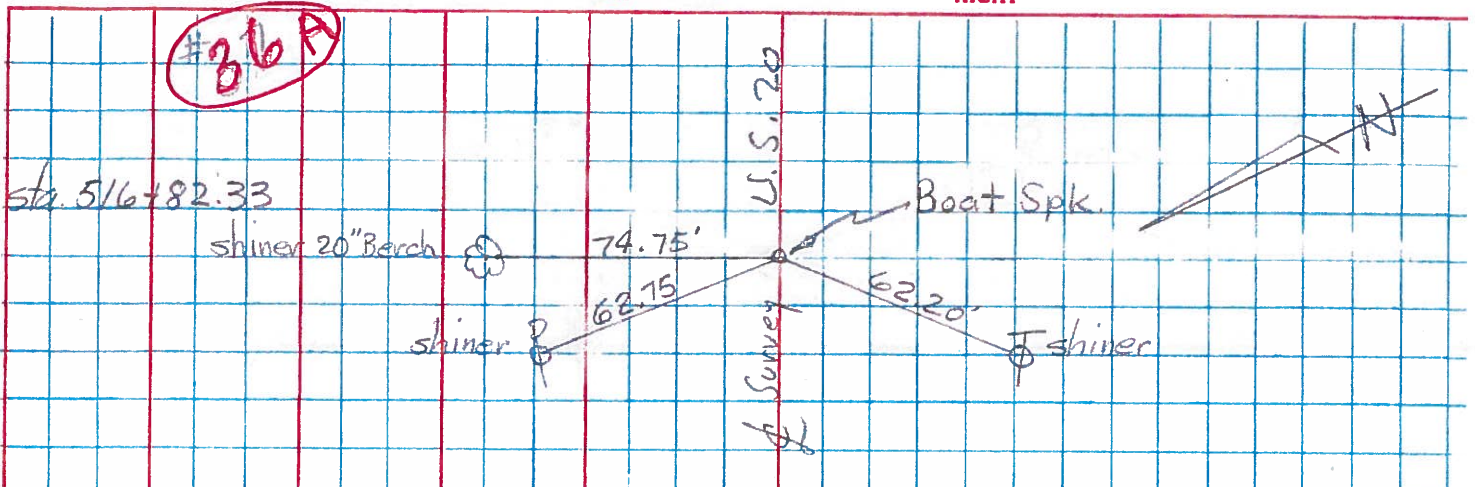


STA. 411+16.97 **35** LUCKEY Rd. SEE NEW TIES - Next sheet

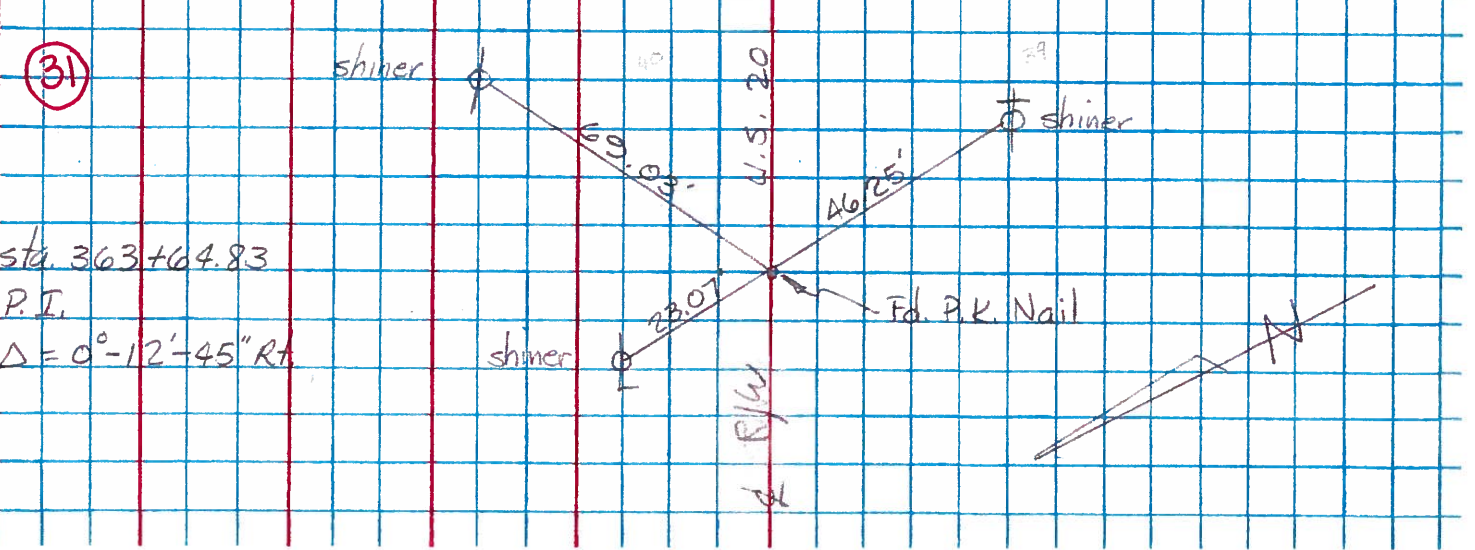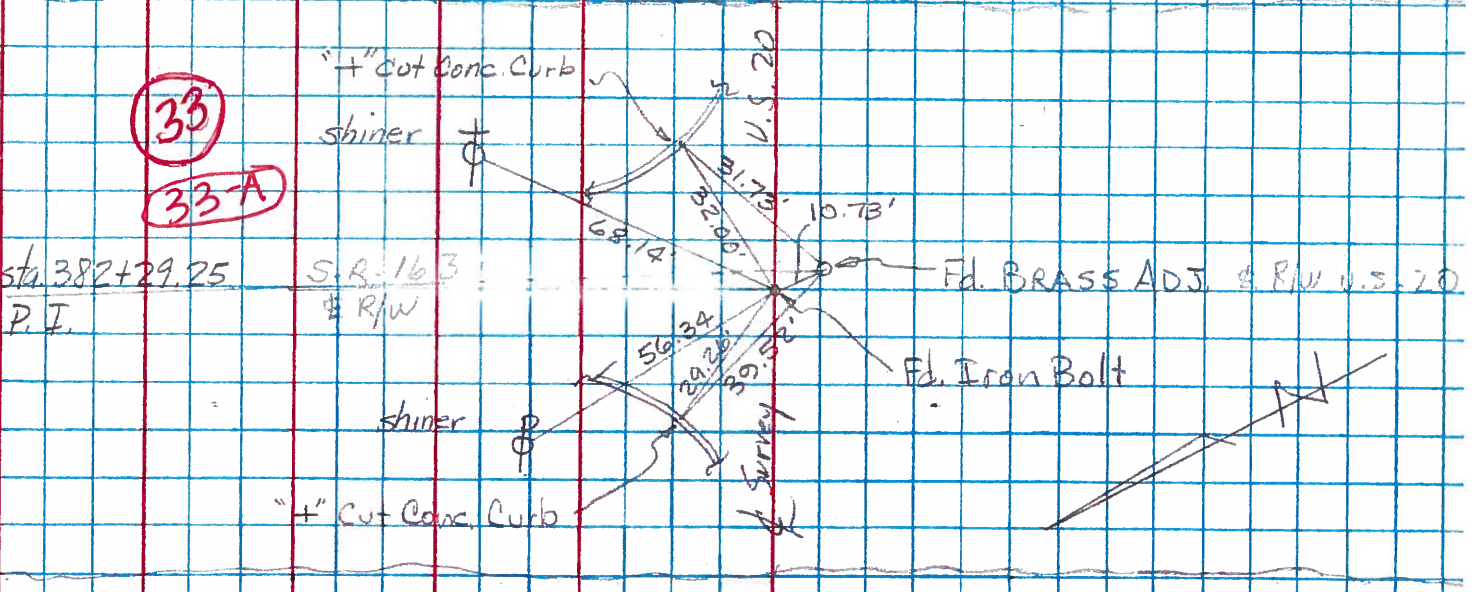

PERSONNEL	TITLE	PERSONNEL	TITLE

COUNTY Wood DATE 3-20-53  
 S. R. 11.5#20 WEATHER           
 SEC.          TEMP.         

DESCRIPTION Stony Ridge JOB NO.         

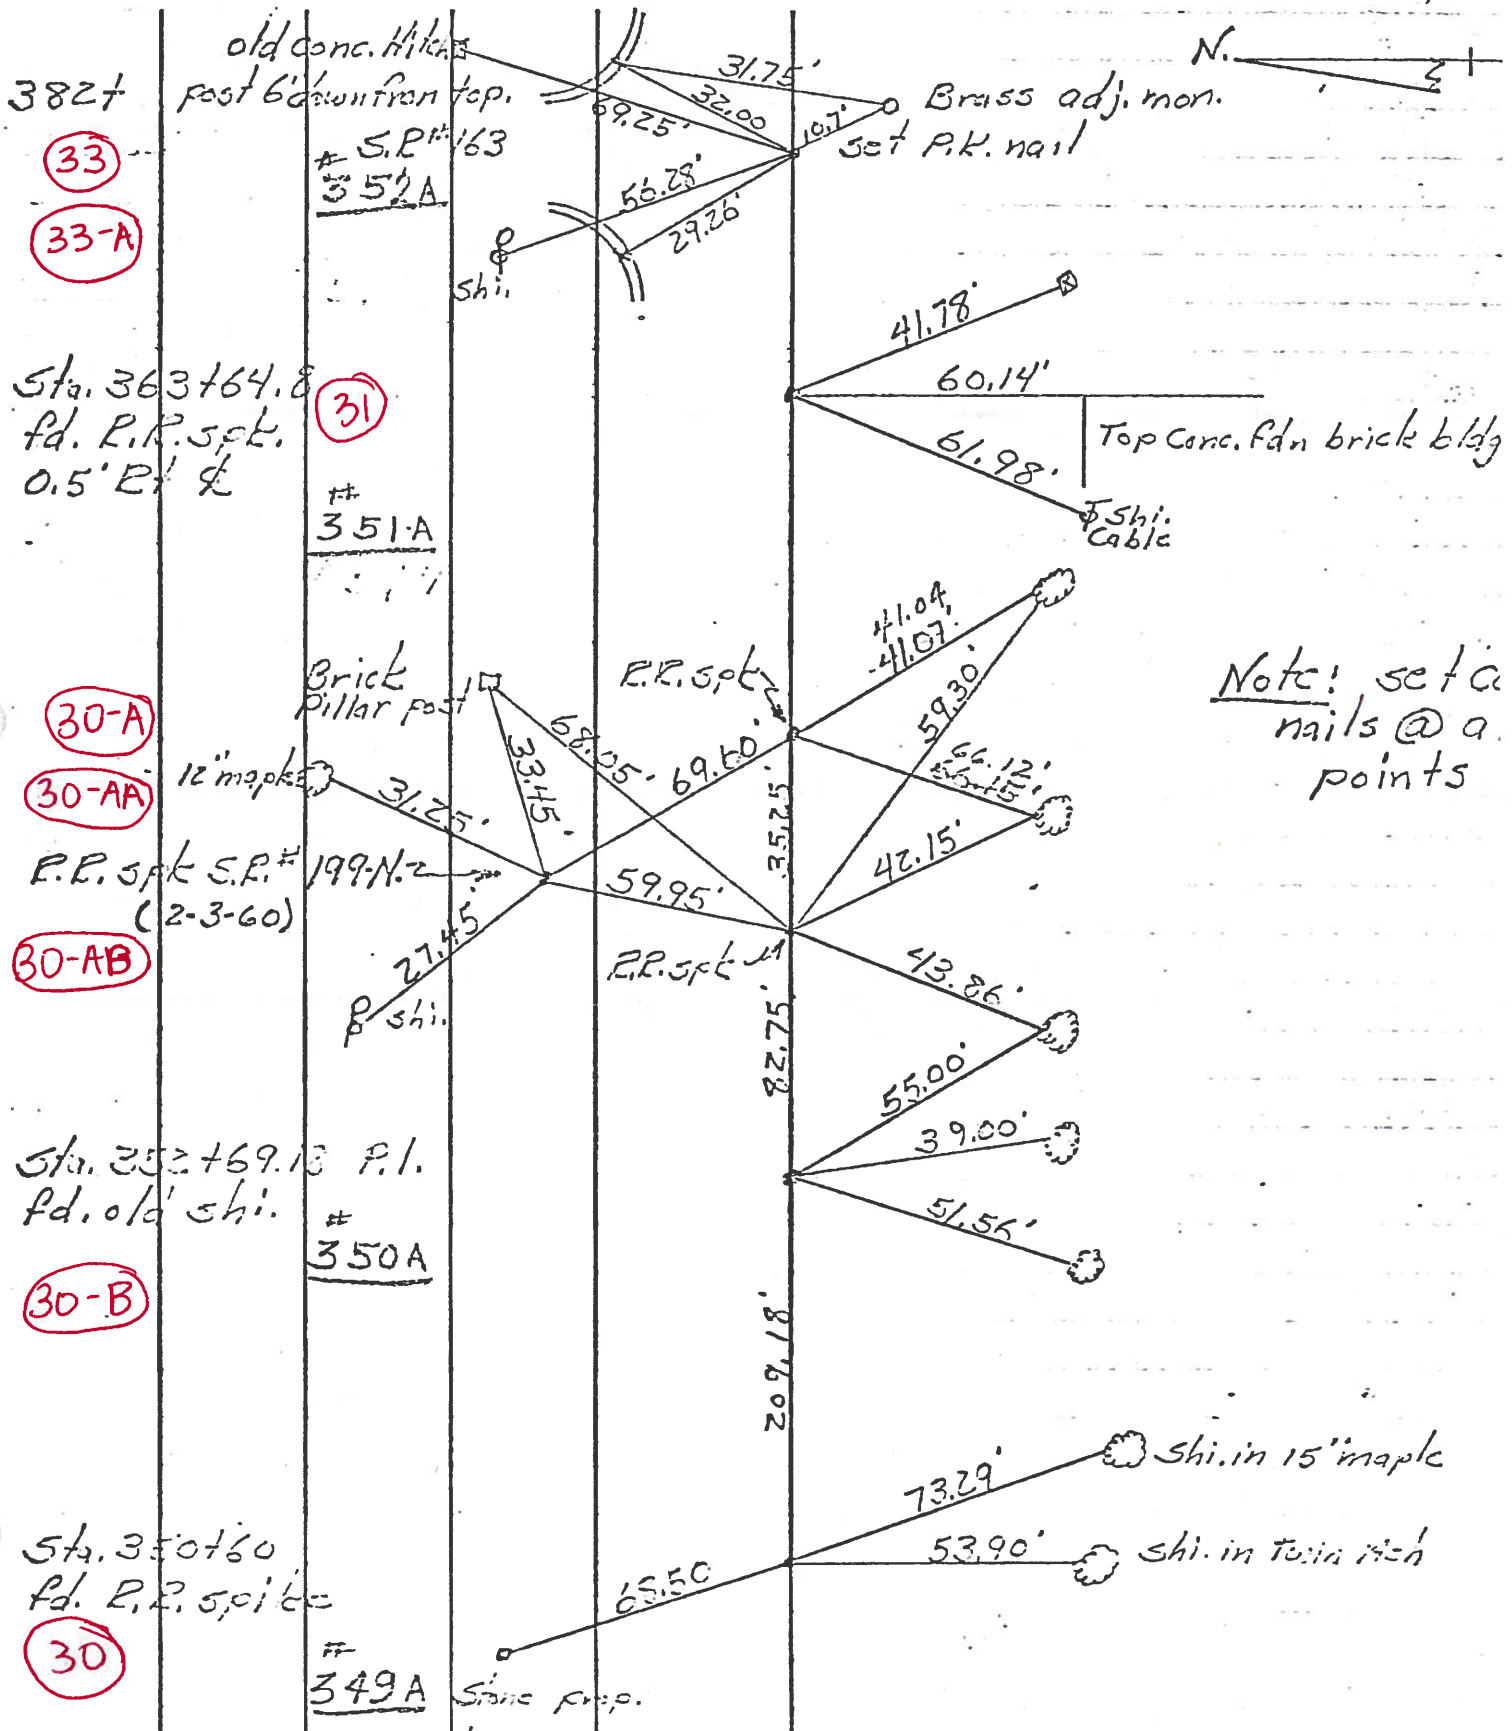

Note: set a nails @ a. points