
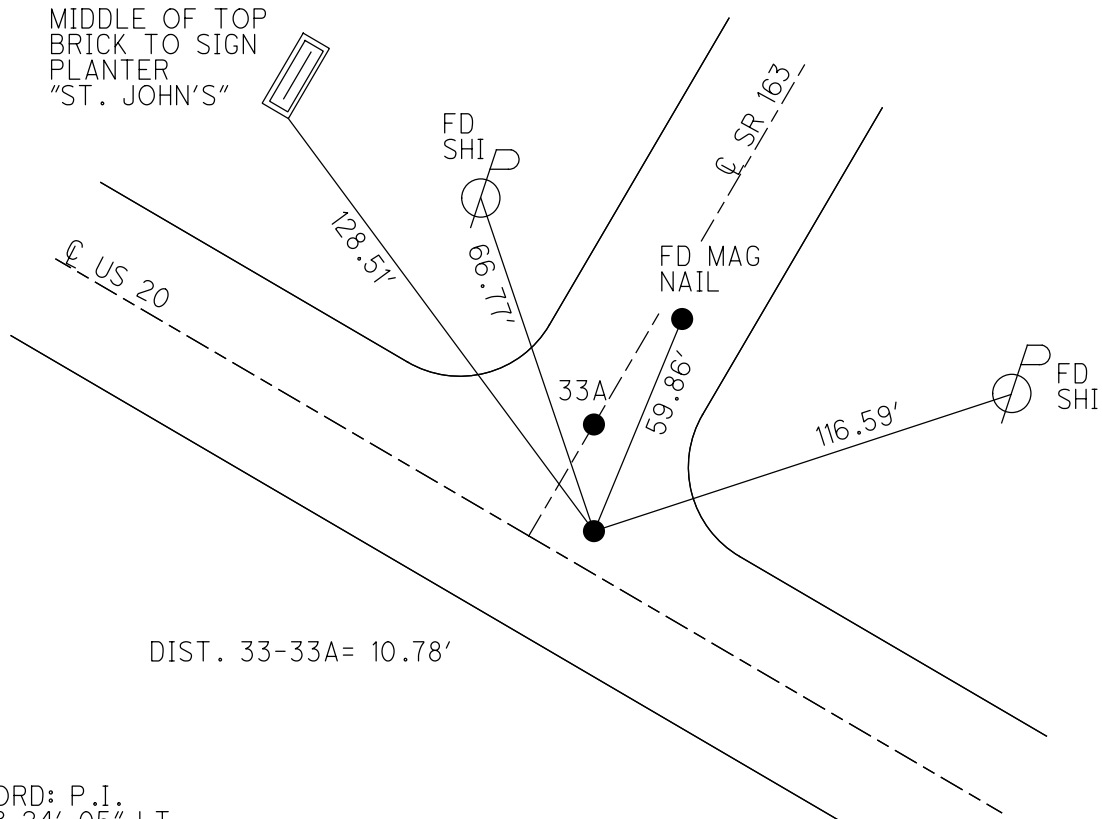


O.D.O.T. DISTRICT 2 SURVEY OFFICE (USE ONLY)

PERSONNEL _____ REFERENCE NO. 33 SHEET 14 OF 23

NOTES	<u>LEU</u>	DATE	<u>8/9/16</u>	ROUTE	<u>US 20</u>
H.C.	<u>HOMAN</u>	WEATHER	<u>SUNNY</u>	COUNTY	<u>WOOD</u>
R.C.	<u>LEU</u>	TEMP.	<u>69°</u>	TOWNSHIP	<u>TROY</u>
				SECTION	<u>42</u>
				T <u>6</u> N	R <u>12</u> E

TYPE MONUMENT _____ P.K.NAIL _____
 ON SURFACE - ~~BELOW~~ _____ ON _____
 LEFT - C PAV'T - ~~RIGHT~~ _____ 4.8' _____
 - TO - _____ EDGE PAVEMENT _____
 S.L.M. _____ 468+38 _____
 GRID: NORTHING: 672280.395 EASTING: 1694091.653

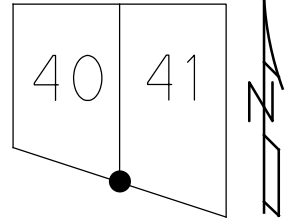



DIST. 33-33A= 10.78'

RECORD: P.I.
 $\Delta=0^{\circ} 24' 05''$ LT
 PLAN STA. 382+29.25
 FD P.K./WASHER
 8/1/13, SDC
 FD P.K.NAIL
 REF33
 8/9/16, DCH
 SET MAG/WASHER
 5/7/18
 6/17/19, JFO

O.D.O.T. DISTRICT 2 SURVEY OFFICE (USE ONLY)

PERSONNEL	REFERENCE NO.	<u>33</u>	SHEET	<u>14</u>	OF	<u>23</u>
NOTES	LEU	DATE	<u>8/9/16</u>	ROUTE	<u>US 20</u>	
H.C.	<u>HOMAN</u>	WEATHER	<u>SUNNY</u>	COUNTY	<u>WOOD</u>	
R.C.	<u>LEU</u>	TEMP.	<u>69°</u>	TOWNSHIP	<u>TROY</u>	
				SECTION	<u>42</u>	
				T	<u>6</u>	R
				N	<u>12</u>	E

TYPE MONUMENT _____ P.K.NAIL _____
 ON SURFACE - ~~BELOW~~ _____ ON _____
 LEFT - ☉ PAV'T - ~~RIGHT~~ 4.8' _____
 _____ TO _____ EDGE PAVEMENT _____
 S.L.M. _____ 468+38 _____
 GRID: NORTHING: 672280.395 EASTING: 1694091.653

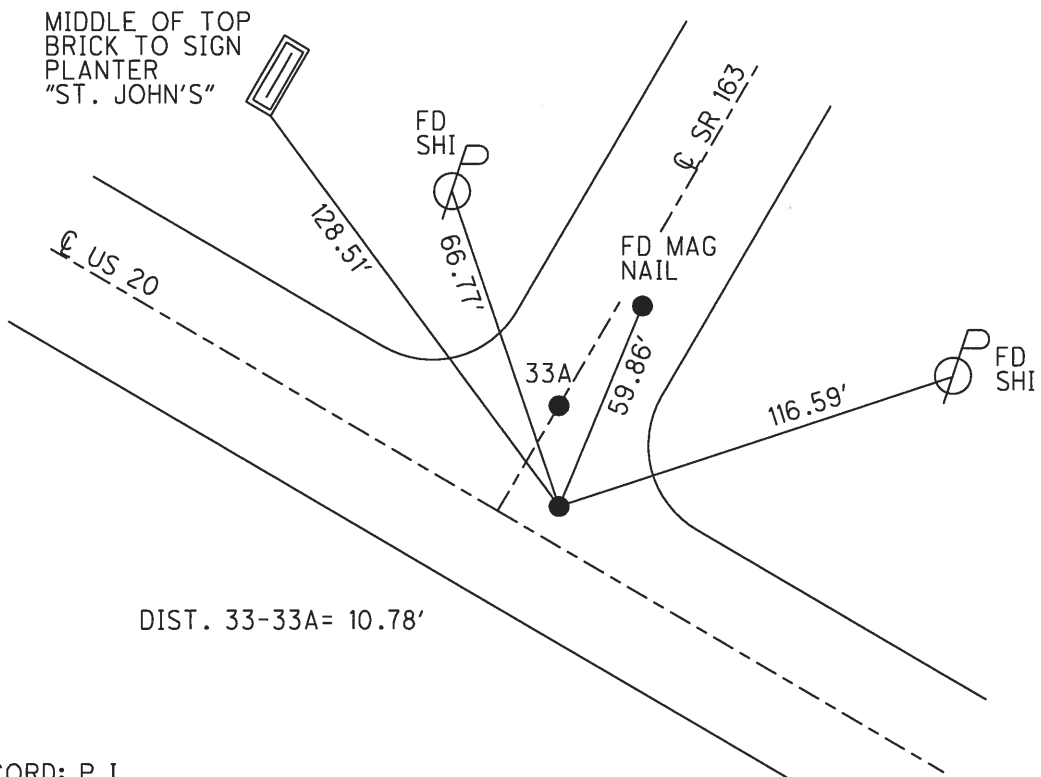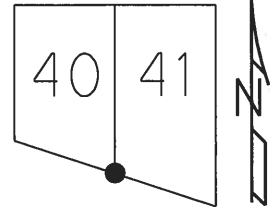


DIST. 33-33A= 10.78'

RECORD: P.I.
 $\Delta=0^{\circ} 24' 05''$ LT
 PLAN STA. 382+29.25
 FD P.K./WASHER
 8/1/13, SDC
 FD P.K.NAIL
 REF33
 8/9/16, DCH
 SET MAG/WASHER
 5/7/18, JFO

O.D.O.T. DISTRICT 2 SURVEY OFFICE (USE ONLY)


PERSONNEL	REFERENCE NO.	<u>33</u>	SHEET	<u>14</u>	OF	<u>19</u>
NOTES	RHOADES	DATE	<u>8/1/13</u>	ROUTE	<u>US 20</u>	
H.C.	<u>CODER</u>	WEATHER	<u>CLOUDY</u>	COUNTY	<u>WOOD</u>	
R.C.	<u>RHOADES</u>	TEMP.	<u>80°</u>	TOWNSHIP	<u>TROY</u>	
				SECTION	<u>42</u>	
				T	<u>6</u>	N
				R	<u>12</u>	E

TYPE MONUMENT _____ P.K./WASHER _____
 ON SURFACE - ~~BELOW~~ _____ ON _____
 LEFT - ℄ PAV'T - ~~RIGHT~~ _____ 4.8' _____
 - _____ TO _____ EDGE PAVEMENT _____
 S.L.M. _____ 468+38 _____

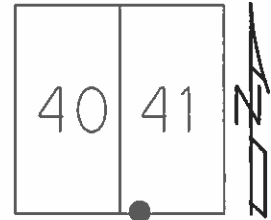

GRID: NORTHING: 672280.394 EASTING: 1694091.589

RECORD: P.I.
 $\Delta=0^{\circ} 24' 05''$ LT
 PLAN STA. 382+29.25

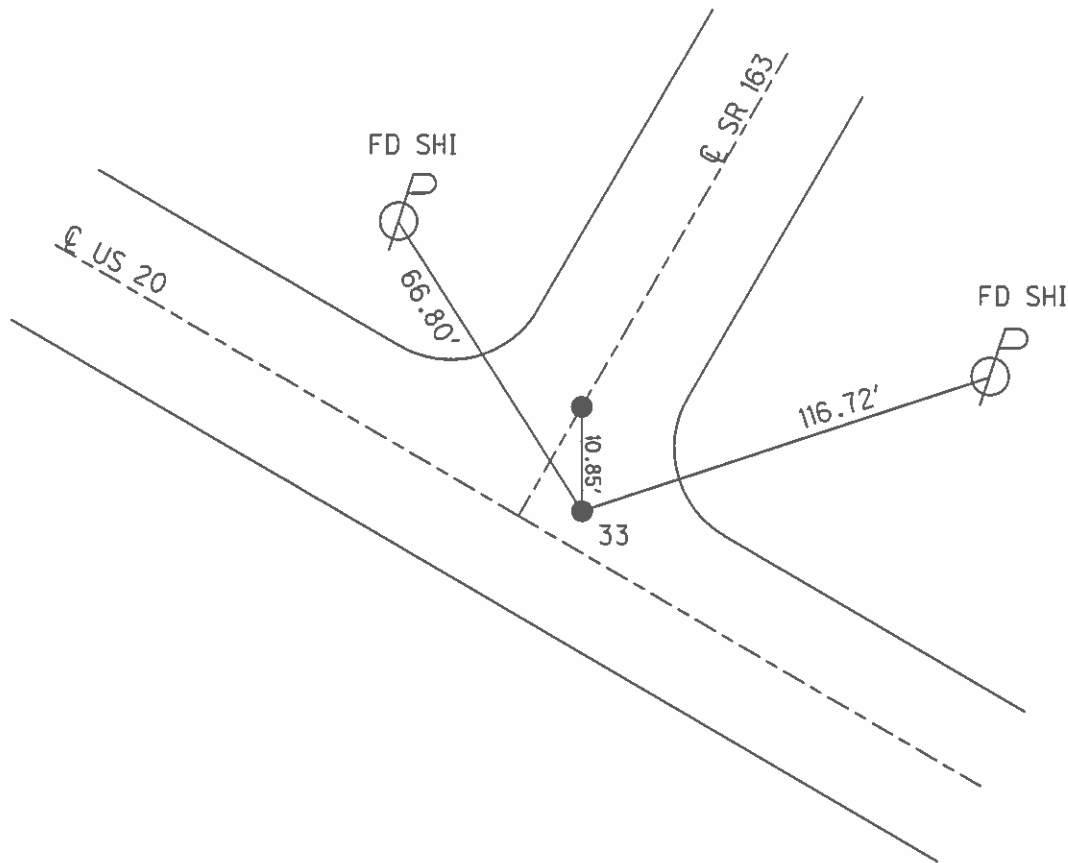

O.D.O.T. DISTRICT 2 SURVEY OFFICE

PERSONNEL

REFERENCE NO. 33

SHEET 15 OF 19

NOTES LOEHRKE

H.C. CURTIS

R.G. ROMETO

DATE 5-13-92

WEATHER Pt. Cloudy

TEMP. +70

ROUTE U.S. 20

COUNTY Wood

TOWNSHIP TROY

SECTION R.T. 41

T 6 N R 12 E

Set P.K.'s / WASHERS

TYPE MONUMENT P.K. Nails

6-29-93

ON SURFACE - BELOW Yes

C.L.

LEFT-☐ PAV'T. - RIGHT A = 4.8'

TO EDGE PAVEMENT

S.L.M. 468+38 = Pt A

R.T. 40	R.T. 41
R.T. 39	R.T. 42




Btw - 10.76

Pt. "A" of R/W. P.I.

$\Delta = 0^{\circ}24'05'' - Lt.$

PLAN Sta 382+29.25


Pt. "B" of SURVEY

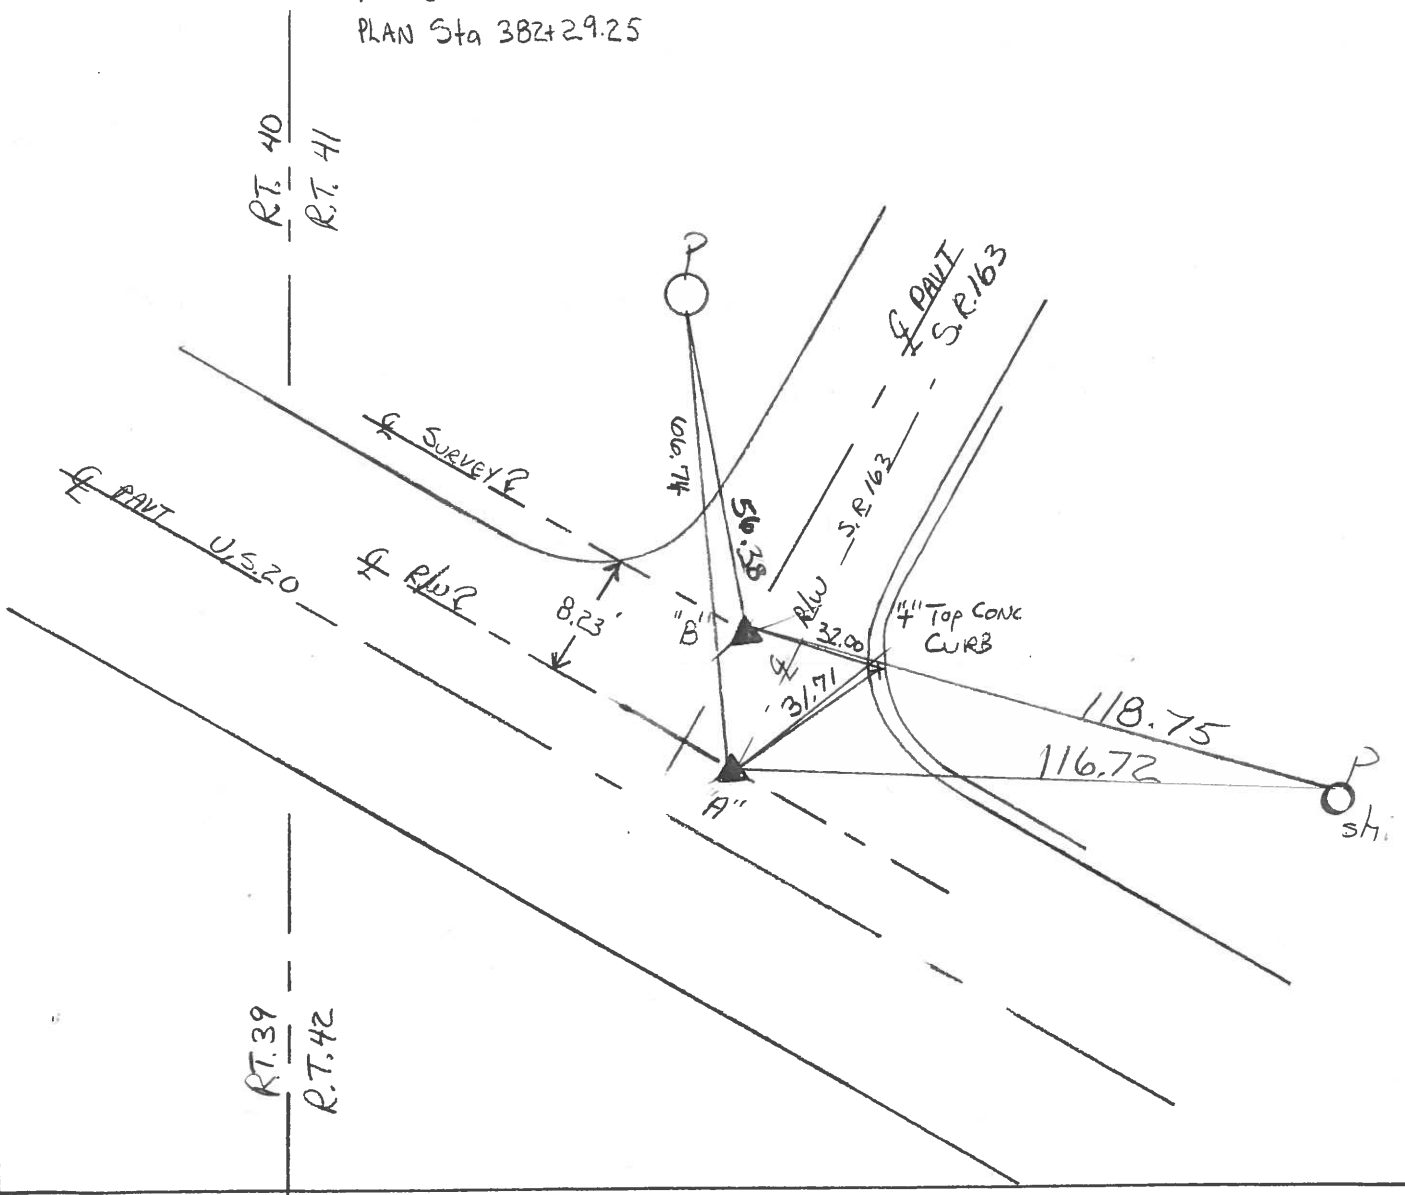

PERSONNEL	TITLE	PERSONNEL	TITLE
Tomasic			
Neuser			
Vanyo			
Granata			

COUNTY Wood DATE Aug 17, 1972
 S. R. U.S. 20 Rechecked - Dec-23
 WEATHER _____
 SEC. _____ TEMP. _____


DESCRIPTION REF. CONTROL Pts. LEFT CENTER LINE RIGHT JOB NO.

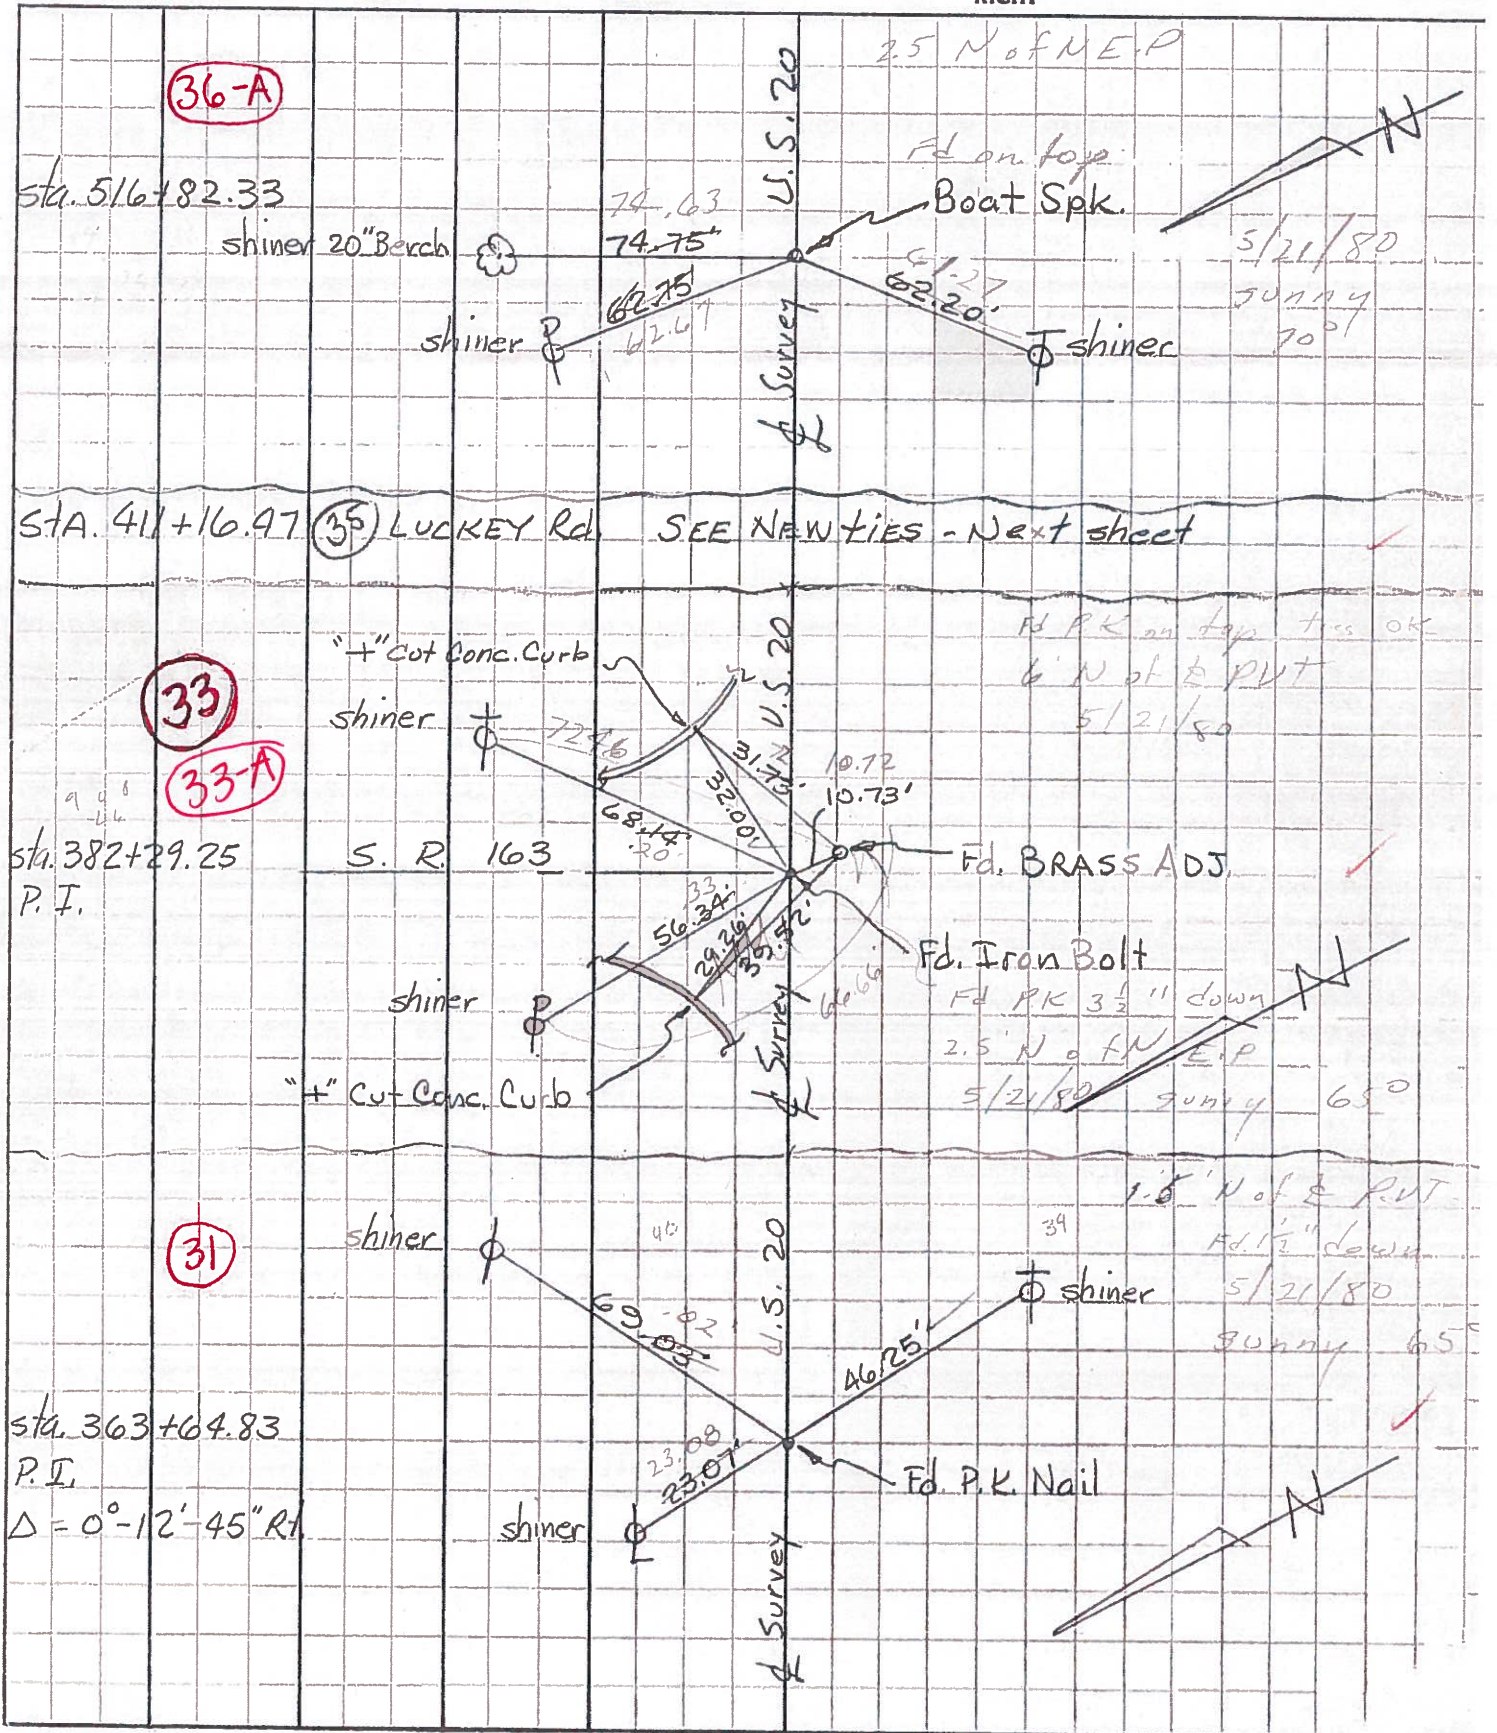

PERSONNEL	TITLE	PERSONNEL	TITLE
Tomsic			
Neuser			
Vanyo			
Granata			

COUNTY Wood DATE AUG 17, 1971
 S. R. U.S. 20 RECHECKED - Dec-23-
 SEC. _____ WEATHER _____
 TEMP. _____

DESCRIPTION REF. CONTROL Pts. LEFT CENTER LINE RIGHT JOB NO.

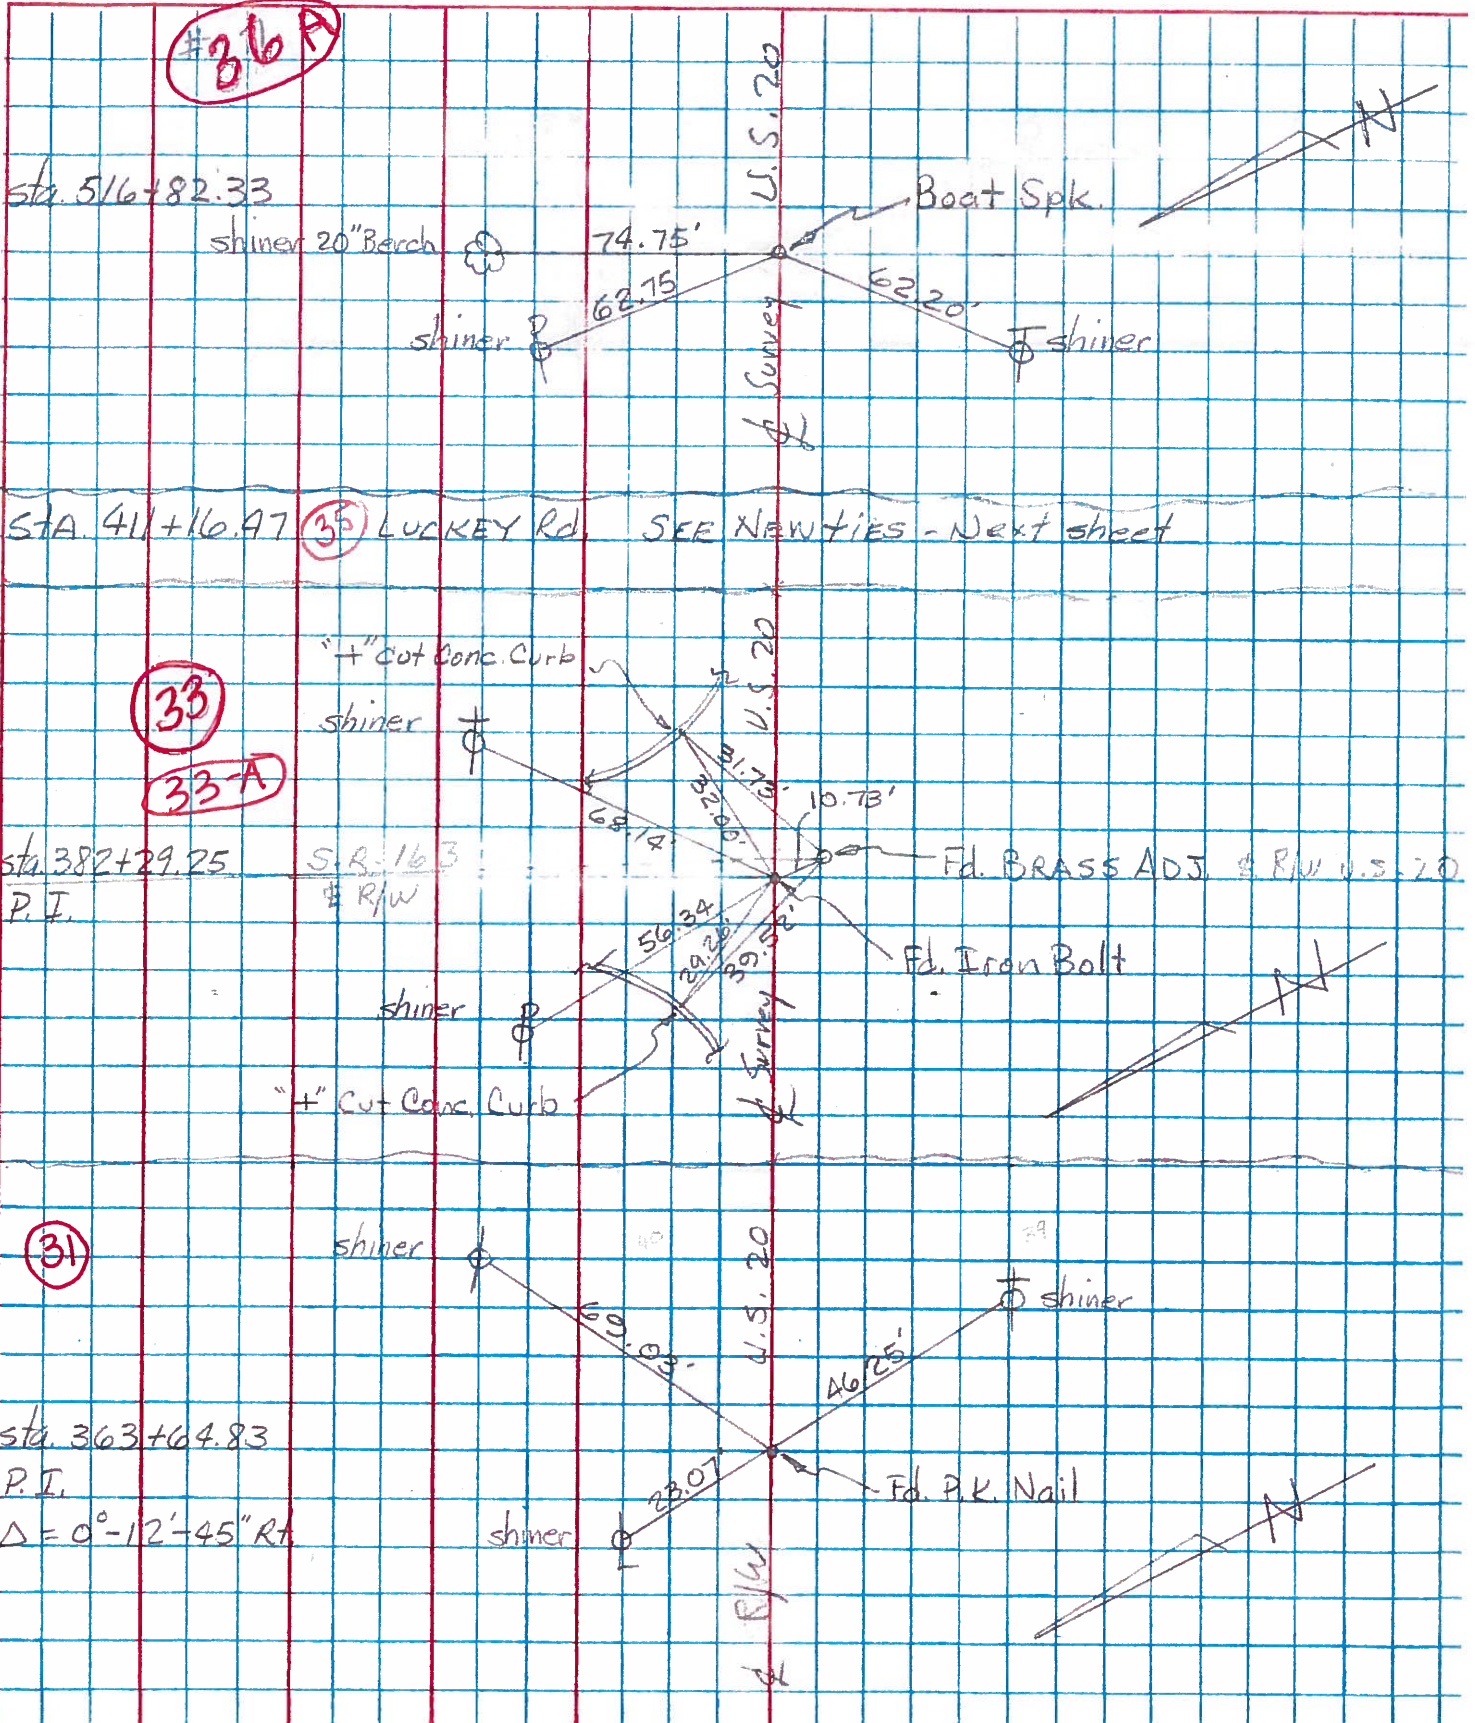


PERSONNEL TITLE PERSONNEL TITLE

COUNTY Wood DATE 3-20-53

S. R. 11.5#20 WEATHER

SEC. TEMP.

DESCRIPTION Stony Ridge JOB NO.

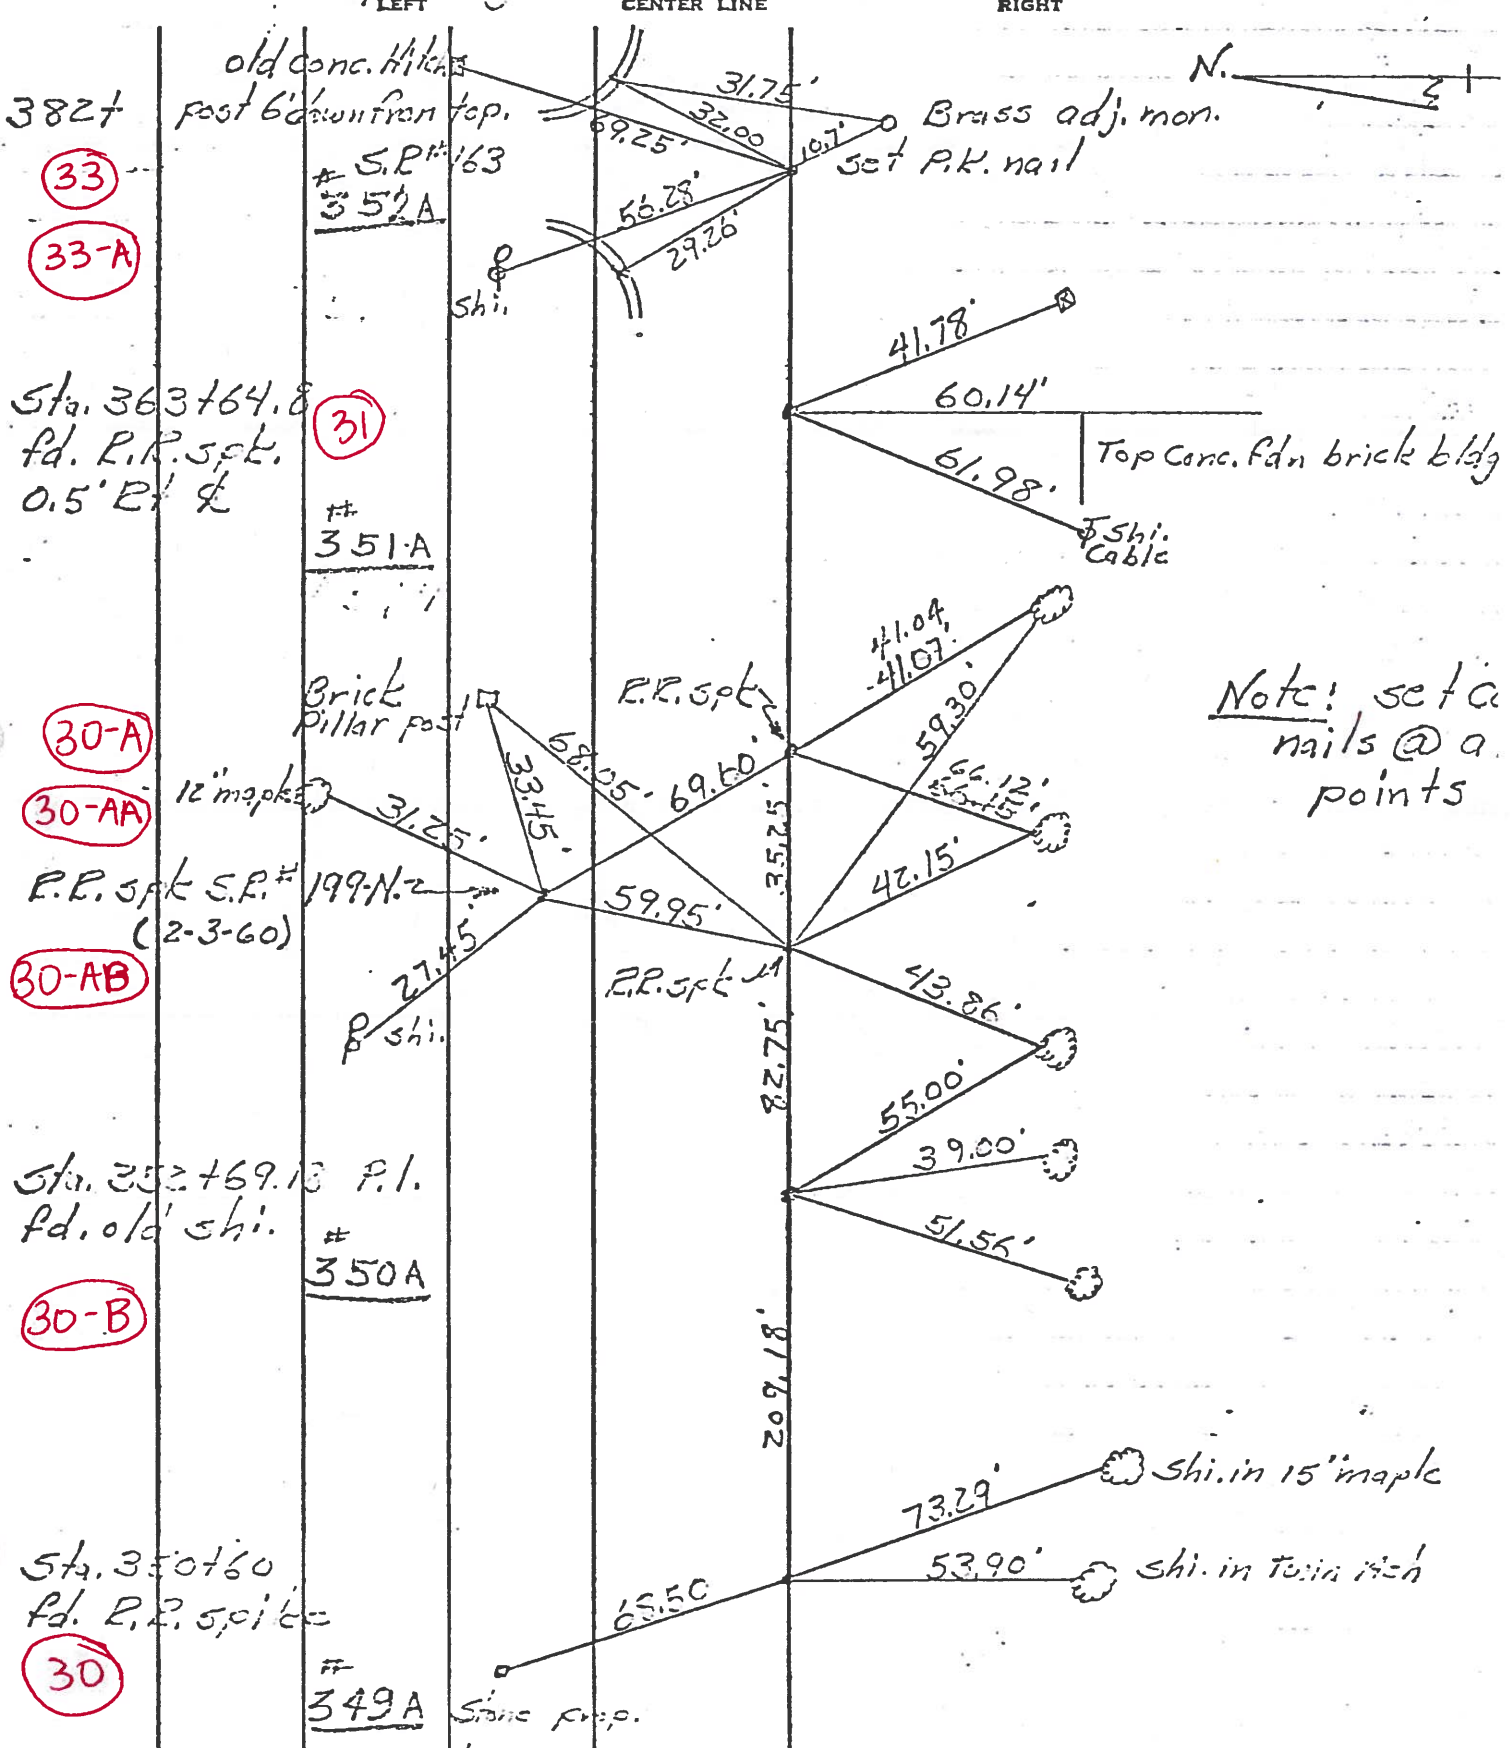

Note! set a nails @ a. points

382+

33

33-A

Sta. 363+64.8
fd. R.R. spike
0.5' E of

31

30-A

30-AA

R.R. spike S.R.# 199-N-2
(2-3-60)

30-AB

Sta. 352+69.13 P.I.
fd. old shi.

30-B

Sta. 350+60
fd. R.R. spike

30

349A

Stone prop.