



O.D.O.T. DISTRICT 2 SURVEY OFFICE (USE ONLY)

PERSONNEL \_\_\_\_\_ REFERENCE NO. 37 SHEET 19 OF 23  
 NOTES LEU DATE 8/9/16 ROUTE US 20  
 H.C. HOMAN WEATHER CLEAR COUNTY WOOD  
 R.C. LEU TEMP. 69° TOWNSHIP TROY  
 \_\_\_\_\_ SECTION RT 48  
 T 6 N R 12 E

TYPE MONUMENT SM.R.R. SPIKE  
~~ON SURFACE~~ - BELOW 6"  
 LEFT - ℄ PAV'T - ~~RIGHT~~ 14.5'  
2.3' TO LT EDGE PAVEMENT  
 S.L.M. 527+78  
 GRID: NORTHING: 669321.403 EASTING: 1699243.821

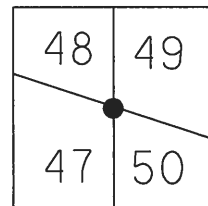


RECORD:  
 PLAN STA 527+65.12  
 FD SM.R.R.SPIKE  
 6/25/02, KPM  
 FD SM.R.R. SPIKE  
 6" BELOW REF37  
 8/9/16, DCH  
 SET MAG/WASHER  
 5/7/18, JFO

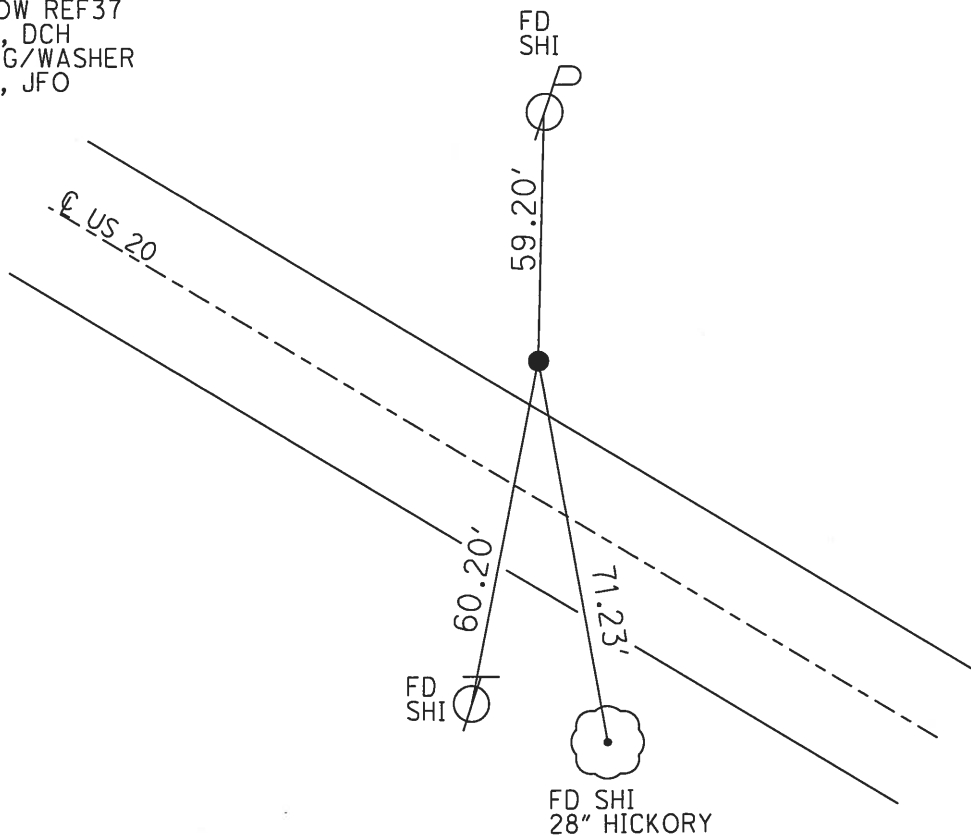


O.D.O.T. DISTRICT 2 SURVEY OFFICE (USE ONLY)

PERSONNEL \_\_\_\_\_ REFERENCE NO. 37 SHEET 19 OF 19  
 NOTES MICHALAK DATE 6/25/02 ROUTE US 20  
 H.C. MOSER WEATHER CLEAR COUNTY WOOD  
 R.C. SIEFRING TEMP. 95° TOWNSHIP TROY  
BEAUMONT SECTION RT 48  
 T 6 N R 12 E

TYPE MONUMENT \_\_\_\_\_ SM. R.R. SPIKE \_\_\_\_\_  
 ON SURFACE - BELOW \_\_\_\_\_ ON \_\_\_\_\_  
 LEFT - Q PAV'T - RIGHT 14.5'  
2.3' TO LT EDGE PAVEMENT  
 S.L.M. 527+78  
 GRID: NORTHING: \_\_\_\_\_ EASTING: \_\_\_\_\_

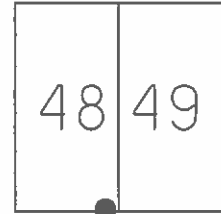

RECORD:  
 PLAN STA 527+65.12

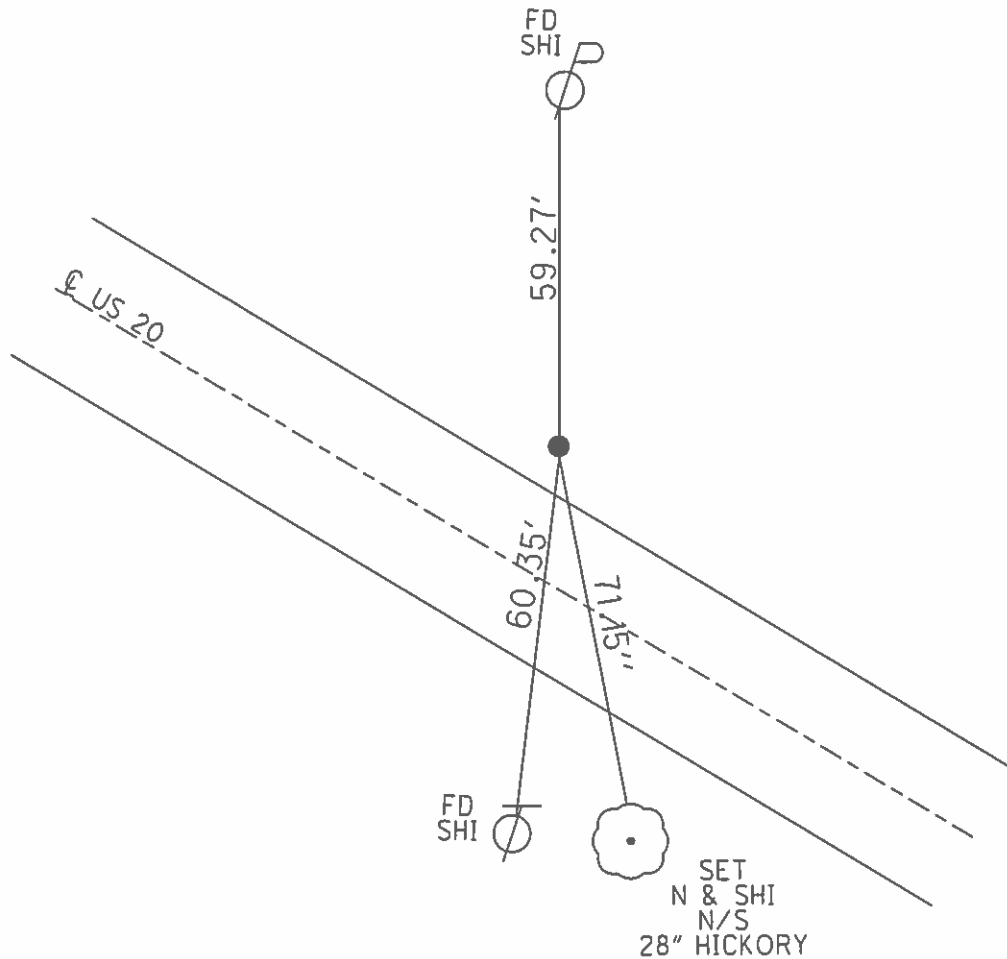

# O.D.O.T. DISTRICT 2 SURVEY OFFICE

PERSONNEL \_\_\_\_\_

REFERENCE NO. 37

SHEET 19 OF 19

NOTES LOEHRKE

H.C. CURTIS

R.C. ROMERO

DATE 5-19-92

WEATHER Clear

TEMP. +68

ROUTE U.S. 20

COUNTY WOOD

TOWNSHIP TROY

SECTION \_\_\_\_\_

T \_\_\_\_\_ R \_\_\_\_\_

TYPE MONUMENT Sm. R.R. Spike Set P.K./WASHER


ON SURFACE - BELOW Yes

LEFT- & PAV'T. - RIGHT 14.2'


2.7 Lt TO Lt EDGE PAVEMENT

S.L.M. 527+78

6-29-93  
C.L.

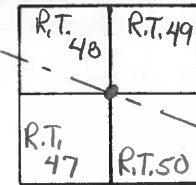

PLAN Sta 527+05.12

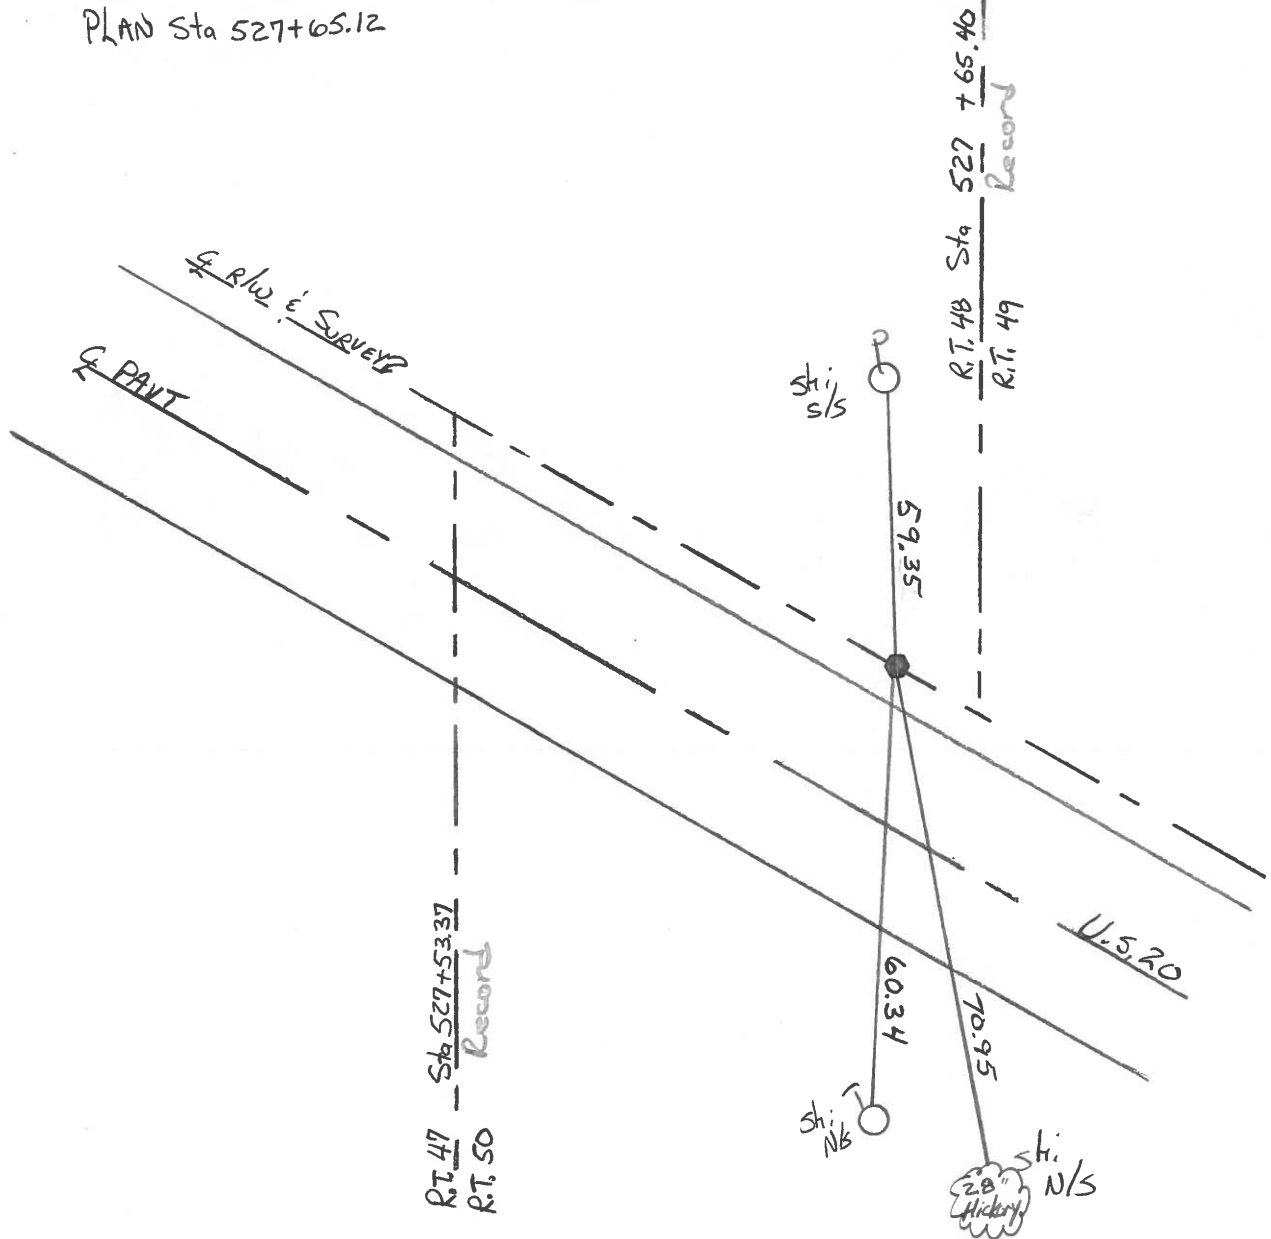

County Wood S.R. U.S. #20

Date 5/21/80 Drawn 5/27/80

Township Troy


Weather sunny

Section \_\_\_\_\_

Temp. 75°

T N, R E

Personnel CRONIN

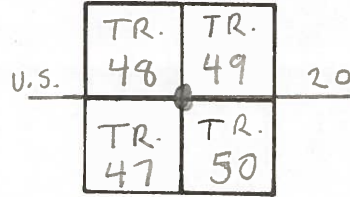

RIPPLE

GEYMAN

MOSSER

BARBOUR

#3)

527+65.12  
 Fd. bolt spike on top  
 2' ± N of N edge of paint.

TR. 49 +65.40  
 TR. 48

P 59.35

64.69  
 Plumb

71.39

60.42

527+53.37

24"  
 Box elder


TR. 50  
 TR. 47

Survey U.S. #20  
 & R/W



PERSONNEL	TITLE	PERSONNEL	TITLE	COUNTY	DATE
Tomasic		Gancare		Wood	Aug 17, 1972
Neuser				S. R. U. S. 20	Rechecked - Dec - 23 - 7.
Vanyo					WEATHER
Granata				SEC.	TEMP.

DESCRIPTION \_\_\_\_\_ LEFT \_\_\_\_\_ CENTER LINE \_\_\_\_\_ RIGHT \_\_\_\_\_ JOB NO. \_\_\_\_\_

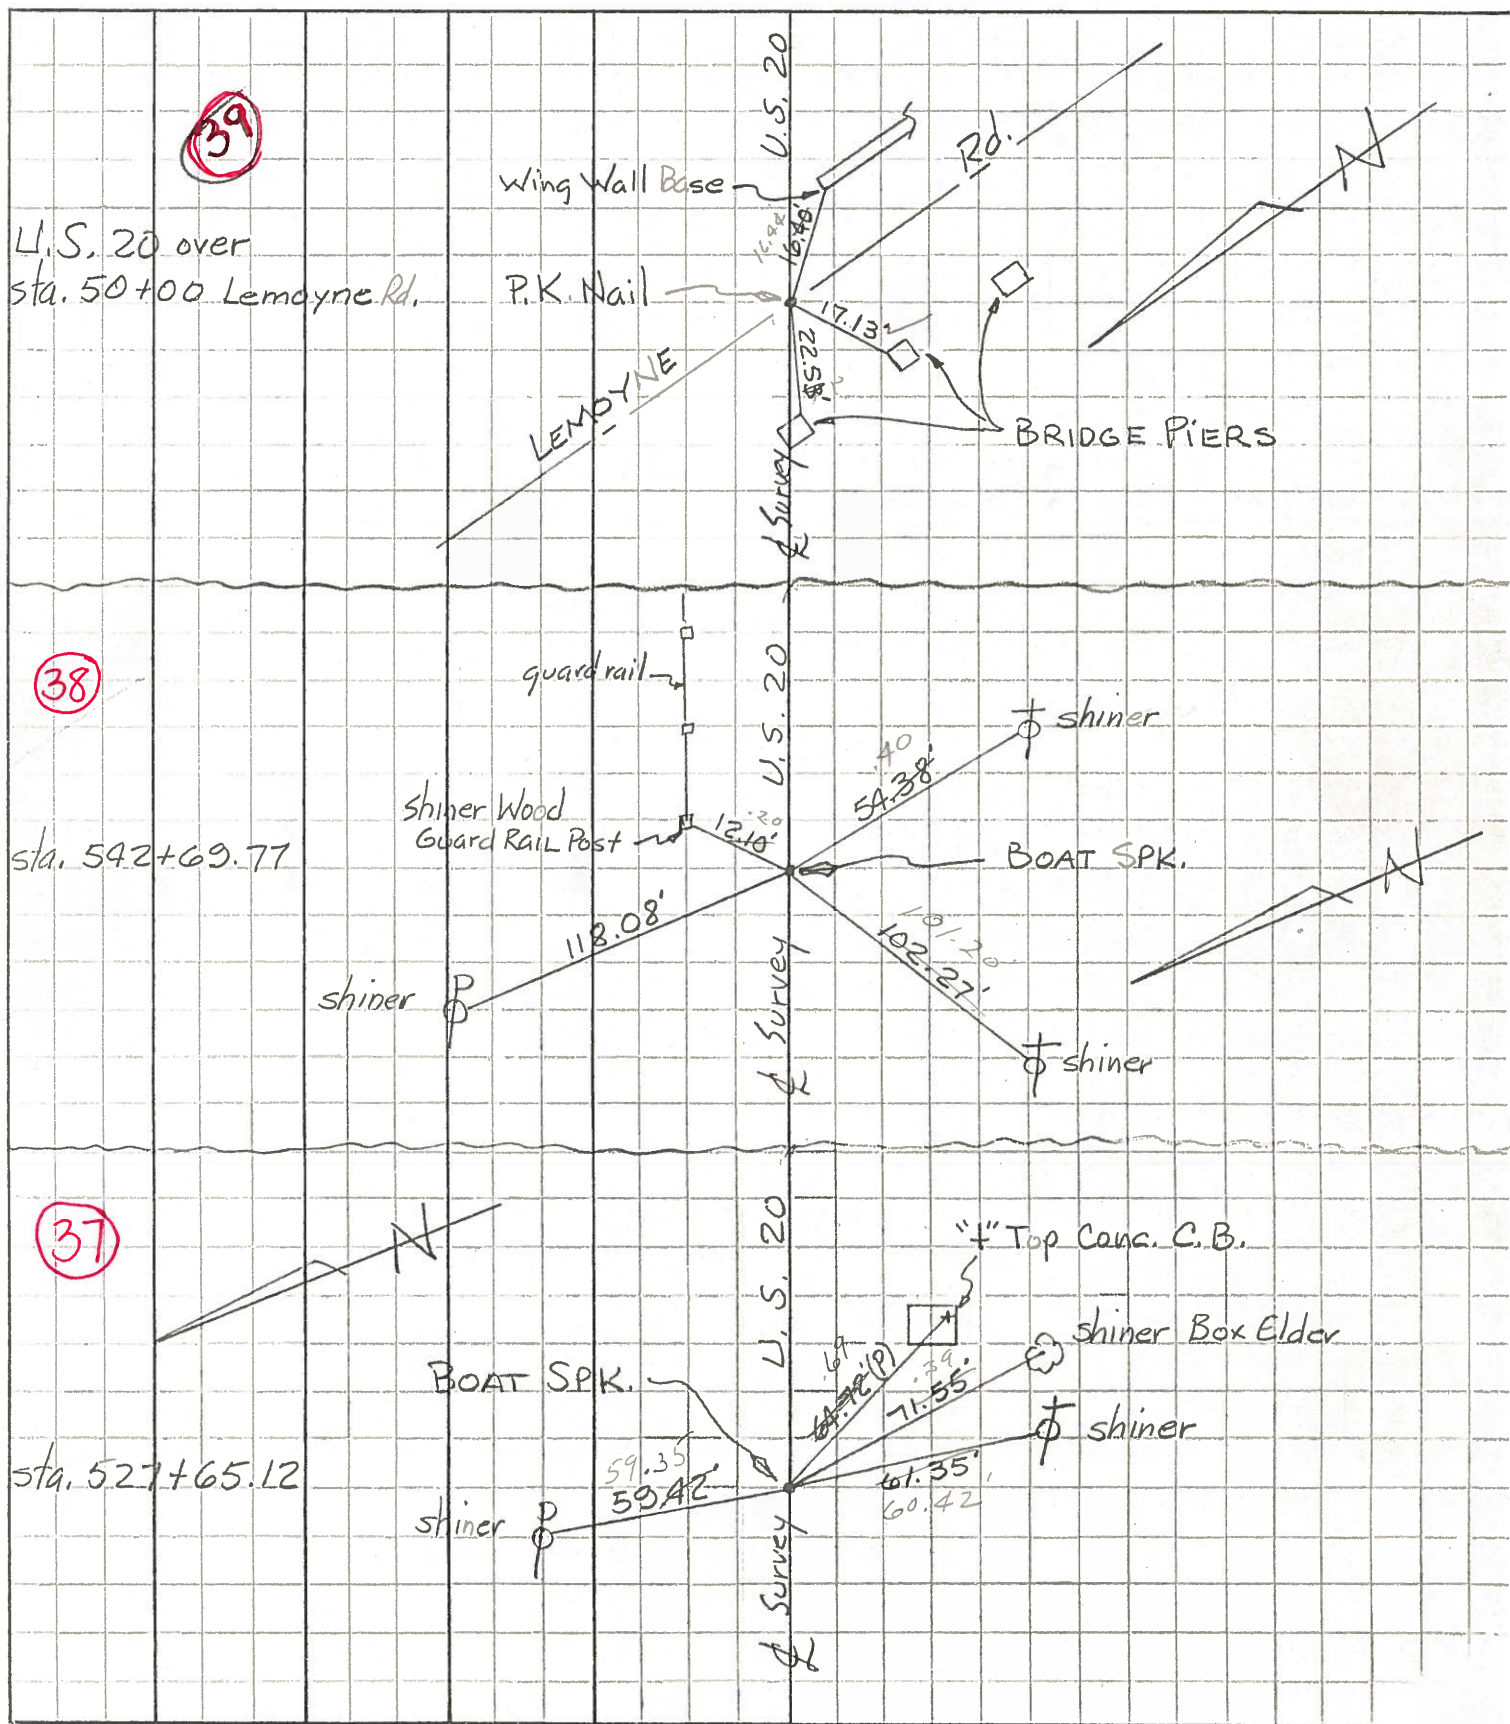



PERSONNEL TITLE PERSONNEL TITLE  
 Tomsic \_\_\_\_\_ Gancarz \_\_\_\_\_  
 Neuser \_\_\_\_\_  
 Vanyo \_\_\_\_\_  
 Granata \_\_\_\_\_

COUNTY Wood DATE Aug 17, 1972  
 S. R. U. S. 20 Rechecked - Dec - 23 - 72  
 SEC. \_\_\_\_\_ WEATHER \_\_\_\_\_  
 TEMP. \_\_\_\_\_

DESCRIPTION LEFT CENTER LINE RIGHT JOB NO.

