



O.D.O.T. DISTRICT 2 SURVEY OFFICE (USE ONLY)

PERSONNEL \_\_\_\_\_ REFERENCE NO. 41 SHEET 23 OF 23  
NOTES WESTFALL DATE 8-26-14 ROUTE US 20  
H.C. \_\_\_\_\_ WEATHER FAIR COUNTY WOOD  
R.C. \_\_\_\_\_ TEMP. 50° TOWNSHIP TROY  
SECTION 56  
T 6 N R 12 E

TYPE MONUMENT 5/8" IPIN  
ON SURFACE - ~~BELOW~~ ON  
~~LEFT~~ - Q PAV'T - RIGHT 3.7'  
2.3' TO LT EDGE PAVEMENT  
S.L.M. 587+71.99  
GRID: NORTHING: 666364.212 EASTING: 1704505.516

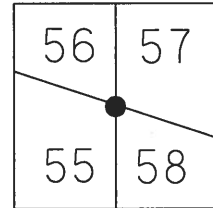

RECORD:  
FD MONBOX  
W/1" IPIN  
5/2/96, TMR  
FD 5/8" IPIN  
ON TOP  
CONC. BARRIOR  
REF41  
8/26/14, EBW

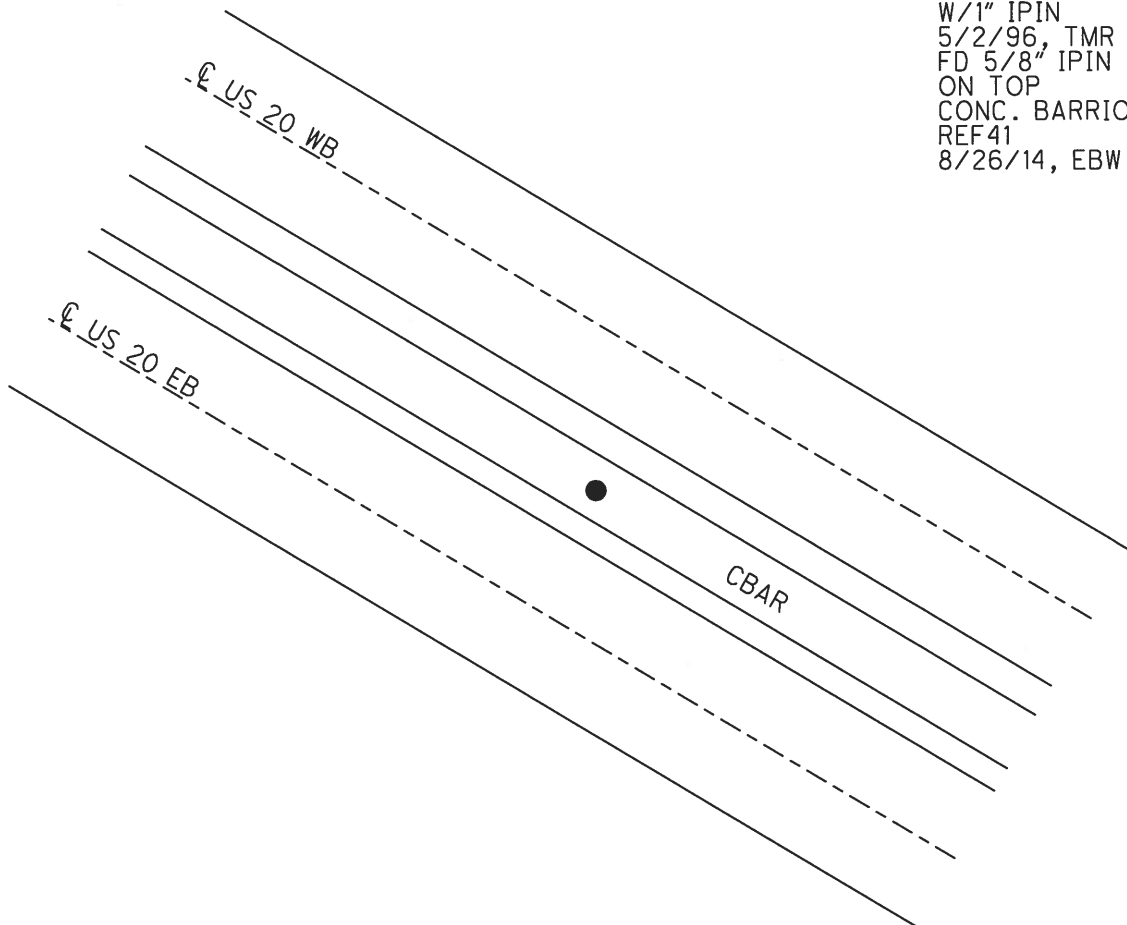

# O.D.O.T. DISTRICT 2 SURVEY OFFICE

PERSONNEL \_\_\_\_\_

REFERENCE NO. 41

SHEET 1 OF 13

NOTES LOEHRKE

H.C. Rousos

R.C. CANTERBURY

DATE 5-2-96

WEATHER FAIR

TEMP. +50

ROUTE U.S. 20

COUNTY WOOD

TOWNSHIP TROY

SECTION \_\_\_\_\_

T 6 N R 12 E

TYPE MONUMENT 1" IRON ROD IN MON BOX


ON SURFACE - ~~BELOW~~ Yes

LEFT-CL PAV'T. - RIGHT \_\_\_\_\_

3.4' TO EDGE PAVEMENT

S.L.M. 5877 91

R.T. 56	R.T. 57
R.T. 55	R.T. 58

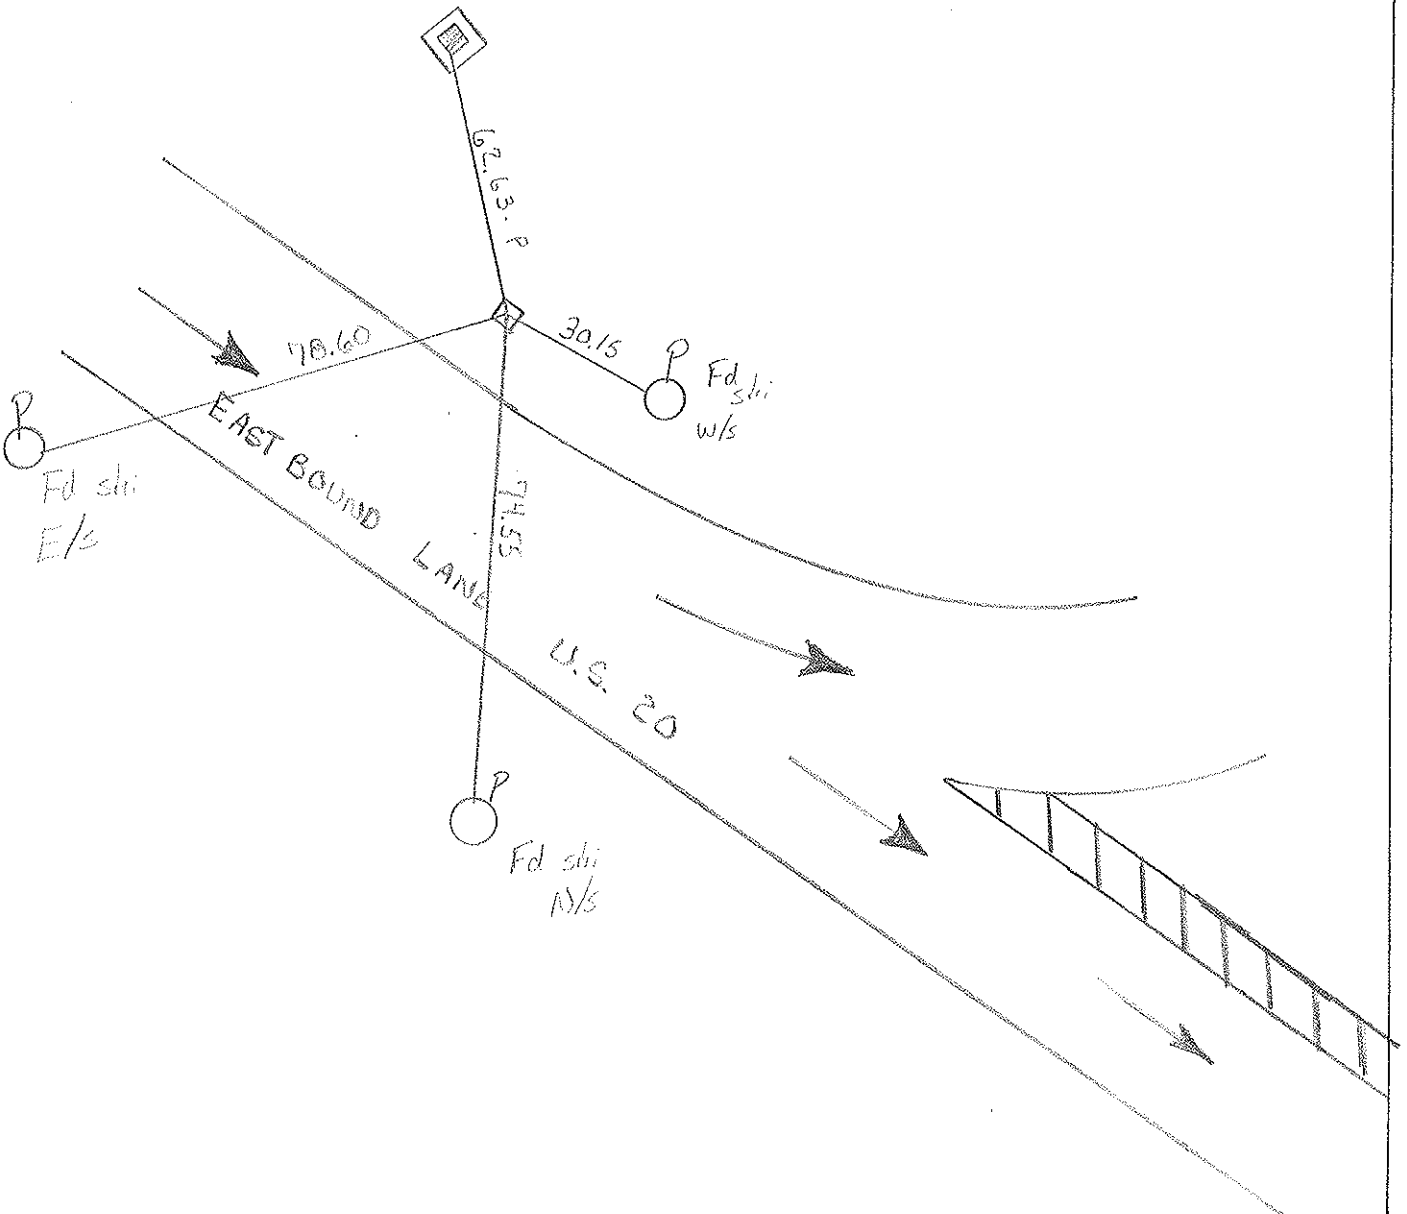

Resurfaced 1996

O.D.O.T. DISTRICT 2 SURVEY OFFICE

PERSONNEL

REFERENCE NO. 41

SHEET      OF     

NOTES BARNHISEL

H.C. HOFFMAN

R.C. LOEHRKE

DATE MAY 21, 1986

WEATHER cloudy

TEMP. +50

ROUTE U.S. 20

COUNTY WOOD

TOWNSHIP Troy

SECTION     

T 6 N R 12 E

TYPE MONUMENT 1" IRON ROD IN MON. BOX


ON SURFACE - BELOW yes

LEFT- & PAV'T. - RIGHT     

3.4 FT TO LT EDGE PAVEMENT curbing

S.L.M. 587+89

R.T. 56	R.T. 57
R.T. 55	R.T. 58

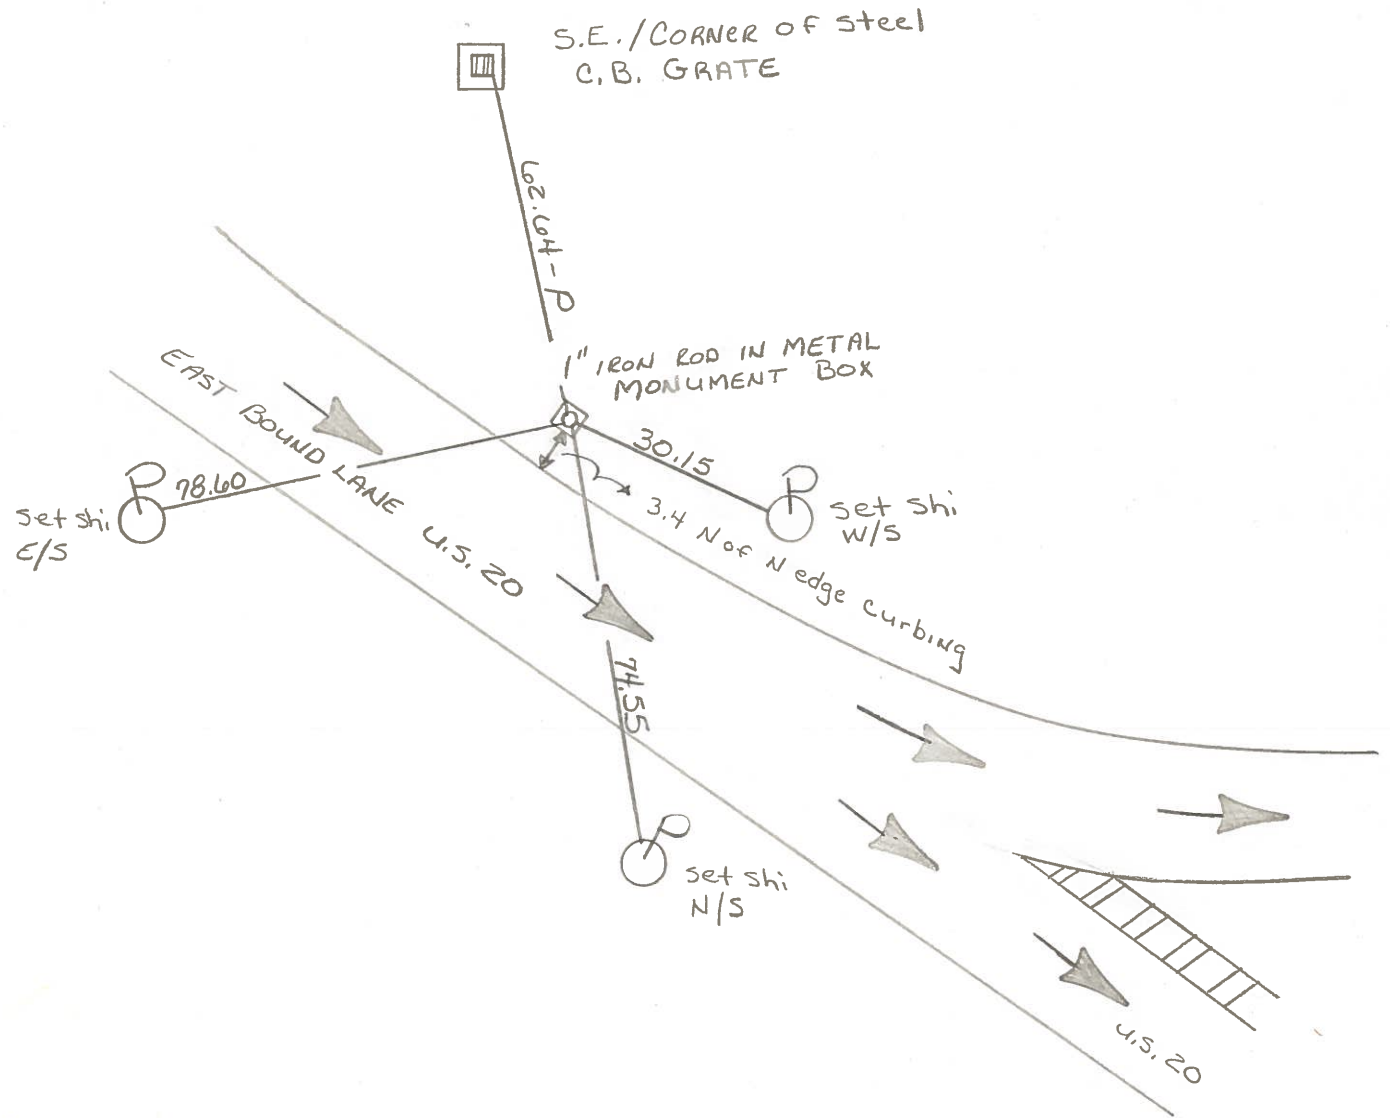

County Wood S.R. U.S. # 20

Date 5/21/80 Drawn 6/5/80

Township Troy

Weather sunny

Section SEC. 10 RT. 56-57

Temp. 75°

T    N, R    E


Personnel CRONIN

RIPPLE

GEYMAN

MOSSER

BARBOUR

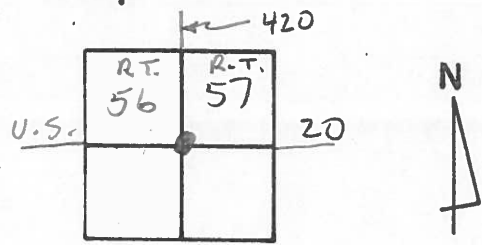


#41

5884 01.10

Fd. 1" rod in metal

monument box

NO ANGLE 0°

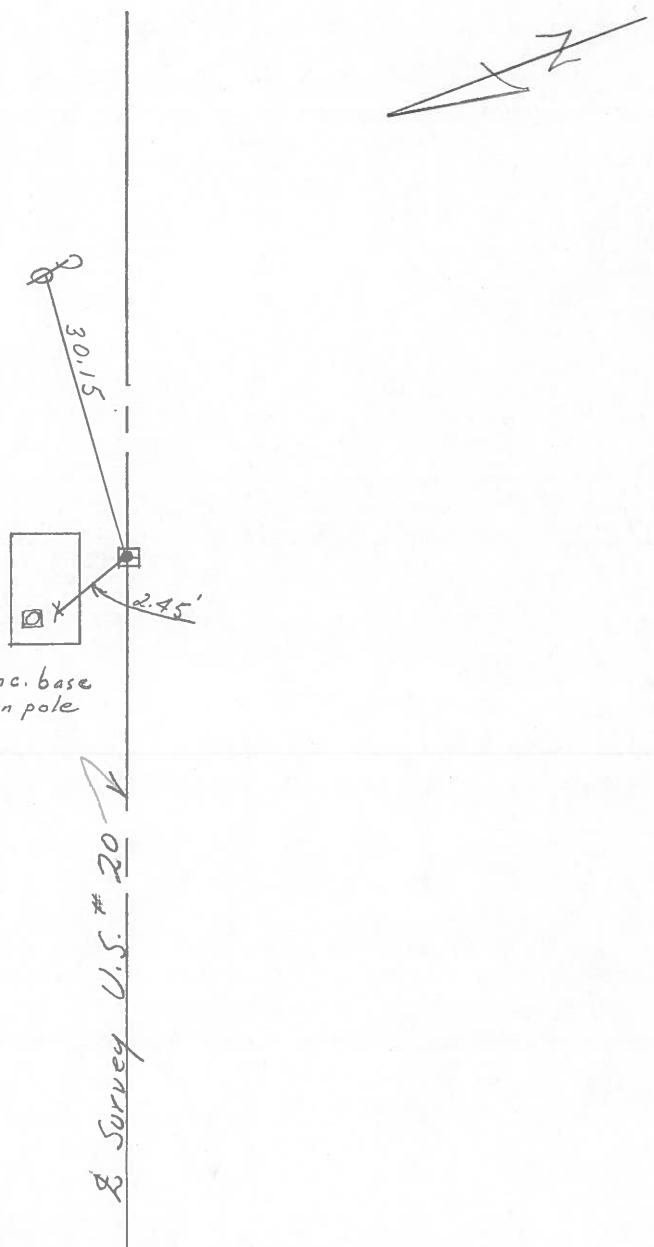


'x' cut in conc. base for metal sign pole

Survey U.S. # 20

PERSONNEL	TITLE	PERSONNEL	TITLE	COUNTY	WOOD	DATE	AUG. 17, 1972
Tomsic		Gancarz		S. R.	U.S. 20	WEATHER	Rechecked - Dec - 23 - 7
Neuser				SEC.		TEMP.	
Vanyo							
Granata							

DESCRIPTION REF. CONTROL PTS. LEFT CENTER LINE RIGHT JOB NO.

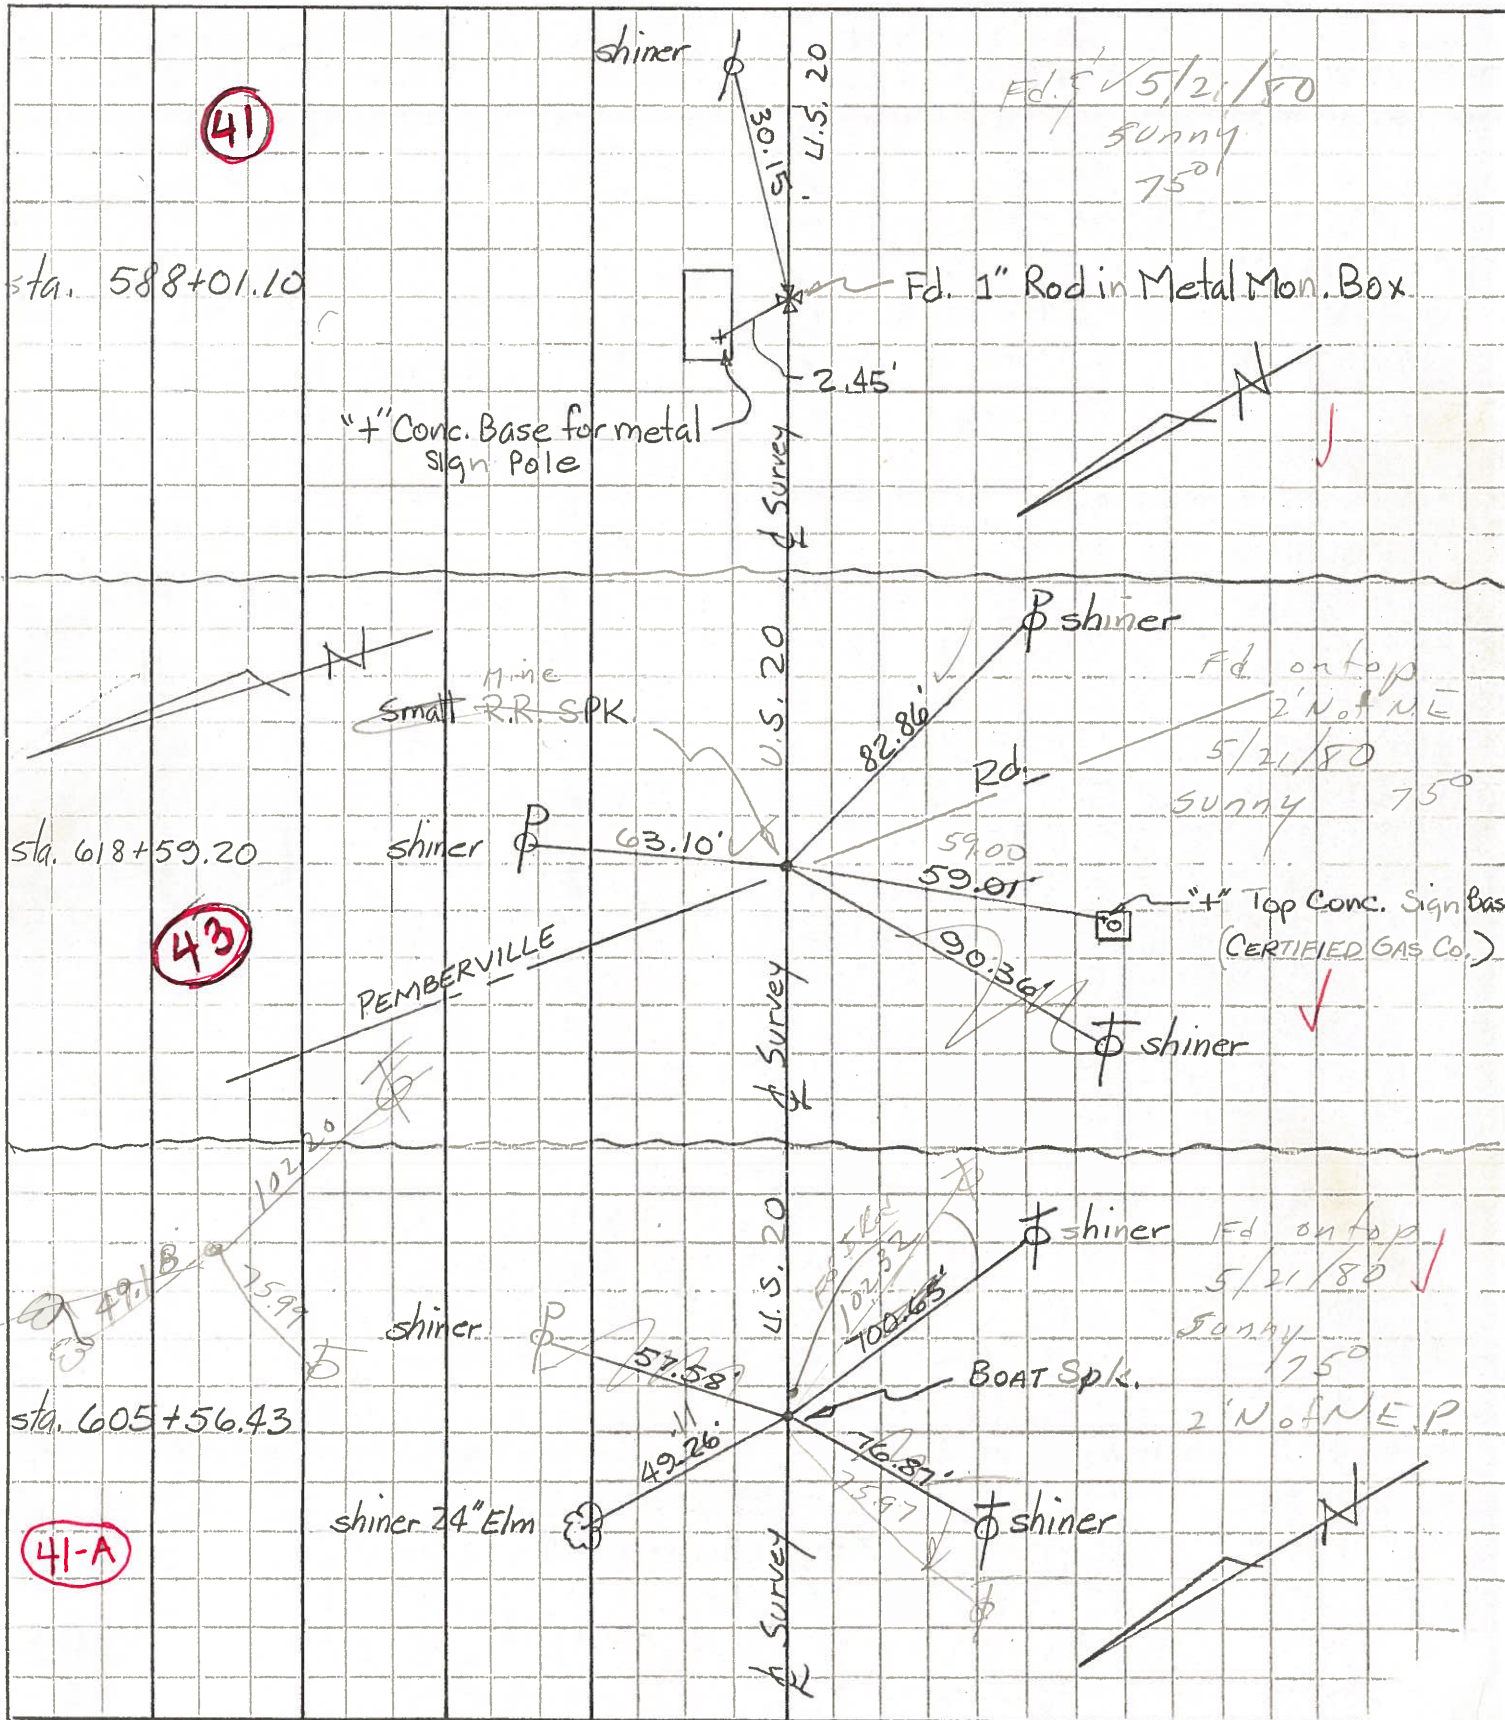

PERSONNEL	TITLE	PERSONNEL	TITLE	COUNTY	DATE
Tomsic		Gancarz		WOOD	AUG. 17, 1972
Neuser				U.S. 20	Rechecked - Dec - 23 - 72
Vanyo					WEATHER
Granata				SEC.	TEMP.

DESCRIPTION	REF. CONTROL PTS.	LEFT	CENTER LINE	RIGHT	JOB NO.
-------------	-------------------	------	-------------	-------	---------

