

O.D.O.T. DISTRICT 2 SURVEY OFFICE (USE ONLY)

PERSONNEL

REFERENCE NO. 41 A

SHEET 1 OF 12

NOTES LOEHRKE
 H.C. ROUSOS
 R.C. CANTERBURY

DATE 5/2/76
 WEATHER FAIR
 TEMP. 50°

ROUTE US 20
 COUNTY WOOD
 TOWNSHIP TROY
 SECTION RT 60
 T 6 N R 12 E

DWG BY NIESE PID _____

TYPE MONUMENT SM.R.R.SPIKE

ON SURFACE - ~~BELOW~~ ON

OFFSET CL PAVEMENT 14.2' LT : ~~RT~~

1.5' LT OF LT EDGE PAVEMENT

STATION: 605+69


HORZ.DATUM: _____ GEOID: _____

GRID: NORTHING: _____ EASTING: _____

RT 60	RT 61
RT 59	RT 62



RECORD:
 FD SM.R.R.SPIKE
 5/2/96, CL
 SET P.K./WASHER
 7/8/96

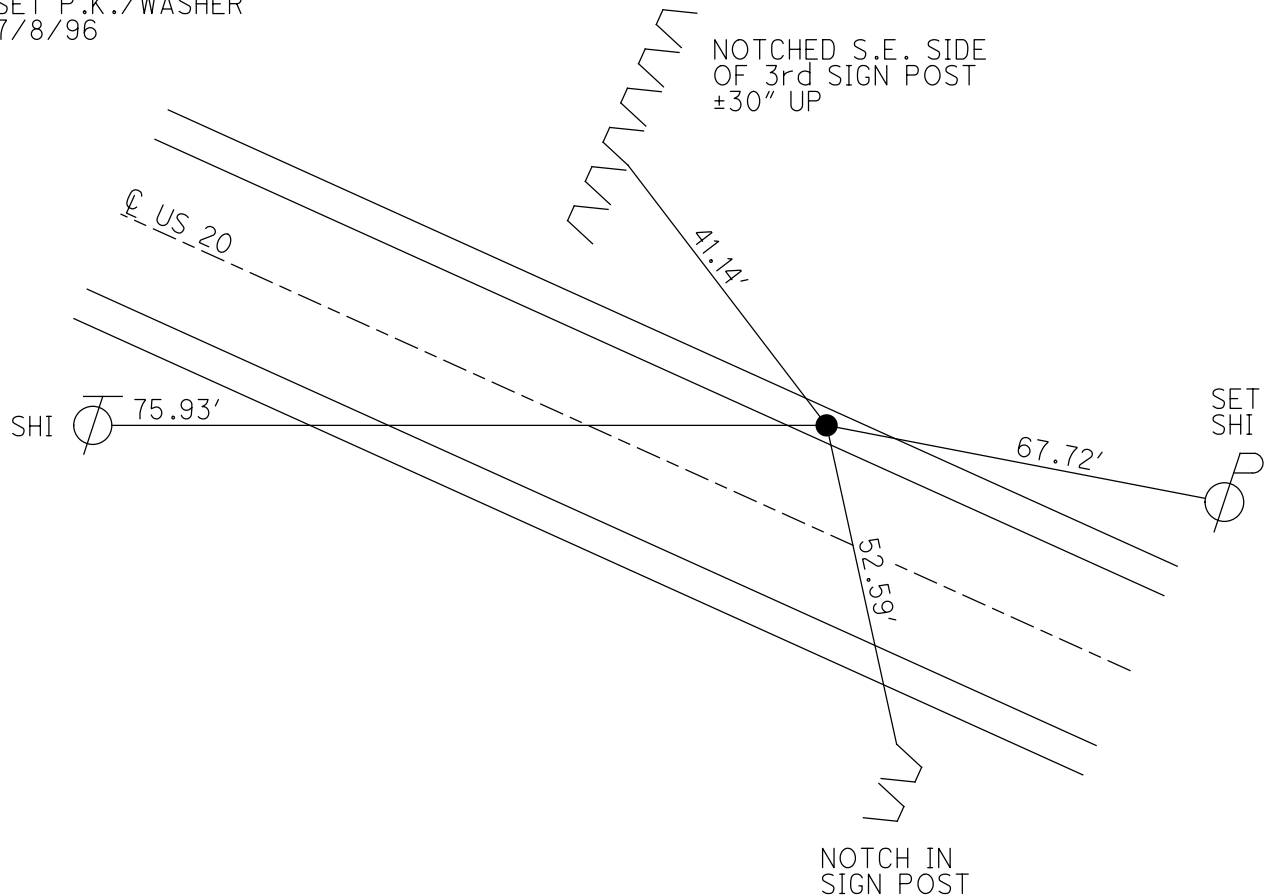

O.D.O.T. DISTRICT 2 SURVEY OFFICE

PERSONNEL _____

REFERENCE NO. 41-A

SHEET 2 OF 13

NOTES LEHRKE

H.C. Russas

DATE 5-2-96

ROUTE U.S. 20

R.C. CAULFIELD

WEATHER FAIR

COUNTY Wood

TEMP. +50°

TOWNSHIP TROY

SECTION _____

T 6 N R 12 E

TYPE MONUMENT Sm. R.R. Spike

Set P.K./WASHER
7-8-96

ON SURFACE - BELOW Yes


LEFT - & PAV'T. - RIGHT 14.2

R.T. 60	60
R.T. 59	59



1.5 ft TO 0 ft EDGE PAVEMENT

S.L.M. 6051 69

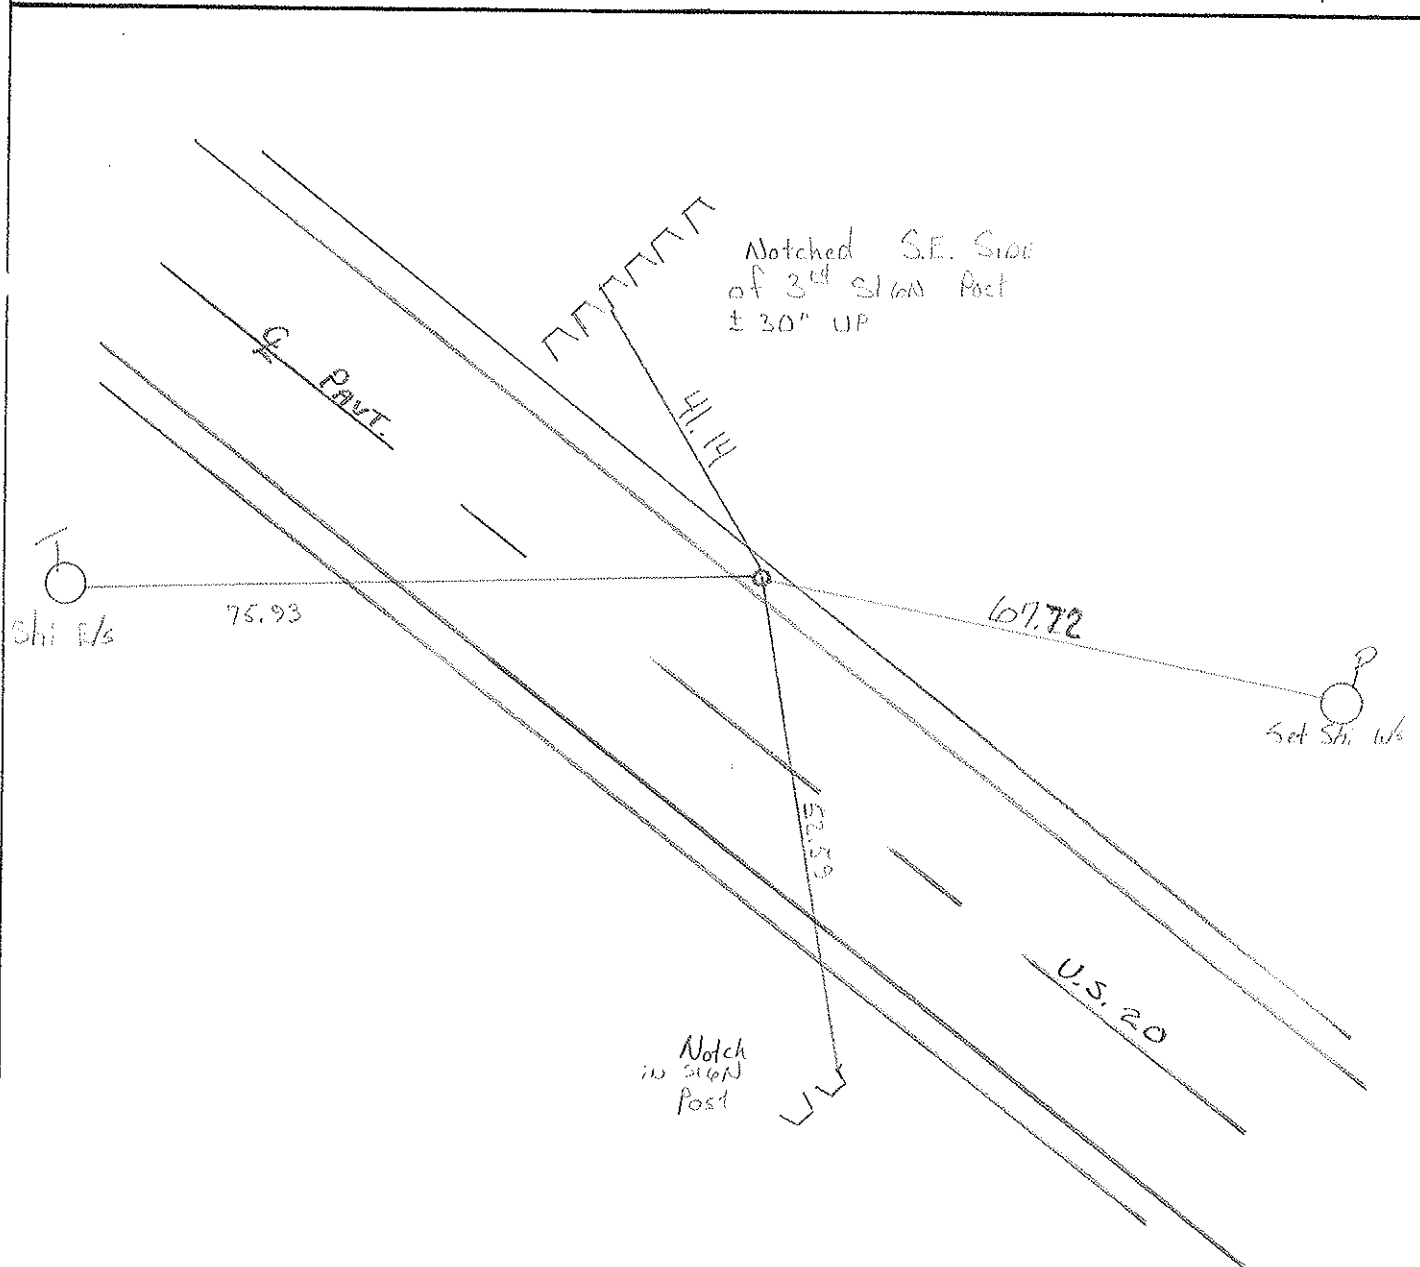

O.D.O.T. DISTRICT 2 SURVEY OFFICE

PERSONNEL

REFERENCE NO. 41-A

SHEET _____ OF _____

NOTES BARNHISEL

H.C. HOFFMAN

R.C. Loehrke

DATE 6-25-86

WEATHER SUNNY

TEMP. +65°

ROUTE U.S. 20

COUNTY WOOD

TOWNSHIP Teoy

SECTION 10 R.T. 59+60

T 6 N 12 E

TYPE MONUMENT Bolt Spk

ON SURFACE - ~~BELOW~~ yes


LEFT - ~~C~~ PAV'T. - RIGHT 13.2

Z'L TO Lt EDGE PAVEMENT

S.L.M. 605+43

Set Sm RR Spk
6-25-86
MDB

R.T. 57	R.T. 60
R.T. 58	R.T. 59

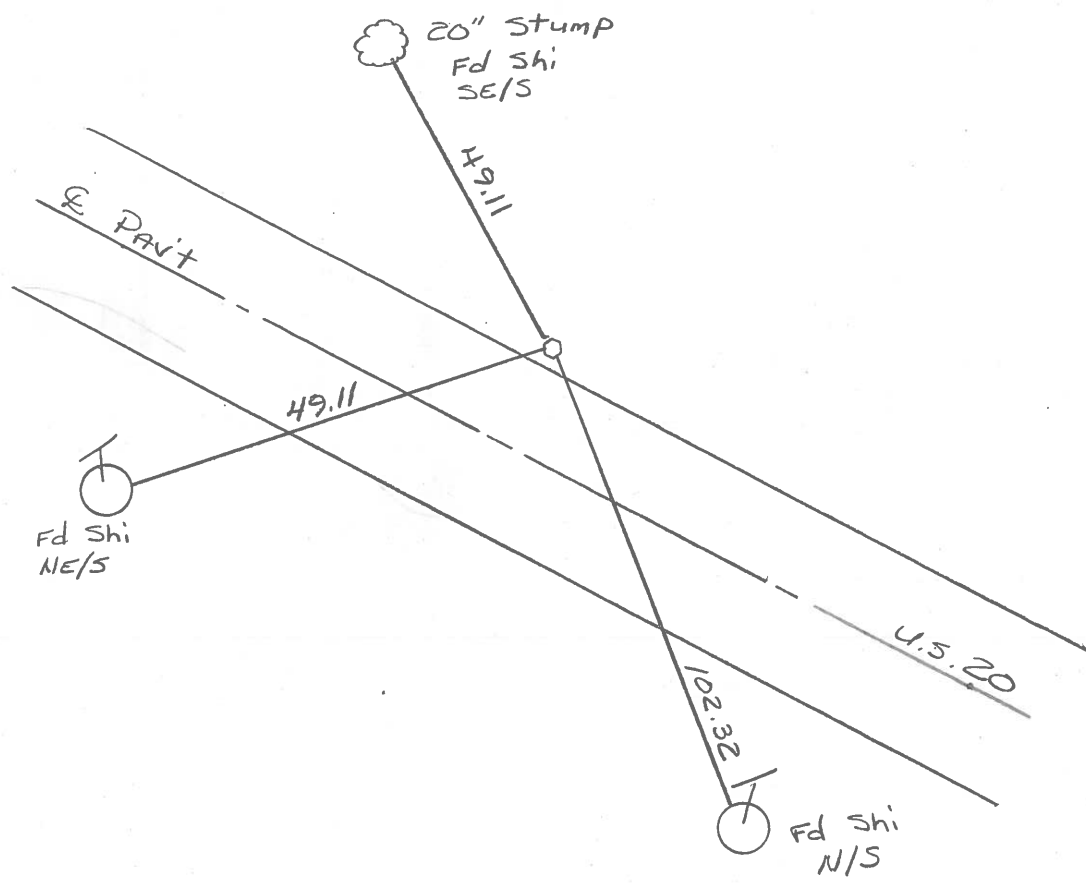

County Wood S.R. U.S. # 20

Date 5/21/80 Drawn 6/5/80

Township Tiny

Weather sunny


Section 10 - R.T. 58-59

Temp. 75°

T6N, R12E

Personnel CRONIN
RIPPLE
GEYMAN
MOSSER
BERBOUR

R.T. 57	R.T. 60
R.T. 58	R.T. 59

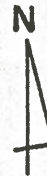


41-A

straight line is 0.17' south of this point

605 + 56.43

Ed bolt spike on top of
2' N of N edge of point

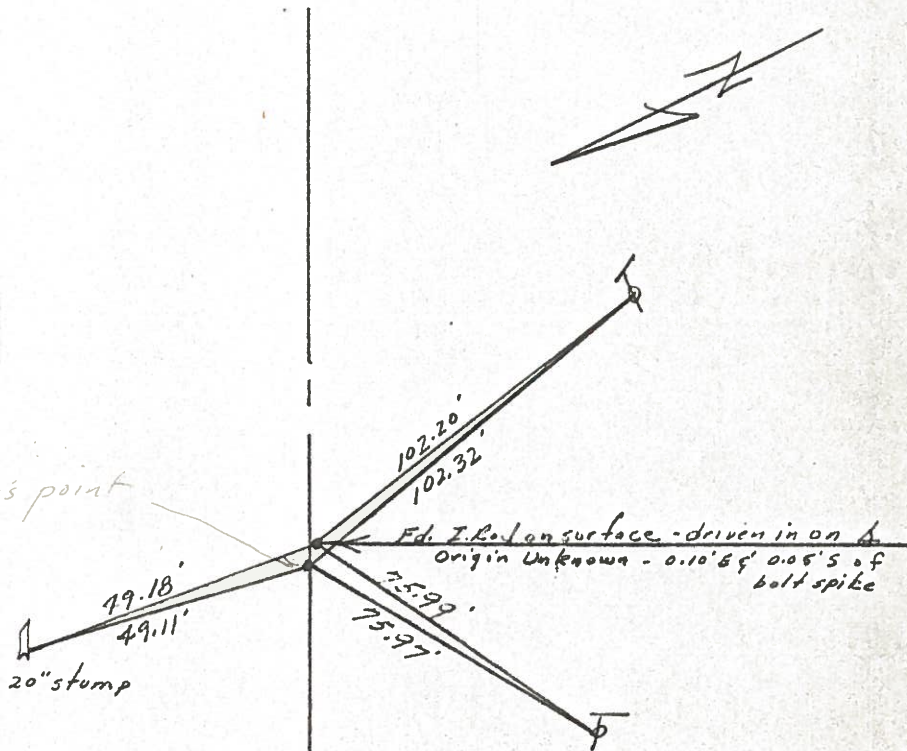


S. Survey U.S. # 20

PERSONNEL	TITLE	PERSONNEL	TITLE
Tomsic		Gancarl	
Neuser			
Vanyo			
Granata			

COUNTY WOOD DATE AUG. 17, 1972
 S. R. U.S. 20 Rechecked - Dec - 23 -
 WEATHER _____
 SEC. _____ TEMP. _____

DESCRIPTION REF. CONTROL PTS. LEFT CENTER LINE RIGHT JOB NO.

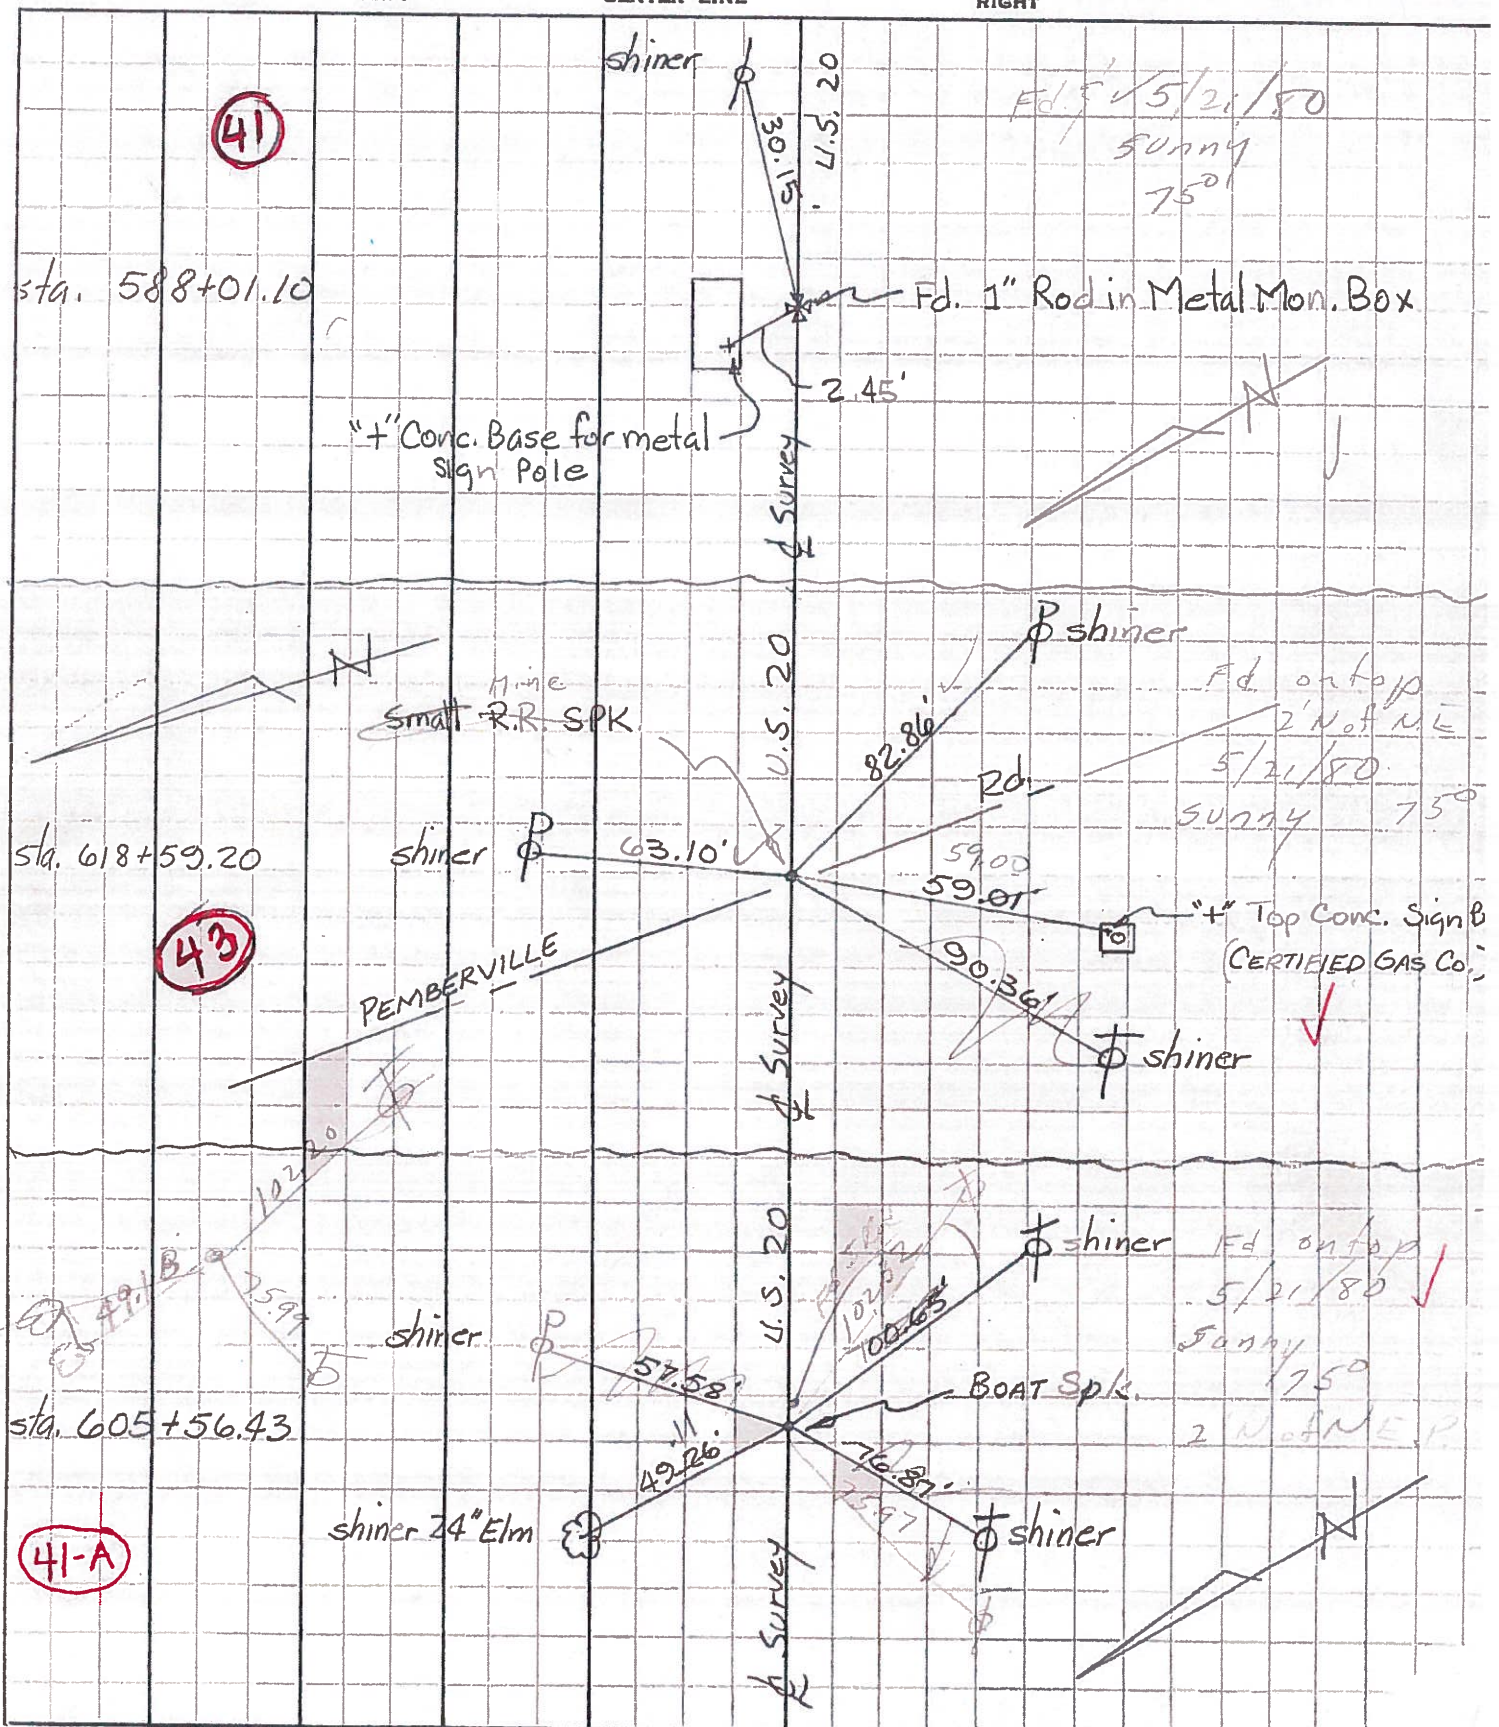

PERSONNEL	TITLE	PERSONNEL	TITLE
Tomsic		Gancarz	
Neuser			
Vanyo			
Granata			

COUNTY WOOD DATE AUG. 17, 1972
 S. R. U.S. 20 Rechecked - Dec - 23.
 WEATHER _____
 SEC. _____ TEMP. _____

DESCRIPTION REF. CONTROL PTS.

JOB NO. _____

