

O.D.O.T. DISTRICT 2 SURVEY OFFICE

PERSONNEL _____

REFERENCE NO. 44

SHEET 4 OF 13

NOTES LOENRVC

H.C. PAVCOE

R.C. CANNON

DATE 5-2-96

WEATHER FAB

TEMP. 72.00

ROUTE U.S. 20

COUNTY WOOD

TOWNSHIP TROY

SECTION R.T. 61 & 62

T 6 N R 12 E

Set P.K./WASHER
7-8-96
CL


TYPE MONUMENT Stn. 2 P. Spk.

ON SURFACE - BELOW yes

LEFT - & PAV'T. - RIGHT 13.1


1.6 TO LT EDGE PAVEMENT

S.L.M. 630+13

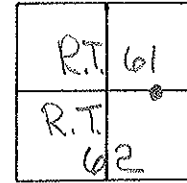

RECORD

P.O.T. Sta 630+26.53

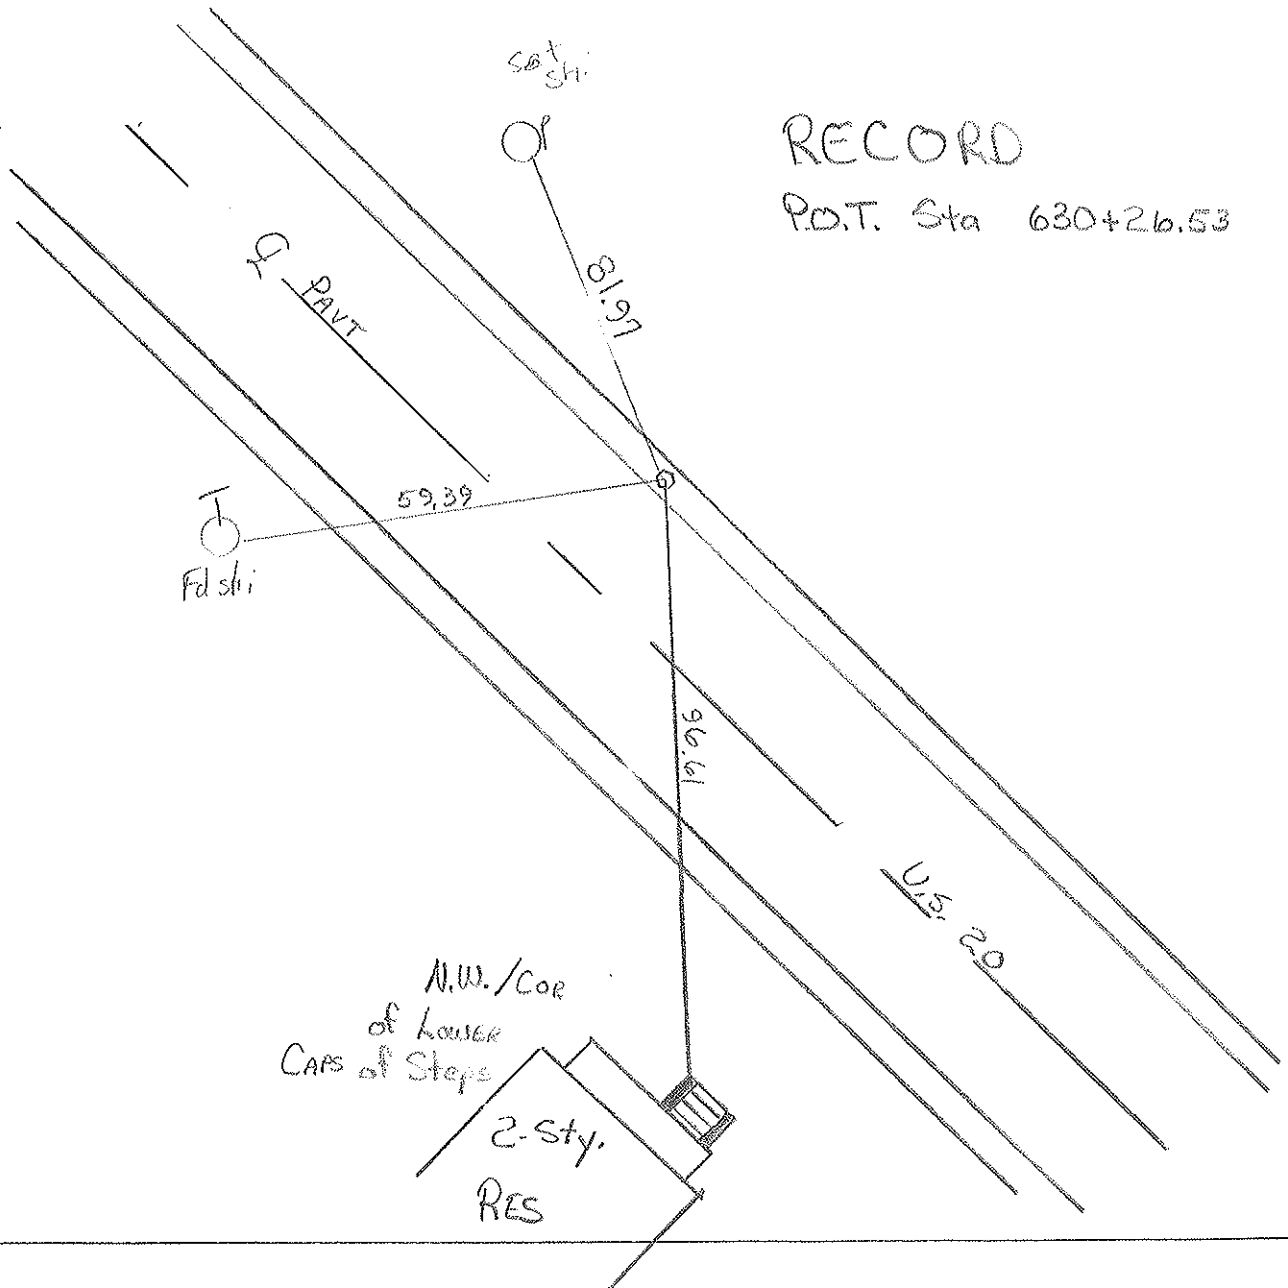

O.D.O.T. DISTRICT 2 SURVEY OFFICE

PERSONNEL

REFERENCE NO. 44 SHEET OF

NOTES BARNHISEL

H.C. HOFFMAN

R.C. Loehrke

DATE May 21, 1986

WEATHER Cloudy

TEMP. +45°

ROUTE U.S. 20

COUNTY Wood

TOWNSHIP Troy

SECTION R.T. 61, 62

T 6 N R 12 E

TYPE MONUMENT Sm RR Spk

ON SURFACE - ~~BELOW~~ yes


LEFT- & PAV'T. - RIGHT 13.0

1.9 Lt TO Lt EDGE PAVEMENT

S.L.M. 630 + 13

Set Sm RR Spk
6-23-86
MAB

R.T. 61	R.T. 64
R.T. 62	R.T. 63

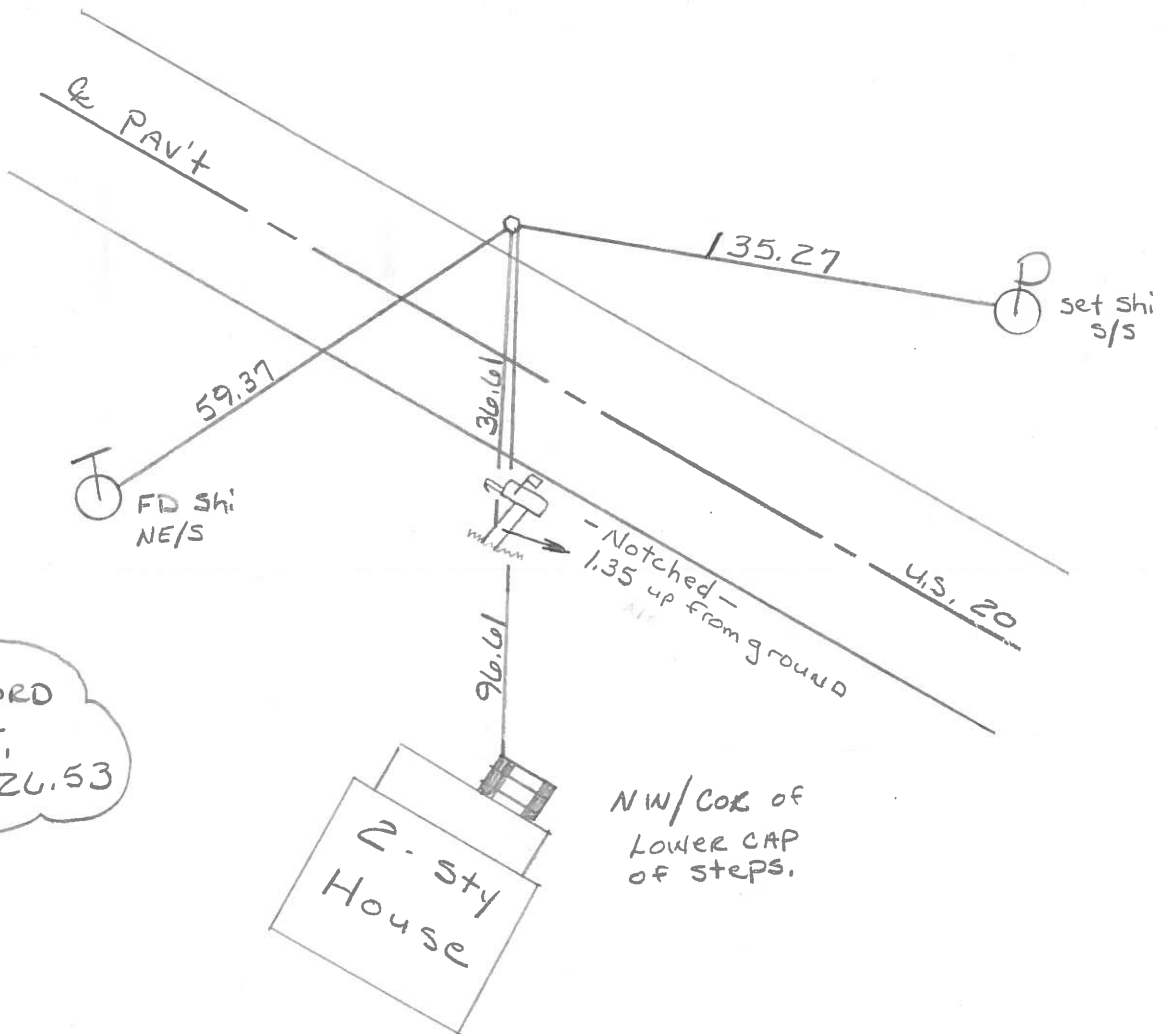

Record
P.O.T.
630 + 26.53

County Wood S.R. U.S. #20

Date 5/22/80 Drawn 6/5/80

Township Troy

Weather sunny

Section 11-14-R.T. 61-62

Temp. 82°

T_N, R_E

Personnel ARONIN SCHNEIDER

RIDDLE MOSSER

GEYMAN BARBOUR

R.T. 61	R.T. 64
R.T. 62	R.T. 63





#44

P.O.-T,

630 + 26.53

Fd. bolt spike on top,
2' N of N edge of pavmt.

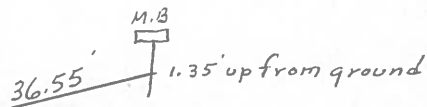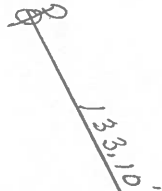


Survey U.S. # 20 R




PERSONNEL	TITLE	PERSONNEL	TITLE	COUNTY	WOOD	DATE	AUG. 22, 1972
Tomsic		Gancart		S. R.	U. S. 20	Rechecked	Dec. 23-7.
Neuser				SEC.		WEATHER	
Vanyo							
Granata							

DESCRIPTION REF. CONTROL Pts. LEFT CENTER LINE RIGHT JOB NO.

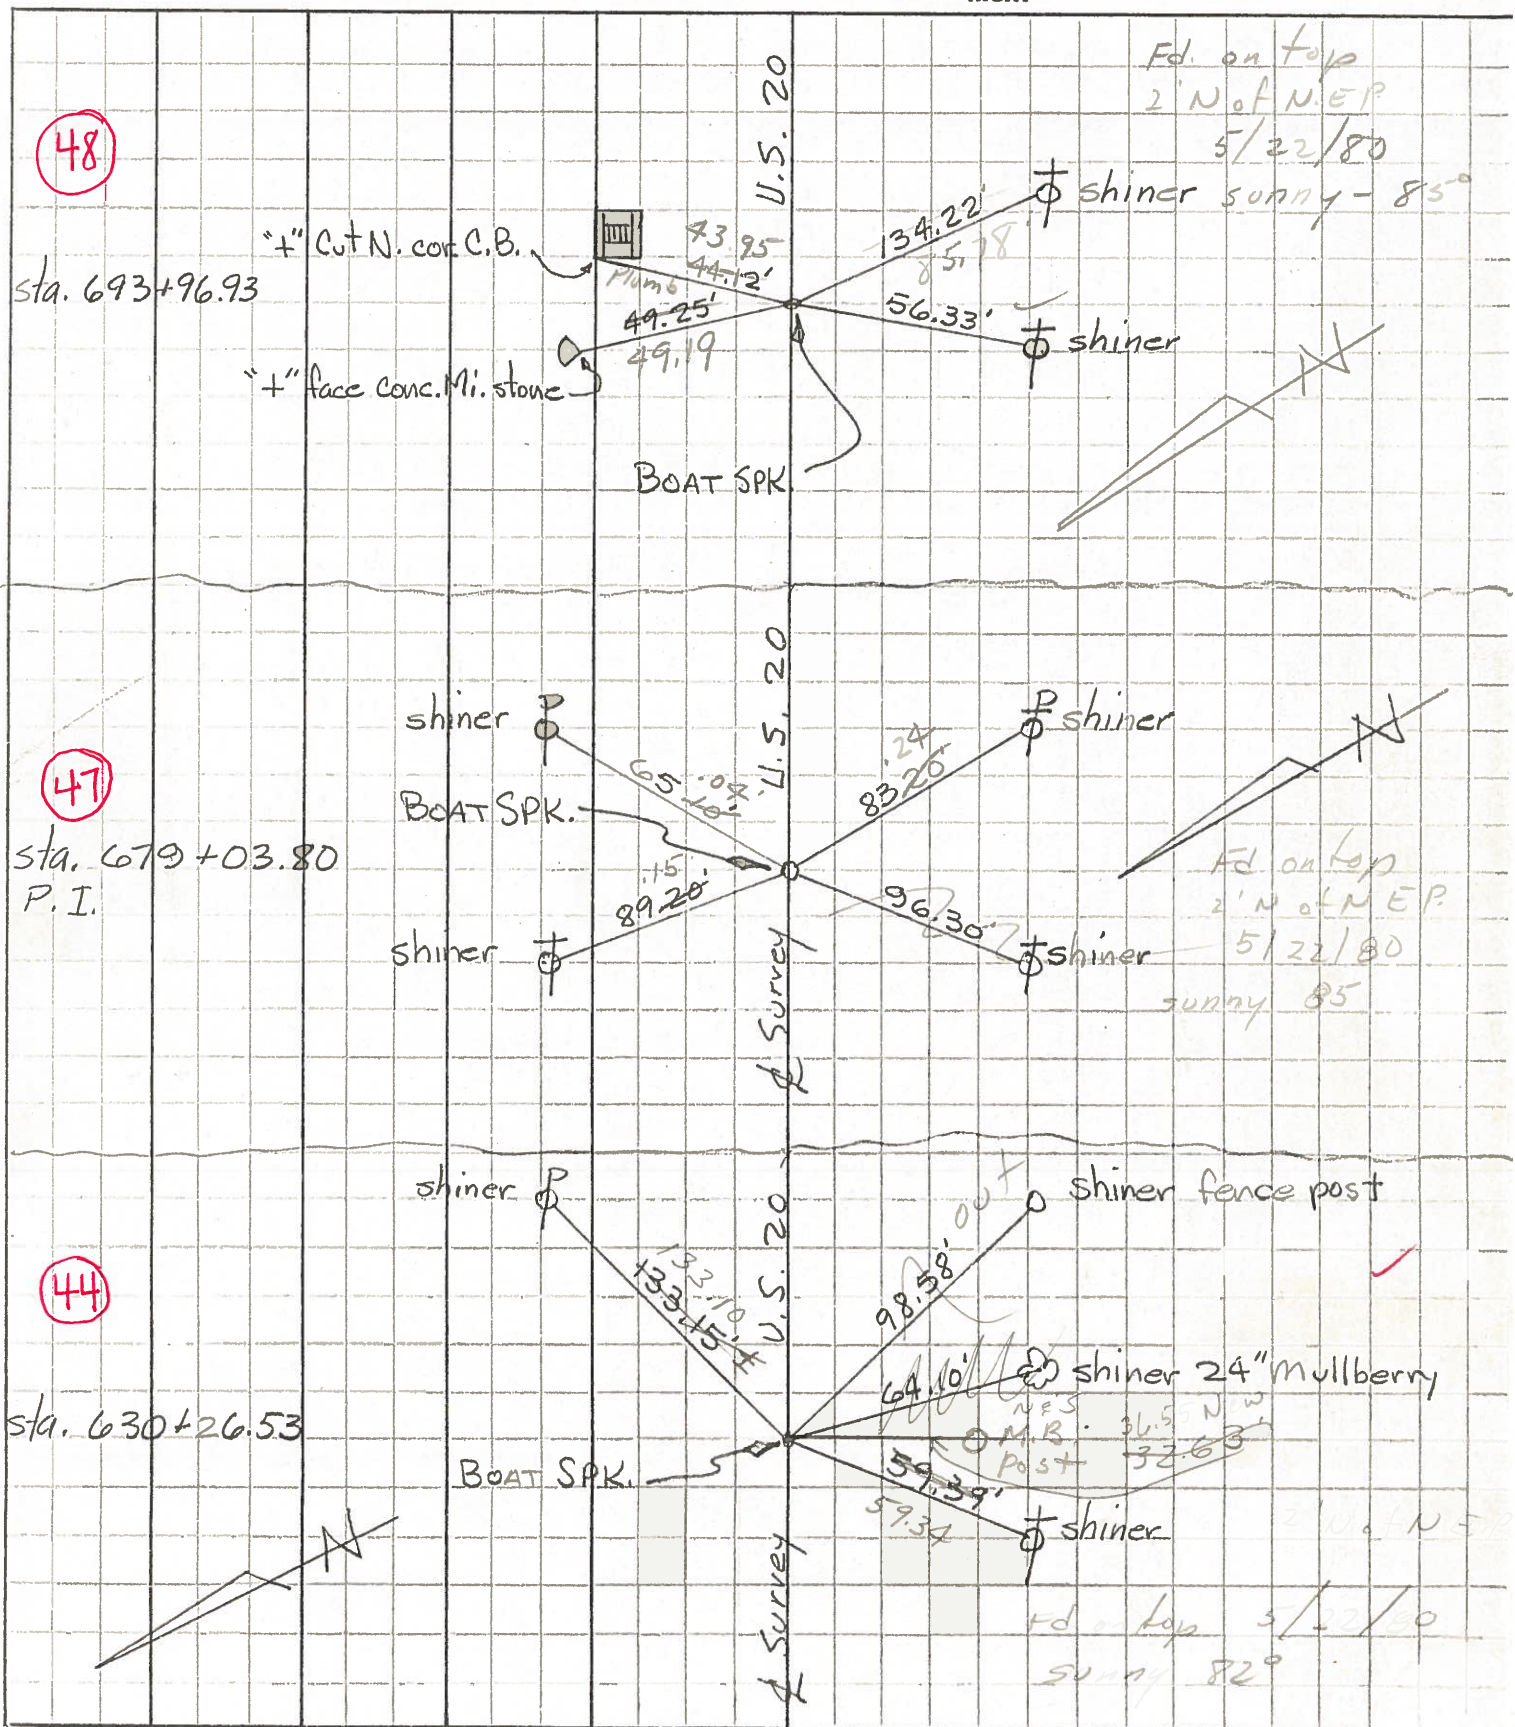

PERSONNEL	TITLE	PERSONNEL	TITLE	COUNTY	DATE
Tomsic		Gancarz		WOOD	Aug. 22, 1972
Neuser				U.S. 20	Rechecked - Dec. 23-75
Vanyo					WEATHER
Granata				SEC.	TEMP.

DESCRIPTION REF. CONTROL Pts. LEFT CENTER LINE RIGHT JOB NO.

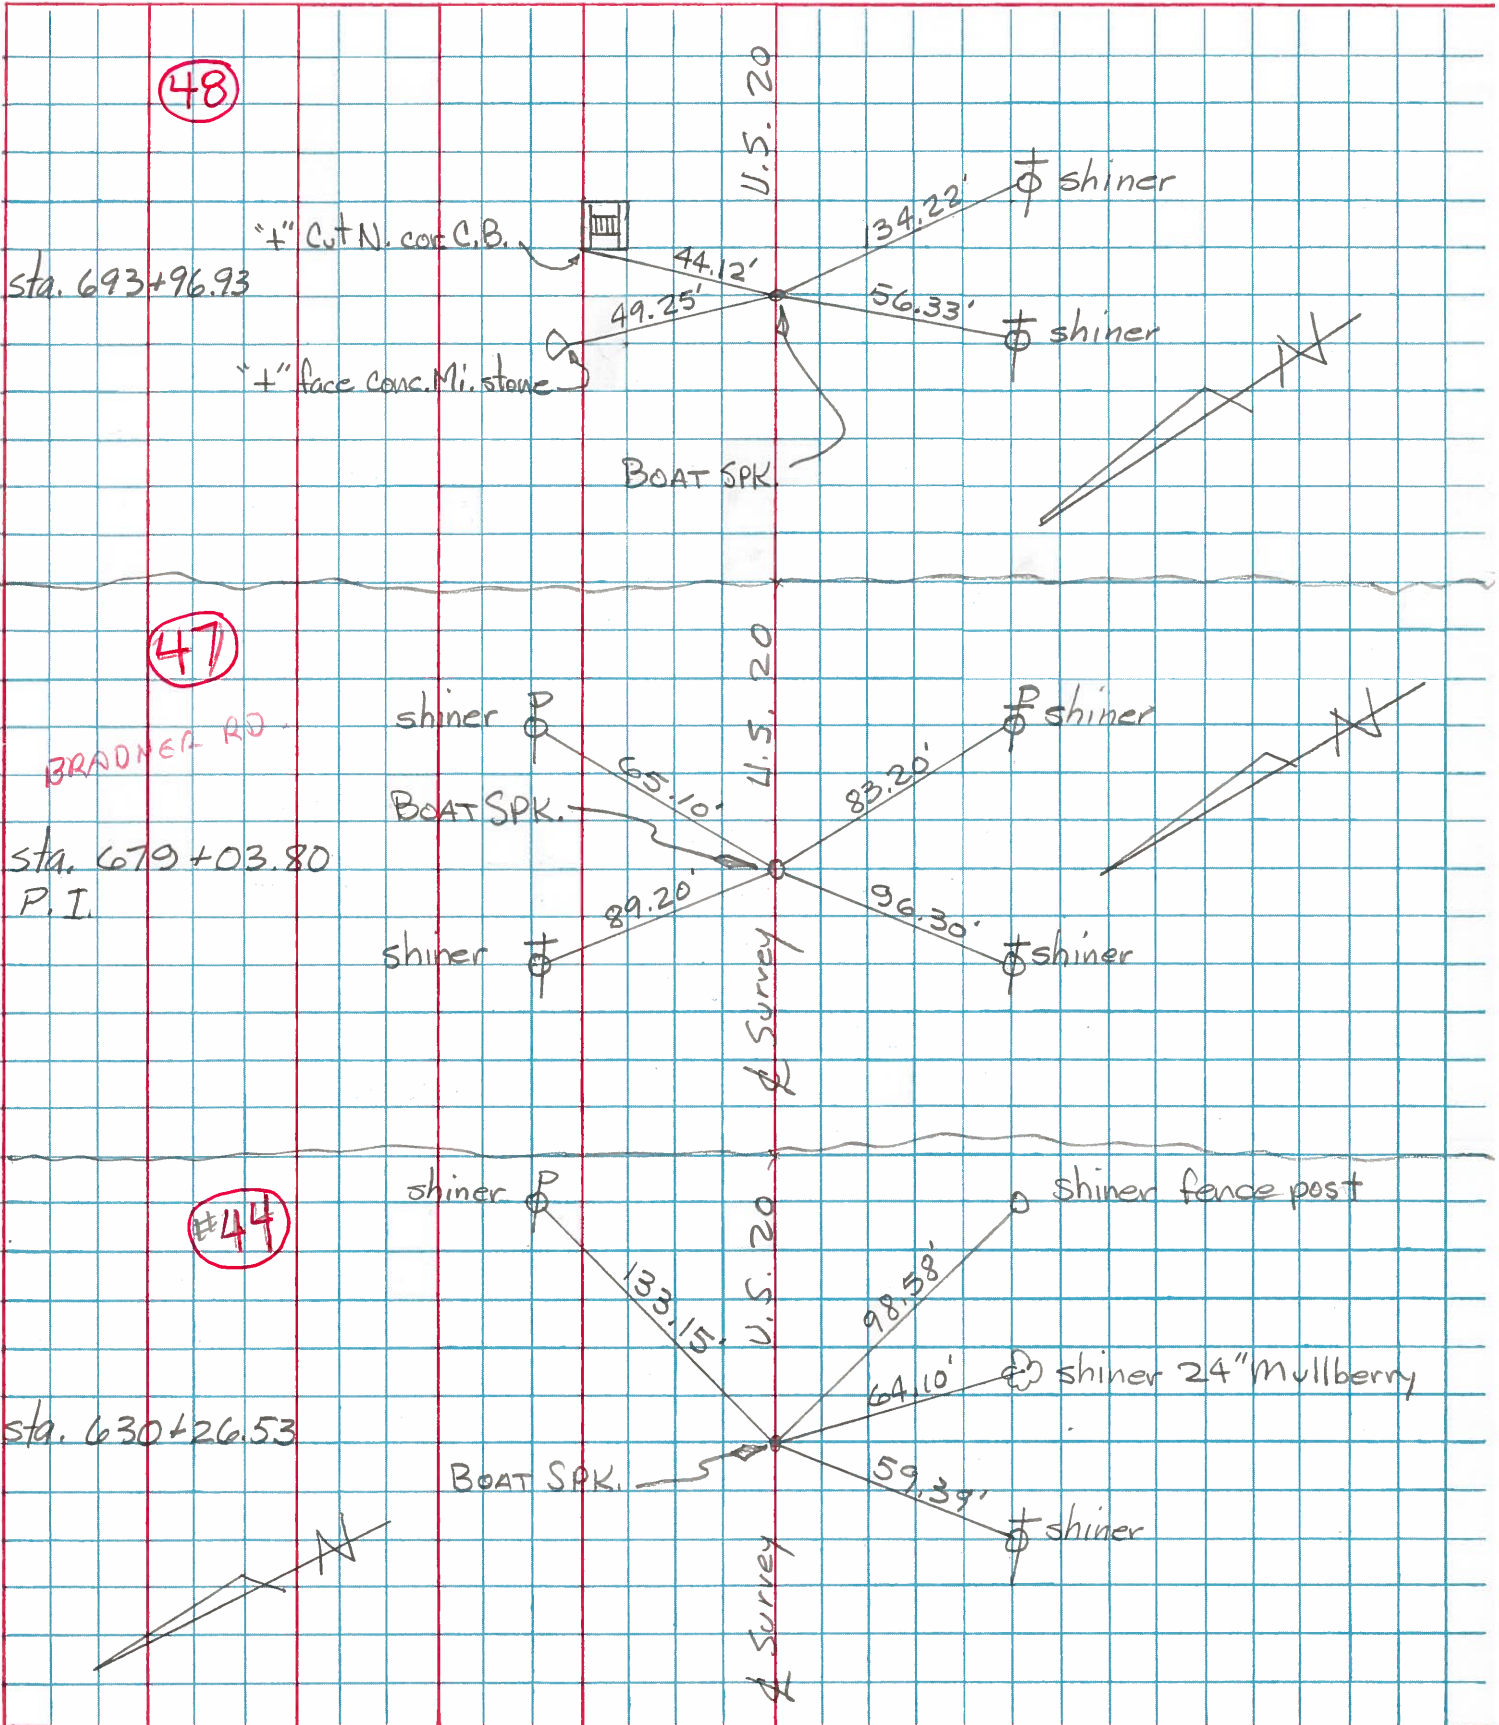

O.D.O.T. DISTRICT 2 SURVEY OFFICE (USE ONLY)

PERSONNEL _____ REFERENCE NO. 44 SHEET 3 OF 12
 NOTES LOEHRKE DATE 5/2/96 ROUTE US 20
 H.C. ROUSOS WEATHER FAIR COUNTY WOOD
 R.C. CANTERBURY TEMP. 52° TOWNSHIP TROY
 SECTION RT 61
 DWG BY NIESE PID _____ T 6 N R 12 E

TYPE MONUMENT SM.R.R.SPIKE

ON SURFACE - ~~BELOW~~ ON _____

OFFSET CL PAVEMENT 13.1' LT : ~~RT~~

1.6' LT OF LT EDGE PAVEMENT

STATION: 630+13

HORZ.DATUM: _____ GEOID: _____

GRID: NORTHING: _____ EASTING: _____

RT 60	RT 61
RT 59	RT 62



RECORD: P.O.T.
 STA 630+26.53
 FD SM.R.R.SPIKE
 5/2/96, CL
 SET P.K./WASHER
 7/8/96, CL

