

O.D.O.T. DISTRICT 2 SURVEY OFFICE (USE ONLY)

PERSONNEL

REFERENCE NO. 45

SHEET 4 OF 12

NOTES LOEHRKE

DATE 5/2/96

ROUTE US 20

H.C. ROUSOS

WEATHER FAIR

COUNTY WOOD

R.C. CANTERBURY

TEMP. 50°

TOWNSHIP TROY

SECTION RT 64

DWG BY NIESE PID _____

T 6 N R 12 E

TYPE MONUMENT SM.R.R.SPIKE

ON SURFACE - ~~BELOW~~ ON

OFFSET Q PAVEMENT 12.7' LT : ~~RT~~

1.2' LT OF LT EDGE PAVEMENT

STATION: 643+18


HORZ.DATUM: _____ GEOID: _____

GRID: NORTHING: _____ EASTING: _____

| | |
|----------|----------|
| 64 | RT 65 |
| RT 63 | RT 66 |



RECORD: P.O.T.
STA 642+94.10
FD SM.R.R.SPIKE
5/2/96, CL
SET P.K./WASHER
7/8/96, CL

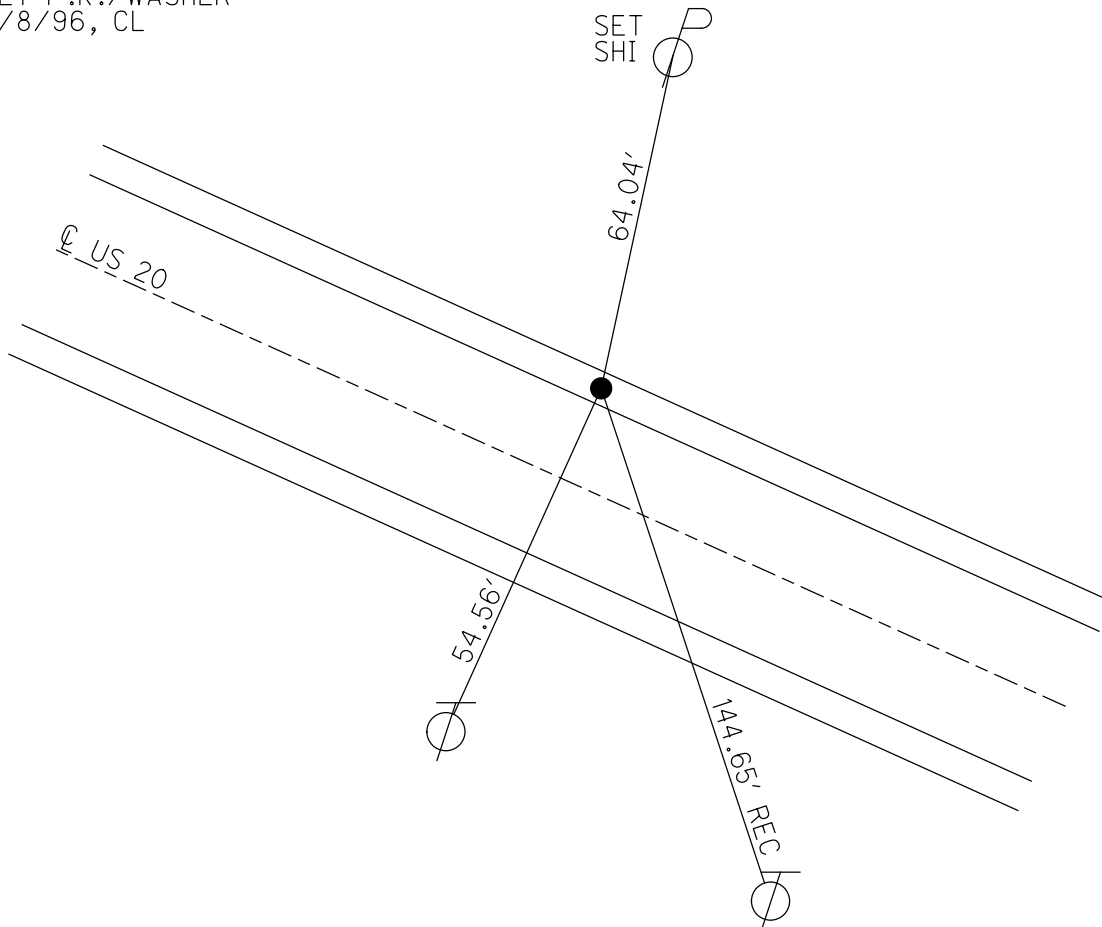

O.D.O.T. DISTRICT 2 SURVEY OFFICE

PERSONNEL _____

REFERENCE NO. 45

SHEET 5 OF 13

NOTES LOEHRKE

H.C. Rousas

R.C. CANTERBURY

DATE 5/2/96

WEATHER FAIR

TEMP. +50°

Set P.K. WASHER
7-8-96
C.L.

ROUTE U.S. 20

COUNTY WOOD

TOWNSHIP TROY

SECTION 14 / RIVER TRACT
63/64

T. 6 N. R. 12 E.

TYPE MONUMENT SM. RR. SPK.


ON SURFACE - BELOW YES

LEFT - C. PAV'T. - RIGHT 12.7

1.2 LT ^{OF} LT EDGE PAVEMENT

S.L.M. 643 + 18

| | | | |
|----|----|----|----|
| | 64 | 65 | 68 |
| 62 | | | |
| | 63 | 66 | 67 |

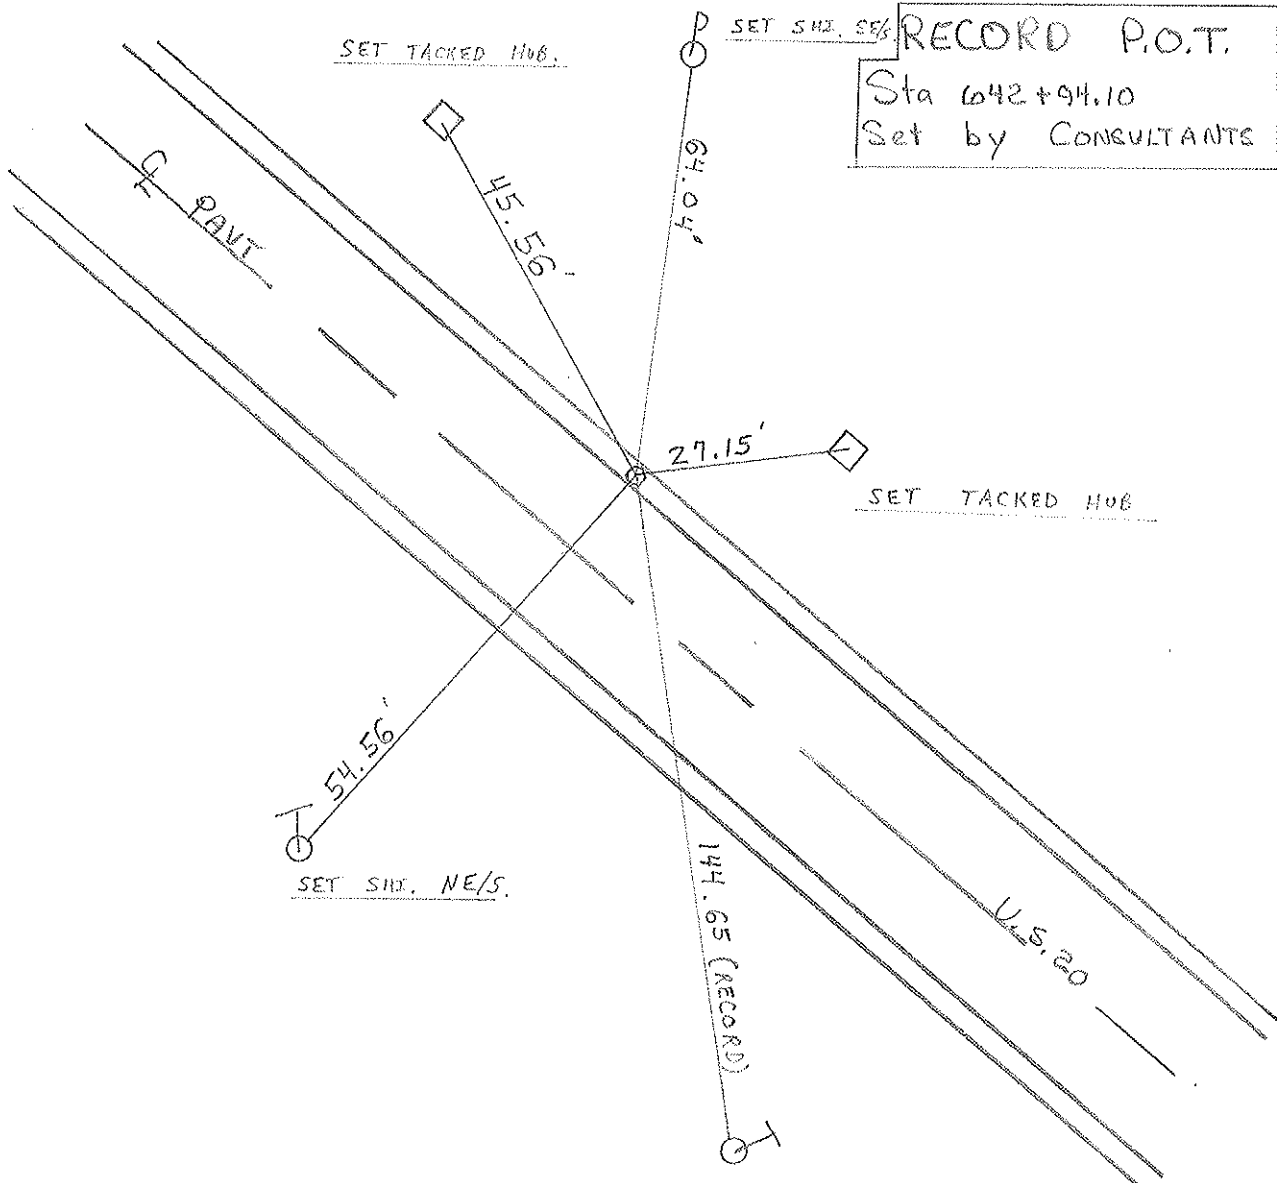

O.D.O.T. DISTRICT 2 SURVEY OFFICE

PERSONNEL

REFERENCE NO. 45 SHEET OF

NOTES BARNHISEL

H.C. HOFFMAN

R.C. Loehrke

DATE May 21, 1986

WEATHER cloudy

TEMP. +45°

ROUTE U.S. 20

COUNTY WOOD

TOWNSHIP Troy

SECTION R.T. 63, 64

T. 6 N R. 12 E (Sec 14)

TYPE MONUMENT RR Spk



ON-SURFACE - BELOW 5"

LEFT- & PAV'T. - RIGHT 12.7

1.5 Lt TO Lt EDGE PAVEMENT

S.L.M. 642+81

Set 5m RR Spk
6-25-86
MDB

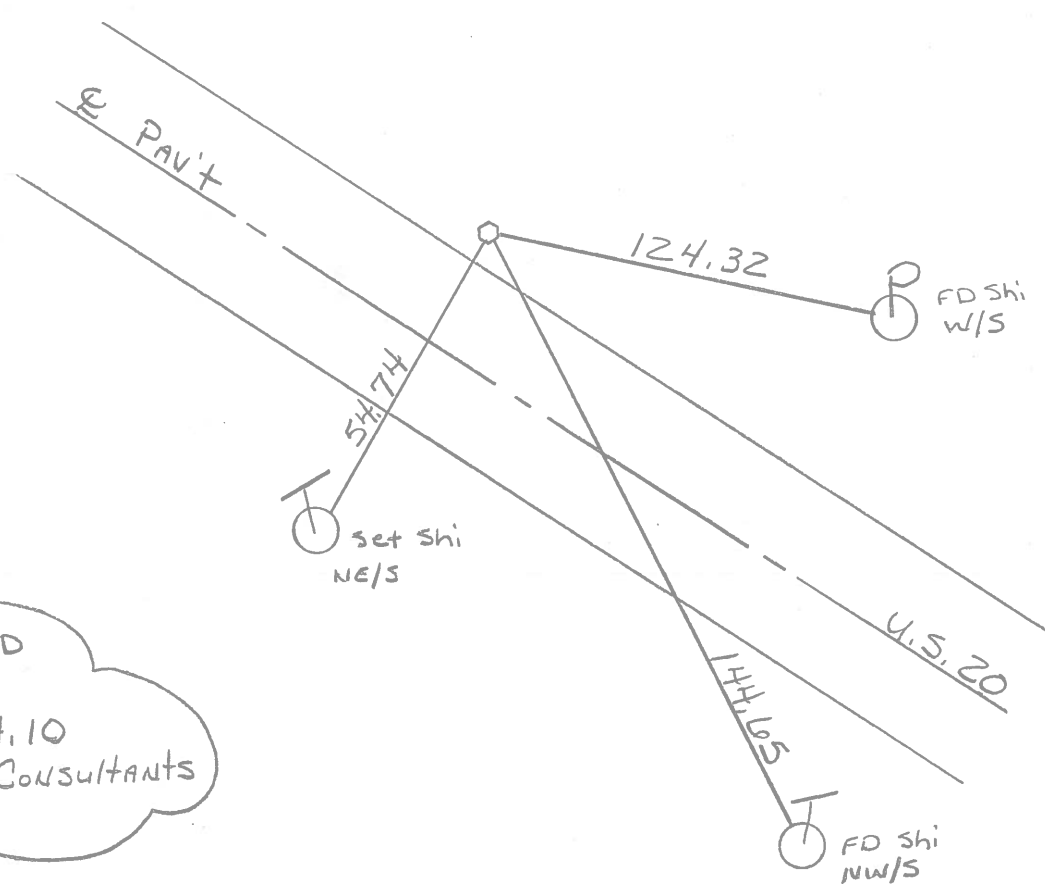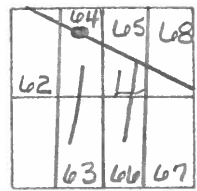

Record
P.O.T.
642+94.10
Set by Consultants

County Wood S.R.U.S.#20

Date 7/23/80

Township Troy

Weather sunny - windy

Section 10

Temp. 72°

T6N, R2E


Personnel CEONIN

RIPPLE

GEYMAN


SCHNEIDER

BARBOUR

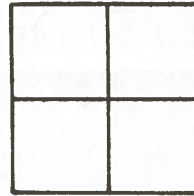

45

P.O.T.
642+94.10
Fd. R.R spike 3" below
surface 2' N. of N. Edge of
pavement. Set by
Consultants

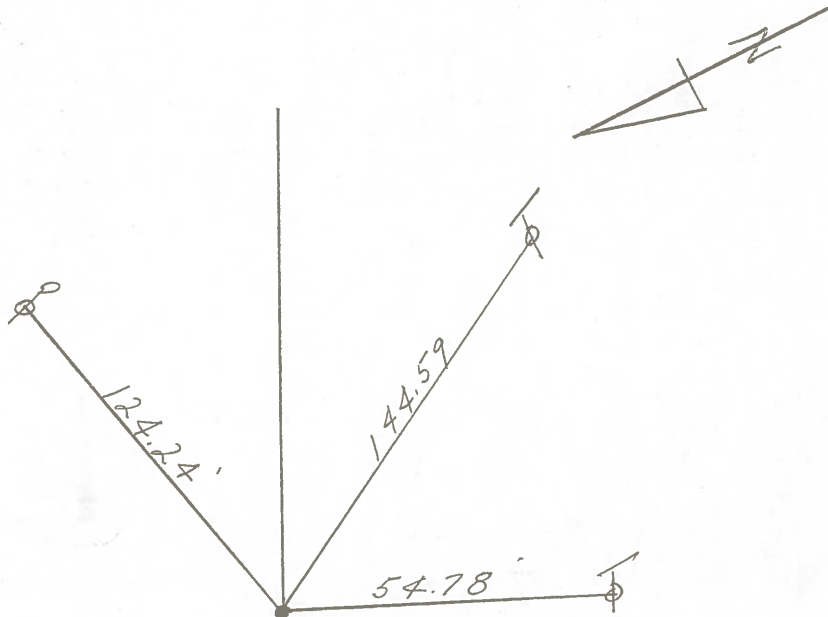

S.R./W U.S. #20