


O.D.O.T. DISTRICT 2 SURVEY OFFICE (USE ONLY)


PERSONNEL _____ REFERENCE NO. 48 SHEET 7 OF 12
 NOTES LOEHRKE DATE 5/2/96 ROUTE US 20
 H.C. ROUSOS WEATHER FAIR COUNTY WOOD
 R.C. CANTERBURY TEMP. 50° TOWNSHIP TROY
 DWG BY NIESE PID _____ SECTION RT 72
 T 6 N R 12 E

TYPE MONUMENT SM.R.R.SPIKE
 ON SURFACE - ~~BELOW~~ ON
 OFFSET \varnothing PAVEMENT 13.0' LT : ~~RT~~
1.6' LT OF LT EDGE PAVEMENT
 STATION: 694+21

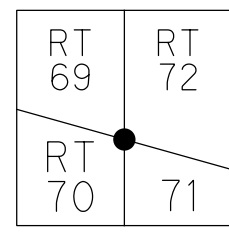

HORIZ.DATUM: _____ GEOID: _____
 GRID: NORTHING: _____ EASTING: _____

RECORD: P.O.T.
 STA 693+96.93
 FD SM.R.R.SPIKE
 5/2/96, CL
 SET P.K./WASHER
 7/8/96

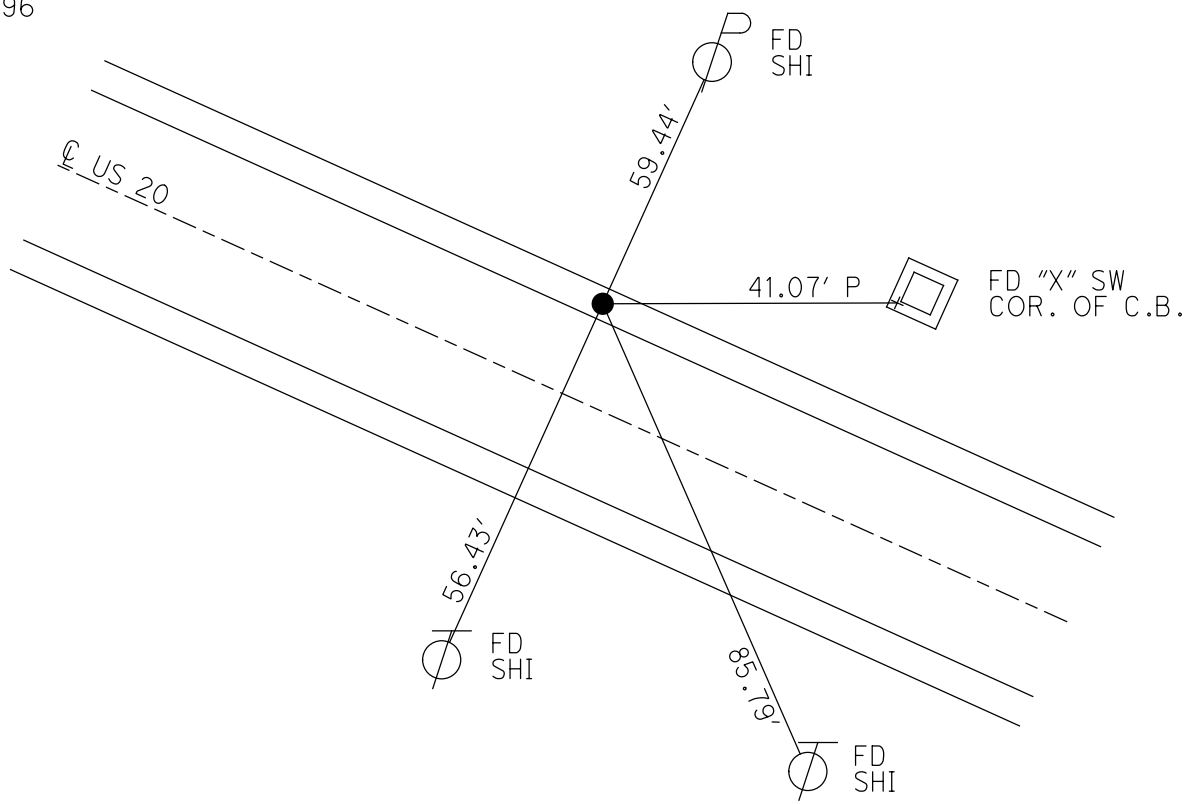

O.D.O.T. DISTRICT 2 SURVEY OFFICE

PERSONNEL _____

REFERENCE NO. 48

SHEET 8 OF 13

NOTES LOEHRKE

H.C. Rousas

R.C. CANTERBURY

DATE 5/2/96

WEATHER FAIR

TEMP. +50°

ROUTE U.S. 20

COUNTY WOOD

TOWNSHIP TROY

SECTION R.T. 71, 72, 73 & 74

T. 6 N. R. 12 E

Set PK/WASHER
T-B-50

TYPE MONUMENT Sm. RR. SPIKE

ON SURFACE - BELOW YES

LEFT - 0 PAV'T. - RIGHT 13.0 LT


1.6 LT ^{OF} TO LT EDGE PAVEMENT

S.L.M. 694 + 21

R.T. 72	R.T. 73
R.T. 71	R.T. 74



RECORD P.O.T.
OLD Sta. 693 + 96.93

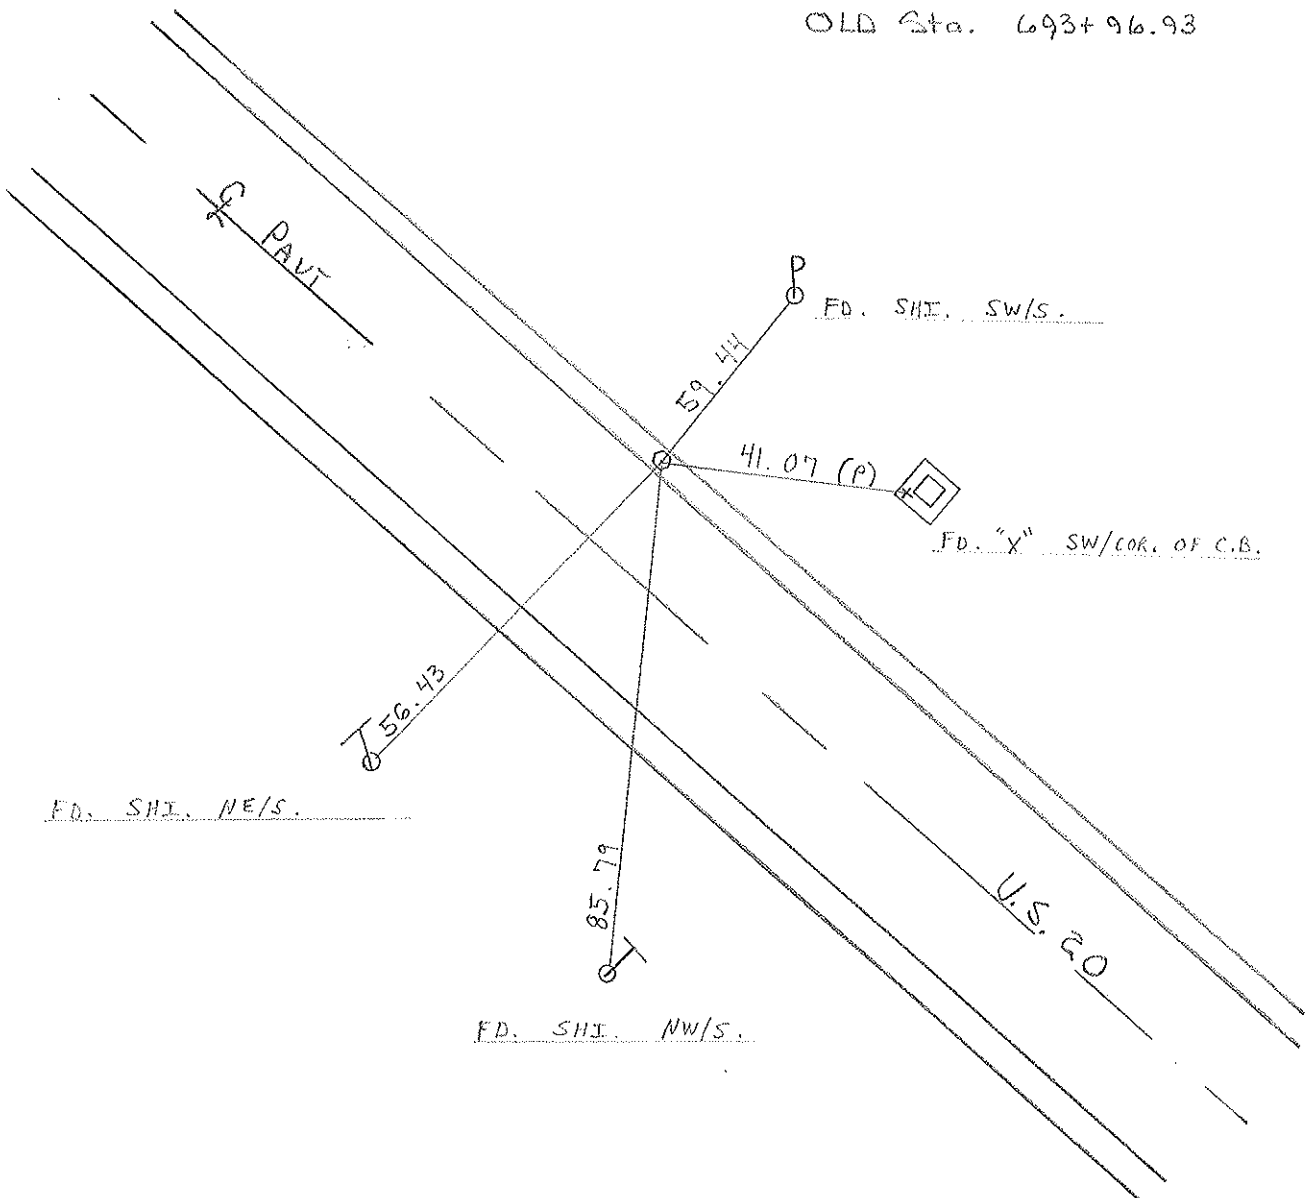

O.D.O.T. DISTRICT 2 SURVEY OFFICE

PERSONNEL _____

REFERENCE NO. 48

SHEET _____ OF _____

NOTES BARNHISEL

H.C. HOFFMAN

R.C. Loehrke

DATE May 23, 1984

WEATHER SUNNY

TEMP. +55°

ROUTE U.S. 20

COUNTY WOOD

TOWNSHIP Troy

SECTION R.T. 71, 72, 73, 74

T6 N R 12 E

TYPE MONUMENT 5m RR Spk

ON SURFACE - BELOW YES


LEFT- & PAV'T. - RIGHT 13.2

2.6 Lt TO Lt EDGE PAVEMENT

S.L.M. 693+84

Set 5m RR Spk
6-25-86
MAB

R.T. 72	R.T. 73
R.T. 71	R.T. 74

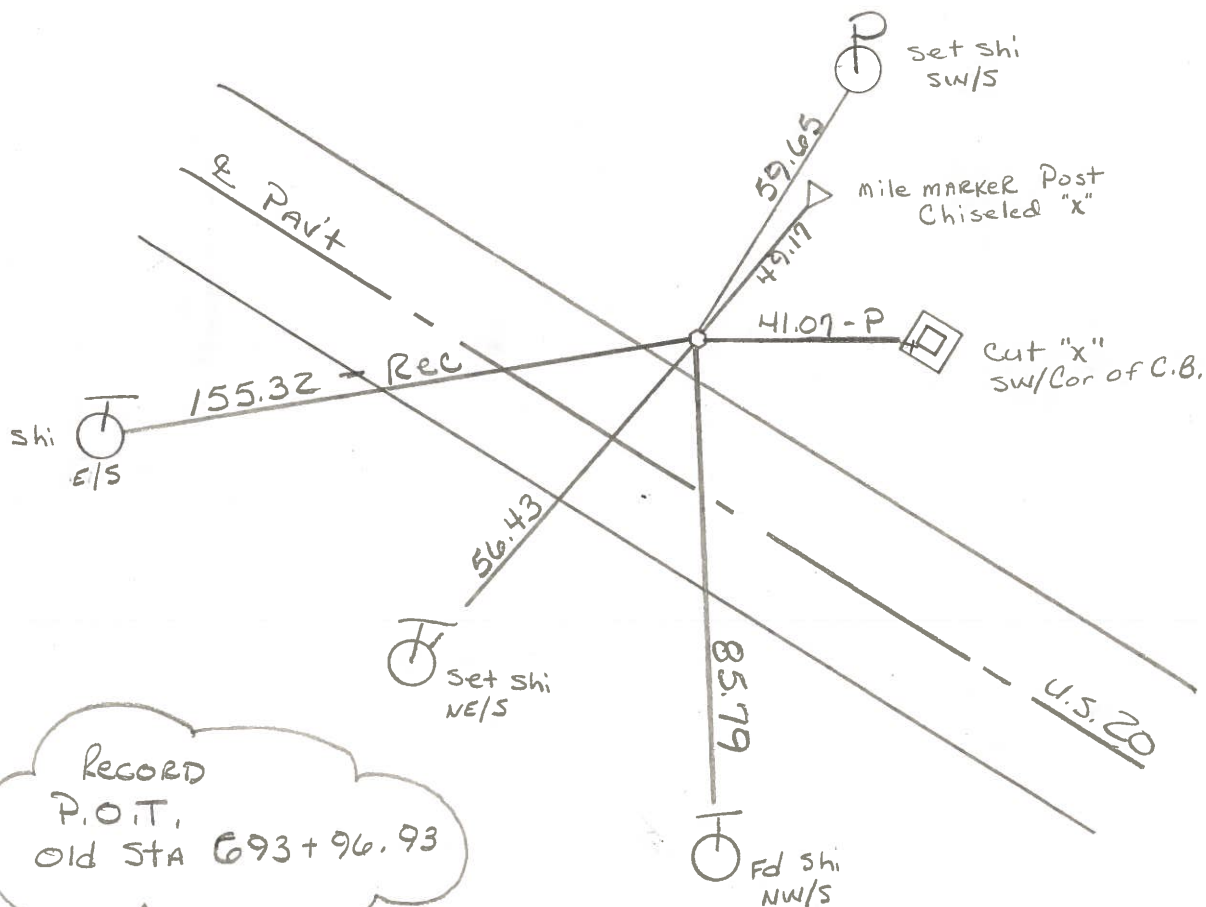

County Wood S.R. US#20

Date 19 April 83

Township T209

Weather Sunny

Section RT 72

Temp. 38°

T_N, R_E

Personnel J. Stone

P. Neuser

R. Michalak


D. Curtis

RT 72	RT 73
RT 71	RT 74



48

REF. NO. 48

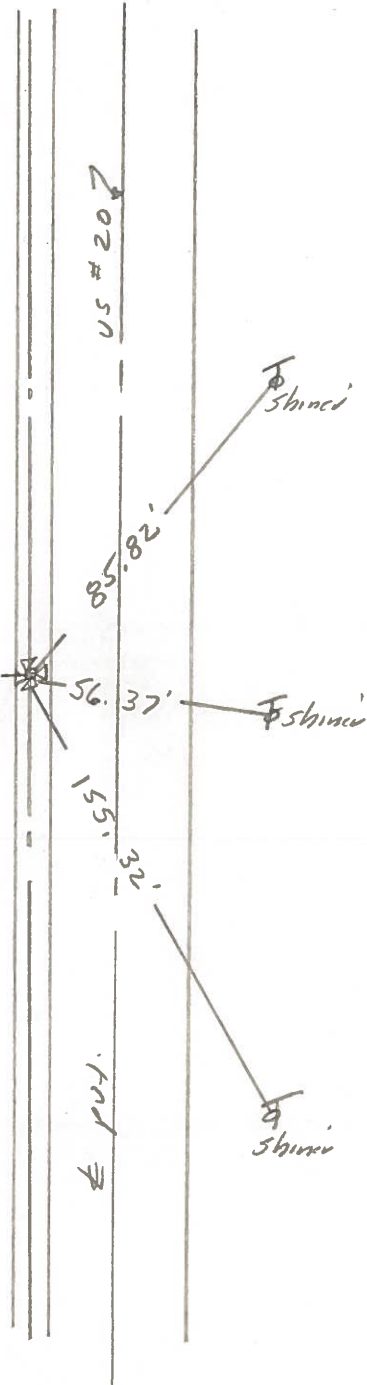

Fd. Post Spk. To Surface
 Old Sta. 693+96.93
 P.O.T. on S. Line RT 72
 2.0' N. of N. edge put.


County Wood S.R. U.S. #20
 Township Troy
 Section 13 - R.T. 69-70-71-72
 T6N, R12E
 Personnel CRONIN SCHNEIDER
RIPPLE MOSSER
GEYMAN BARBOUR

Date 5/22/80 Drawn 6/9/80
 Weather sunny
 Temp. 85°

R.T. 69	R.T. 72
R.T. 70	R.T. 71




#48

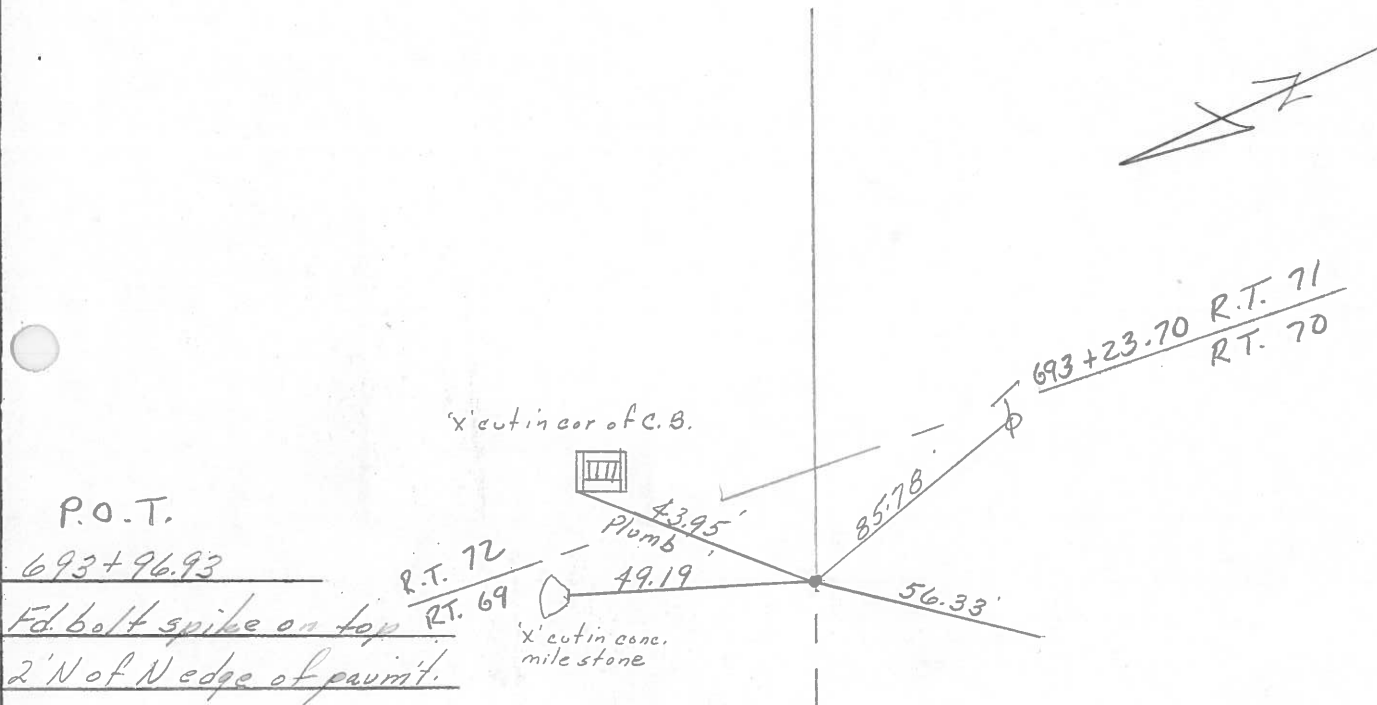

PERSONNEL	TITLE	PERSONNEL	TITLE
Tomsig		Gancart	
Neuser			
Vanyo			
Granata			

COUNTY WOOD DATE AUG. 22, 1970
 S. R. U. S. 20 Rechecked - Dec. 23 -
 WEATHER _____
 SEC. _____ TEMP. _____

DESCRIPTION REF. CONTROL Pts. LEFT CENTER LINE RIGHT JOB NO. _____

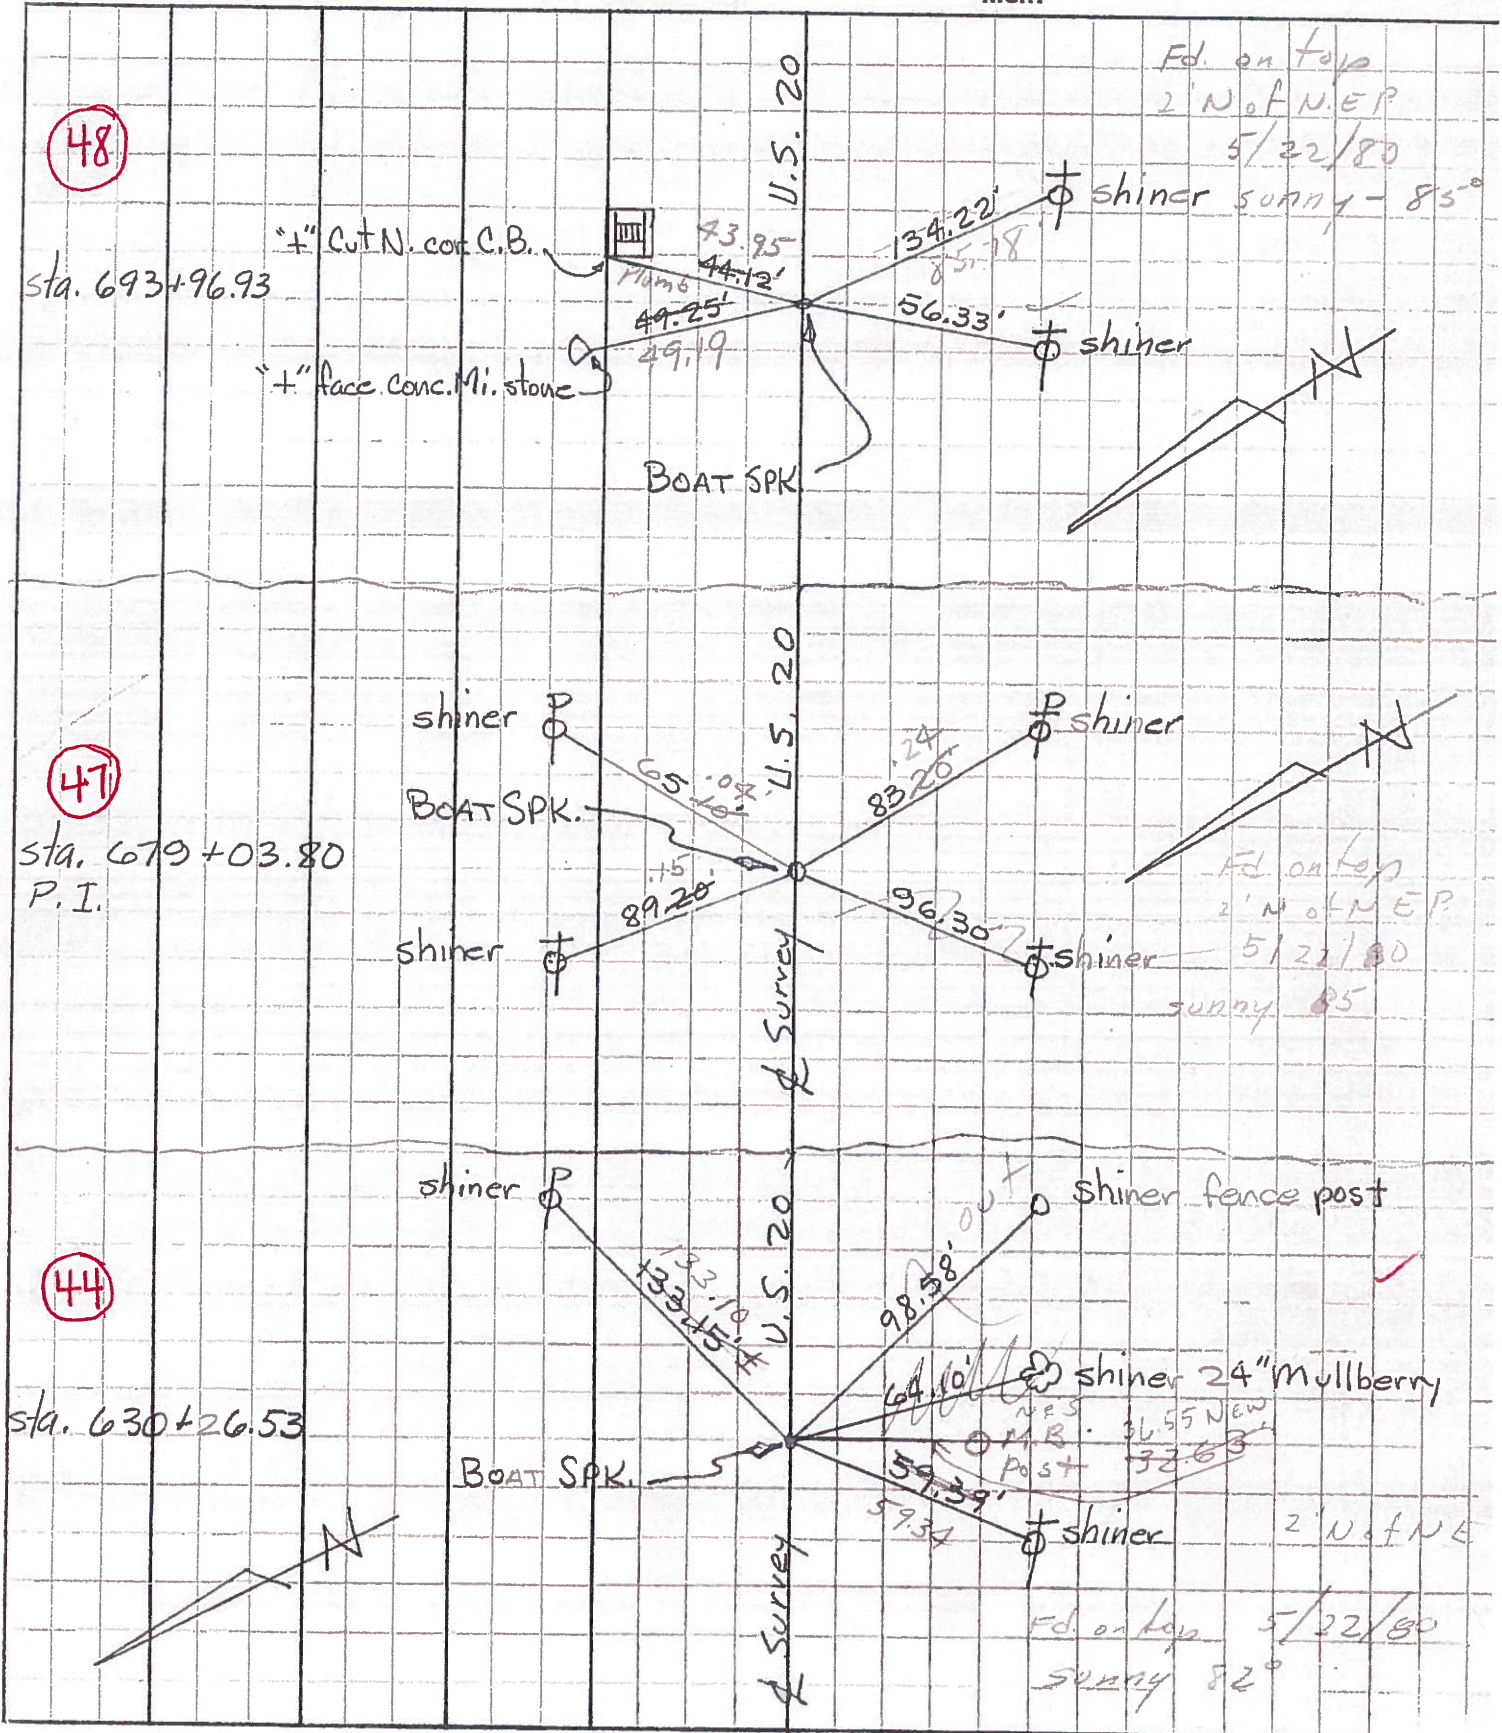

PERSONNEL	TITLE	PERSONNEL	TITLE
Tomsic		Gancarz	
Neuser			
Vanyo			
Granata			

COUNTY WOOD DATE Aug. 22, 1971
 S. R. U. S. 20 Rechecked - Dec. 23 -
 WEATHER _____

DESCRIPTION REF. CONTROL Pts. TEMP. _____
 LEFT CENTER LINE RIGHT JOB NO. _____

