


O.D.O.T. DISTRICT 2 SURVEY OFFICE (USE ONLY)


PERSONNEL _____ REFERENCE NO. 49 SHEET 8 OF 12
 NOTES LOEHRKE DATE 5/2/96 ROUTE US 20
 H.C. ROUSOS WEATHER FAIR COUNTY WOOD
 R.C. CANTERBURY TEMP. 50° TOWNSHIP TROY
 DWG BY NIESE PID _____ SECTION RT 73
 T 6 N R 12 E

TYPE MONUMENT SM.SPIKE
 ON SURFACE - ~~BELOW~~ ON
 OFFSET CL PAVEMENT 13.0' LT : ~~RT~~
1.6' TO LT EDGE PAVEMENT
 STATION: 714+45

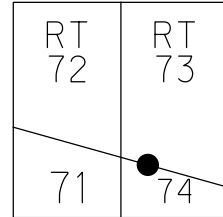

HORZ.DATUM: _____ GEOID: _____
 GRID: NORTHING: _____ EASTING: _____

RECORD:
 STA 714+18.92
 STA 713+94.78
 FD SM.SPIKE
 5/2/96, CL
 SET P.K./WASHER
 7/8/96, MDB

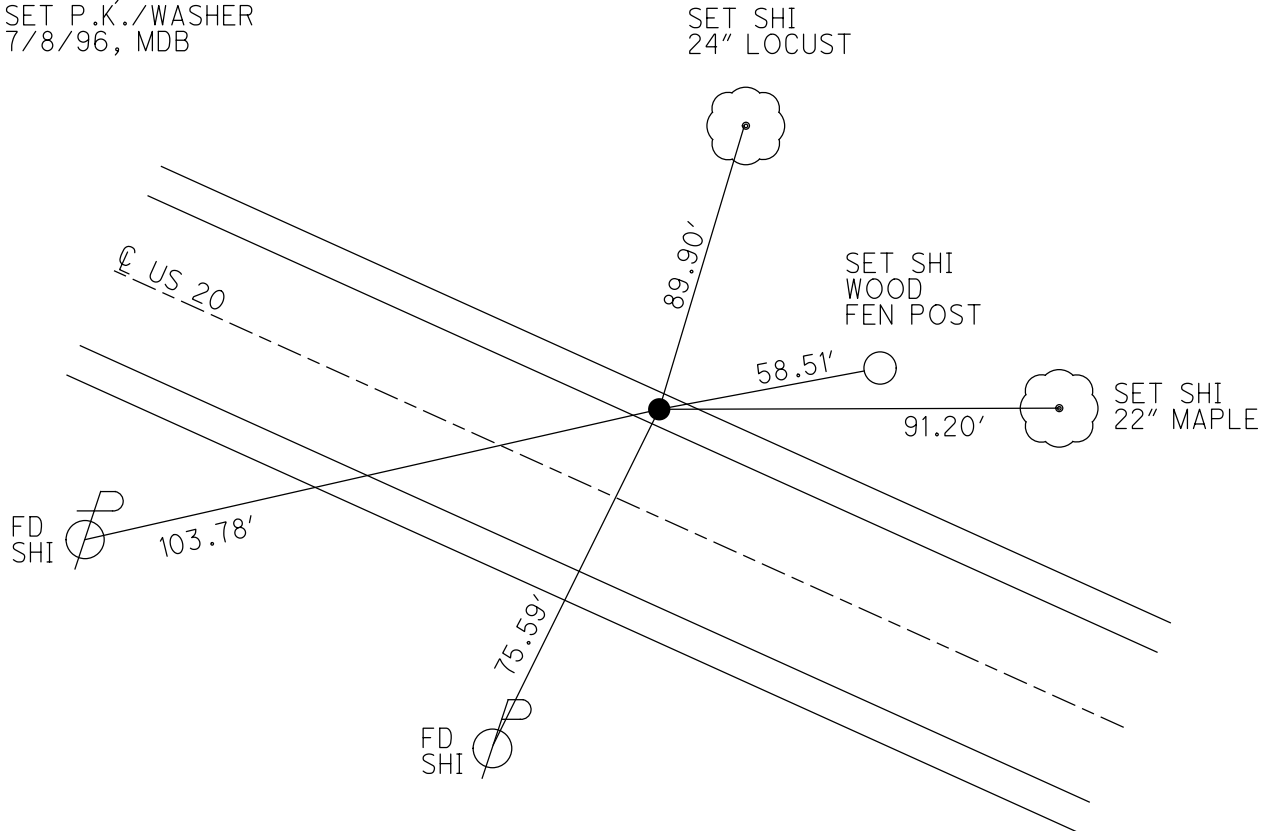

O.D.O.T. DISTRICT 2 SURVEY OFFICE

PERSONNEL _____

REFERENCE NO. 49

SHEET 9 OF 13

NOTES LOOK FOR

H.C. Roussas

R.C. Camdenbury

DATE 5/2/96

WEATHER FAIR

TEMP. +50

ROUTE U.S. 20

COUNTY Wood

TOWNSHIP TROY

SECTION R.T. 71, 72, 73, 74

T. 6 N. R. 12 E

TYPE MONUMENT SM Spk

ON SURFACE - BELOW YES


LEFT-Q PAV'T. - RIGHT 13.0

1.6 TO LEFT EDGE PAVEMENT

S.L.M. 714+45

SET - P.L. / W/SH/SH/SH
 7' 8" 3/4
 MPB

R.T. 72	R.T. 73
R.T. 71	R.T. 74

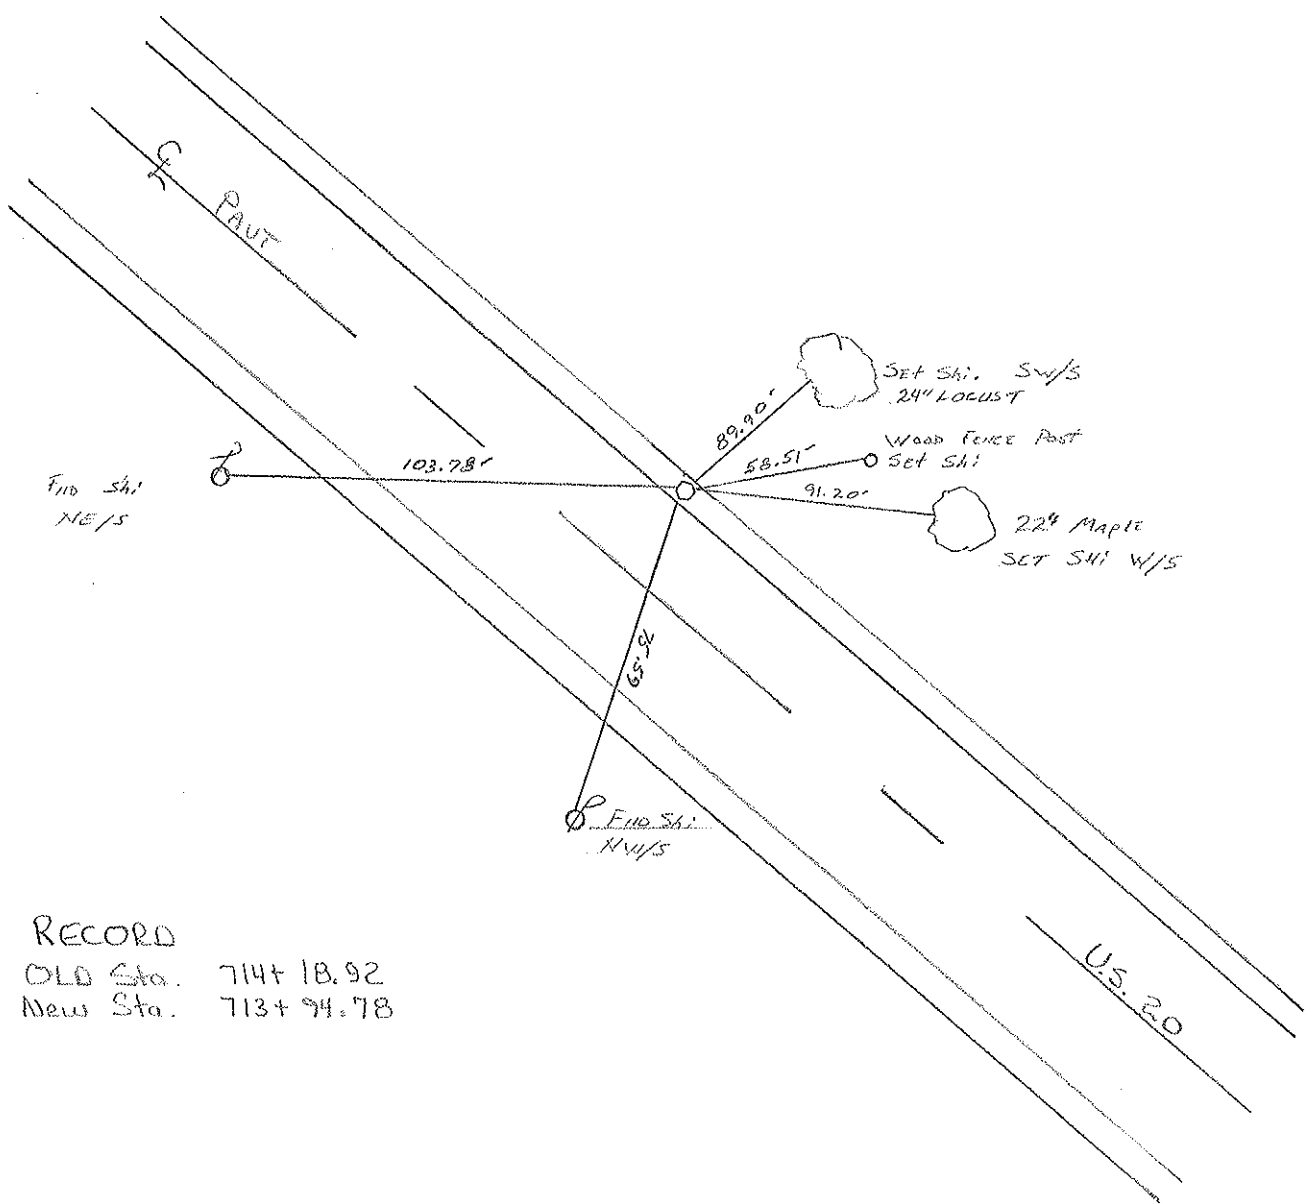

RECORD
 OLD Sta. 714+18.92
 New Sta. 713+94.78

O.D.O.T. DISTRICT 2 SURVEY OFFICE

PERSONNEL _____ REFERENCE NO. 49 SHEET OF 1

NOTES BARNHISEL
 H.C. HOFFMAN
 R.C. Loehrke


DATE May 23, 1986
 WEATHER SUNNY
 TEMP. +55°

ROUTE U.S. 20
 COUNTY WOOD
 TOWNSHIP T Roy
 SECTION R.T. 71.72.73.74
 T & R 12 E

TYPE MONUMENT Sm Spk
 ON SURFACE - ~~BELOW~~ yes
 LEFT - ~~C~~ PAV'T. - ~~RIGHT~~ 13.5
 2.9 L+TO Lt EDGE PAVEMENT
 S.L.M. 714+06

Set Sm RL Spk
6-25-86
gms

R.T. 72	R.T. 73
R.T. 71	R.T. 74

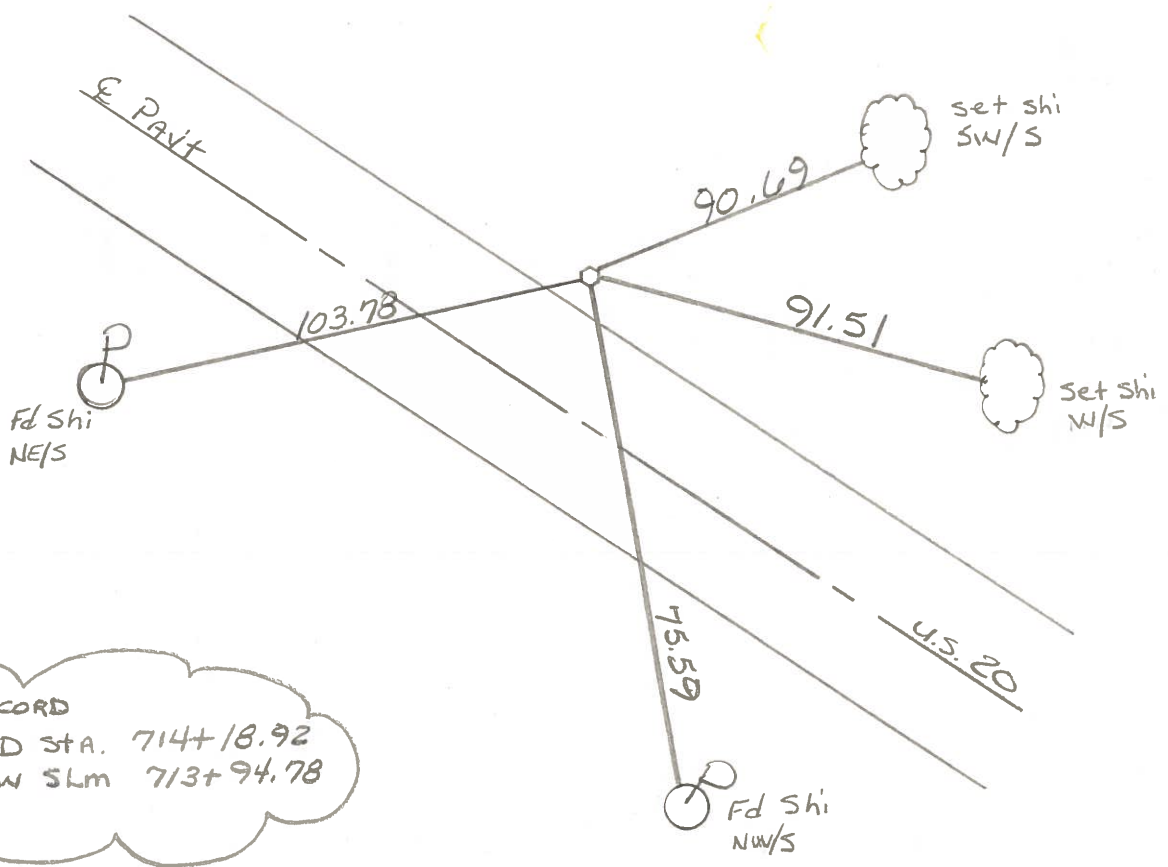

RECORD
 OLD STA. 714+18.92
 New SLM 713+94.78

County Wood S.R. US#20

Date 24 March 83

Township TROY

Weather Cool

Section R.T. 73

Temp. 33°

T_N, R_E

Personnel I. Stone

R. Michalak


D. Curtis

#49

R.T.	R.T.
72	73
R.T.	R.T.
71	74



REF. No. 49

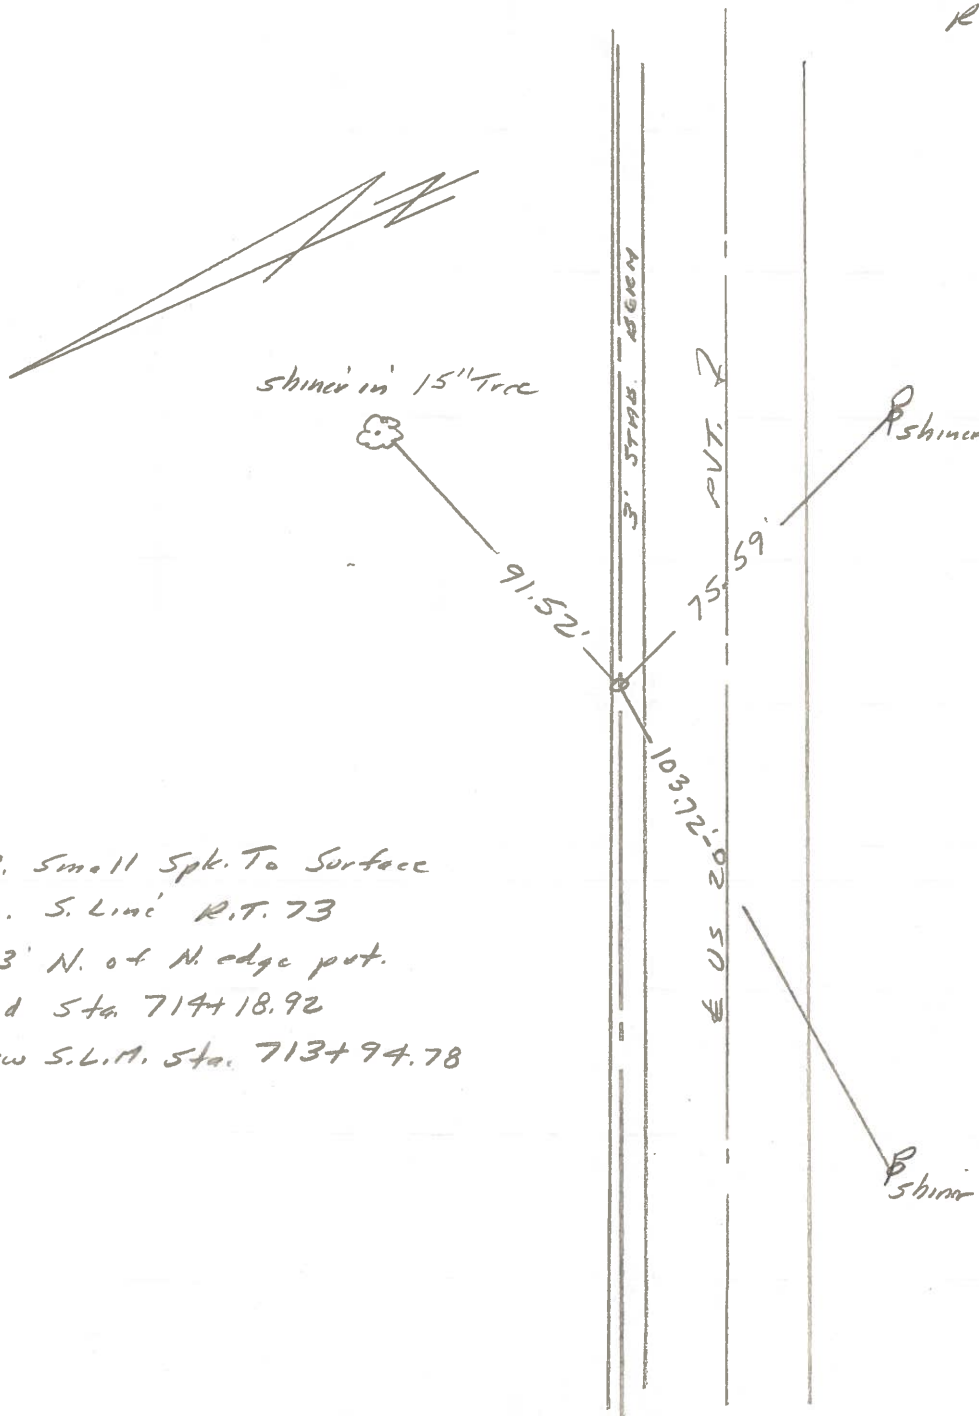

Fd. Small Spk. To Surface
 On S. Line R.T. 73
 2.3' N. of N. edge pot.
 Old Sta 714+18.92
 New S.L.M. Sta. 713+94.78

County Wood S.R. U.S. #20

Date 5/22/80 Drawn 6/9/80

Township TROY

Weather sunny

Section 13 R.T. 71-72-73-74

Temp. 85°

T N, R E

Personnel CROWIN SCHNEIDER

RIPPLE MOSSER

GEYMAN BARBOUR


R.T. 72	R.T. 73
R.T. 71	R.T. 74



#49 X

P.O.T.


714+ 18.92
Fd. bolt spike on top
2.3' Not N edge of print

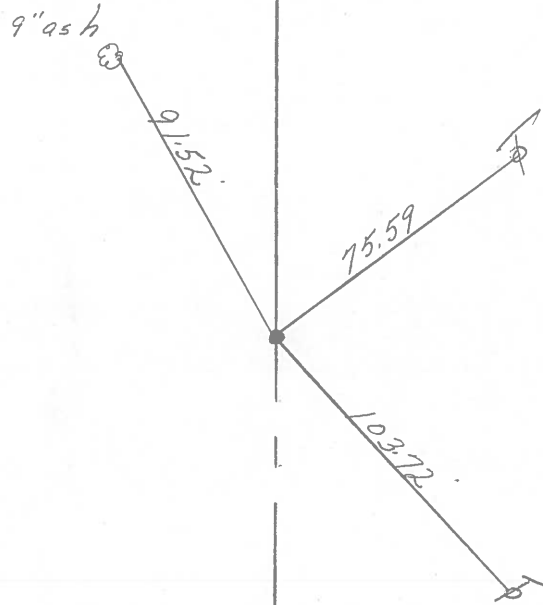

S. Survey U.S. #20

PERSONNEL	TITLE	PERSONNEL	TITLE	COUNTY	DATE
Tomsic				WOOD	Aug. 23, 1972
Vanyo				U.S. 20	Rechecked - 23-75
Granata					WEATHER
Gancarz				SEC.	TEMP.

DESCRIPTION	REF.	CONTROL	PTS.	JOB NO.
	LEFT	CENTER LINE	RIGHT	

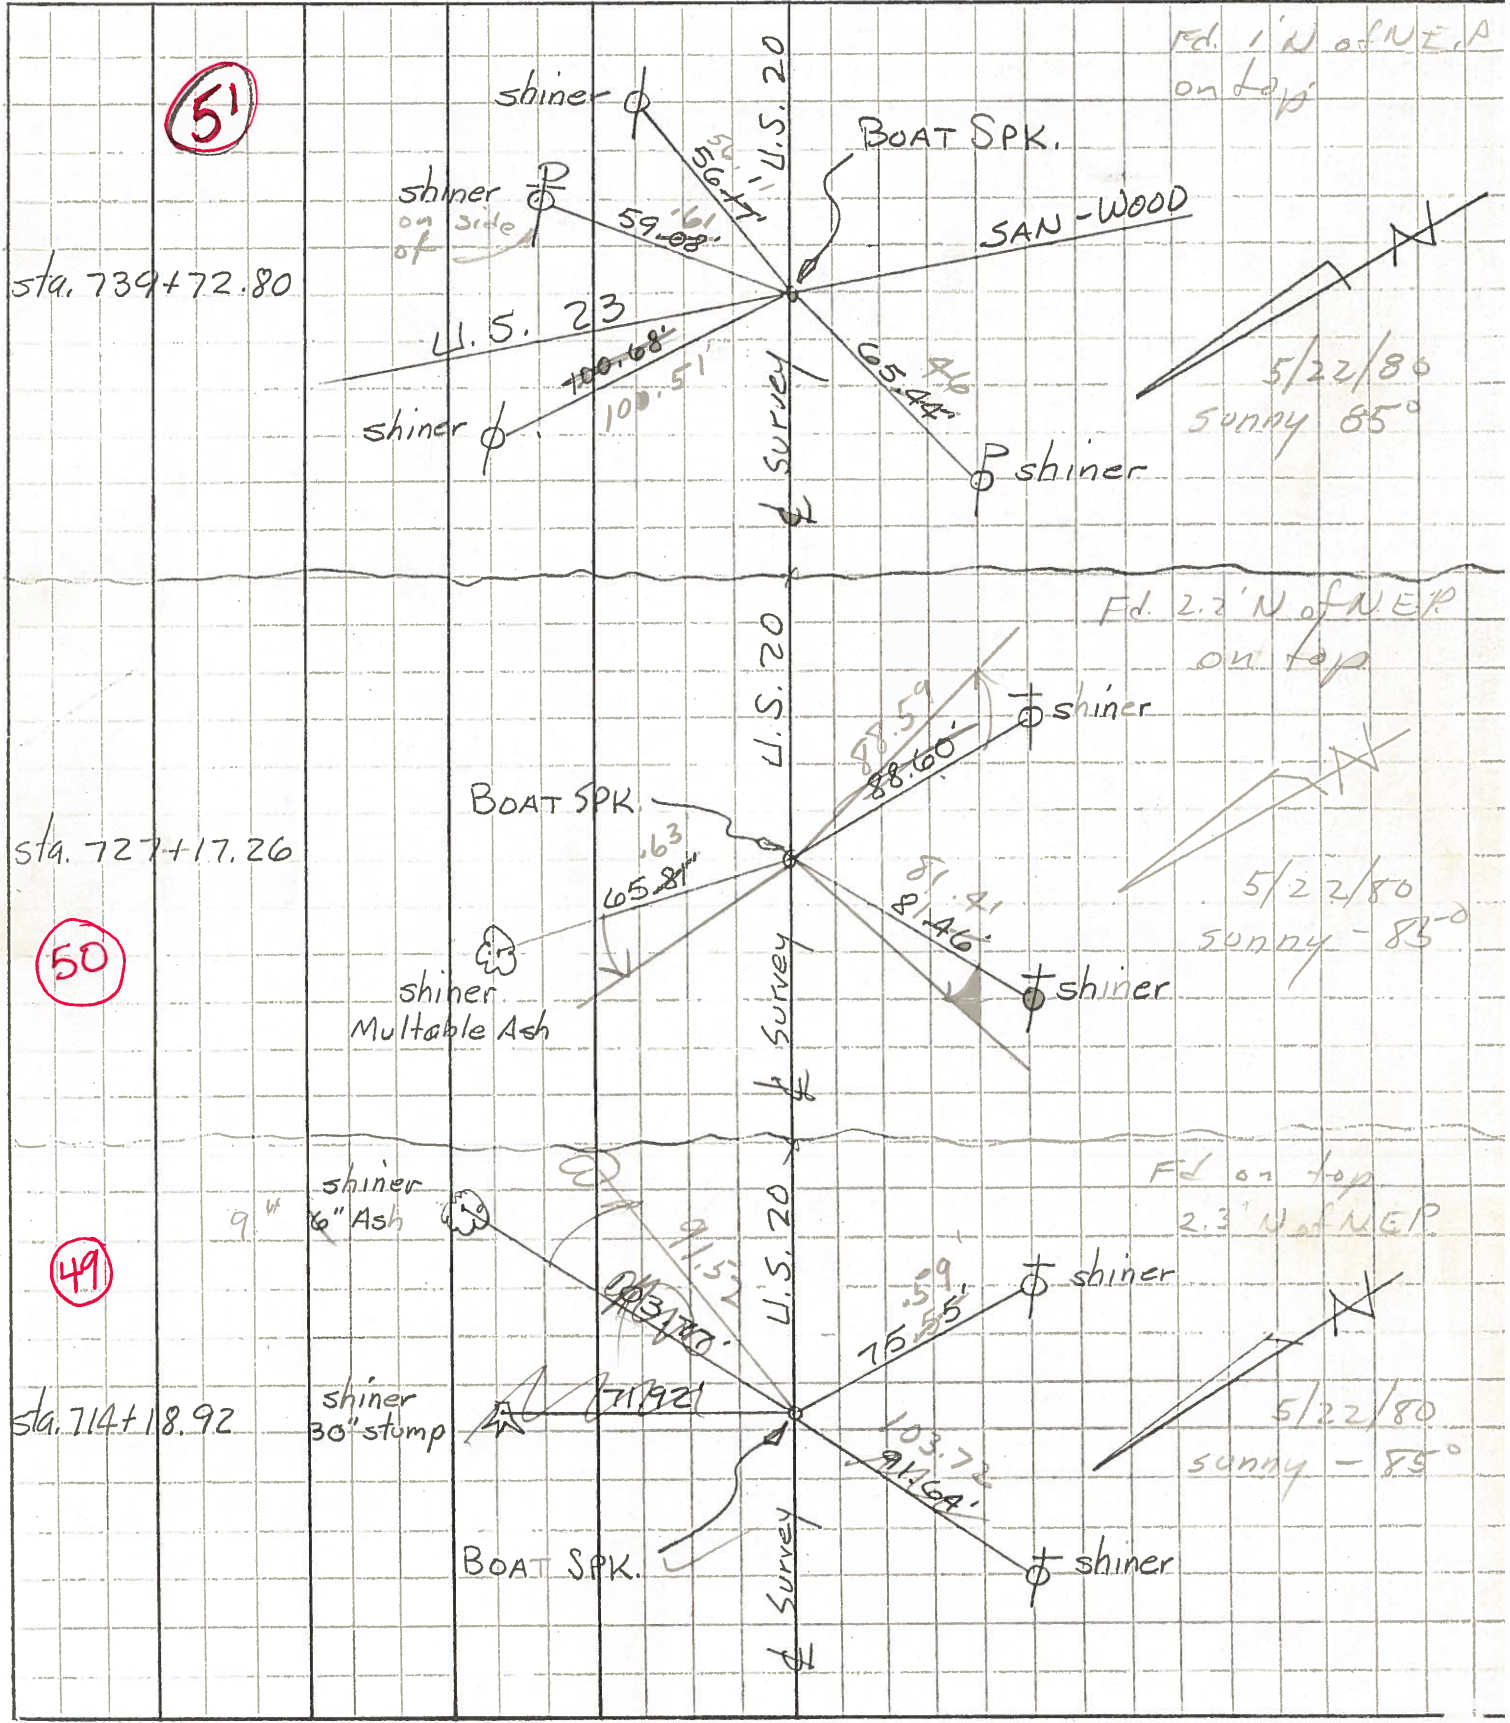

PERSONNEL	TITLE	PERSONNEL	TITLE
Tomsic			
Vanyo			
Granata			
Gancarz			

COUNTY Wood DATE Aug. 23, 1972
 S. R. U.S. 20 - Rechecked - 23-75
 WEATHER _____
 SEC. _____ TEMP. _____

DESCRIPTION REF. CONTROL PTS. LEFT CENTER LINE RIGHT JOB NO. _____

