

O.D.O.T. DISTRICT 2 SURVEY OFFICE (USE ONLY)

PERSONNEL

REFERENCE NO. 50 A

SHEET 11 OF 12

NOTES LOEHRKE

DATE 5/2/96

ROUTE US 20

H.C. ROUSOS

WEATHER FAIR

COUNTY WOOD

R.C. CANTERBURY

TEMP. 60°

TOWNSHIP TROY

SECTION 76

DWG BY NIESE PID _____

T 6 N R 12 E

TYPE MONUMENT SM.R.R.SPIKE

ON SURFACE - ~~BELOW~~ ON

OFFSET \odot PAVEMENT 13.0' LT : ~~RT~~

1.7' TO LT EDGE PAVEMENT


STATION: 727+27.43

HORZ.DATUM: _____


GEOID: _____

GRID: NORTHING: _____

EASTING: _____

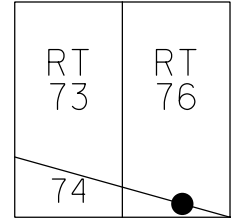

RECORD:
STA 727+17.26
FD SM.R.R.SPIKE
5/2/96, CL
SET P.K./WASHER
7/8/96, CL

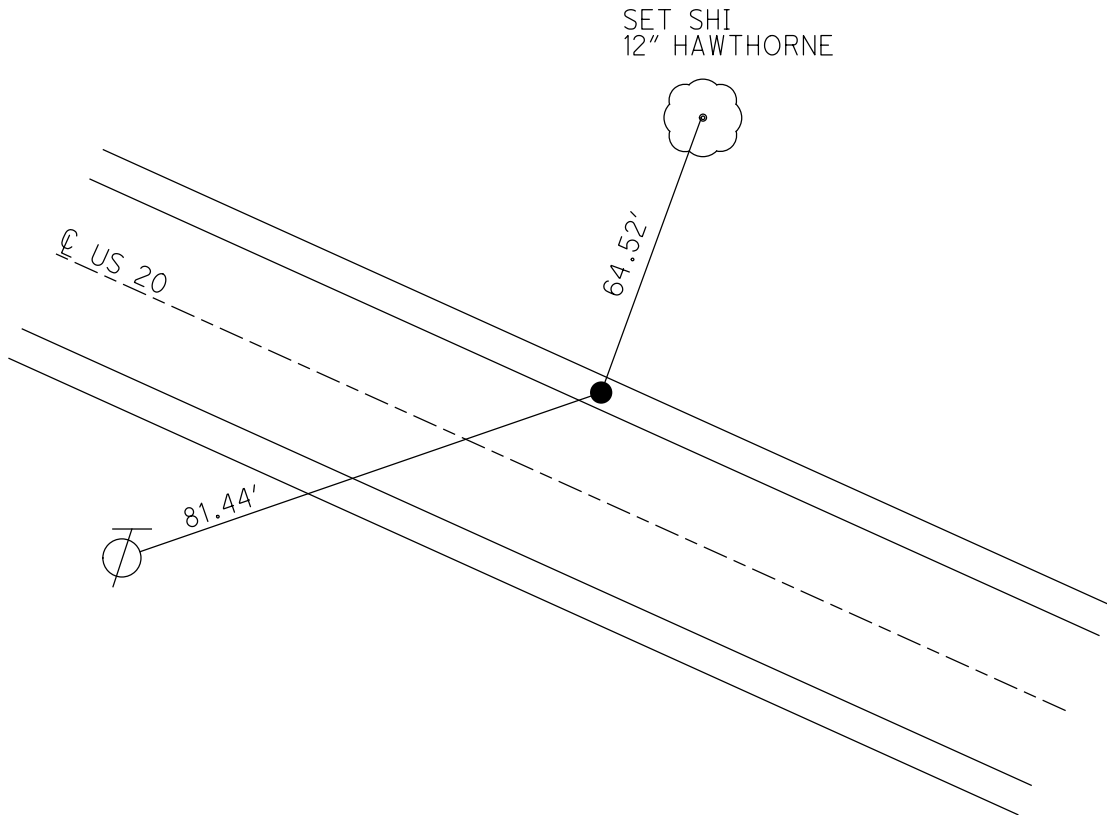

O.D.O.T. DISTRICT 2 SURVEY OFFICE

PERSONNEL _____

REFERENCE NO. 50-A

SHEET 12 OF 13

NOTES Lochke

H.C. Radsos

R.C. Courtenay

DATE 5/2/96

WEATHER FAIR

TEMP. +60 F

Set P.K./WASHER

*7.8.96
C.L.*

ROUTE U.S. 20

COUNTY Wood

TOWNSHIP TROY

SECTION RT. 73, 74, 75 & 76

T 6 N R 12 E

TYPE MONUMENT Sm. RR Spk

ON SURFACE - BELOW YES

LEFT- & PAV'T. - RIGHT 13.0'

1.7' TO LT EDGE PAVEMENT

S.L.M. 727+27.45

R.T. 73	R.T. 76
R.T. 74	R.T. 75



RECORD
Sta 727+17.26

