

O.D.O.T. DISTRICT 2 SURVEY OFFICE (USE ONLY)

PERSONNEL _____

REFERENCE NO. 51

SHEET 12 OF 12

NOTES LOEHRKE

DATE 5/2/96

ROUTE US 20

H.C. ROUSOS

WEATHER FAIR

COUNTY WOOD

R.C. CANTERBURY

TEMP. 50°

TOWNSHIP TROY

SECTION RT 76

DWG BY NIESE PID _____

T 6 N R 12 E

TYPE MONUMENT SM.R.R.SPIKE

ON SURFACE - ~~BELOW~~ ON

OFFSET CL PAVEMENT 12.7' LT : ~~RT~~

2.0' TO LT EDGE PAVEMENT


STATION: 739+62

HORZ.DATUM: _____


GEOID: _____

GRID: NORTHING: _____

EASTING: _____

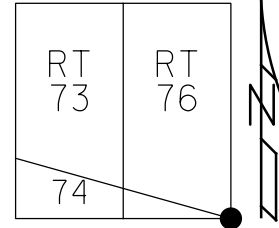

RECORD
 STA 739+72.80
 $\Delta = 00^{\circ}00'00''$
 FD SM.R.R.SPIKE
 5/2/96, CL
 SET P.K./WASHER
 7/8/96, CL

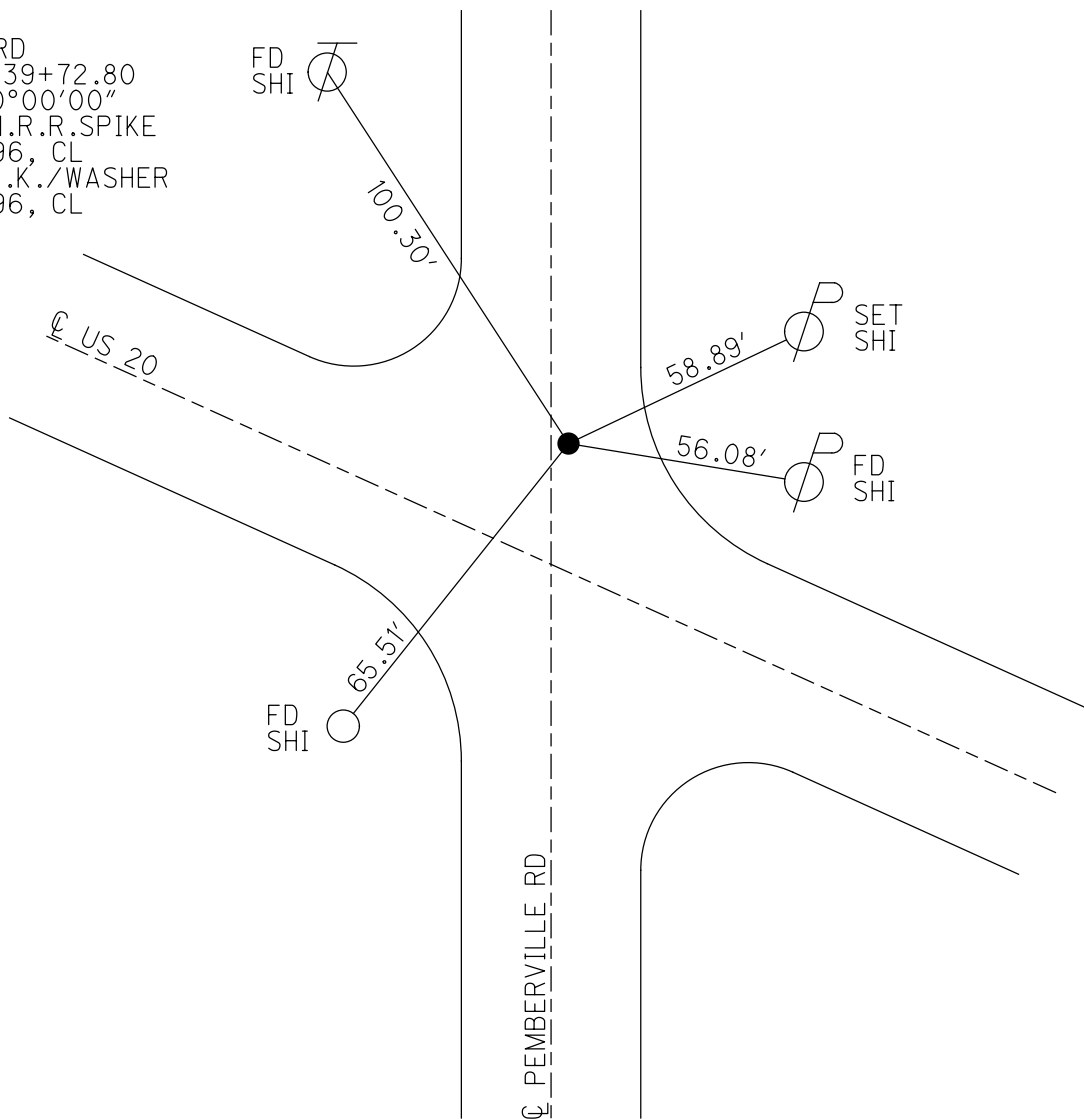

O.D.O.T. DISTRICT 2 SURVEY OFFICE

PERSONNEL _____

REFERENCE NO. 51

SHEET 13 OF 13

NOTES Lochrke

H.C. Roussier

R.C. Carter busy

DATE 5/2/96

WEATHER Fair

TEMP. +50

ROUTE US 20

COUNTY WOOD

TOWNSHIP TROY

SECTION RT. 75, 76, 77 & 78

T 6 N R 12 E

Set PK / WASHER
7-8-96
C.L.

TYPE MONUMENT Sm RR spk


ON SURFACE - ~~BELOW~~ Yes

LEFT - ~~C~~ PAV'T. - ~~RIGHT~~ 12.7

2.0 TO LT EDGE PAVEMENT

S.L.M. 739+62 / 2' East of C PAVT North

R.T. 76	R.T. 77
R.T. 75	R.T. 78

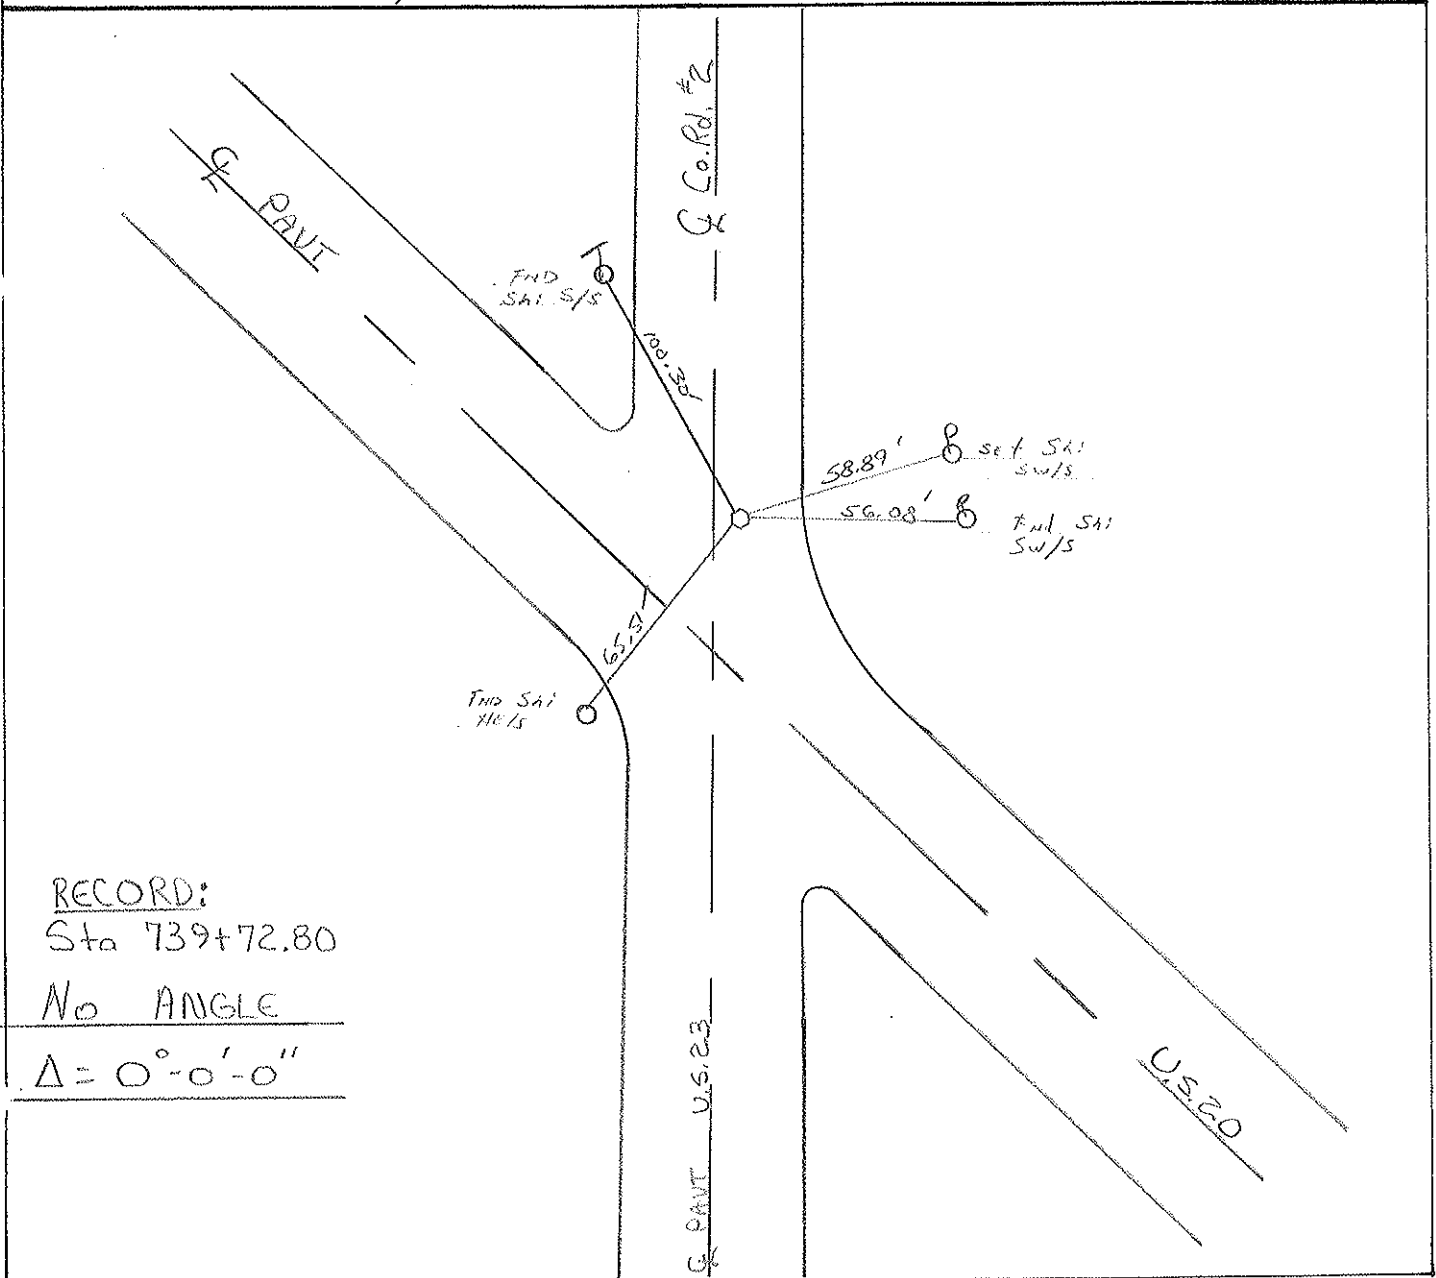

RECORD:
Sta 739+72.80
No ANGLE
 $\Delta = 0^{\circ} - 0' - 0''$

O.D.O.T. DISTRICT 2 SURVEY OFFICE

PERSONNEL

REFERENCE NO. 51

SHEET OF

NOTES BARNHISEL

H.C. HOFFMAN

R.C. Loehrke

DATE May 23, 1986

WEATHER SUNNY

TEMP. +55°

ROUTE U.S. 20

COUNTY WOOD

TOWNSHIP Troy

SECTION R.T. 75, 76, 77, 78

T. 6 N R 12 E

TYPE MONUMENT Sm RR Spk

ON SURFACE - ~~BELOW~~ yes

LEFT- & PAV'T. - ~~RIGHT~~ 13.3


2.0 Lt TO Lt EDGE PAVEMENT

S.L.M. 739+62

2.0 E. of & PAV'T N.

Set Sm RR Spk
6-25-86
MOB

R.T. 76	R.T. 77
R.T. 75	R.T. 78

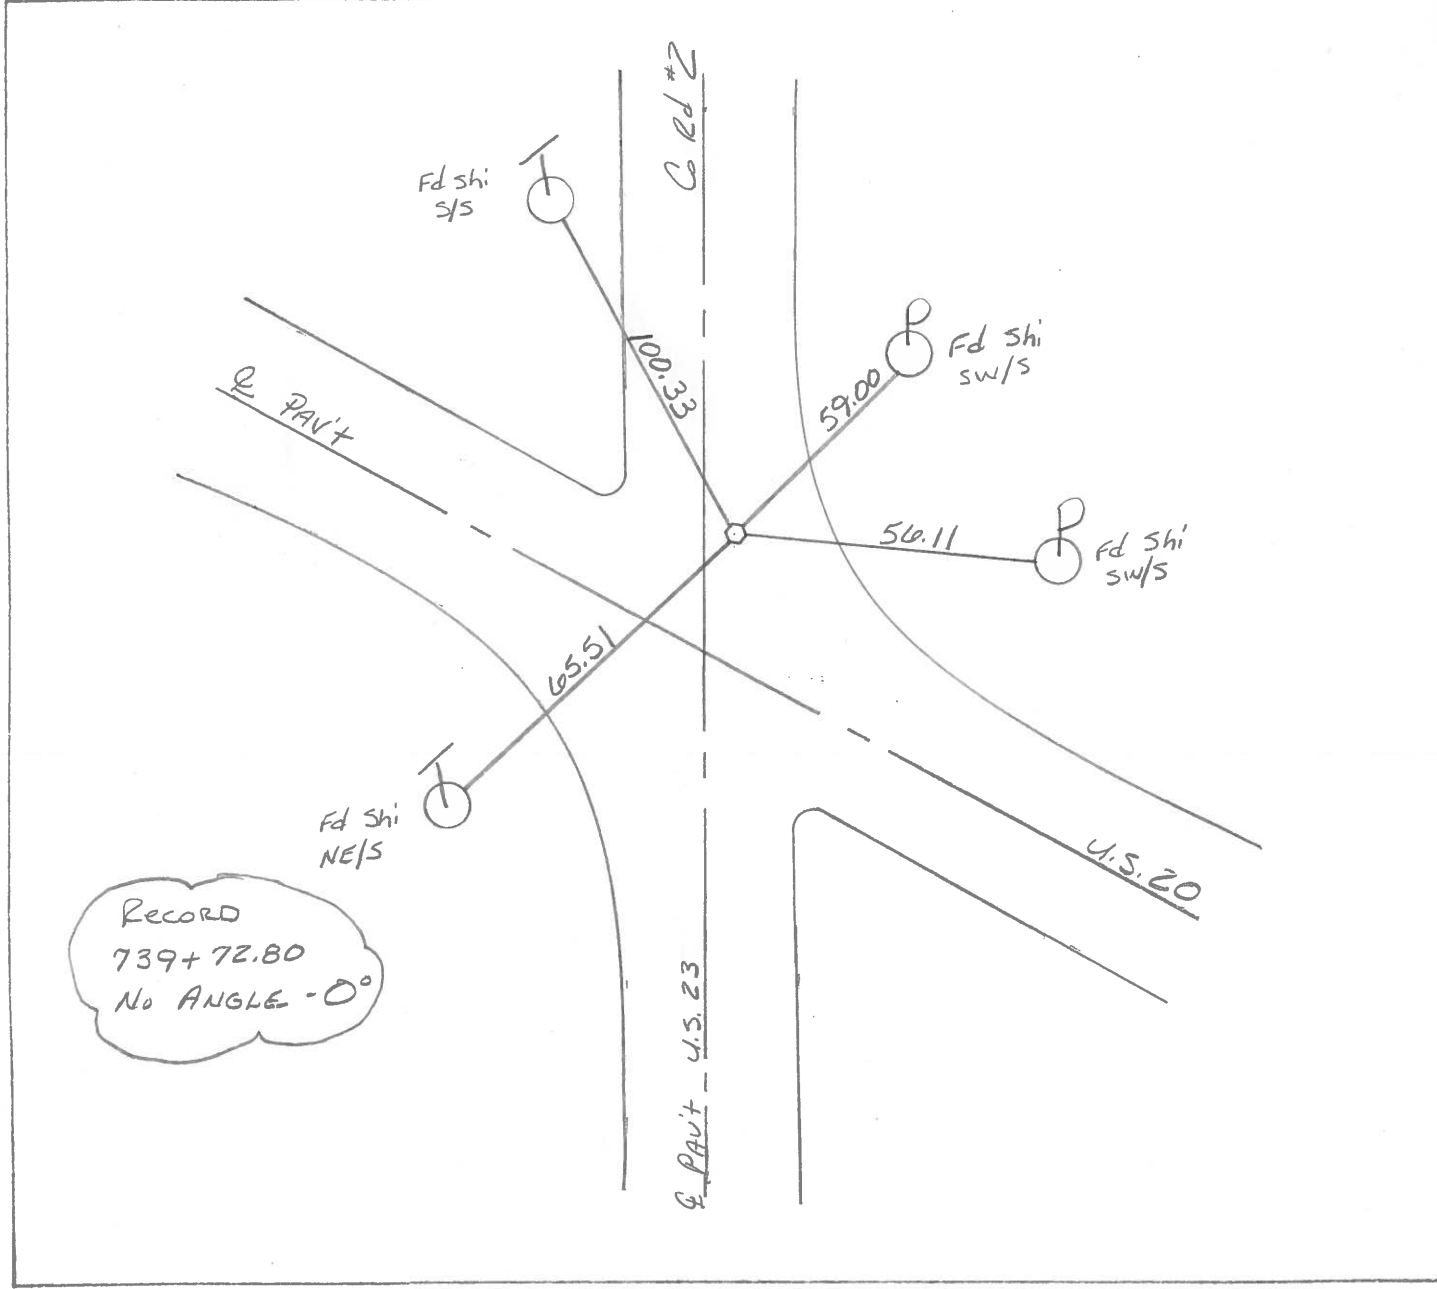

County Wood S.R. U.S.#20

Date 5/22/80 Drawn 6/9/80

Township Troy

Weather sunny


Section 13-24 R.T. 75-76

Temp. 85°

T N, R E

Personnel CRONIN SCHNEIDER
RIDDLE MOSSER
GEYMAN BARBOUR

R.T. 76	R.T. 77
R.T. 75	R.T. 78

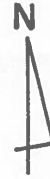

#51

No ANGLE - 0°
739+72.80

Fd. bolt spike on top
 1' N of N edge of point.

SANDUSKY Co.
Wood Co.

C.R. #2

100.51


59.61
 N's on side of P

56.11

U.S. #232

65.46


Survey U.S. #20

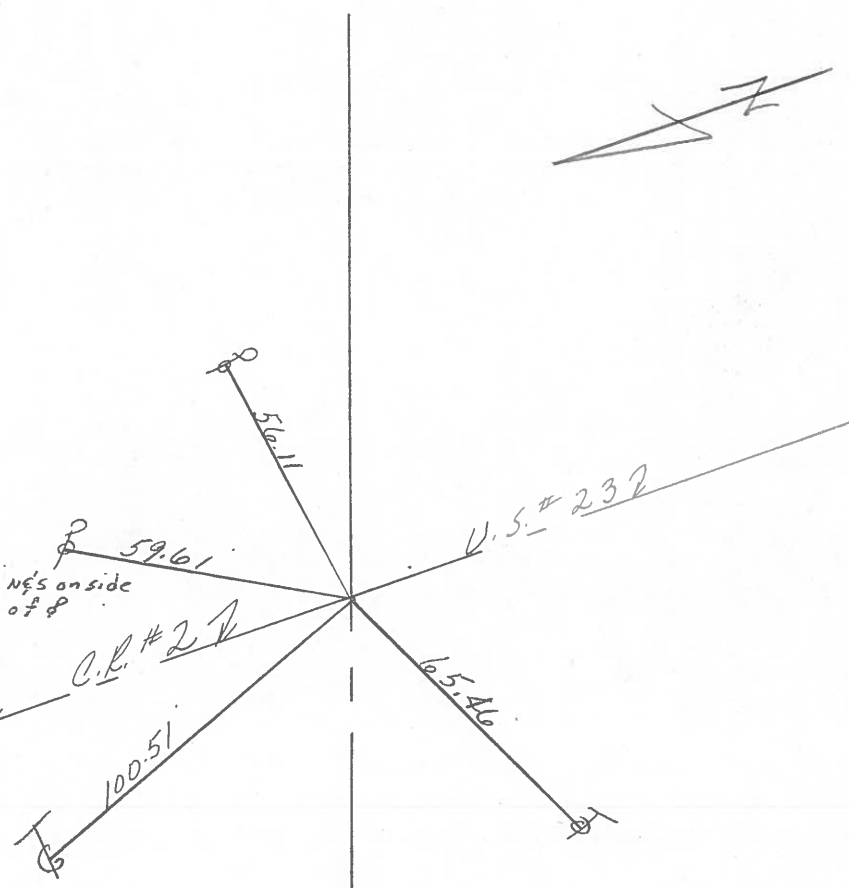

PERSONNEL TITLE PERSONNEL TITLE
 TOMSIC _____
 Vanyo _____
 Granata _____
 Gancarz _____

STREET NO. _____
 COUNTY WOOD DATE Aug. 23, 1970
 S. R. U.S. 20 Rechecked - 23 - 70
 WEATHER _____
 SEC. _____ TEMP. _____

DESCRIPTION REF. CONTROL PTS. LEFT CENTER LINE RIGHT JOB NO. _____

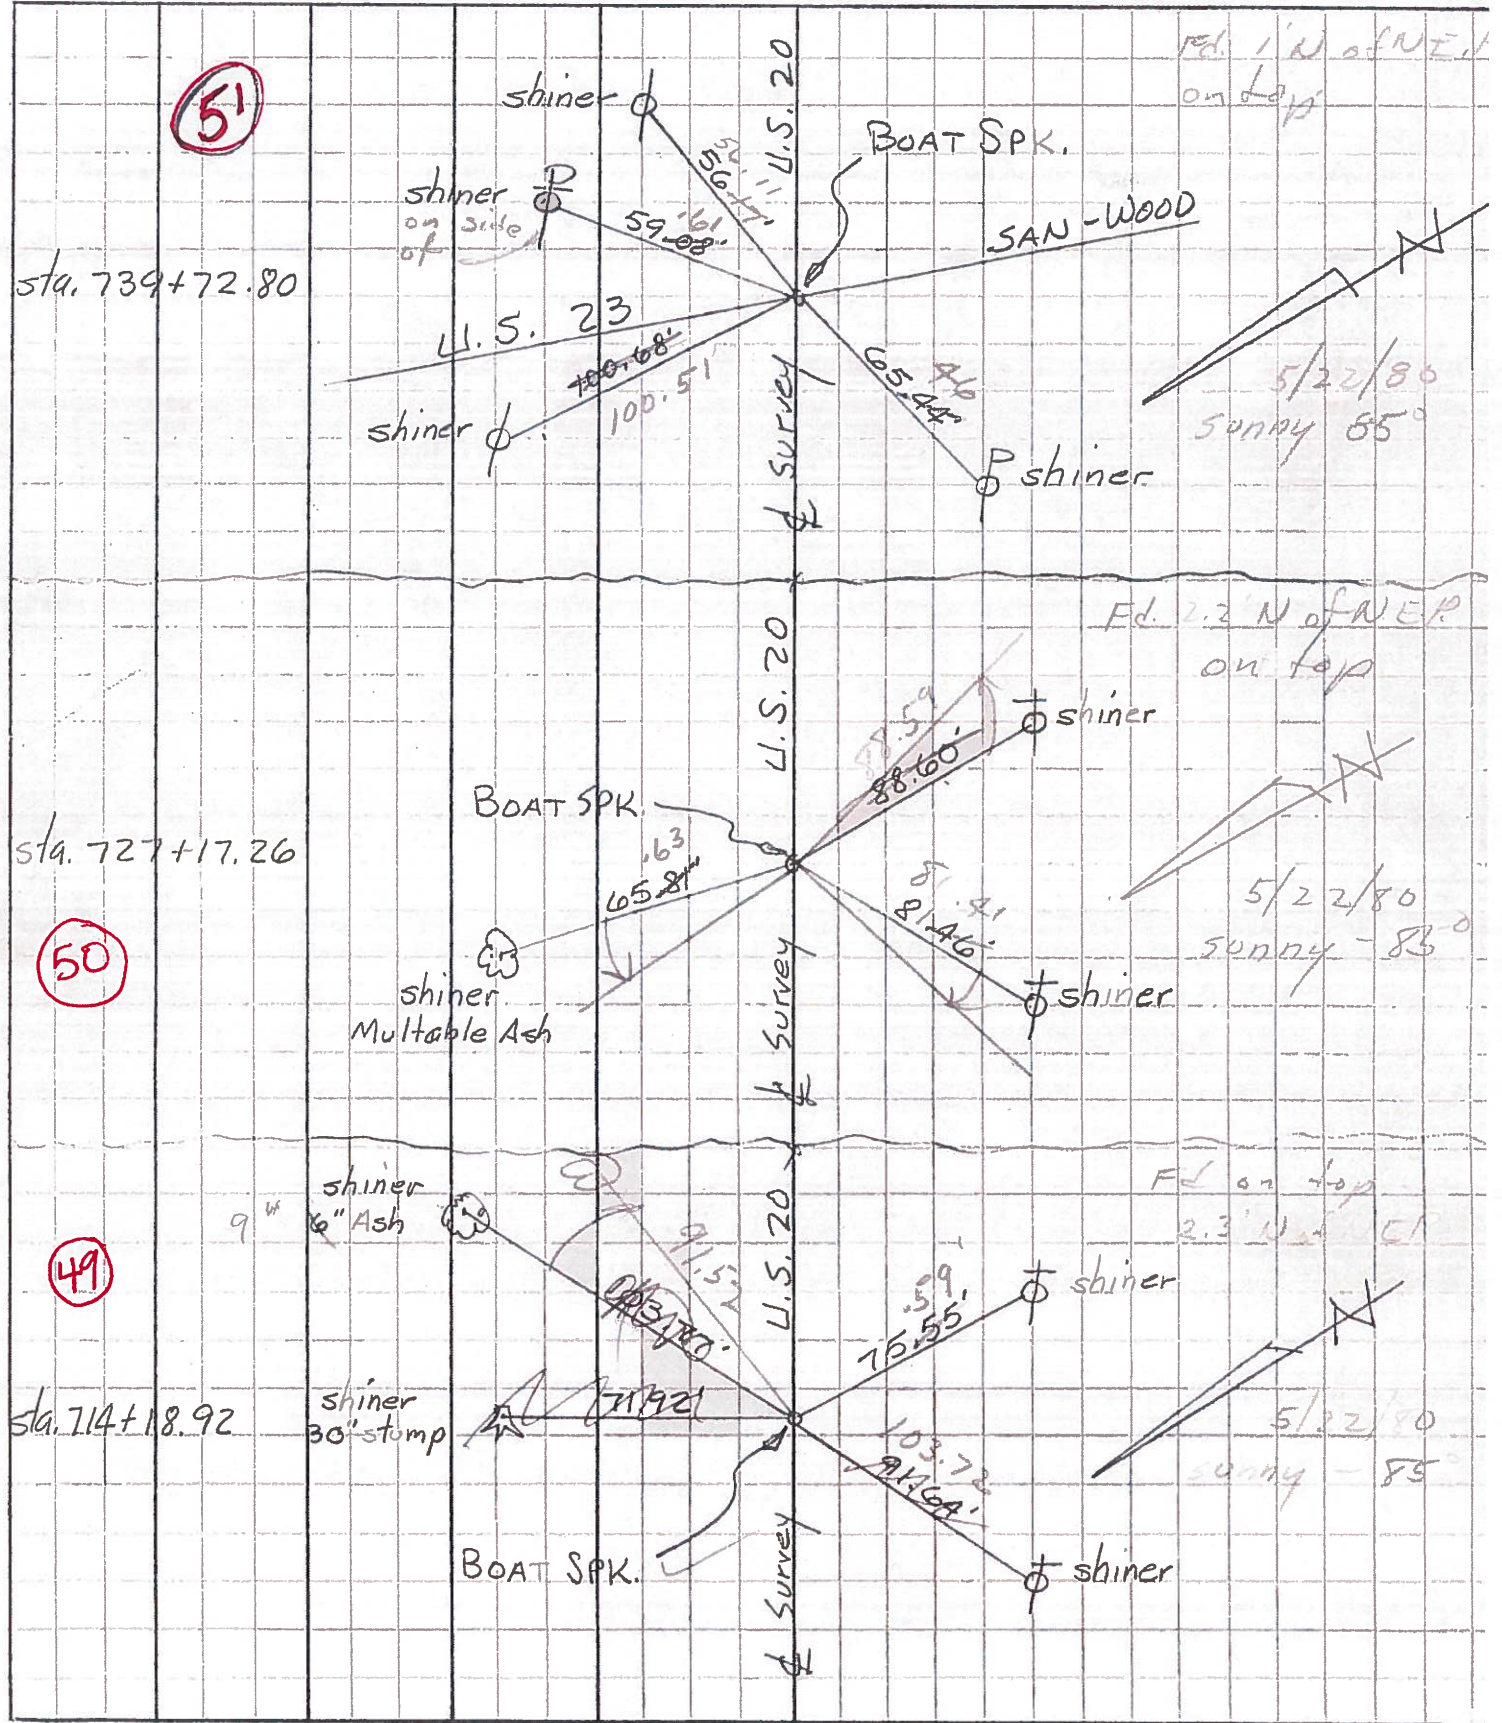

PERSONNEL TITLE PERSONNEL TITLE
 TOMSIC _____
 Vanyo _____
 Granata _____
 Gancarz _____

COUNTY Wood DATE Aug. 23, 19
 S. R. U. S. 20 - Rechecked - 23-7.
 WEATHER _____
 SEC. _____ TEMP. _____

DESCRIPTION REF. CONTROL PTS. LEFT CENTER LINE RIGHT JOB NO.

