

O.D.O.T. DISTRICT 2 SURVEY OFFICE (USE ONLY)

PERSONNEL

REFERENCE NO. 18

SHEET 17 OF 22

NOTES RHOADES

DATE 5/7/19

ROUTE US 23

H.C. O'DONNELL

WEATHER CLOUDY

COUNTY WOOD

R.C. MILLER

TEMP. 50°

TOWNSHIP PERRY

DWG BY BALBAUGH PID 92134

SECTION 12

T 3 N R 12 E

TYPE MONUMENT P.K./WASHER

~~ON SURFACE~~ - BELOW 3"

OFFSET \odot PAVEMENT ON ~~LT~~ : ~~RT~~

12.0' TO LT EDGE PAVEMENT


STATION: 252+70.56

HORZ. DATUM: NAD83 (2011)



GEOID: 2012A

GRID: NORTHING: 573109.183

EASTING: 1715430.445

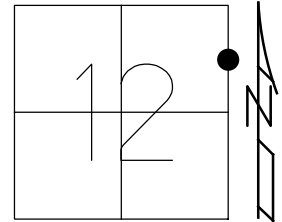

RECORD:
 STA 239+26.61
 FD P.K./WASHER
 8/12/91, MB
 SET P.K./WASHER
 4/16/92, BVD
 FD P.K./WASHER
 3" DOWN
 REF18
 8/24/17, JFO
 SET MAG/WASHER
 10/28/19, JFO

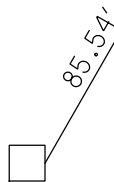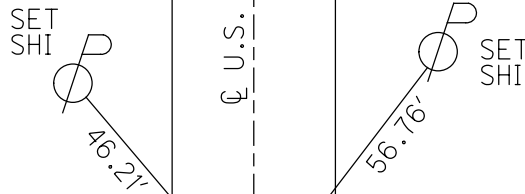

FD "+" ON
 FACE OF SQUARE
 CONC. POST
 "CENTER OF THE WORLD"

\odot U.S. 23

DIST. 17-18 = 104.83'

17 \odot

County Wood S.R. U.S.23

Date 7-28-81

Township Perry

Weather cloudy

Section 12

Temp. +75°


T3N, R12E

Personnel HOFFMAN

#17-18

Loehrke

Householder

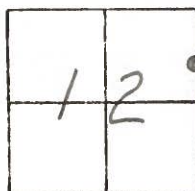

Pt. "A" Fd. P.K. @ surface S.L.M. = 252+27

12.1' to W. E.P.


11.9' to E. E.P.

SET P.K./WASHER
@ BOTH POINTS
9-21-83
S.W.H.

Pt. "B" Fd. P.K.
@ surface

12.0' to W. E.P.

12.1' to E. E.P.

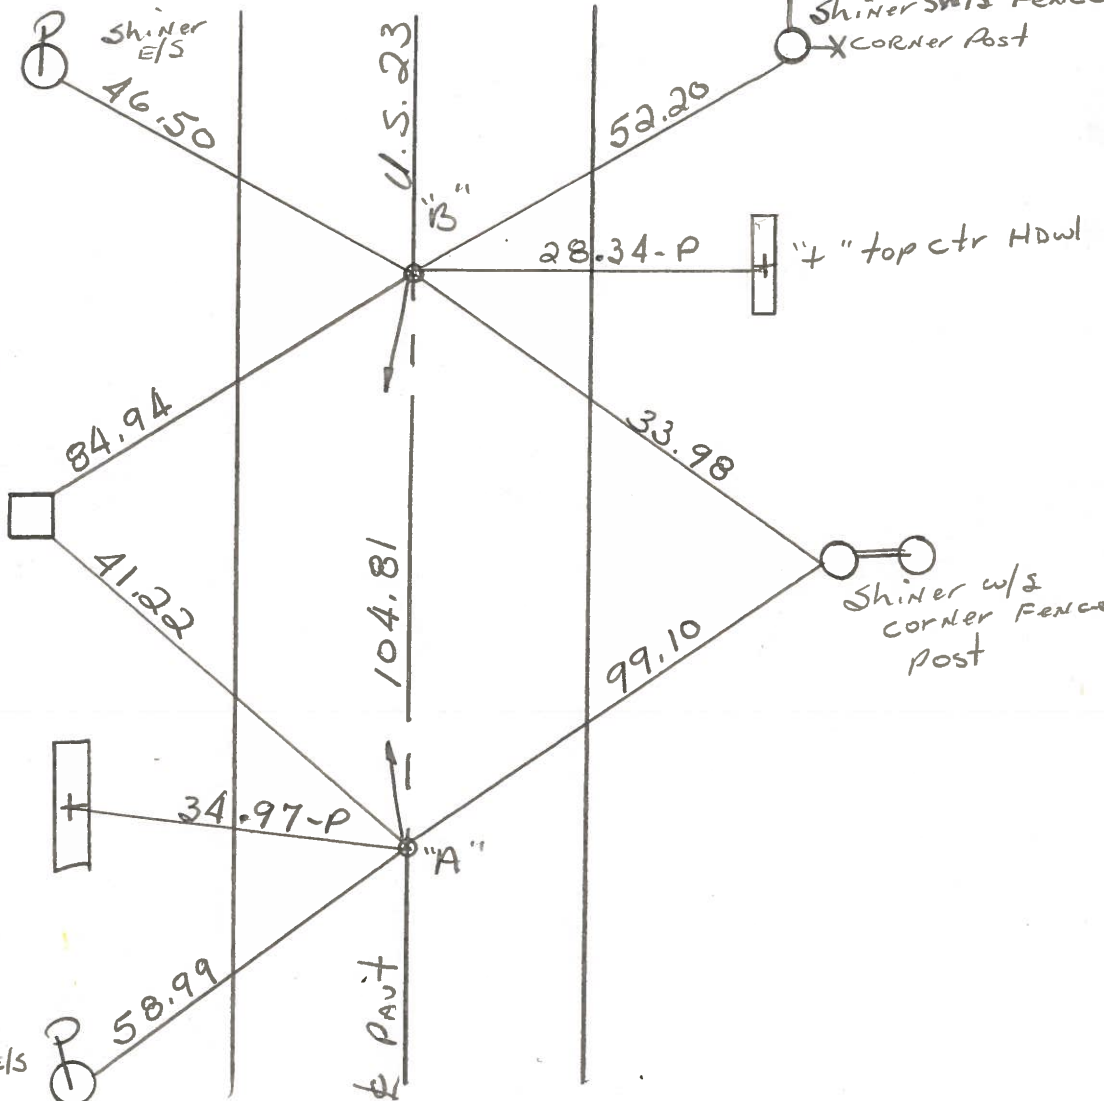

NEAR SIDE
2' UP CONC.
CORNER POST

"4" top ctr.
Hdwl

Shiner Nels

Pt. "B" STA. 239 + 26.61 — Rec. 2

Pt "A" STA. 238 + 21.8 - Δ = 0° - 18' Lt

O.D.O.T. DISTRICT 2 SURVEY OFFICE

SHEET _____ OF _____

County WOOD S.R. 23

Township PERRY

Section 12

T3N, R12E

Personnel: BURNSIDE


HOFFMAN

9-1-70-OK

Date 9-15-71-OK

Weather _____


Temp. _____

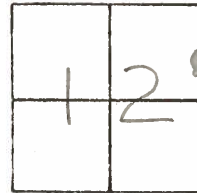

#17 - #18

#18
 STA. 239+26.61
 "STONE" SENECA CO.
 FD. BRASS MON.
 P.K. NAIL

#17
 STA. 238+21.8
 Δ = 0°-18' LT.
 "STONE" WOOD CO.
 FD. BRASS MON.
 P.K. NAIL

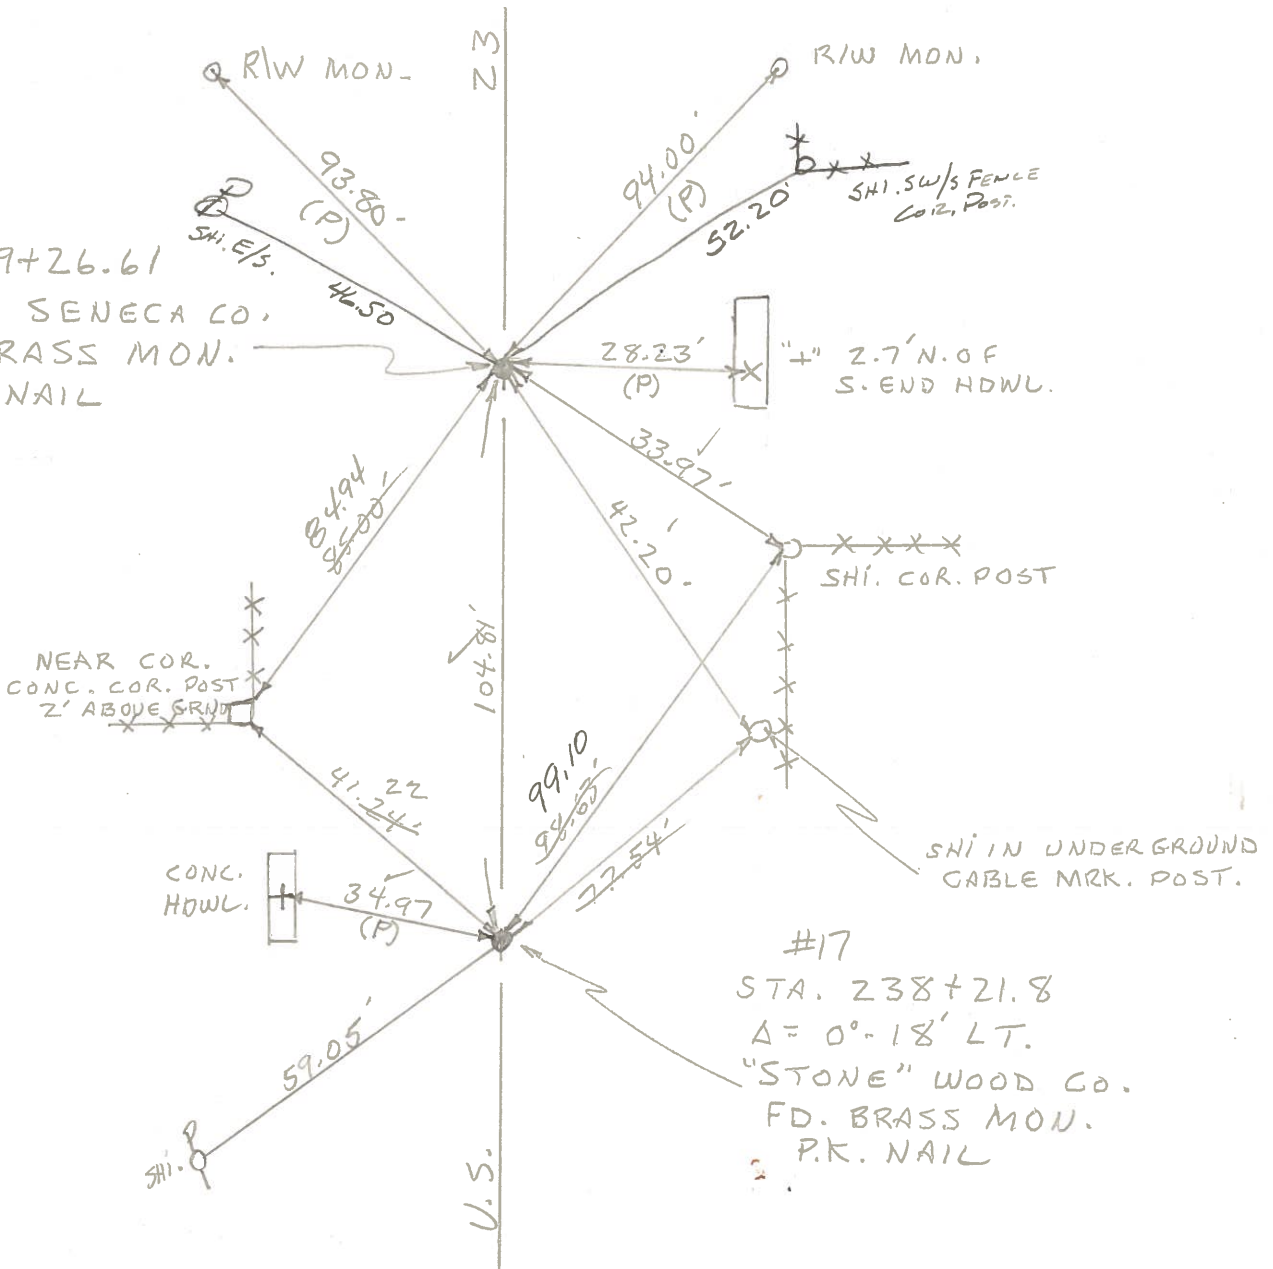

PERSONNEL TITLE PERSONNEL TITLE

CK. BY
BURNSIDE
HOFFMAN

COUNTY Wood

DATE OK-9-1-70

OK-9-15-71

S. R. U.S. #23

WEATHER

SEC. FOSTORIA - NORTH

TEMP.

DESCRIPTION


CONTROL TIES

JOB NO.

LEFT

CENTER LINE


RIGHT

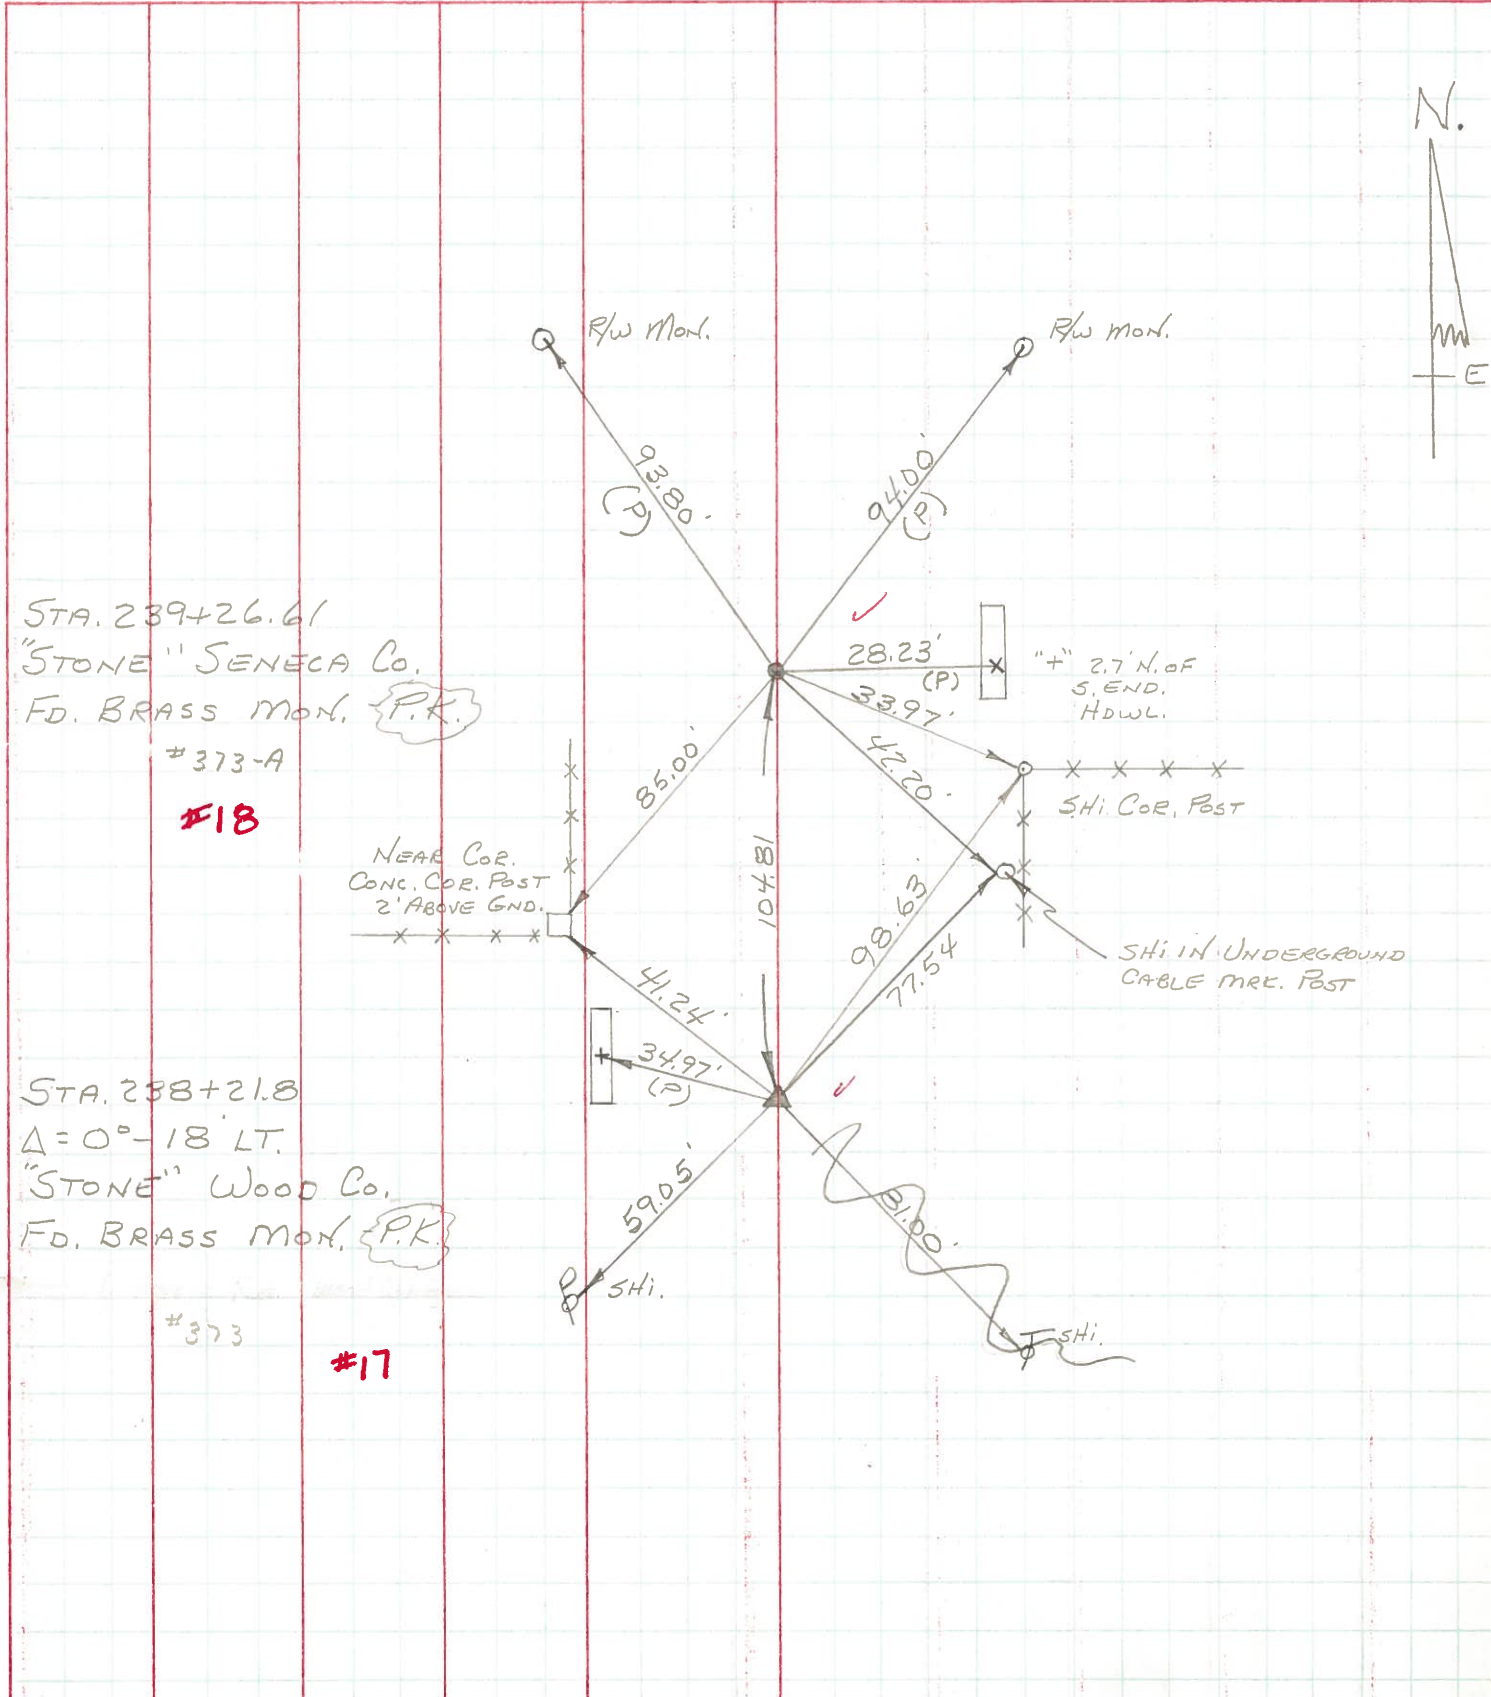

PERSONNEL	TITLE	PERSONNEL	TITLE	COUNTY	DATE
Jameson		Burns		Wood-Seneca	6-22-61
Powers		Heyman			2-7-64
Garno				S. R. 199 SH 529	WEATHER 75
Dolph				SEC. A	TEMP. Fair

DESCRIPTION Monument Location JOB NO. _____

LEFT CENTER LINE RIGHT

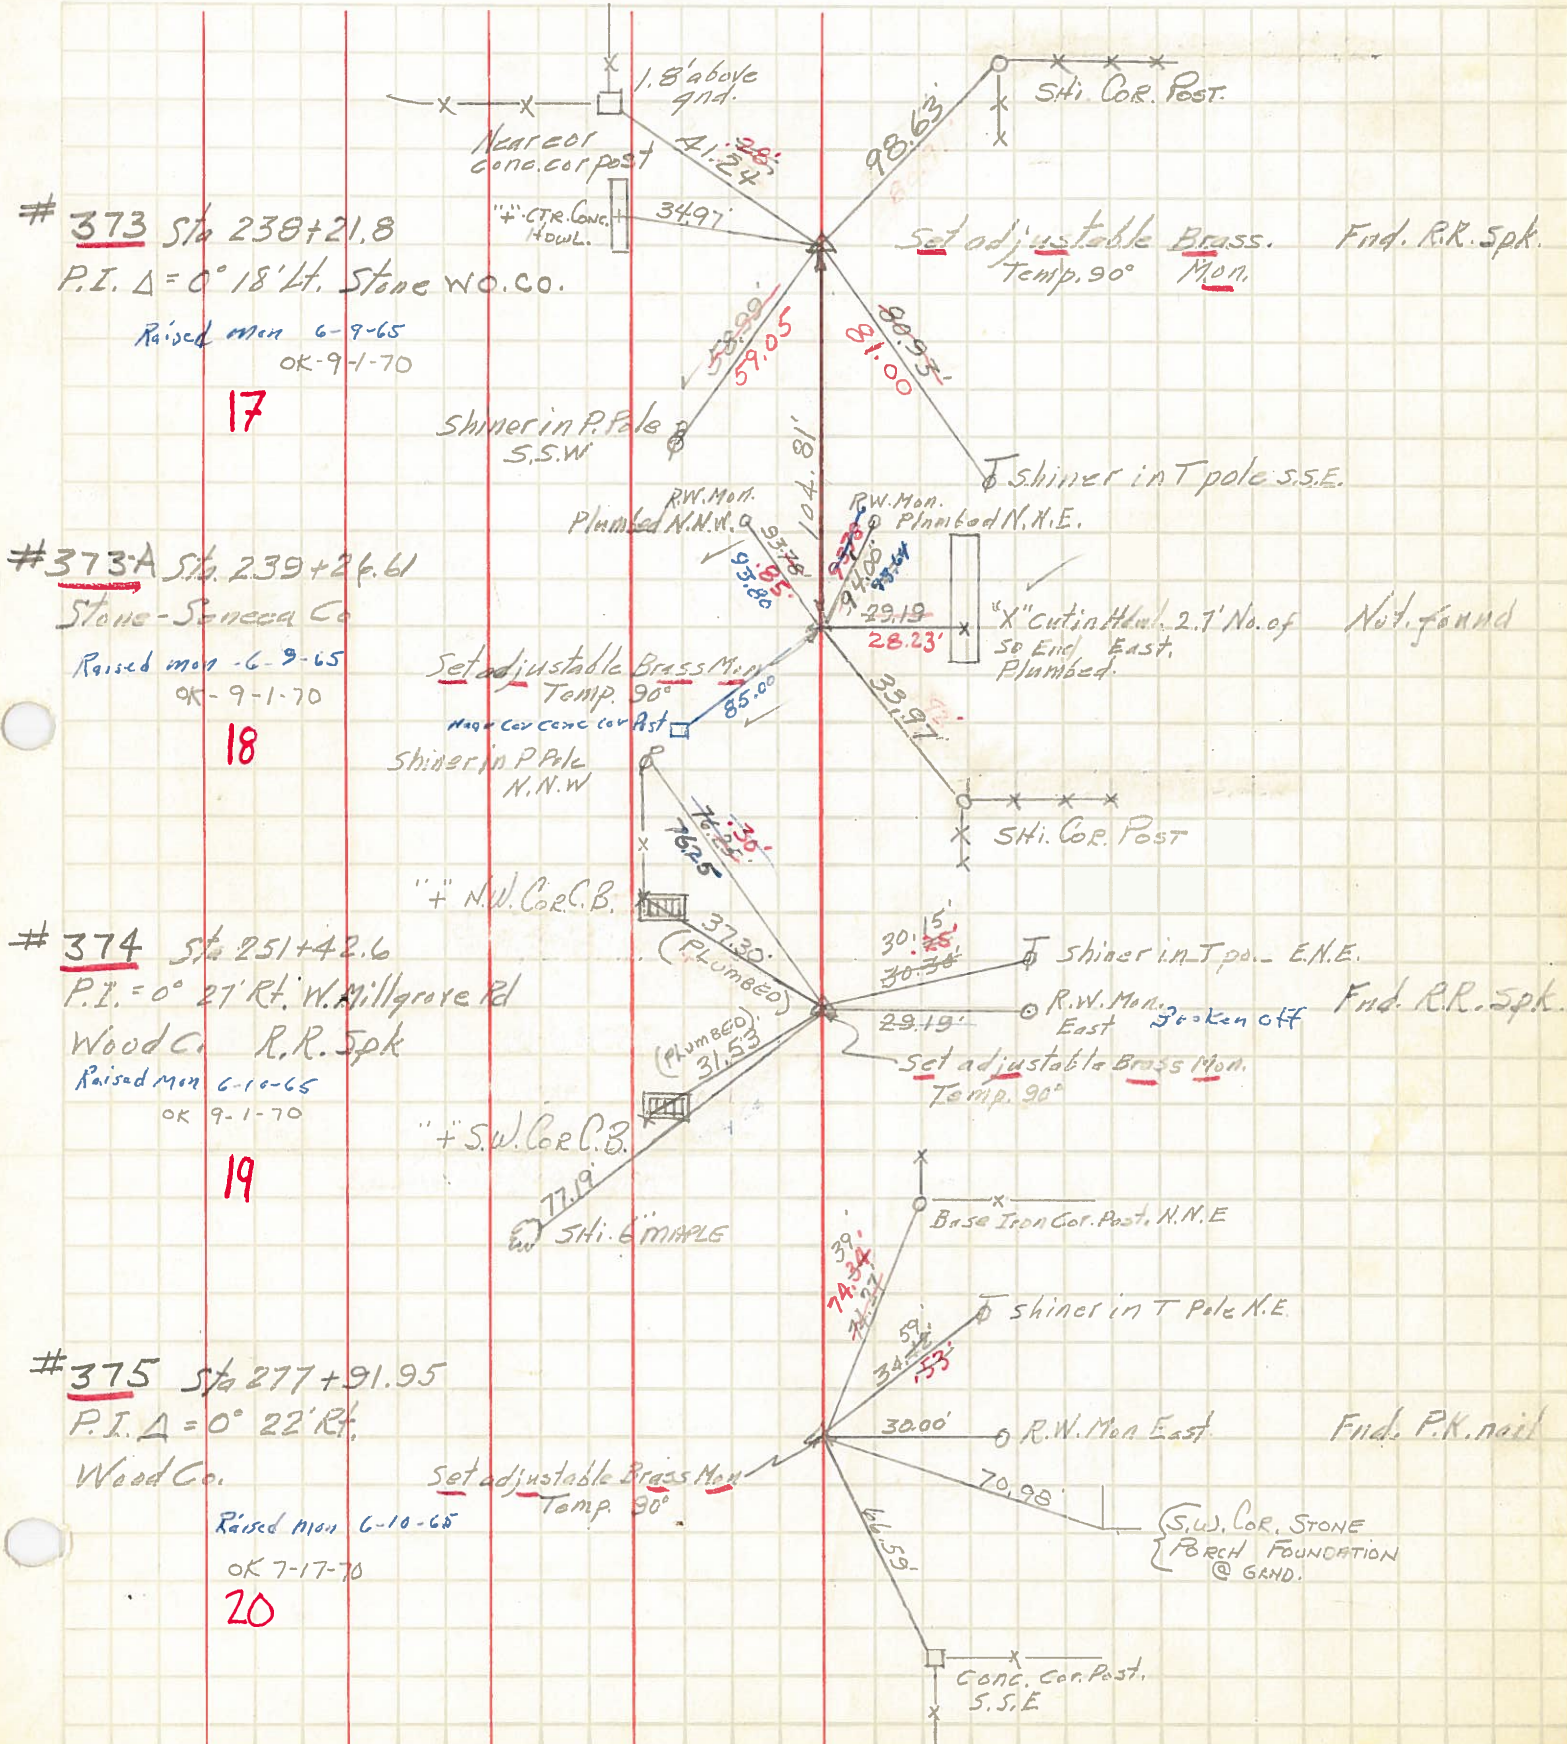

17

18

19

20