



O.D.O.T. DISTRICT 2 SURVEY OFFICE (USE ONLY)

PERSONNEL	REFERENCE NO.	<u>42</u>	SHEET	<u>9</u>	OF	<u>22</u>
NOTES	<u>RHOADES</u>	DATE	<u>4-21-14</u>	ROUTE	<u>US 23</u>	
H.C.	<u>ROUSOS</u>	WEATHER	<u>CLOUDY</u>	COUNTY	<u>WOOD</u>	
R.C.	<u>GABLE</u>	TEMP.	<u>62°</u>	TOWNSHIP	<u>FREEDOM</u>	
	<u>HOMAN</u>			SECTION	<u>24</u>	
				T	<u>5</u>	N
				R	<u>12</u>	E

TYPE MONUMENT PK SHANK
~~ON SURFACE~~ - BELOW 1" BELOW
~~LEFT - C PAV'T - RIGHT~~ ON
11.9 TO LT EDGE PAVEMENT
S.L.M. 767+96.39
Grid: Northing: 624606.691 Easting: 1716974.343

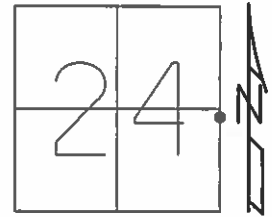

RECORD: POT
SHANK OF SM SPK
767+95.44
SET PKS & WASHERS
4-14-93, MB
FD, SHOT GPS
REFA42, REFB42
11-30-12, SAH
NEWREF42, NEWREFA42
FD MON BOX W/ 3/4" IPIN
10-17-16, JLL

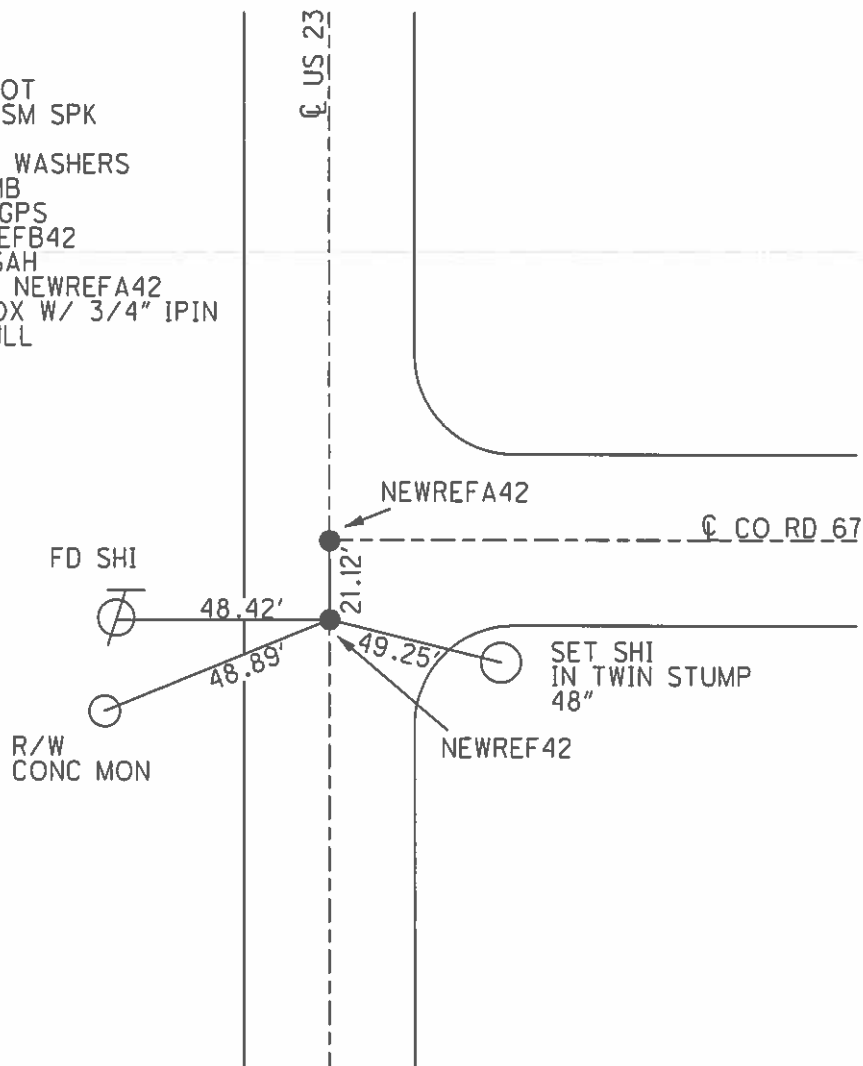

O.D.O.T. DISTRICT 2 SURVEY OFFICE

PERSONNEL

REFERENCE NO. 42

SHEET 5 OF 11

NOTES VAN DUSEN

H.C. VAN DUSEN

R.C. BARNHISEL

KUSZ

DATE 7-19-91

WEATHER OVERCAST

TEMP. +75° F.

ROUTE U.S. 23

COUNTY WOOD

TOWNSHIP FREEDOM

SECTION 24

T5 N R 12 E

PT A" PT B"


TYPE MONUMENT Shank of 5m. spk. Nail

ON SURFACE - BELOW 1" Below Surface

LEFT - & PAV'T. - RIGHT YES

11.9 TO LT EDGE PAVEMENT PT A"


S.L.M. 768+25 PT A" 17.5'S. of E to E.

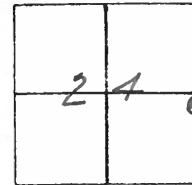

P.O.T. RECORD!
Shank of 5m. SPK.
767+95.44

SET P.K.'S & WASHERS
4-14-92
MB

POINT "B"
FD NAIL ON SURFACE
ORIGIN UNKNOWN

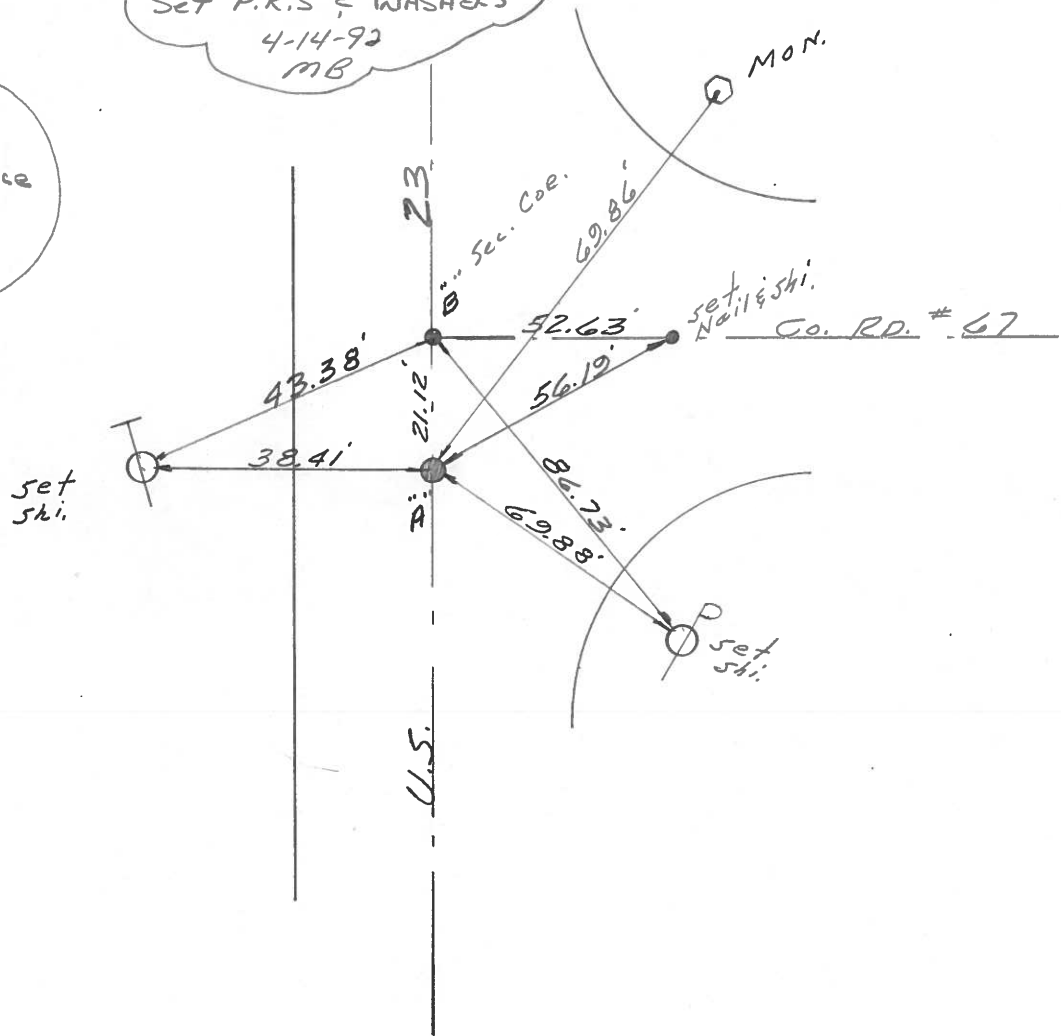

ODOT. DISTRICT 2 SURVEY OFFICE

SHEET _____ OF _____

County WOOD ^{U.S.} ~~S.R.~~ 23

Date 2-6-70

Township FREEDOM


Weather FAIR

Section 24

Temp. 40°

T5N, R12E


Personnel SCHEIDER
MOSSER
BARBOUR
POTTS

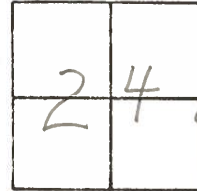

#42


P.O.T.
 767+95.44
 SMALL SPK.

23'

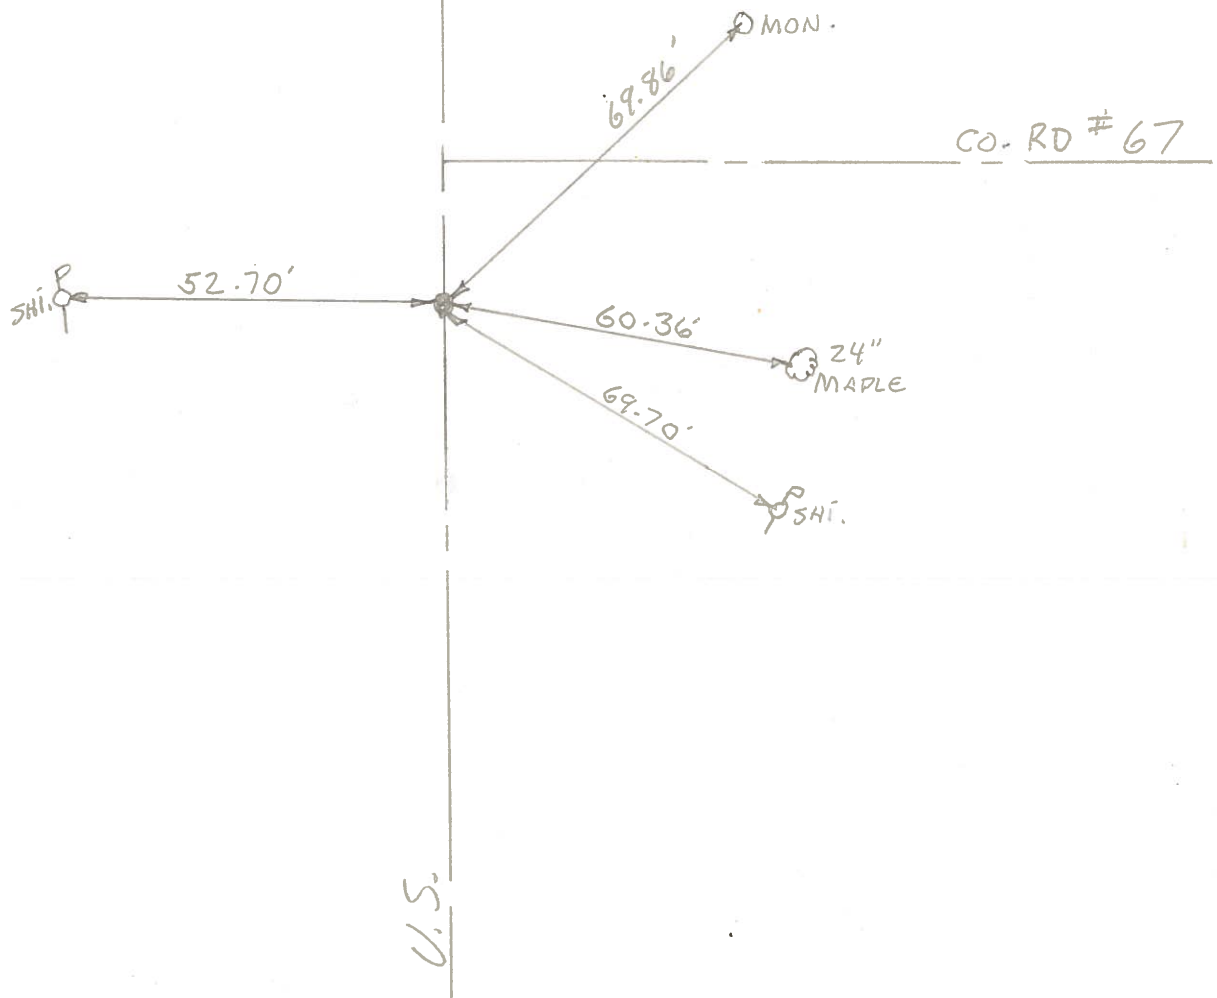

PERSONNEL	TITLE	PERSONNEL	TITLE	COUNTY	DATE
<u>Schneider</u>				<u>Sqa - Wood</u>	<u>2-6-70</u>
<u>Mosser</u>				S. R. <u>23</u>	WEATHER <u>Fair</u>
<u>Barbour</u>				SEC. <u>U.S. #6 - U.S. #20</u>	TEMP <u>40°</u>
<u>Potts</u>					

DESCRIPTION Ties for Control Points JOB NO. _____

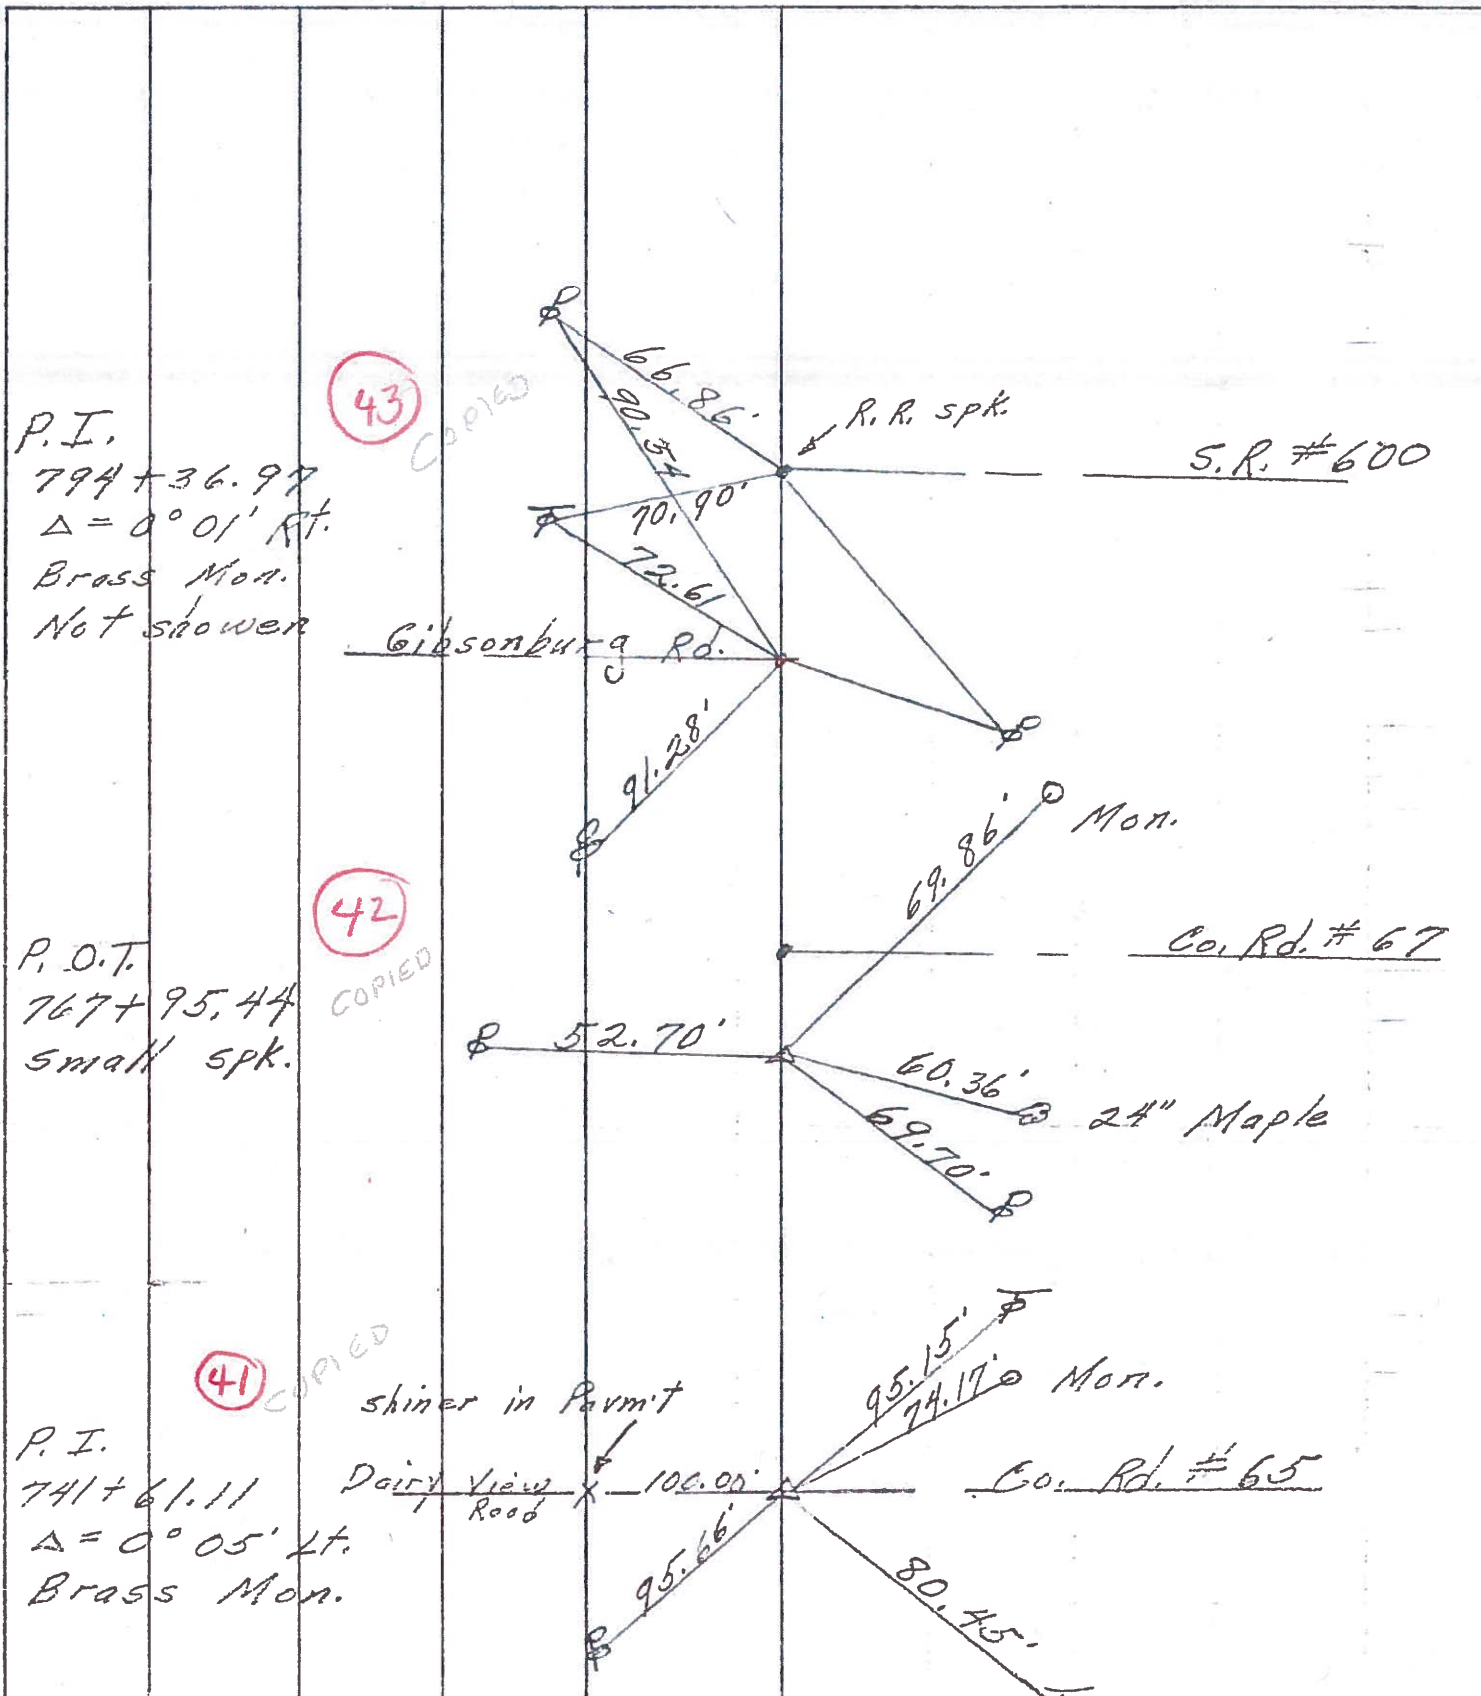

PERSONNEL	TITLE	PERSONNEL	TITLE
Sworders	Notes	Rice	
Cramin			
Halcombe			
Sege			


COUNTY San Woo DATE 6/29/60

S. R. #199 WEATHER Cloudy

SEC 45+6 North to 45+20 TEMP +80

DESCRIPTION Ties For Control Points JOB NO. _____

LEFT CENTER LINE RIGHT

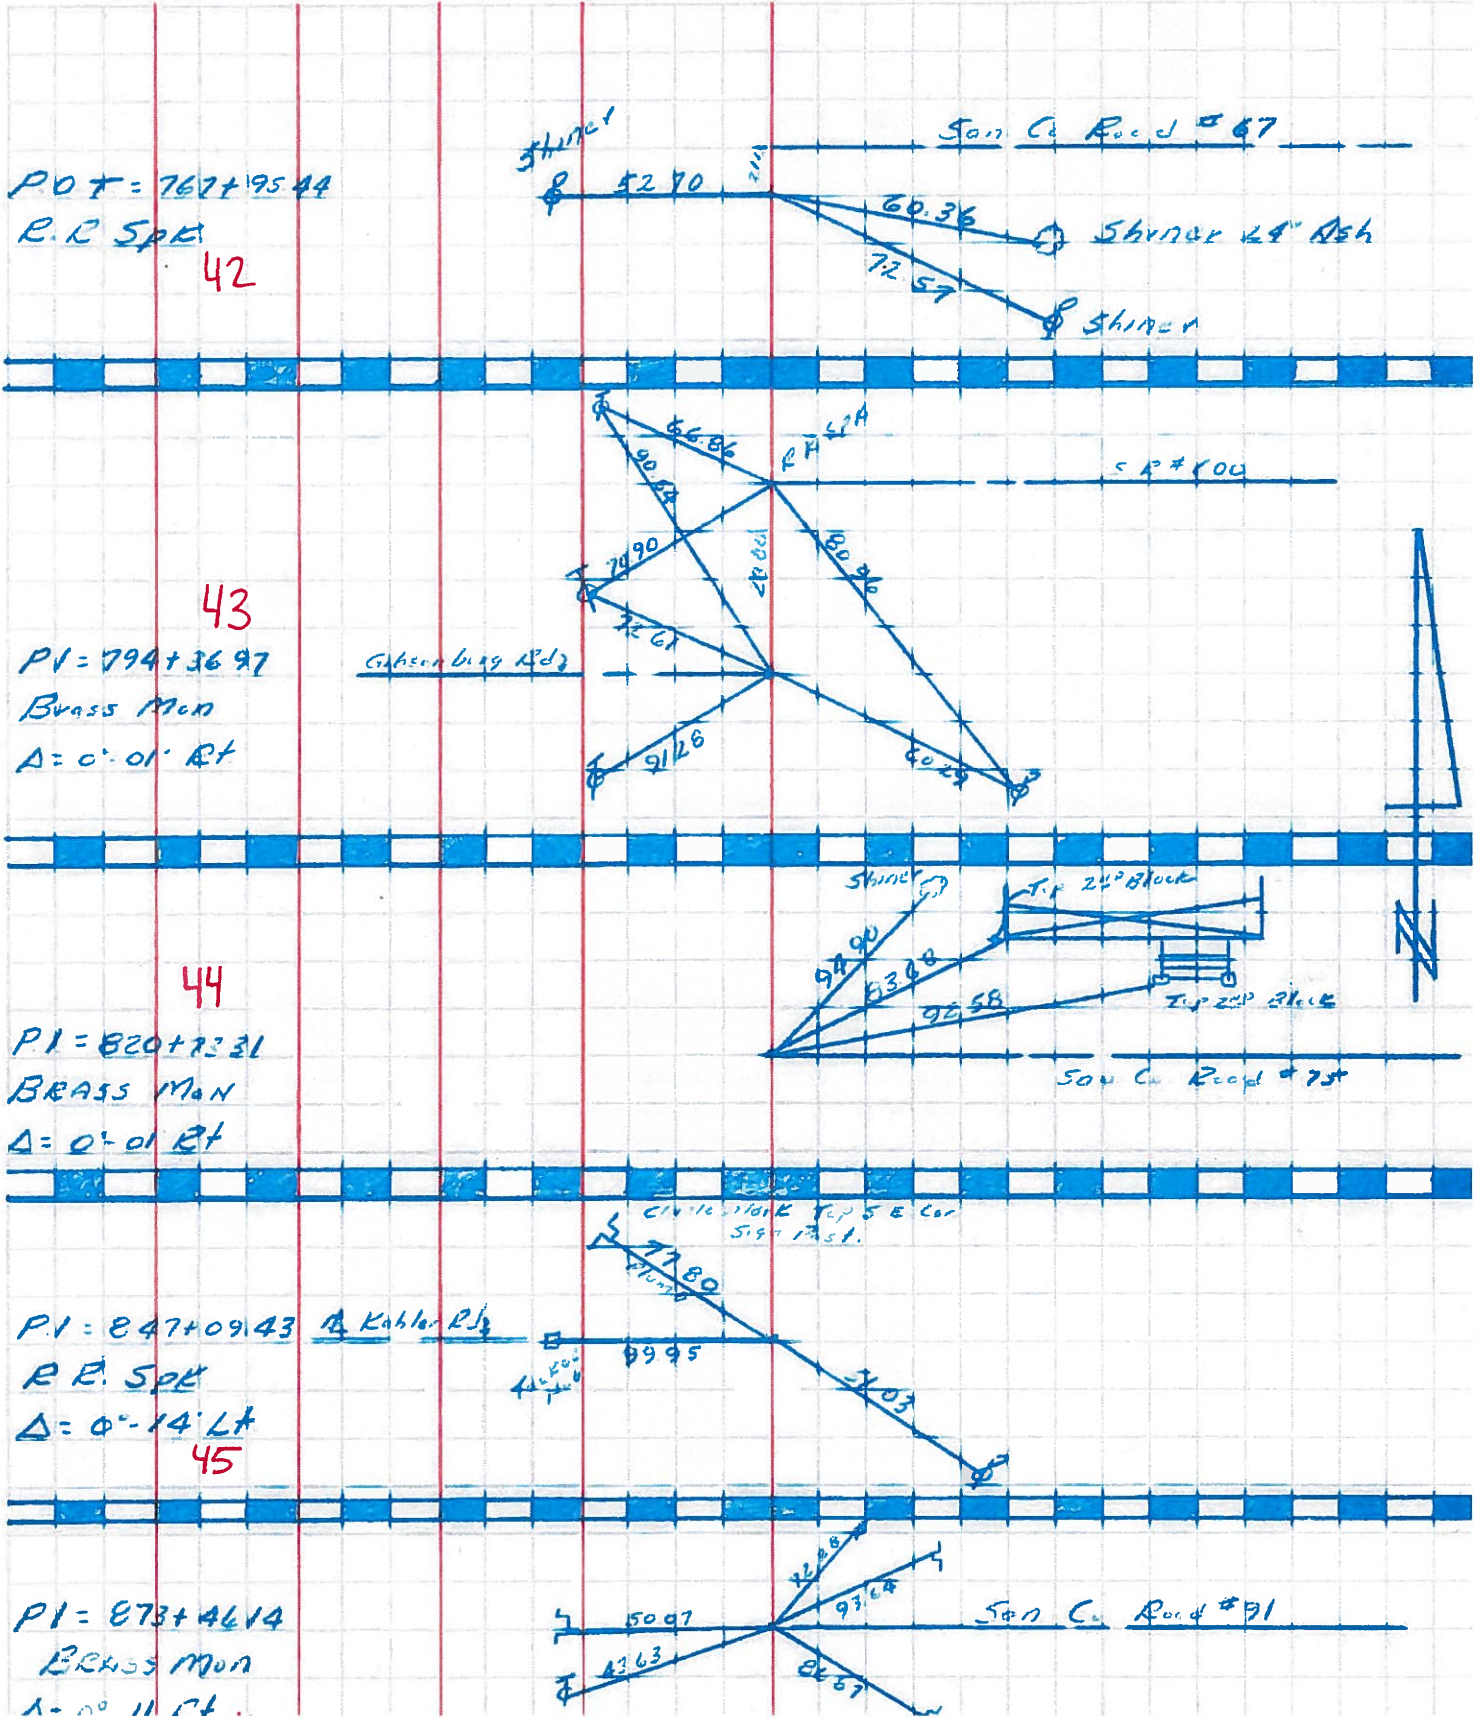

POB = 767+95.44

R.P. SPE
42

43

PI = 794+36.97

BRASS MON
Δ = 0°-01' RT

44

PI = 820+73.31

BRASS MON
Δ = 0°-01' RT

PI = 847+09.43

R.P. SPE
Δ = 0°-14' LT
45

PI = 873+46.14

BRASS MON
Δ = 0°-11' RT