


O.D.O.T. DISTRICT 2 SURVEY OFFICE (USE ONLY)


PERSONNEL \_\_\_\_\_ REFERENCE NO. 48 SHEET 21 OF 22  
 NOTES HOMAN DATE 4-22-14 ROUTE US 23  
 H.C. ROUSOS WEATHER CLOUDY COUNTY WOOD  
 R.C. GABLE TEMP. 60° TOWNSHIP FREEDOM  
 \_\_\_\_\_ SECTION 1  
 \_\_\_\_\_ T 5 N R 12 E

TYPE MONUMENT \_\_\_\_\_ SPK \_\_\_\_\_  
 ON SURFACE - ~~BELOW~~ \_\_\_\_\_ 1 1/2" \_\_\_\_\_  
~~LEFT~~ - Q PAV'T - ~~RIGHT~~ \_\_\_\_\_ ON \_\_\_\_\_  
 \_\_\_\_\_ 12' TO E EDGE PAVEMENT \_\_\_\_\_  
 S.L.M. \_\_\_\_\_ 926+42.36 \_\_\_\_\_

Grid: Northing: 640447.236 Easting: 1717388.551

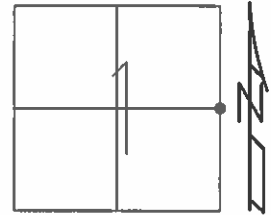

RECORD: PI  
 $\Delta=0^{\circ}-01'$  RT  
 SET PK 2-11-70  
 SET PK/WASHER  
 4-15-92, BVD  
 FD, GPS SHOTS  
 REF48  
 12-03-12, SAH  
 SET 3/4" IPIN IN  
 MON BOX FROM  
 STRADDLERS  
 NEWREF48  
 10-19-16, DCG, JLL

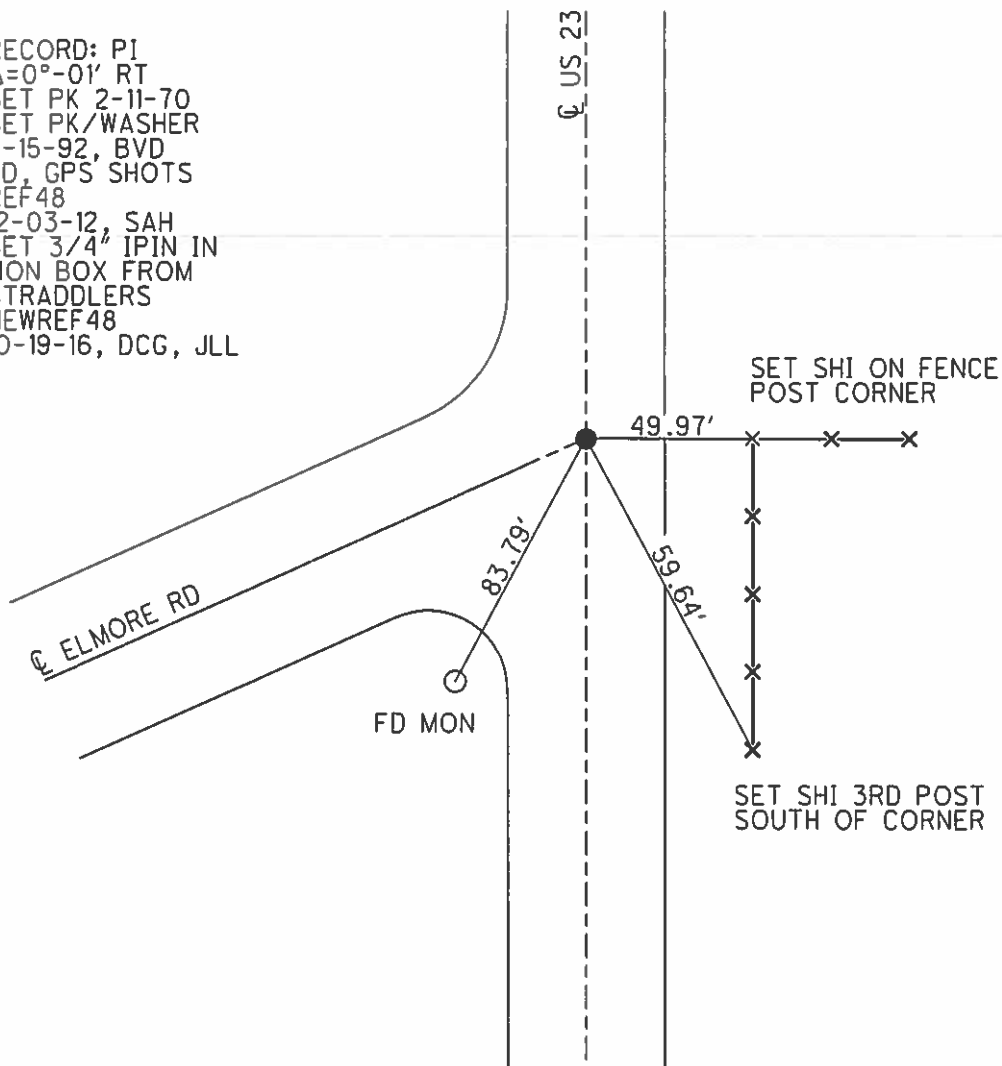

# O.D.O.T. DISTRICT 2 SURVEY OFFICE

PERSONNEL

REFERENCE NO. 48

SHEET 11 OF 11

NOTES Van Dusen

H.C. Barnhisel

R.C. Kusz

DATE 7-19-91

WEATHER Clear

TEMP. +90°F

ROUTE US 23

COUNTY Wood

TOWNSHIP Freedom

SECTION 1

T 5 N R 12 E


TYPE MONUMENT "PK" Nail

ON SURFACE - BELOW yes


LEFT - & PAV'T. - RIGHT yes

12' TO E. EDGE PAVEMENT

S.L.M. 926+88 (8' N. of & EX.)

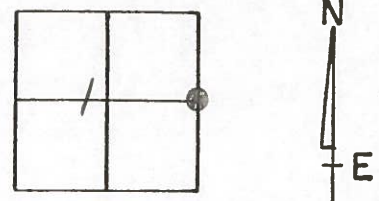

P.I. 926+41.90  
 $\Delta = 0^\circ - 01' RT.$   
 Set P.C.  
 Record 2-11-70

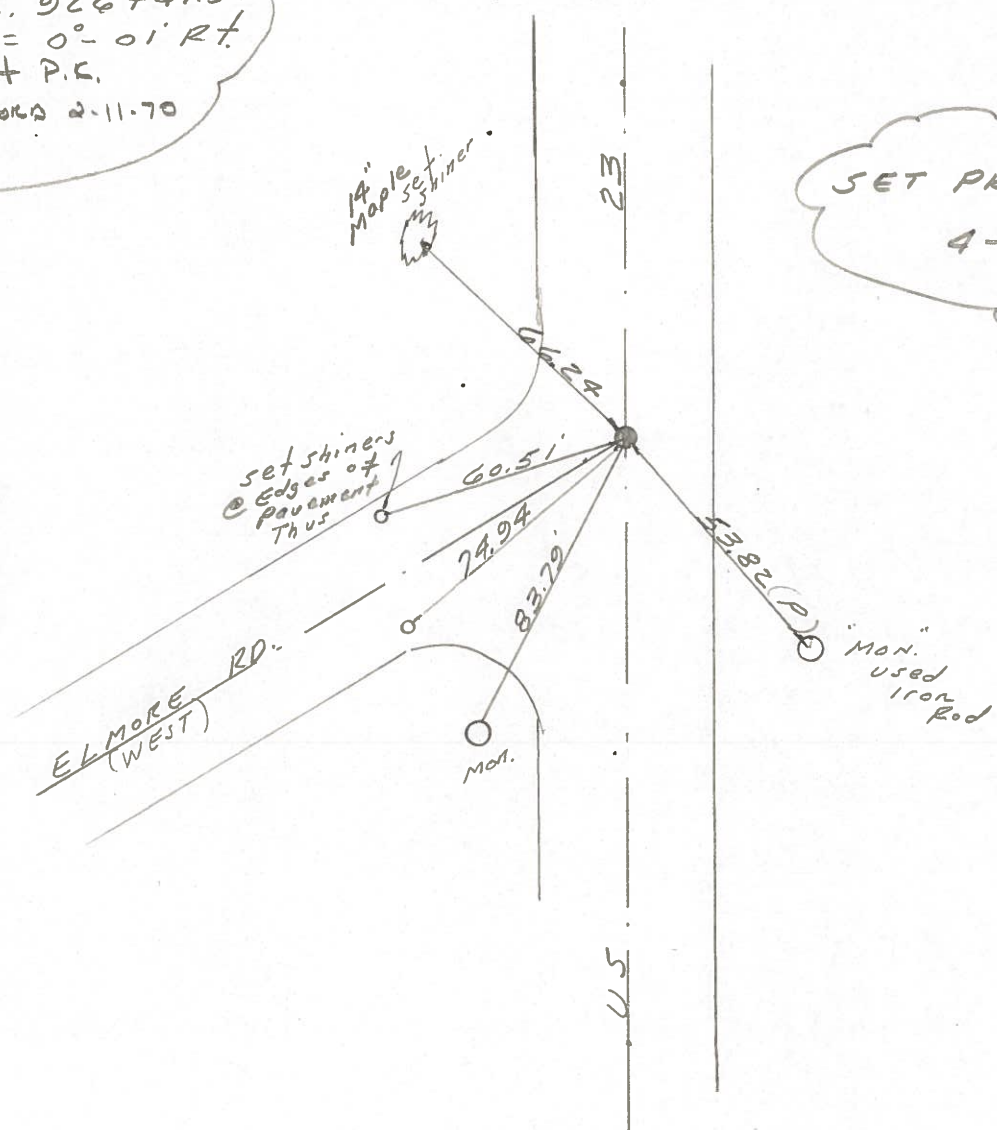

SET PK/WASHER  
4-15-92  
BVD

O.D.O.T. DISTRICT 2 SURVEY OFFICE

SHEET \_\_\_\_\_ OF \_\_\_\_\_

County WOOD <sup>U.S.</sup> S.R. 23

Date 2-11-70

Township FREEDOM


Weather CLOUDY

Section 1

Temp. 30°

T5N, R12E

Personnel SCHNEIDER  
MOSSEY  
BARBOUR  
POTTS

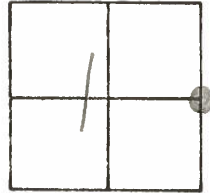


#48

P.I. 926+41.90

$\Delta = 0^\circ - 01' \text{ RT.}$

SET P.K. NAIL

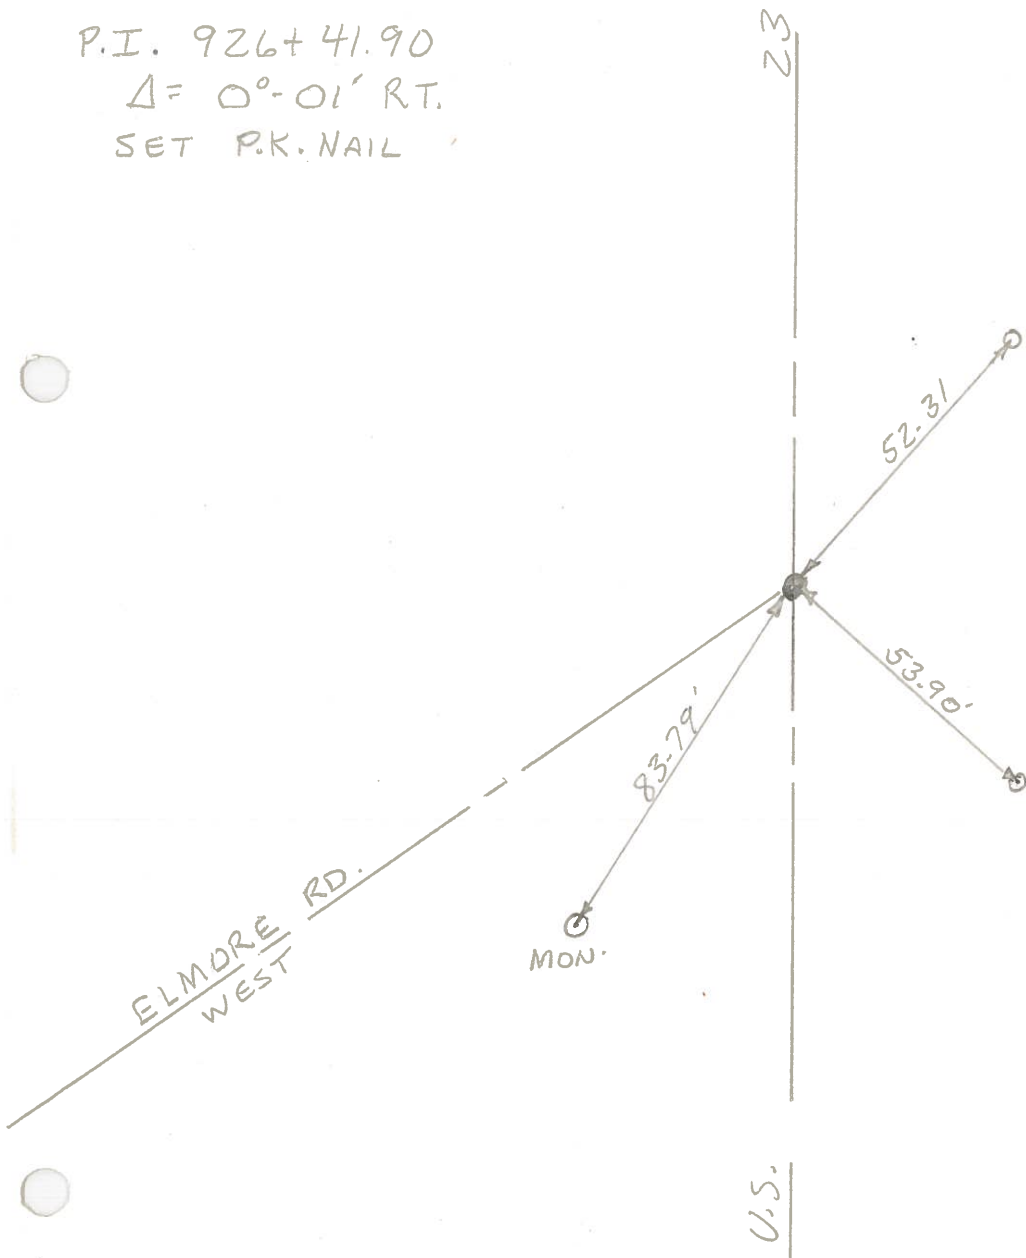

PERSONNEL	TITLE	PERSONNEL	TITLE	COUNTY	DATE
<u>Swarden</u>	<u>Notes</u>	<u>Rice</u>		<u>San-Woo</u>	<u>6-30-60</u>
<u>Cramin</u>				S. R. <u>#199</u>	WEATHER <u>Clear</u>
<u>Hulkamba</u>				SEC. <u>U.S.#61 U.S.#20</u>	TEMP <u>+80°</u>
<u>Sage</u>					

DESCRIPTION Tie for Control Point JOB NO.         

