

O.D.O.T. DISTRICT 2 SURVEY OFFICE (USE ONLY)

PERSONNEL _____ REFERENCE NO. A SHEET 1 OF 36

NOTES HUSS DATE 4/12/01 ROUTE SR 25
 H.C. ROUSOS WEATHER CLOUDY/WINDY COUNTY WOOD
 R.C. VAN DUSEN TEMP. 72° TOWNSHIP HENRY
 SECTION 1

DWG BY MILLER PID _____ T 3 N R 10 E

TYPE MONUMENT _____ MONBOX _____

ON SURFACE - ~~BELOW~~ ON _____


OFFSET ϕ PAVEMENT ON _____ ~~LT~~: ~~RT~~

11.3' TO RT EDGE PAVEMENT


STATION: 28+51.20

HORZ. DATUM: _____ GEOID: _____

GRID: NORTHING: _____ EASTING: _____

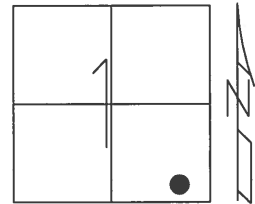

RECORD: P.C.
 PLAN STA 0+90
 SLM 0.54= 28+51
 3-22-91
 FD MONBOX
 4/12/01, DCH

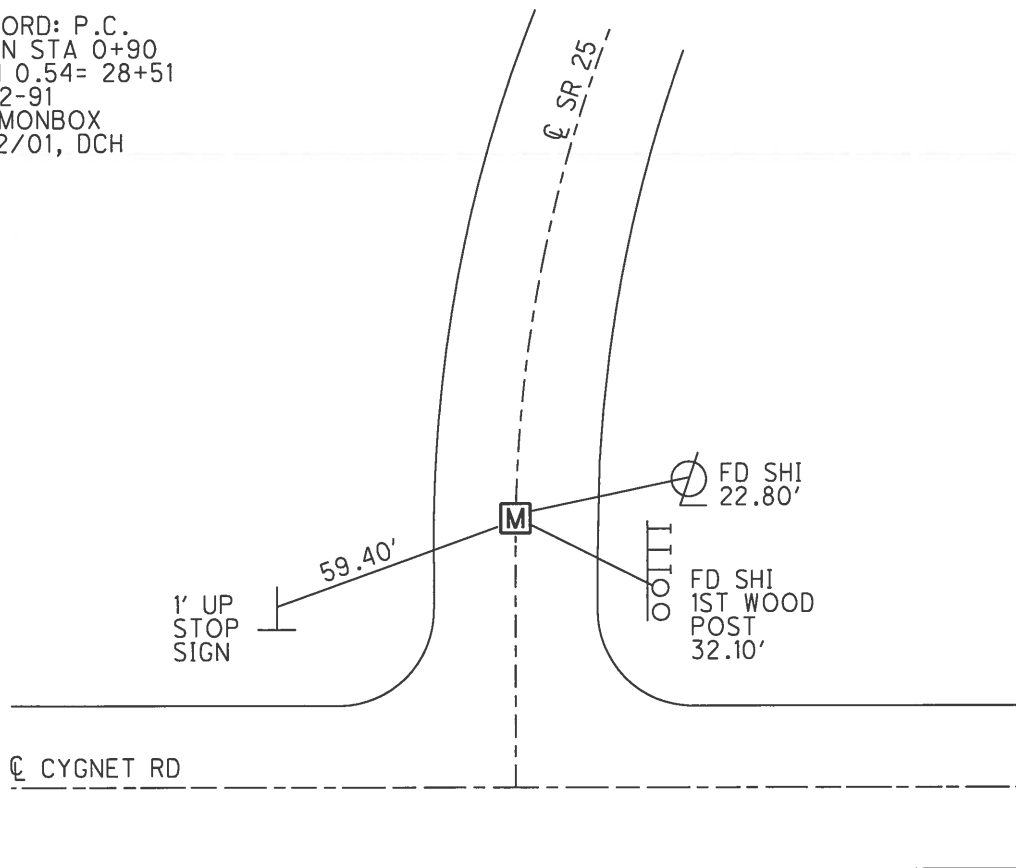

O.D.O.T. DISTRICT 2 SURVEY OFFICE

PERSONNEL _____

REFERENCE NO. 7

SHEET 1 OF 23

NOTES Huss

H.C. Rouso

R.C. Van Nusen

DATE 4-12-01

WEATHER Pt Cldy - Windy

TEMP. 72°F

ROUTE SR-25

COUNTY Wood

TOWNSHIP Henry

SECTION 1

T 3 N R 10 E


TYPE MONUMENT Mon Box

ON SURFACE - ~~BELOW~~ Surface

~~LEFT~~ - E PAV T - ~~RIGHT~~ E Pav.

11.3, 11.7 TO RT EDGE PAVEMENT


S.L.M.: 28+51.20 , 30+62.40

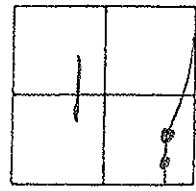

Revised:

A = Plan PC - 3-22-91
 Plan Sta 0+90
 SLM - 0.540 = 28+51

B Plan = PT 3-22-91
 Plan = Sta 3+00.02
 SLM = 0.580 = 30+62

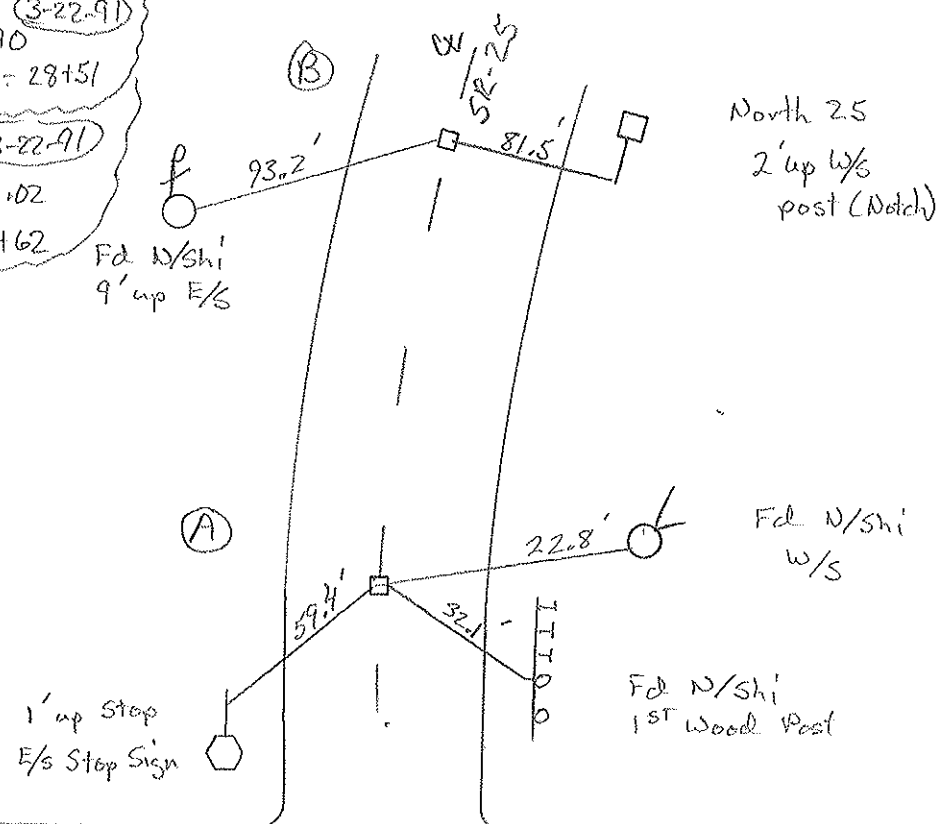

E Pav.
Cygnat Rd

Resurfaced 2001

O.D.O.T. DISTRICT 2 SURVEY OFFICE

PERSONNEL

REFERENCE NO. _____

SHEET 1 OF 23

NOTES HOFFMAN

H.C. LOEHRKE

R.C. BARNHISEL

DATE 3-22-91

WEATHER CLOUDY

TEMP. 55°

ROUTE SR 25

COUNTY WOOD

TOWNSHIP HENRY

SECTION 1

T 3 N R 10 E

TYPE MONUMENT Mon. Box

ON SURFACE - BELOW YES


LEFT - C PAV'T. - RIGHT YES

11.9' ± 11.7' TO RT. EDGE PAVEMENT

S.L.M. 28 + 51.20 ± 30 + 62.40

(A)


(B)

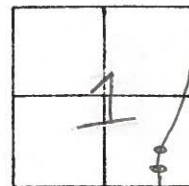


MONUMENT BOX - DID NOT OPEN

PLAN: P.T. 3+00.02

SLM: 30+62.40 (0.580)

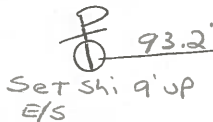


CUT NOTCH 2' UP SIGN

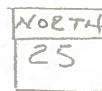

MONUMENT BOX - DID NOT OPEN

PLAN: P.C. STA 0+90.00

SLM: 28+51.20 (0.540)

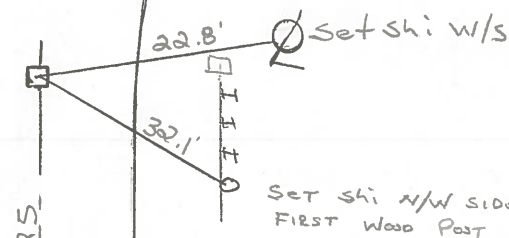

C PAV'T

CYGNET RD.