

O.D.O.T. DISTRICT 2 SURVEY OFFICE (USE ONLY)

PERSONNEL

REFERENCE NO. B

SHEET 2 OF 36

NOTES HUSS

DATE 4/12/01

ROUTE SR 25

H.C. ROUSOS

WEATHER CLOUDY/WINDY

COUNTY WOOD

R.C. VAN DUSEN

TEMP. 72°

TOWNSHIP HENRY

SECTION 1

DWG BY MILLER PID _____

T 3 N R 10 E

TYPE MONUMENT MONBOX

ON SURFACE - ~~BELOW~~ ON _____

OFFSET ϕ PAVEMENT ON LT : ~~RT~~

11.7' TO RT EDGE PAVEMENT


STATION: 30+62.40

HORZ.DATUM: _____


GEOID: _____

GRID: NORTHING: _____

EASTING: _____

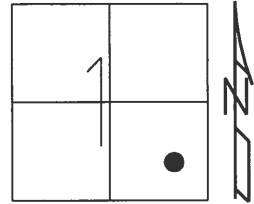

RECORD: P.T.
PLAN STA 3+00.02
SLM 0.58=30+62
3-22-91
FD MONBOX
4/12/01, DCH

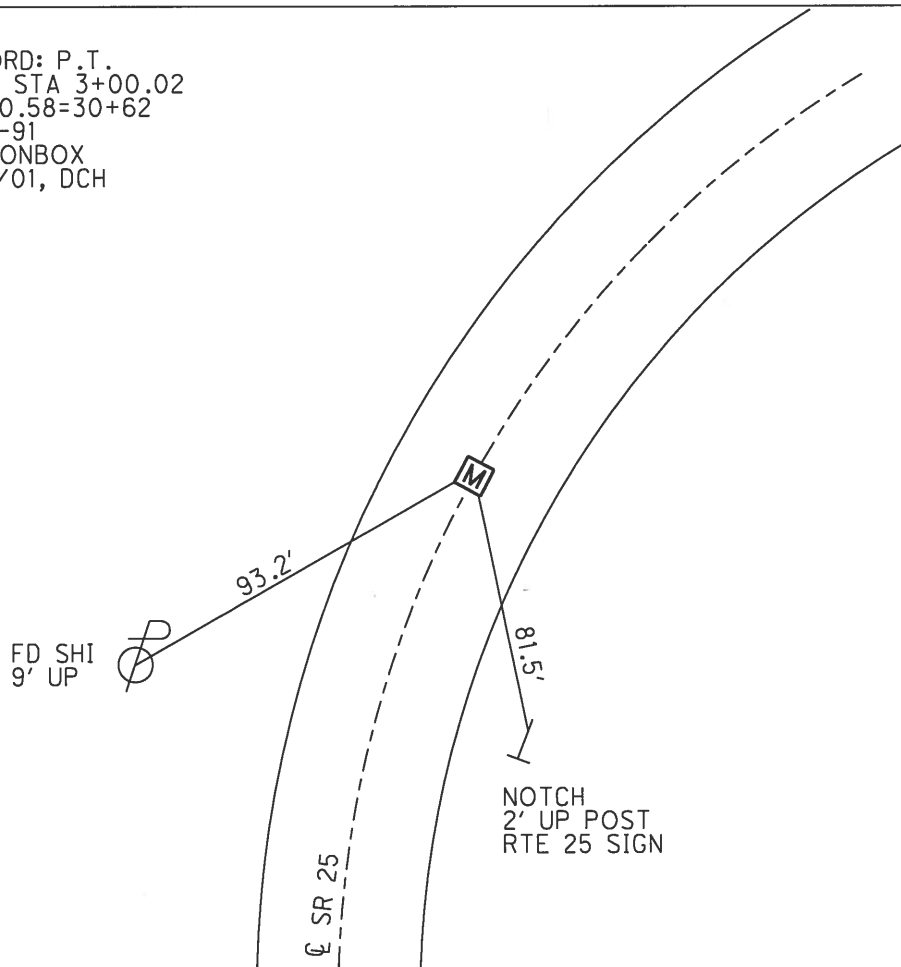

O.D.O.T. DISTRICT 2 SURVEY OFFICE

PERSONNEL _____

REFERENCE NO. 7

SHEET 1 OF 23

NOTES Huss

H.C. Rouso

R.C. Van Nusen

DATE 4-12-01

WEATHER Pt Cldy - Windy

TEMP. 72°F

ROUTE SR-25

COUNTY Wood

TOWNSHIP Henry

SECTION 1

T 3 N R 10 E


TYPE MONUMENT Mon Box

ON SURFACE - BELOW Surface

LEFT - (E PAV T) - RIGHT E Pav.

11.3, 11.7 TO RT EDGE PAVEMENT


S.L.M.: (A) 28+51.20, (B) 30+62.40

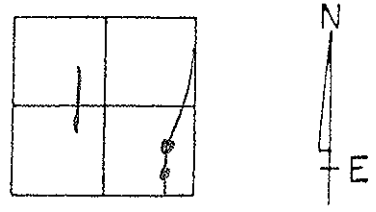

Revised:

A = Plan PC - (3-22-91)
 Plan Sta 0+90
 SLM - 0.540 = 28+51

B Plan = PT (3-22-91)
 Plan Sta = 3+00.02
 SLM = 0.580 = 30+62

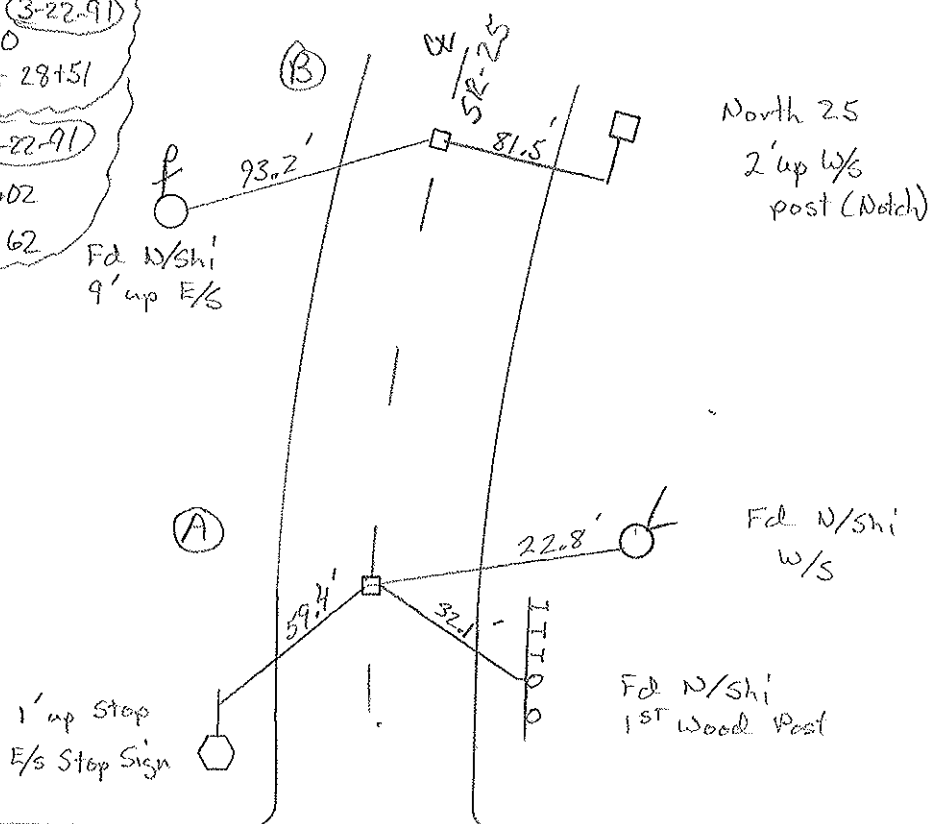

E Pav.
Cygnat Rd

Resurfaced 2001

O.D.O.T. DISTRICT 2 SURVEY OFFICE

PERSONNEL

REFERENCE NO. _____

SHEET 1 OF 23

NOTES HOFFMAN

H.C. LOEHRKE

R.C. BARNHISEL

DATE 3-22-91

WEATHER CLOUDY

TEMP. 55°

ROUTE SR 25

COUNTY WOOD

TOWNSHIP HENRY

SECTION 1

T 3 N R 10 E

TYPE MONUMENT Mon. Box

ON SURFACE - BELOW YES


LEFT - C PAV'T. - RIGHT YES

11.9' ± 11.7' TO RT. EDGE PAVEMENT

S.L.M. 28 + 51.20 ± 30 + 62.40

(A)


(B)

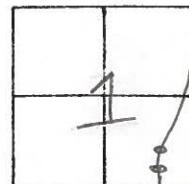


MONUMENT BOX - DID NOT OPEN

PLAN: P.T. 3+00.02

SLM: 30+62.40 (0.580)

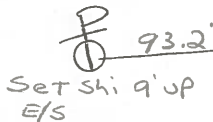


CUT NOTCH 2' UP SIGN

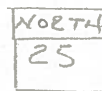

MONUMENT BOX - DID NOT OPEN

PLAN: P.C. STA 0+90.00

SLM: 28+51.20 (0.540)

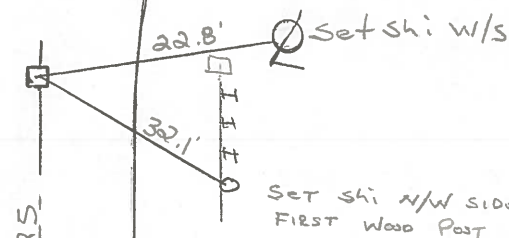

± Pav't SR 25

± Pav't

CYGNET RD.