

O.D.O.T. DISTRICT 2 SURVEY OFFICE (USE ONLY)

PERSONNEL _____ REFERENCE NO. C SHEET 3 OF 36

NOTES HUSS DATE 4/12/01 ROUTE SR 25

H.C. ROUSOS WEATHER CLOUDY/WINDY COUNTY WOOD

R.C. VAN DUSEN TEMP. 72° TOWNSHIP HENRY

SECTION 1

DWG BY MILLER PID _____

T 3 N R 10 E

TYPE MONUMENT MONBOX

ON SURFACE - ~~BELOW~~ ON


OFFSET ϕ PAVEMENT ON ~~LT:RT~~

11.3' TO RT EDGE PAVEMENT


STATION: 36+48.48

HORZ.DATUM: _____ GEOID: _____

GRID: NORTHING: _____ EASTING: _____

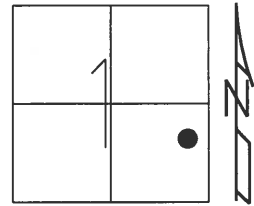

RECORD: P.C.
PLAN STA. 8+92.10
FD MONBOX
4/12/01, TMR

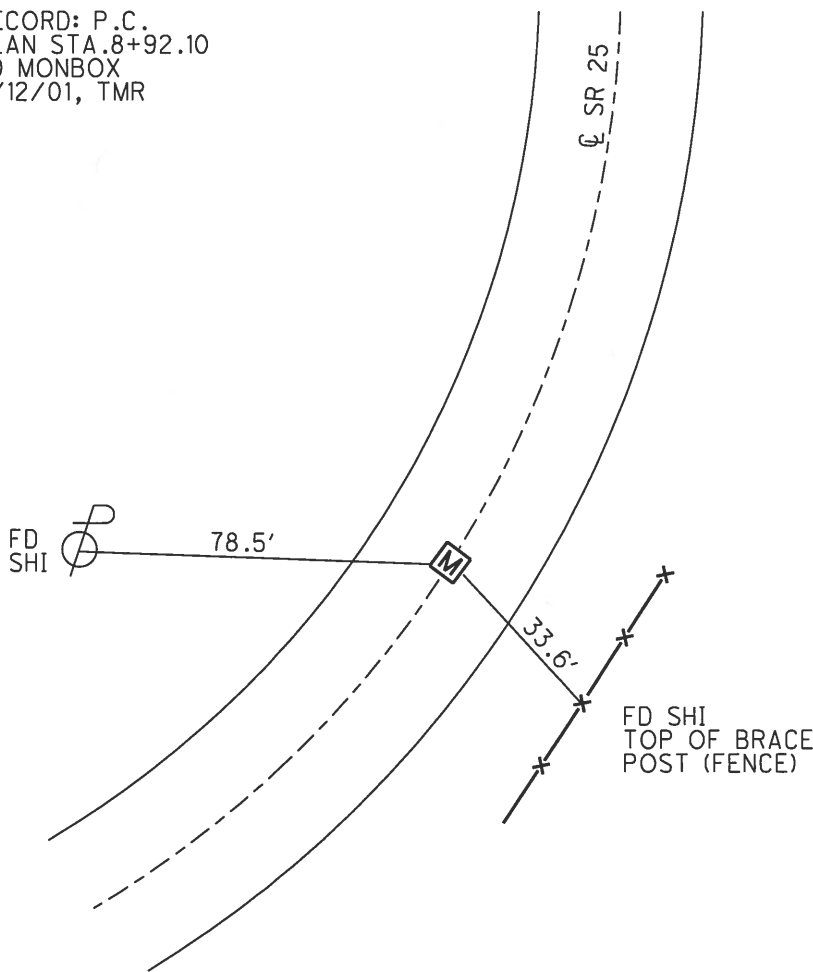

O.D.O.T. DISTRICT 2 SURVEY OFFICE

PERSONNEL _____

REFERENCE NO. _____

SHEET 2 OF 23

NOTES Huss

H.C. Rousos

R.C. Van Dusen

DATE 4-12-01

WEATHER Pt Clay - Windy

TEMP. 72°F

ROUTE SR-25

COUNTY Wood

TOWNSHIP Henry

SECTION 1

T 3 N R 10 E


TYPE MONUMENT Mon Box

ON SURFACE - ~~BELOW~~ Surface

~~LEFT~~ - E PAV'T - ~~RIGHT~~

113,117 TO RT EDGE PAVEMENT


S.L.M. (A) 86+48.48 (B) 44+08.80

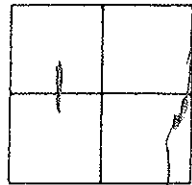

Record:

(A) R.B. Plan Sta: PC
8+92.10 (0.69) ^{SLM}

(B) M/B Plan Sta: PT
16+47.10 (0.835) ^{SLM}

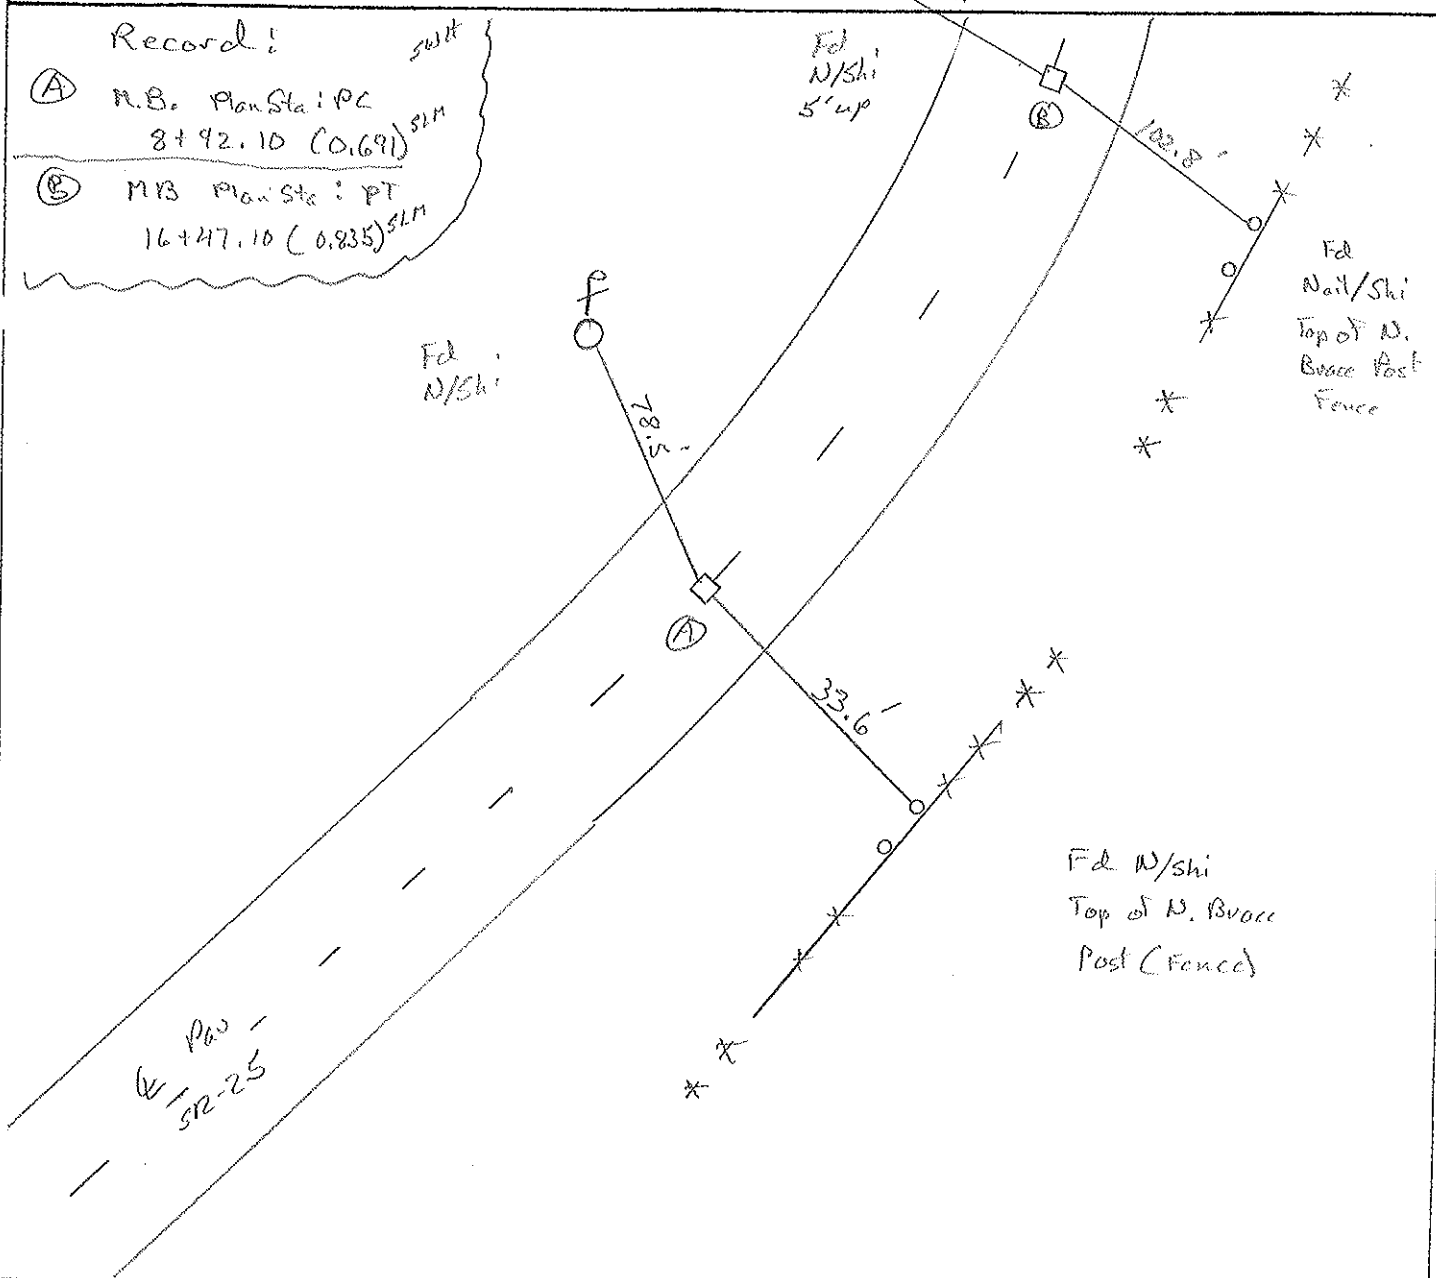

O.D.O.T. DISTRICT 2 SURVEY OFFICE

PERSONNEL _____

REFERENCE NO. _____

SHEET 2 OF 23

NOTES HOFFMAN

H.C. LOEHRKE

R.C. BARNHISEL

DATE 3-22-91

WEATHER CLOUDY

TEMP. 55°

ROUTE SR 25

COUNTY WOOD

TOWNSHIP HENRY

SECTION 1

T 3 N R 10 E

(C) (D)


TYPE MONUMENT Mon. Box

ON SURFACE - BELOW yes

LEFT - & PAV'T. - RIGHT yes

11.3' ± 11.7' TO RT. EDGE PAVEMENT



S.L.M. 36+48.48 & 44+08.80

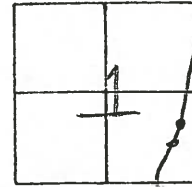

Set shi
5' up sets



MONUMENT
BOX - DID NOT OPEN
PLAN STA: P.T. 16+47.10
S.L.M.: 44+08.80
(0.835)

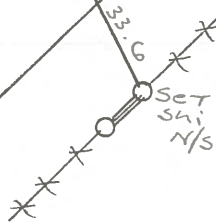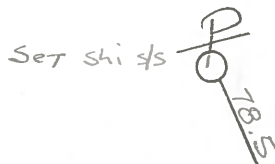

MONUMENT BOX - DID NOT OPEN
PLAN STA: P.C. 8+92.10
S.L.M.: 36+48.48
(0.691)

