


O.D.O.T. DISTRICT 2 SURVEY OFFICE (USE ONLY)


PERSONNEL _____ REFERENCE NO. E SHEET 5 OF 36
NOTES HUSS DATE 4/12/01 ROUTE SR 25
H.C. ROUSOS WEATHER CLOUDY/WINDY COUNTY WOOD
R.C. VAN DUSEN TEMP. 72° TOWNSHIP HENRY
DWG BY MILLER PID _____ SECTION 1
T 3 N R 10 E

TYPE MONUMENT MONBOX
ON SURFACE - ~~BELOW~~ ON
OFFSET Q PAVEMENT ON LT : RT
11' TO RT EDGE PAVEMENT
STATION: 55+12.32

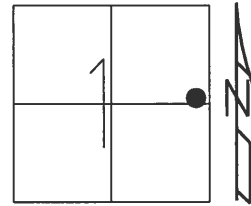

HORZ.DATUM: _____ GEOID: _____
GRID: NORTHING: _____ EASTING: _____

RECORD: P.C.
PLAN STA. 27+57.77
FD MONBOX
4/12/01, TMR

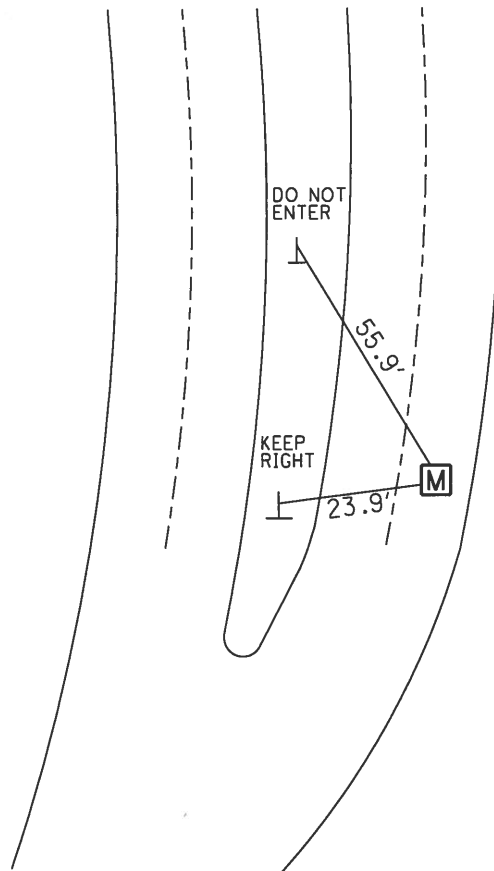

CUT NOTCHES
1' UP NEAR/S
SIGN POSTS

O.D.O.T. DISTRICT 2 SURVEY OFFICE

PERSONNEL _____

REFERENCE NO. _____

SHEET 3 OF 23

NOTES Huss

H.C. Roussos

R.C. VanDusen

DATE 4-12-01

WEATHER Pt Cldy-Windy

TEMP. 72°F

ROUTE SR-25

COUNTY Wood

TOWNSHIP Henry

SECTION 1

T 3 N R 10 E



TYPE MONUMENT Mon Box

~~ON SURFACE~~ ~~BELOW~~ Surface

~~LEFT - E PAV'T - RIGHT~~ E N.B. Pav

11.0, 11.7 TO Rt EDGE PAVEMENT

S.L.M. (A) 55+12.32 (B) 59+61.12

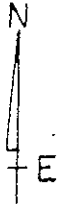
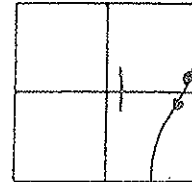


Record:

(A) Mon Box
Plan Sta - PC 27+57.77
SLM - 1.044

(B) Mon Box
Plan Sta - PT 31+97.77
SLM - 1.129 S.W.H.

Fd W/shi
E/S M.B. Post
for Wayne Homes

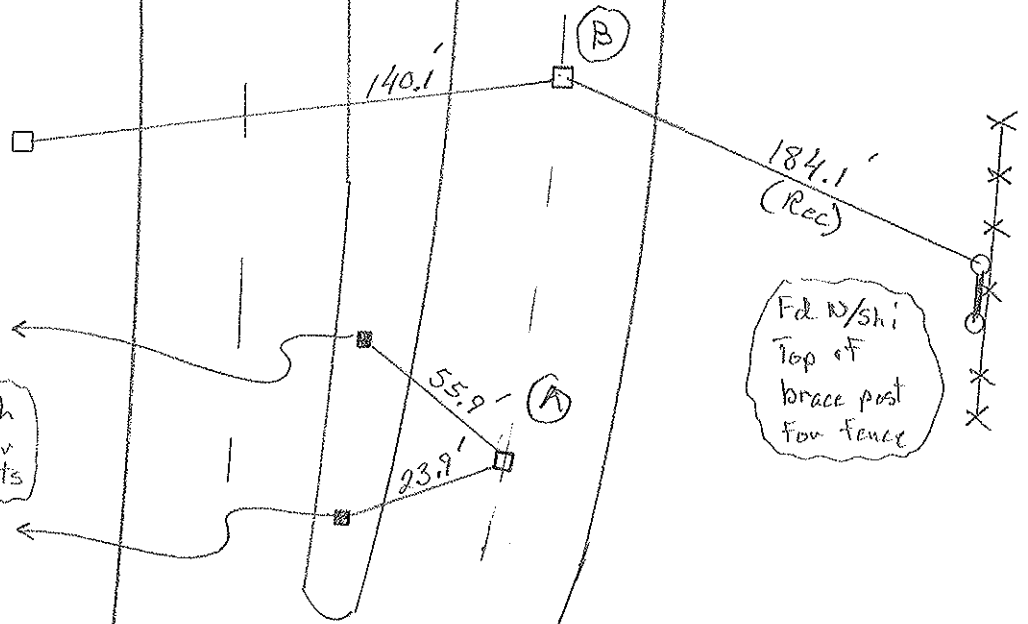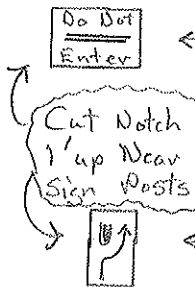

O.D.O.T. DISTRICT 2 SURVEY OFFICE

PERSONNEL _____

REFERENCE NO. _____

SHEET 3 OF 23

NOTES HOFFMAN

H.C. LOEHRKE

R.C. BARNHISEL

DATE 3-22-91

WEATHER cloudy

TEMP. 55°

ROUTE S.R. 25

COUNTY WOOD

TOWNSHIP HENRY

SECTION 1

T.3 N R.10 E

TYPE MONUMENT Mon. Box

ON SURFACE - BELOW yes

LEFT- & PAV'T. - RIGHT yes

11.07 TO RT. EDGE PAVEMENT

S.L.M. 55+12.32 & 59+61.12

(E) (F)

