

O.D.O.T. DISTRICT 2 SURVEY OFFICE (USE ONLY)

PERSONNEL _____

REFERENCE NO. F

SHEET 6 OF 36

NOTES HUSS

DATE 4/12/01

ROUTE SR 25

H.C. ROUSOS

WEATHER CLOUDY/WINDY

COUNTY WOOD

R.C. VAN DUSEN

TEMP. 72°

TOWNSHIP HENRY

SECTION 1

DWG BY MILLER PID _____

T 3 N R 10 E

TYPE MONUMENT MONBOX

ON SURFACE - ~~BELOW~~ ON _____

OFFSET Q PAVEMENT ON LT : ~~RT~~

11.7' TO RT EDGE PAVEMENT


STATION: 59+61.12

HORZ. DATUM: _____


GEOID: _____

GRID: NORTHING: _____

EASTING: _____

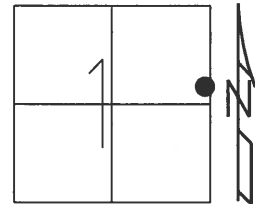

RECORD: P.T.
PLAN STA. 31+97.77
FD MONBOX
4/12/01, SAH

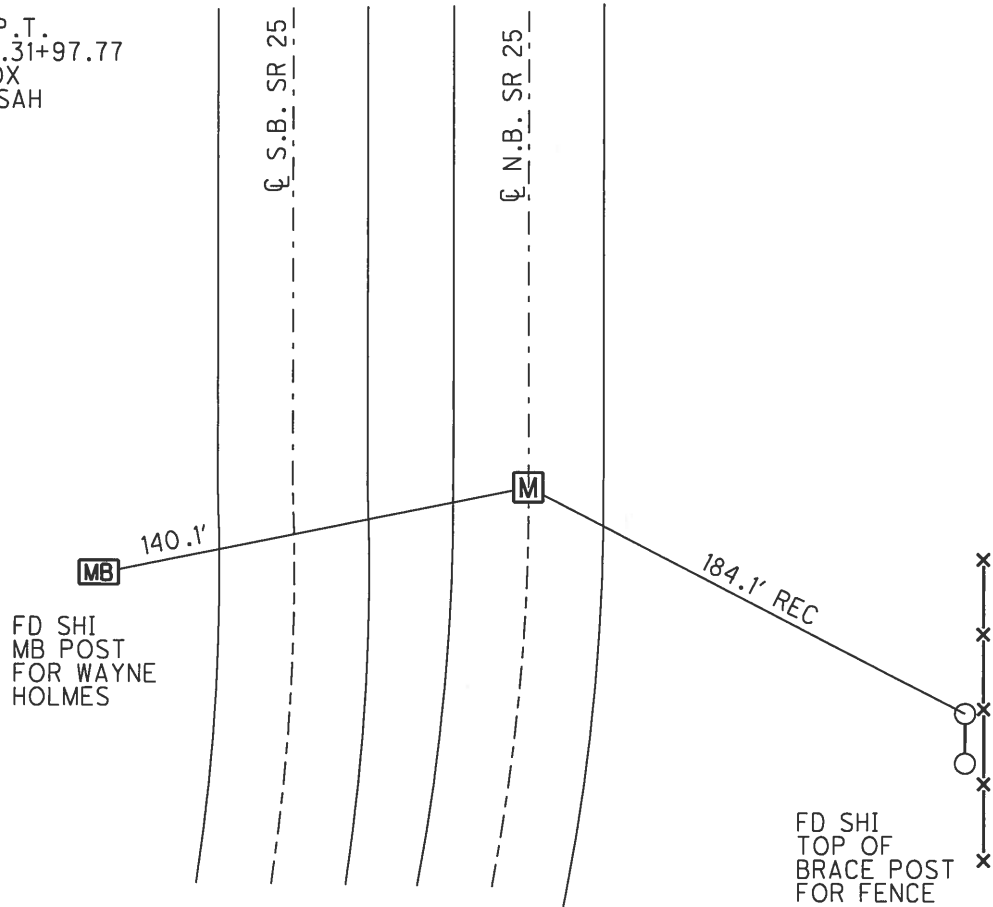

O.D.O.T. DISTRICT 2 SURVEY OFFICE

PERSONNEL _____

REFERENCE NO. _____

SHEET 3 OF 23

NOTES Huss

H.C. Roussos

R.C. VanDusen

DATE 4-12-01

WEATHER Pt Cldy-Windy

TEMP. 72°F

ROUTE SR-25

COUNTY Wood

TOWNSHIP Henry

SECTION 1

T 3 N R 10 E



TYPE MONUMENT Mon Box

~~ON SURFACE~~ ~~BELOW~~ Surface

~~LEFT - E PAV'T - RIGHT~~ E N.B. Pav

11.0, 11.7 TO Rt EDGE PAVEMENT

S.L.M. (A) 55+12.32 (B) 59+61.12

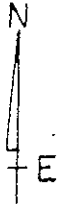
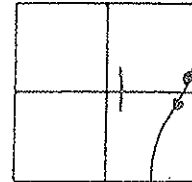


Record:

(A) Mon Box
Plan Sta - PC 27+57.77
SLM - 1.044

(B) Mon Box
Plan Sta - PT 31+97.77
SLM - 1.129 S.W.H.

Fd W/shi
E/S M.B. Post
for Wayne Homes

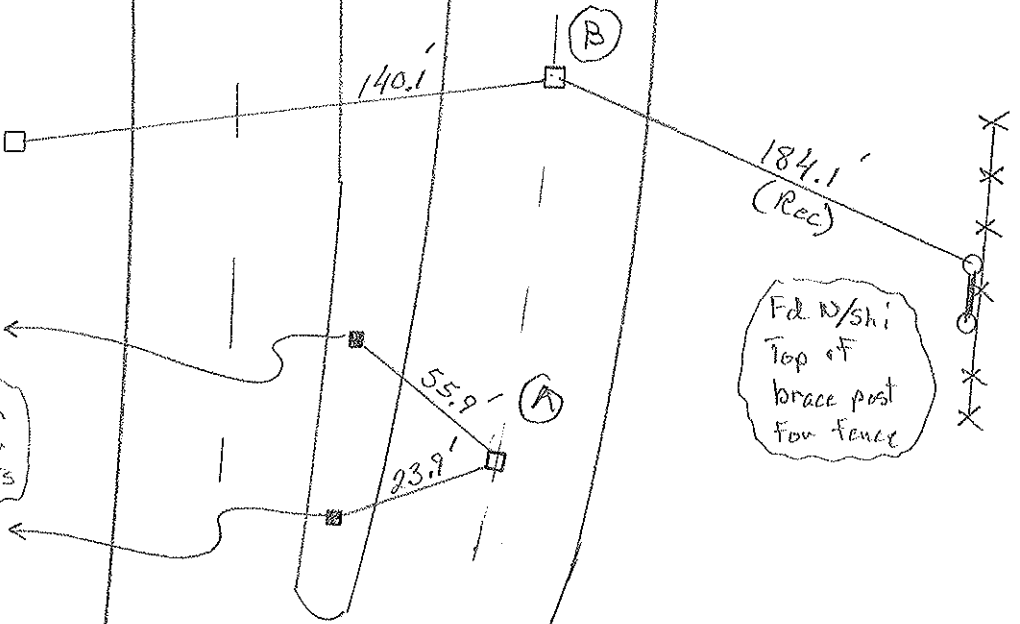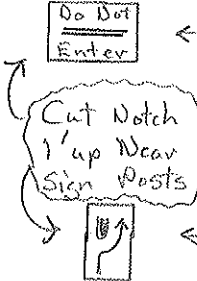

O.D.O.T. DISTRICT 2 SURVEY OFFICE

PERSONNEL _____

REFERENCE NO. _____

SHEET 3 OF 23

NOTES HOFFMAN

H.C. LOEHRKE

R.C. BARNHISEL

DATE 3-22-91

WEATHER cloudy

TEMP. 55°

ROUTE S.R. 25

COUNTY WOOD

TOWNSHIP HENRY

SECTION 1

T.3 N R.10 E

TYPE MONUMENT Mon. Box

ON SURFACE - BELOW yes

LEFT- & PAV'T. - RIGHT yes

11.07 TO RT. EDGE PAVEMENT

S.L.M. 55+12.32 59+61.12

(E) (F)

