

O.D.O.T. DISTRICT 2 SURVEY OFFICE (USE ONLY)

PERSONNEL _____ REFERENCE NO. 1 A SHEET 8 OF 36

NOTES HUSS DATE 4/12/01 ROUTE SR 25
 H.C. ROUSOS WEATHER CLOUDY/WINDY COUNTY WOOD
 R.C. VAN DUSEN TEMP. 72° TOWNSHIP LIBERTY
 SECTION 36

DWG BY MILLER PID NO PID T 4 N R 10 E

TYPE MONUMENT P.K.SHANK

ON SURFACE - ~~BELOW~~ ON


OFFSET \bar{C} PAVEMENT 3.2' LT : ~~RT~~

6.1' TO LT EDGE PAVEMENT


STATION: 81+57

HORZ.DATUM: NAD83(2011) GEOID: NAVD88 2012A

GRID: NORTHING: 580370.019 EASTING: 1652280.395

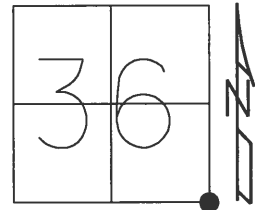

RECORD:
 \bar{C} R/W,
 36 SEC COR
 FD P.K./WASHER
 4/12/01, TMR
 SET PK/WASHER
 10-29-01, SAH
 FD HOLE
 REFA1
 5-30-18, JFO

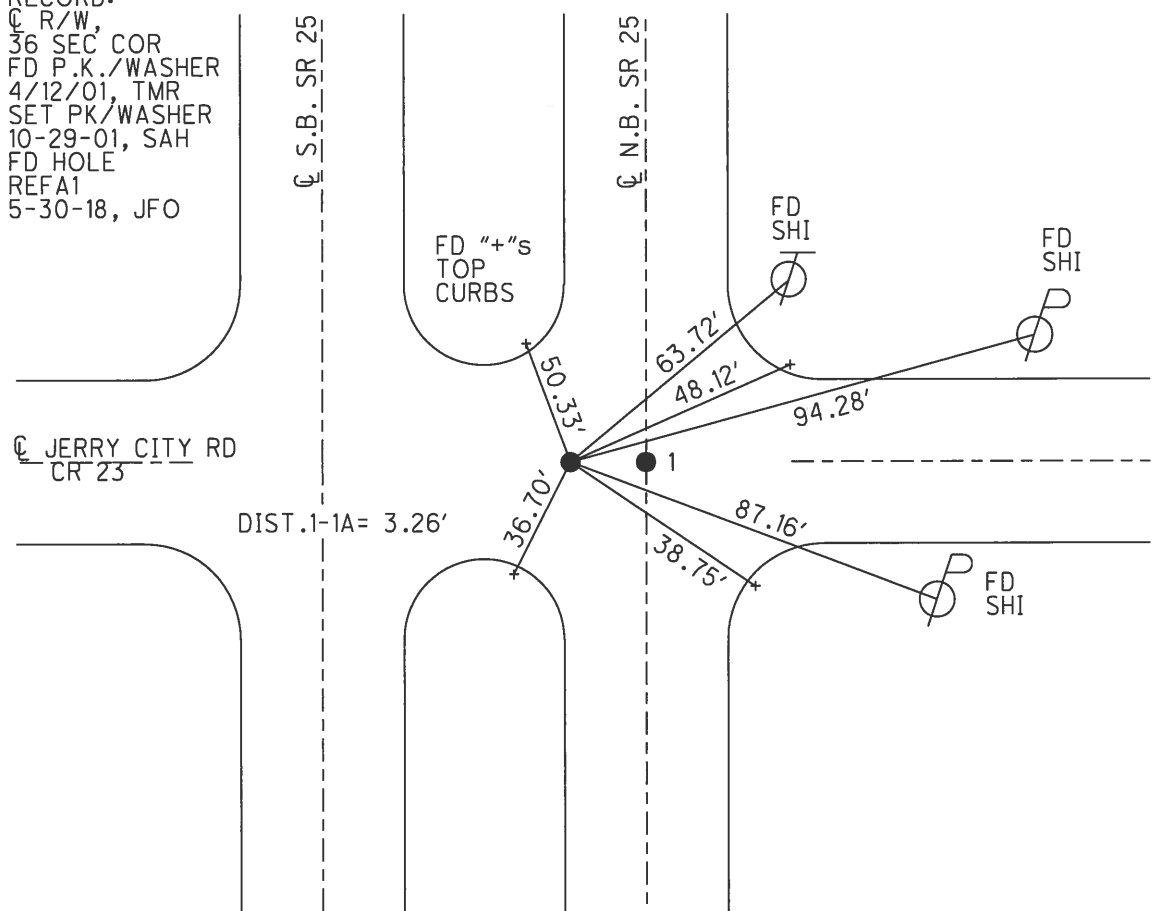

O.D.O.T. DISTRICT 2 SURVEY OFFICE

PERSONNEL

REFERENCE NO. 1

SHEET 4 OF 23

NOTES Huss

H.C. Rousos

R.C. VanDusen

DATE 4-12-01

WEATHER Pt Cldy - Windy

TEMP. +72°F

ROUTE SR-25

COUNTY Wood

TOWNSHIP Liberty

SECTION 36

T 4 N R 10 E



TYPE MONUMENT Ⓐ PK/W Ⓑ PK/W

ON SURFACE - ~~BELOW~~ Surf

LEFT - E PAVT. - RIGHT Ⓐ 3.2' Lt g B E Paut.

Ⓐ 6.1' TO Lt. EDGE PAVEMENT

S.L.M. Ⓐ 81+57 Ⓑ 81+57

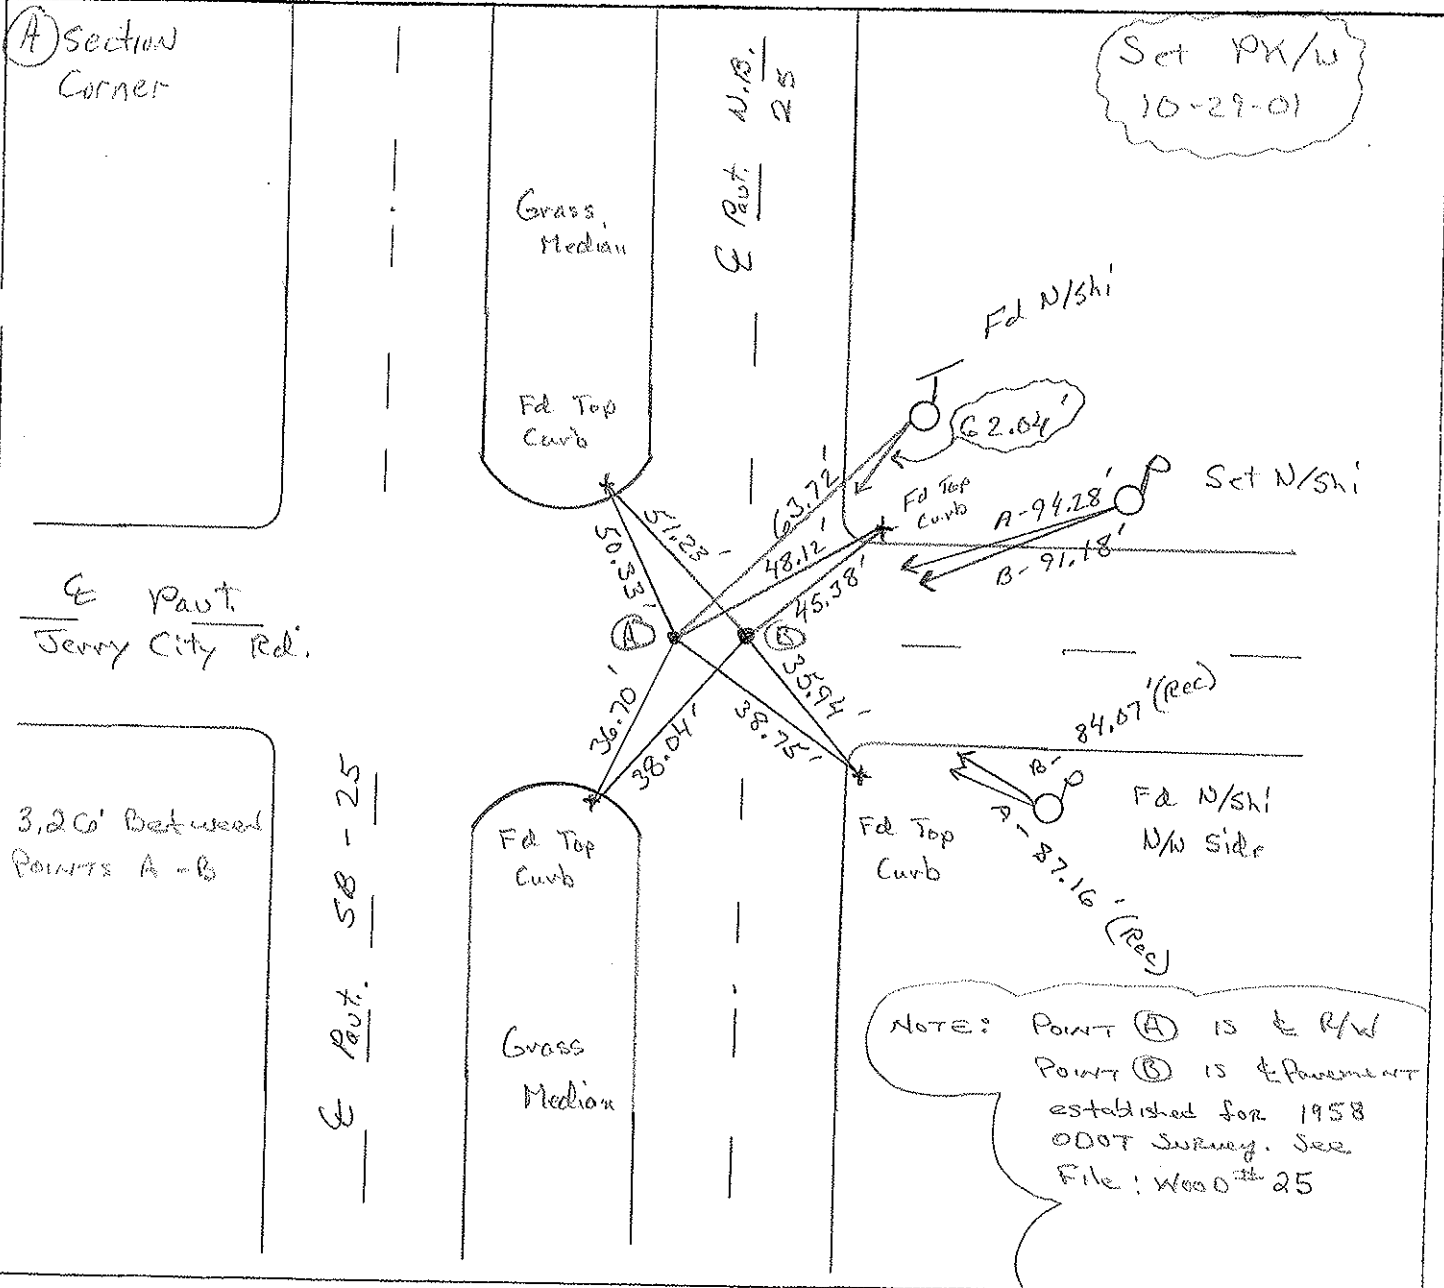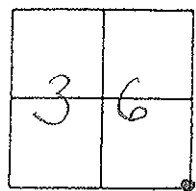

O.D.O.T. DISTRICT 2 SURVEY OFFICE

PERSONNEL

REFERENCE NO. 1

SHEET 4 OF 23

NOTES Huss

H.C. Rousos

R.C. Van Dusen

DATE 4-12-01

WEATHER Pt Cloudy Windy

TEMP. +72°F

ROUTE SR-25

COUNTY Wood

TOWNSHIP Liberty

SECTION 36

T 4 N R 10 E



TYPE MONUMENT (A) PK/W (B) PK/W

ON SURFACE - ~~BELOW~~ Surf

LEFT - ℄ PAV'T. - RIGHT (A) 3.2' Lt g B ℄ Pavt.

(A) 6.1' TO Lt. EDGE PAVEMENT

S.L.M. (A) 81+57 (B) 81+57

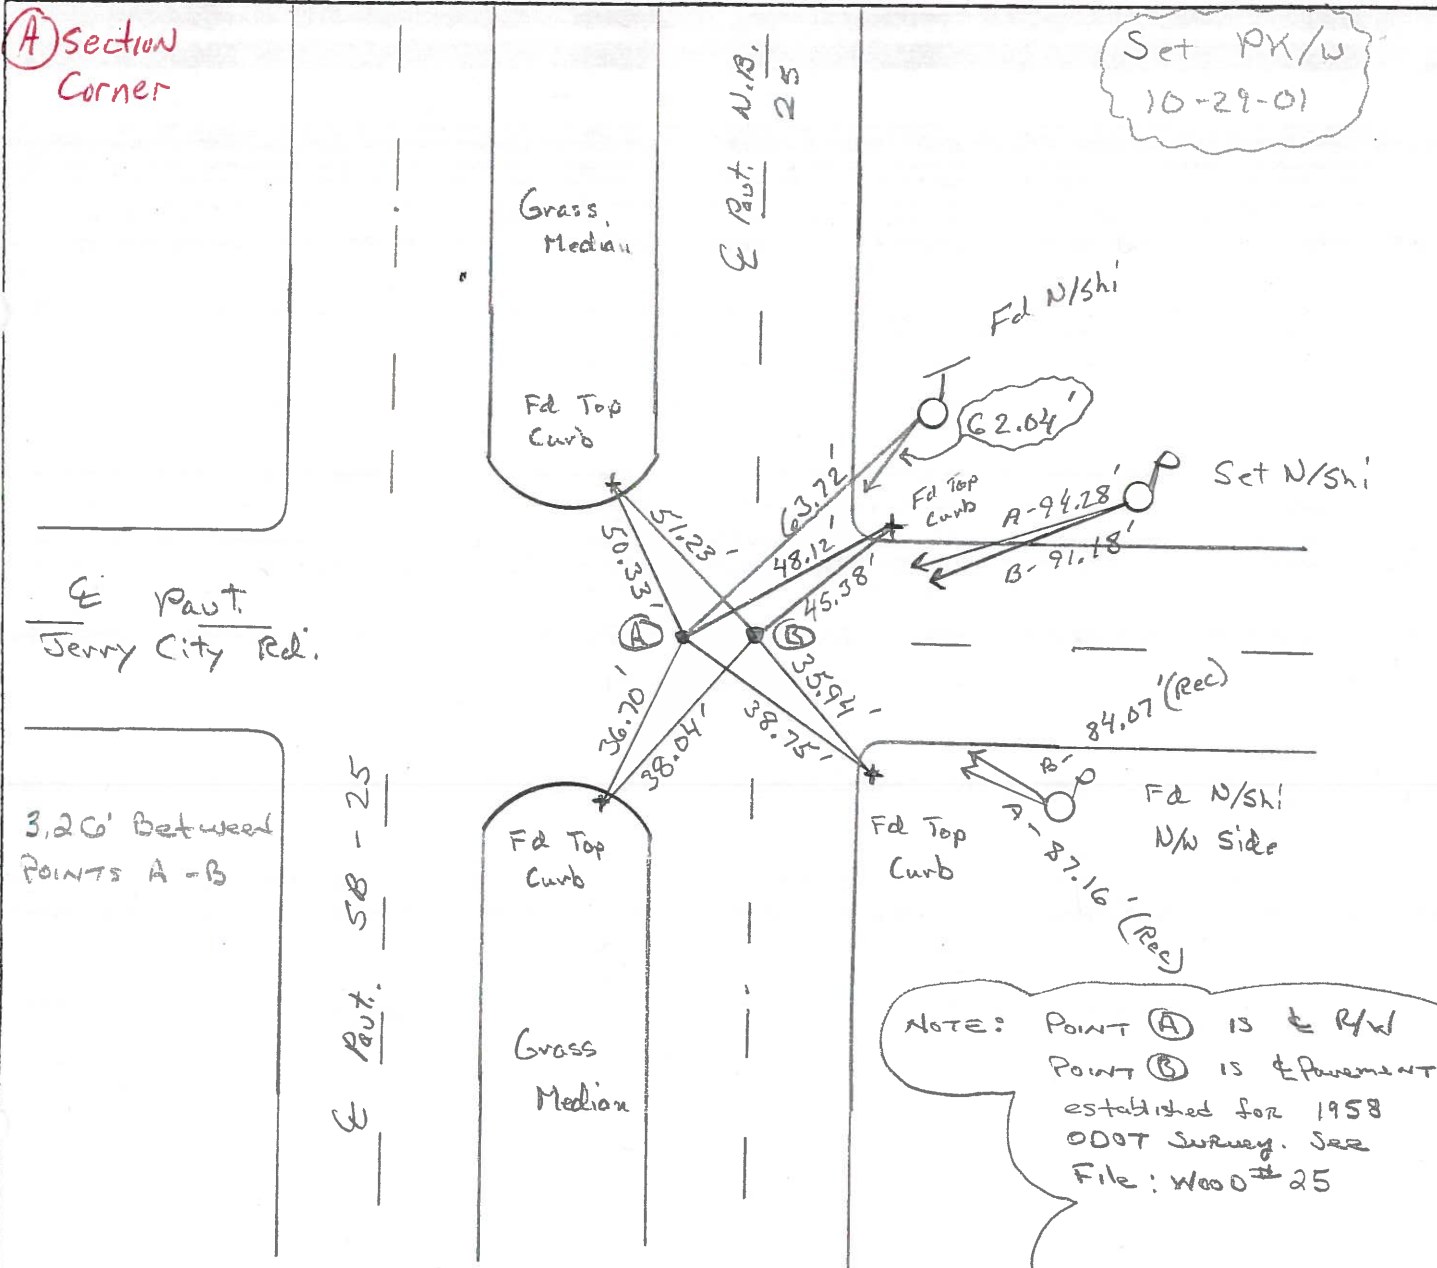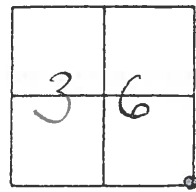

O.D.O.T. DISTRICT 2 SURVEY OFFICE

PERSONNEL

REFERENCE NO. 1

SHEET 4 OF 23

NOTES HOFFMAN

H.C. LOHRKE

R.C. BARNHISEL

DATE 3-22-91

WEATHER CLOUDY

TEMP. 55°

ROUTE SR 25


COUNTY WOOD

TOWNSHIP LIBERTY

SECTION 36

T 4 N R 10 E

TYPE MONUMENT P.K./WASHER ^(A) IN P.K. ^(B)
 ON SURFACE - BELOW yes ^{2' down}
 LEFT - CL PAV'T. - RIGHT 3.2' LT ^{NBL} IN NBL
 TO LT EDGE PAVEMENT
 S.L.M. 91+57

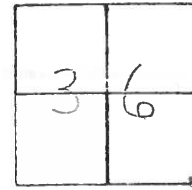

3.26 between points

Set P.K.'s & Washers
 5-31-91
 MB

E PAVT S.B.L.

SR 25

NOTE: RECORD SHOWS POINT "B" TO BE FD. ON E OF N.B.L. THE ORIGINAL IS UNKNOWN

E PAVT LERRY CITY RD.

CUT "+"

Set shi
SW/S



Fd "+"

Fd shi
NW/S

SR 25

E PAVT N.B.L.

87.13

84.07

County Wood S.R.-U.S. 25

Date 6-9-81 8-25-81

Township LIBERTY


Weather Clear

Section 36

Temp. +75°

T4N, R10E

Personnel HOFFMAN

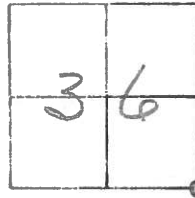

1


Householder
Loehrke

Pt. "A" Fd. BRASS MON @ Surface
3.2' W. of E PAUT

PROJECT STA ± 81+96

Pt. "B" Fd. P.K. @ Surface
ON E PAUT

3.24' Btw. Pts "A" & "B"

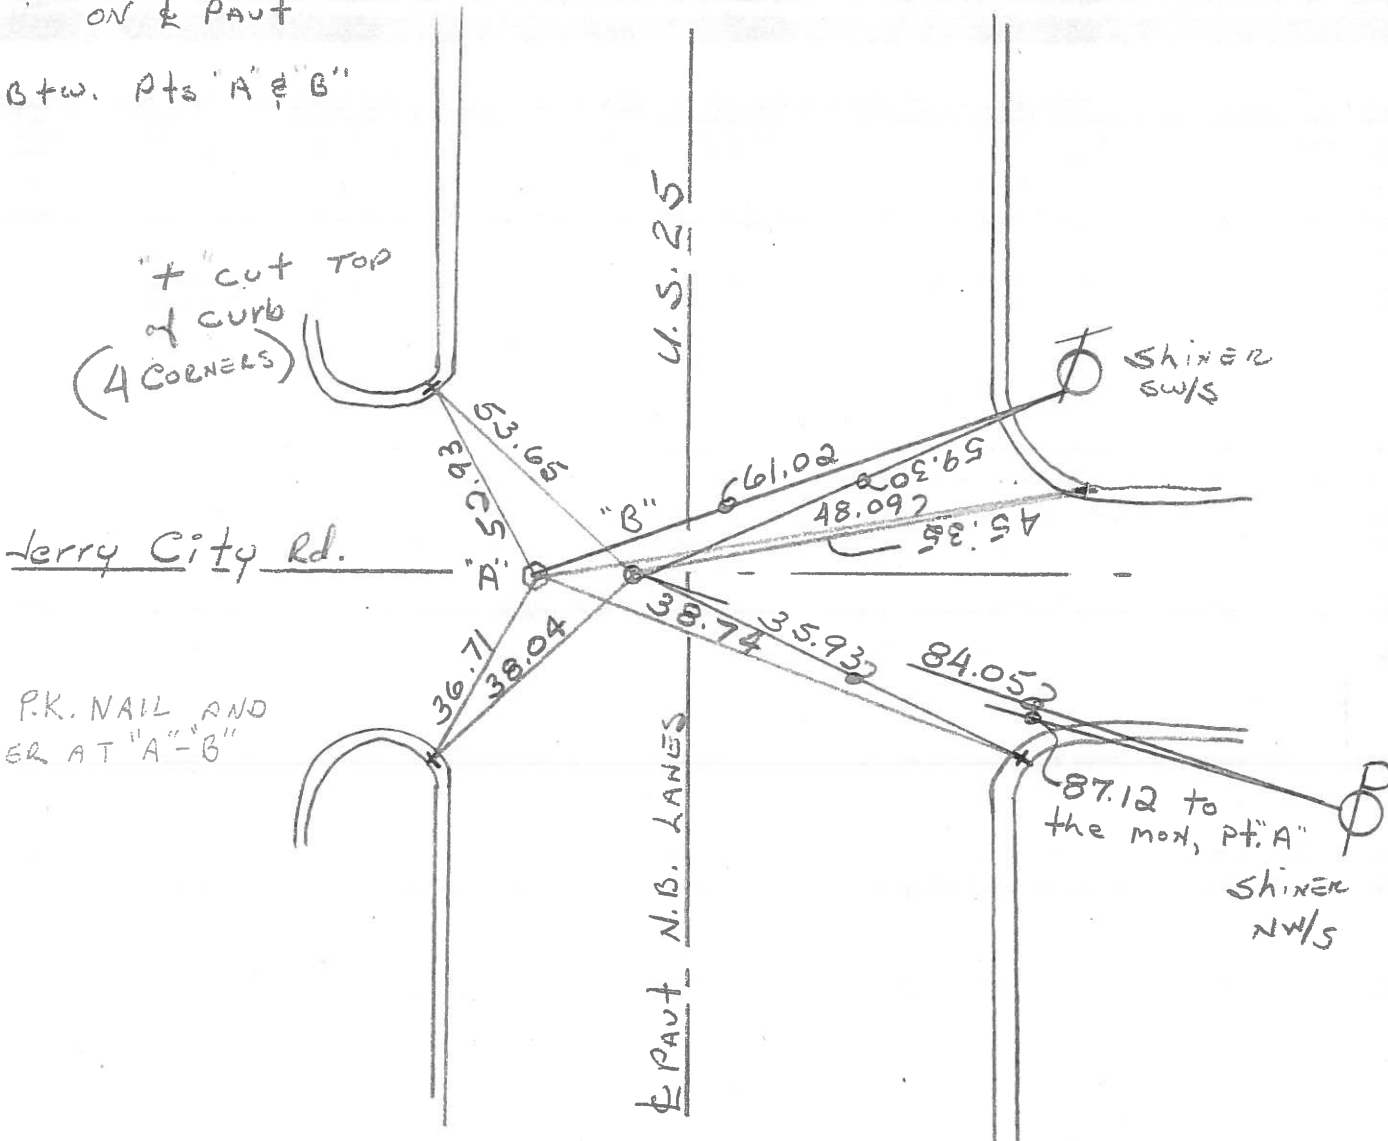

+ "cut TOP
of CURB
(4 CORNERS)

SHINER
SW/S

Jerry City Rd.

U.S. 25

E PAUT N.B. LANES

87.12 to
the mon, Pt. "A"

SHINER
NW/S

SET P.K. NAIL AND
WASHER AT "A"-"B"

O.D.O.T. DISTRICT 2 SURVEY OFFICE

SHEET OF

County WOOD ^{U.S.} ~~S.R.~~ 25

Date 7-2-71

Township LIBERTY-HENRY

Weather CLEAR

Section 36

Temp. 72°


T4N, R10E

Personnel BURNSIDE

SMITH

BOWERS

HOLCOMBE

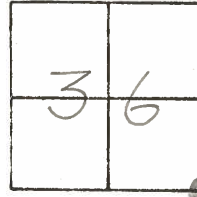

#1

X

