


O.D.O.T. DISTRICT 2 SURVEY OFFICE (USE ONLY)


PERSONNEL _____ REFERENCE NO. 2 SHEET 9 OF 36
 NOTES HUSS DATE 4/12/01 ROUTE SR 25
 H.C. ROUSOS WEATHER CLOUDY/WINDY COUNTY WOOD
 R.C. VAN DUSEN TEMP. 72° TOWNSHIP LIBERTY
 SECTION 36
 DWG BY MILLER PID NO PID T 4 N R 10 E

TYPE MONUMENT P.K./WASHER
 ON SURFACE - ~~BELOW~~ ON
 OFFSET \odot PAVEMENT 19.0' LT : ~~RT~~
 8.6' LT TO LT EDGE PAVEMENT
 STATION: 107+91

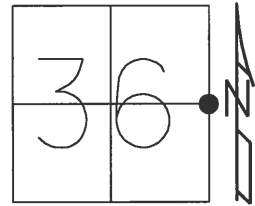

HORZ. DATUM: NAD83(2011) GEOID: NAVD88 2012A
 GRID: NORTHING: 583004.222 EASTING: 1652316.793

RECORD:
 FD P.K./WASHER
 4/12/01, TMR
 SET P.K./WASHER
 10-29-01, SAH
 FD P.K./WASHER
 REF2
 5-30-18, JFO
 10-1-18, JFO

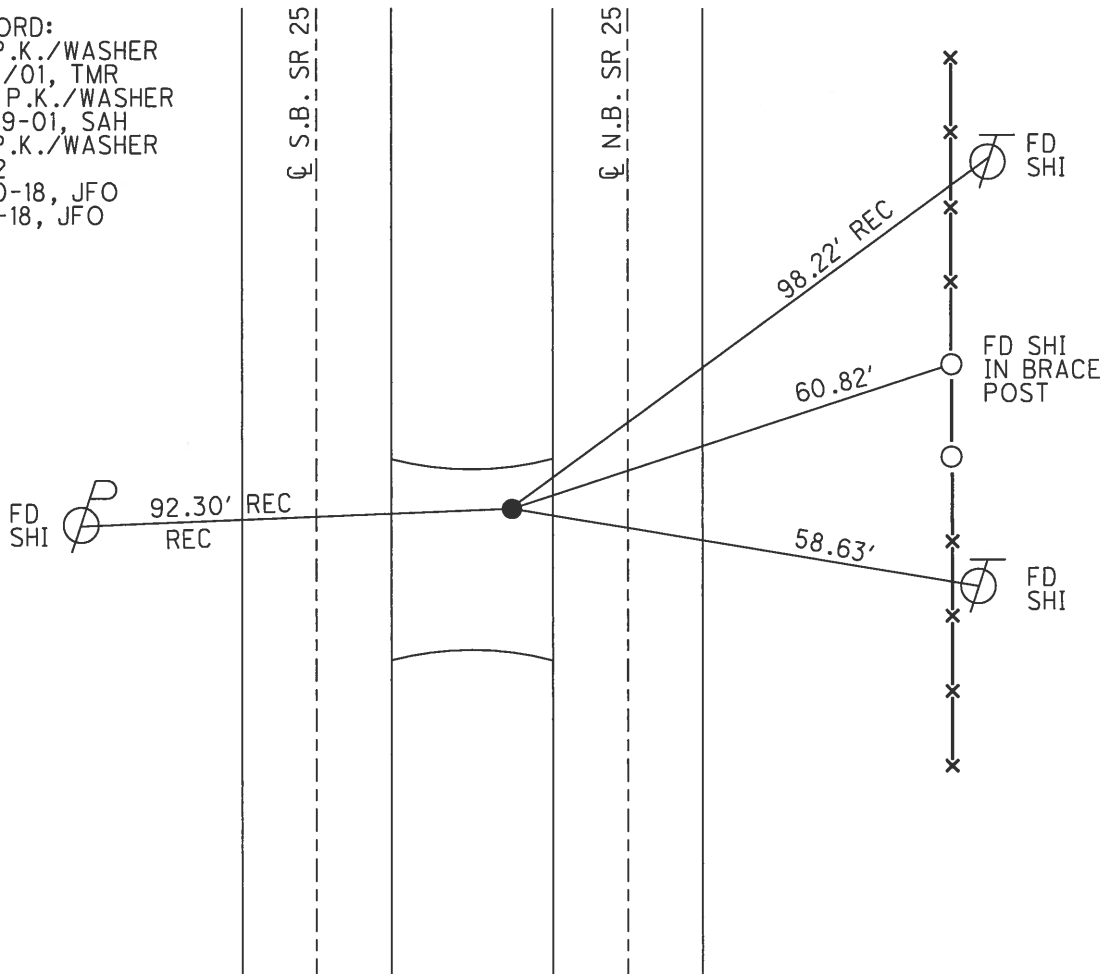

O.D.O.T. DISTRICT 2 SURVEY OFFICE

PERSONNEL _____

REFERENCE NO. 2

SHEET 5 OF 03

NOTES Huss

H.C. Roussos

R.C. VanDusen

DATE 4-12-01

WEATHER Pt Cldy Windy

TEMP. 72°F

ROUTE SR-25

COUNTY Wood

TOWNSHIP Liberty

SECTION 36

T 4 N R 10 E



TYPE MONUMENT PK/w

~~ON SURFACE~~ BELOW Surface

LEFT - & PAV T - RIGHT 19.0' Lt of N.S.L.

7.8' Lt. TO Lt. EDGE PAVEMENT N.B. Lane

S.L.M. 107+91

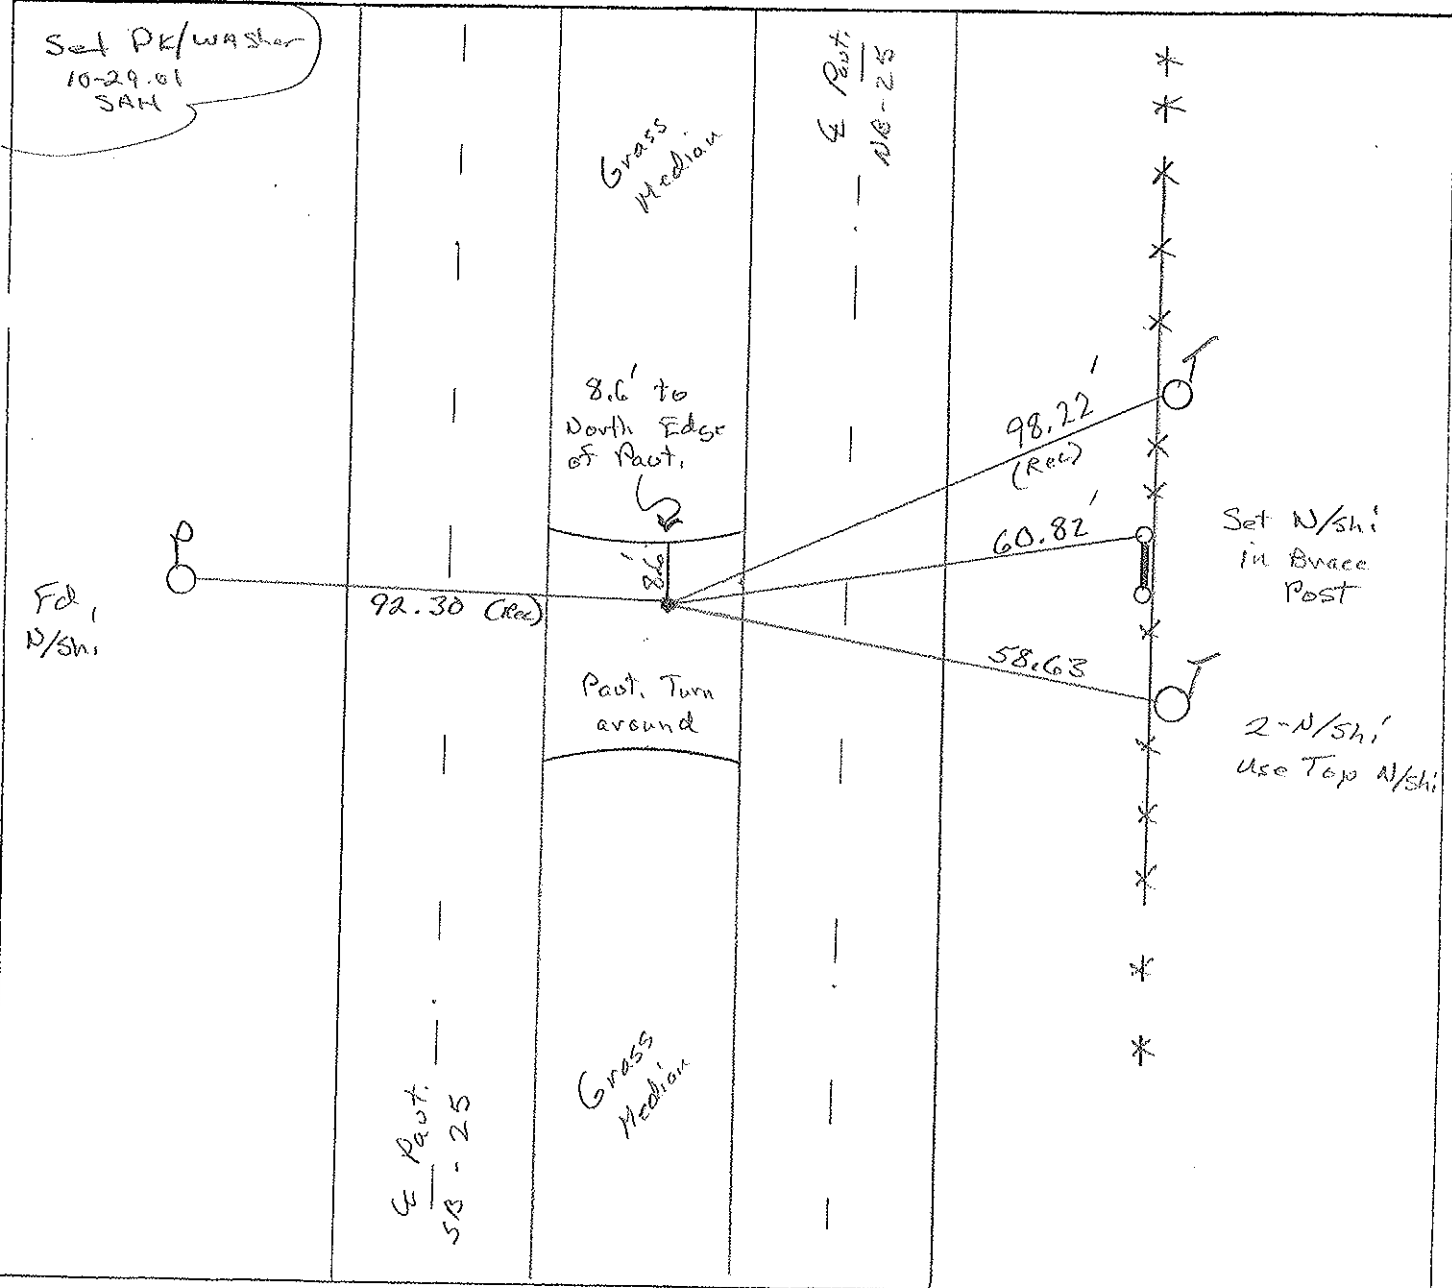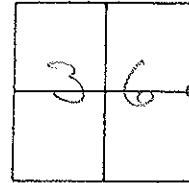

O.D.O.T. DISTRICT 2 SURVEY OFFICE

PERSONNEL

REFERENCE NO. 2

SHEET 5 OF 23

NOTES HOFFMAN

H.C. LOSHRKE

R.C. BARANISEL

DATE 3-22-91

WEATHER CLOUDY

TEMP. 55°

ROUTE SR 25

COUNTY WOOD

TOWNSHIP LIBERTY

SECTION 36

T4 N R 10 E


TYPE MONUMENT P.K. / WASHER

ON SURFACE - BELOW YES


LEFT - & PAV'T. - RIGHT 19.0' NBL

7.8 TO LT. EDGE PAVEMENT NBL

S.L.M. 107+91

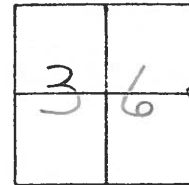

Set P.K. & Washer
5-31-91
MB

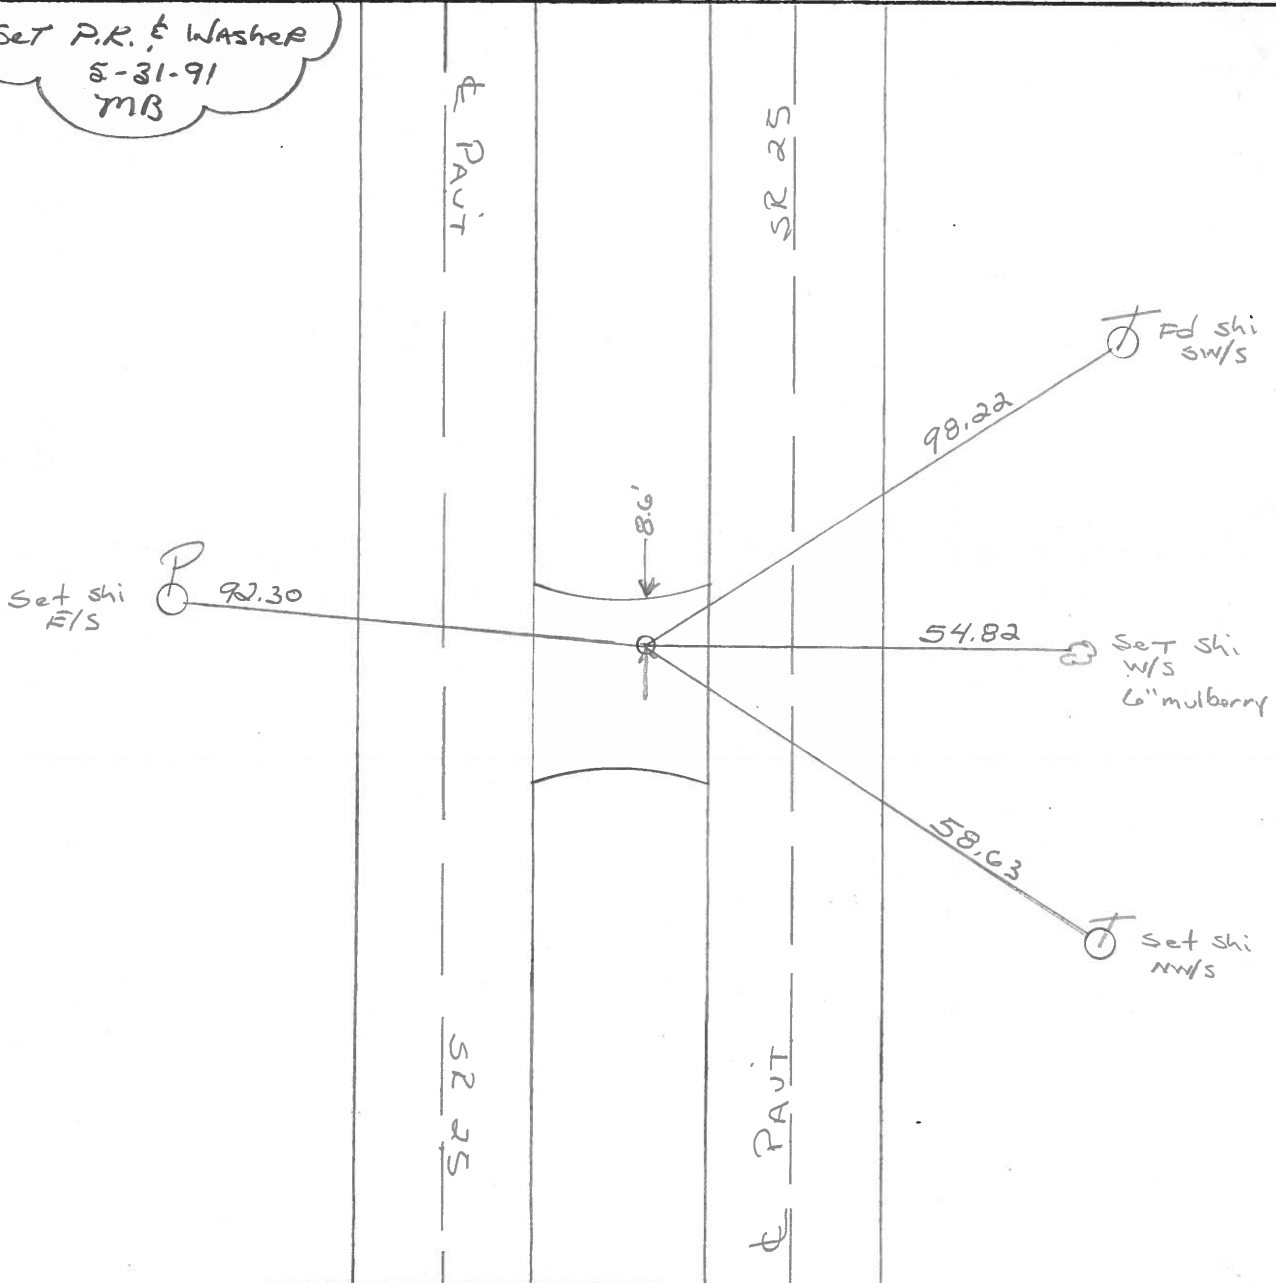

County Wood S.R. - U.S. 25

Date 6-9-81 8-25-81

Township LIBERTY

Weather Cloudy

Section 36

Temp. + 75°


T4N, R10E

Personnel Hoffman

Loehrke

Householder


2

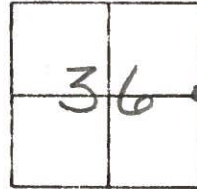

Fd. "+" IN CONC. MEDIAN CROSS OVER - Project STA. ± 108 + 33

7' w. of w. Edge PAVT, N.B. LANES

19.1' w. of c. of PAVT, N.B. LANES

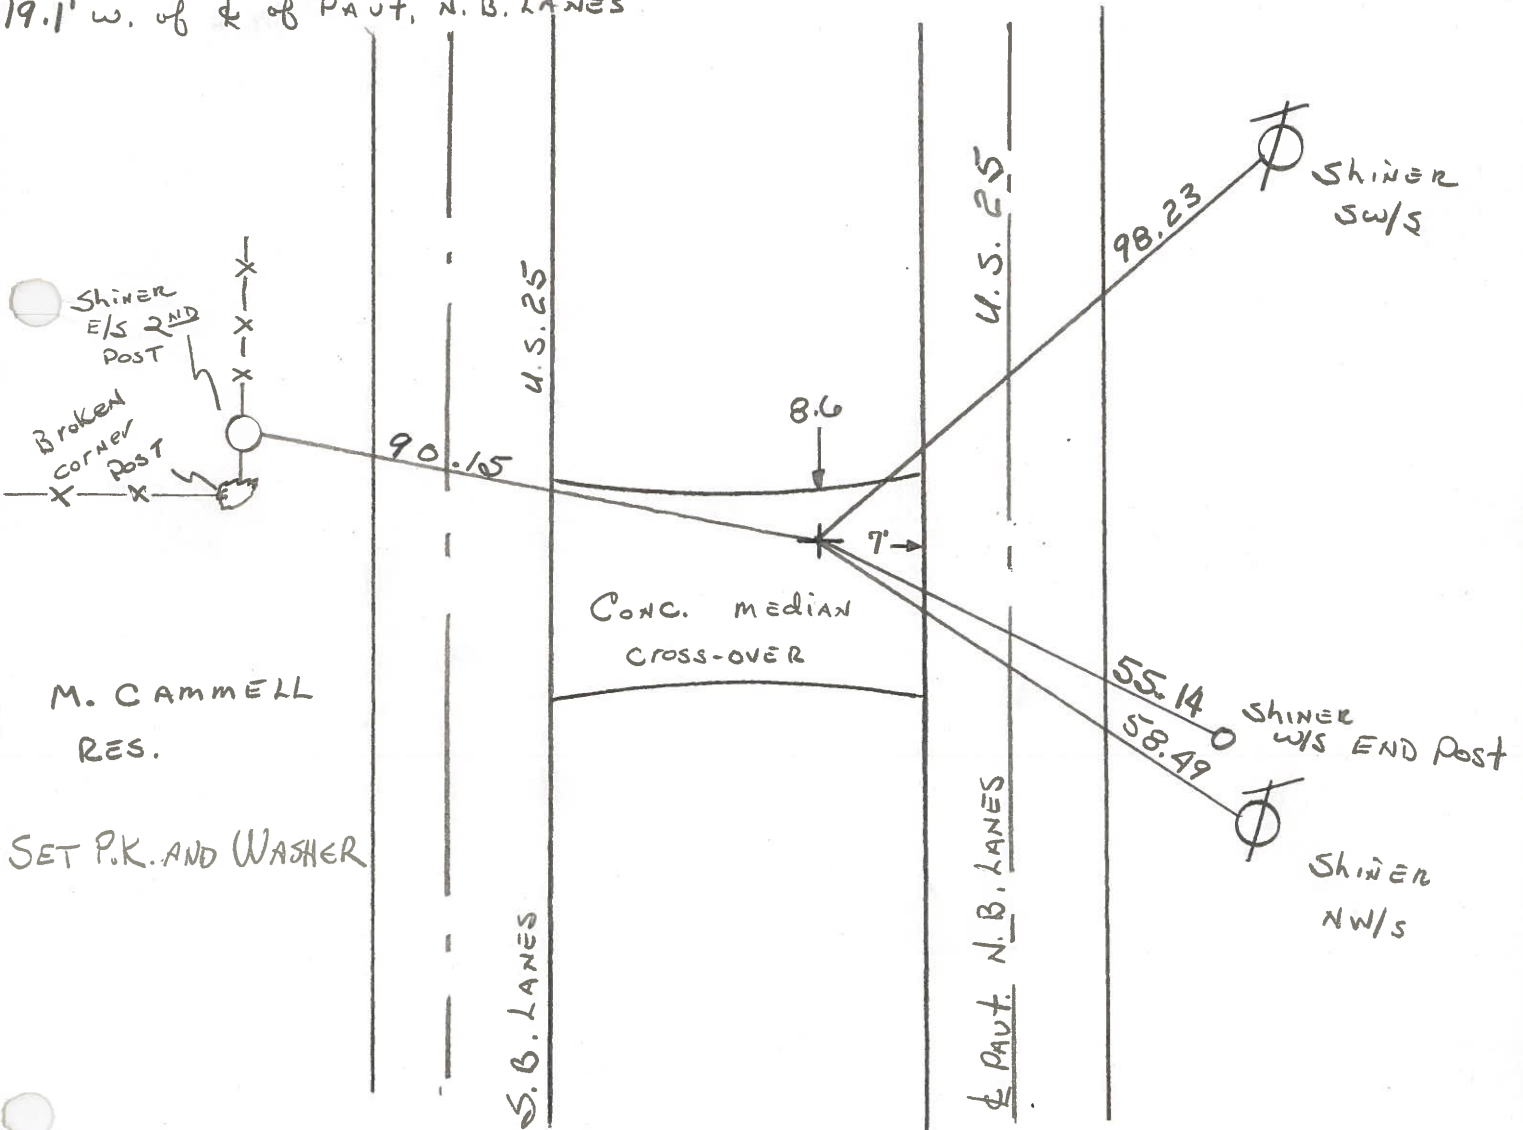

ODOT. DISTRICT 2 SURVEY OFFICE

SHEET _____ OF _____

County WOOD S.R.

Township LIBERTY

Section 36

T4N, R10E

Personnel MORRISON

HOLCOMBE

BOWERS


SMITH

HUFFMAN

Date AUG 18 - 70

Weather CLEAR

Temp. 92°

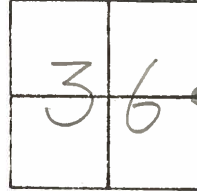

#2

