



O.D.O.T. DISTRICT 2 SURVEY OFFICE (USE ONLY)

PERSONNEL	REFERENCE NO. <u>4</u>	SHEET <u>12</u> OF <u>36</u>
NOTES <u>RHOADES</u>	DATE <u>5/30/18</u>	ROUTE <u>SR 25</u>
H.C. <u>O'DONNELL</u>	WEATHER <u>CLOUDY</u>	COUNTY <u>WOOD</u>
R.C. <u>TRENKA</u>	TEMP. <u>77°</u>	TOWNSHIP <u>LIBERTY</u>
		SECTION <u>25</u>
DWG BY <u>MILLER</u>	PID <u>NO PID</u>	T <u>4</u> N R <u>10</u> E
TYPE MONUMENT <u>P.K.SHANK</u>		
ON SURFACE - BELOW <u>ON</u>		
OFFSET <u>Q</u> PAVEMENT <u>10.3'</u> LT : RT		
<u>1' LT TO LT</u> EDGE PAVEMENT		
STATION: <u>156+10</u>		
HORZ.DATUM: <u>NAD83(2011)</u>	GEOID: <u>NAVD88 2012A</u>	
GRID: NORTHING: <u>587824.888</u>	EASTING: <u>1652367.858</u>	

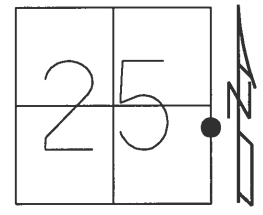

RECORD:
 FD P.K./WASHER
 4/12/01, TMR
 SET P.K./WASHER
 10-31-01, SAH
 FD P.K./SHANK
 REF4
 5-30-18, JFO
 SET MAG/WASHER
 10-1-18, JFO

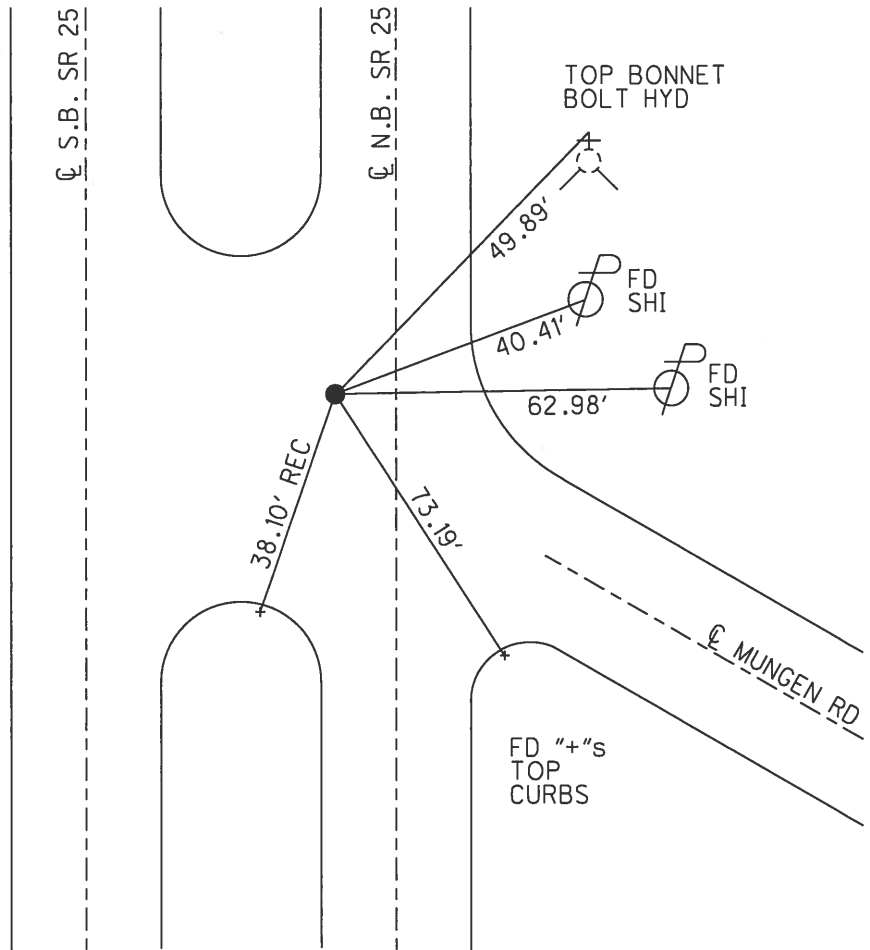

O.D.O.T. DISTRICT 2 SURVEY OFFICE

PERSONNEL _____

REFERENCE NO. 4

SHEET 7 OF 23

NOTES Huss

H.C. Rousos

R.C. Van Duern

DATE 4-12-01

WEATHER Pt Cldy-Windy

TEMP. 72°F

ROUTE SR-25

COUNTY Wood

TOWNSHIP Liberty

SECTION 25

T 4 N R 10 E



TYPE MONUMENT PK/W

ON SURFACE - ~~BELOW~~ Surface

LEFT - & PAV'T - ~~RIGHT~~ 10.3'

1' Lt. TO Lt. EDGE PAVEMENT

S.L.M. 156+10

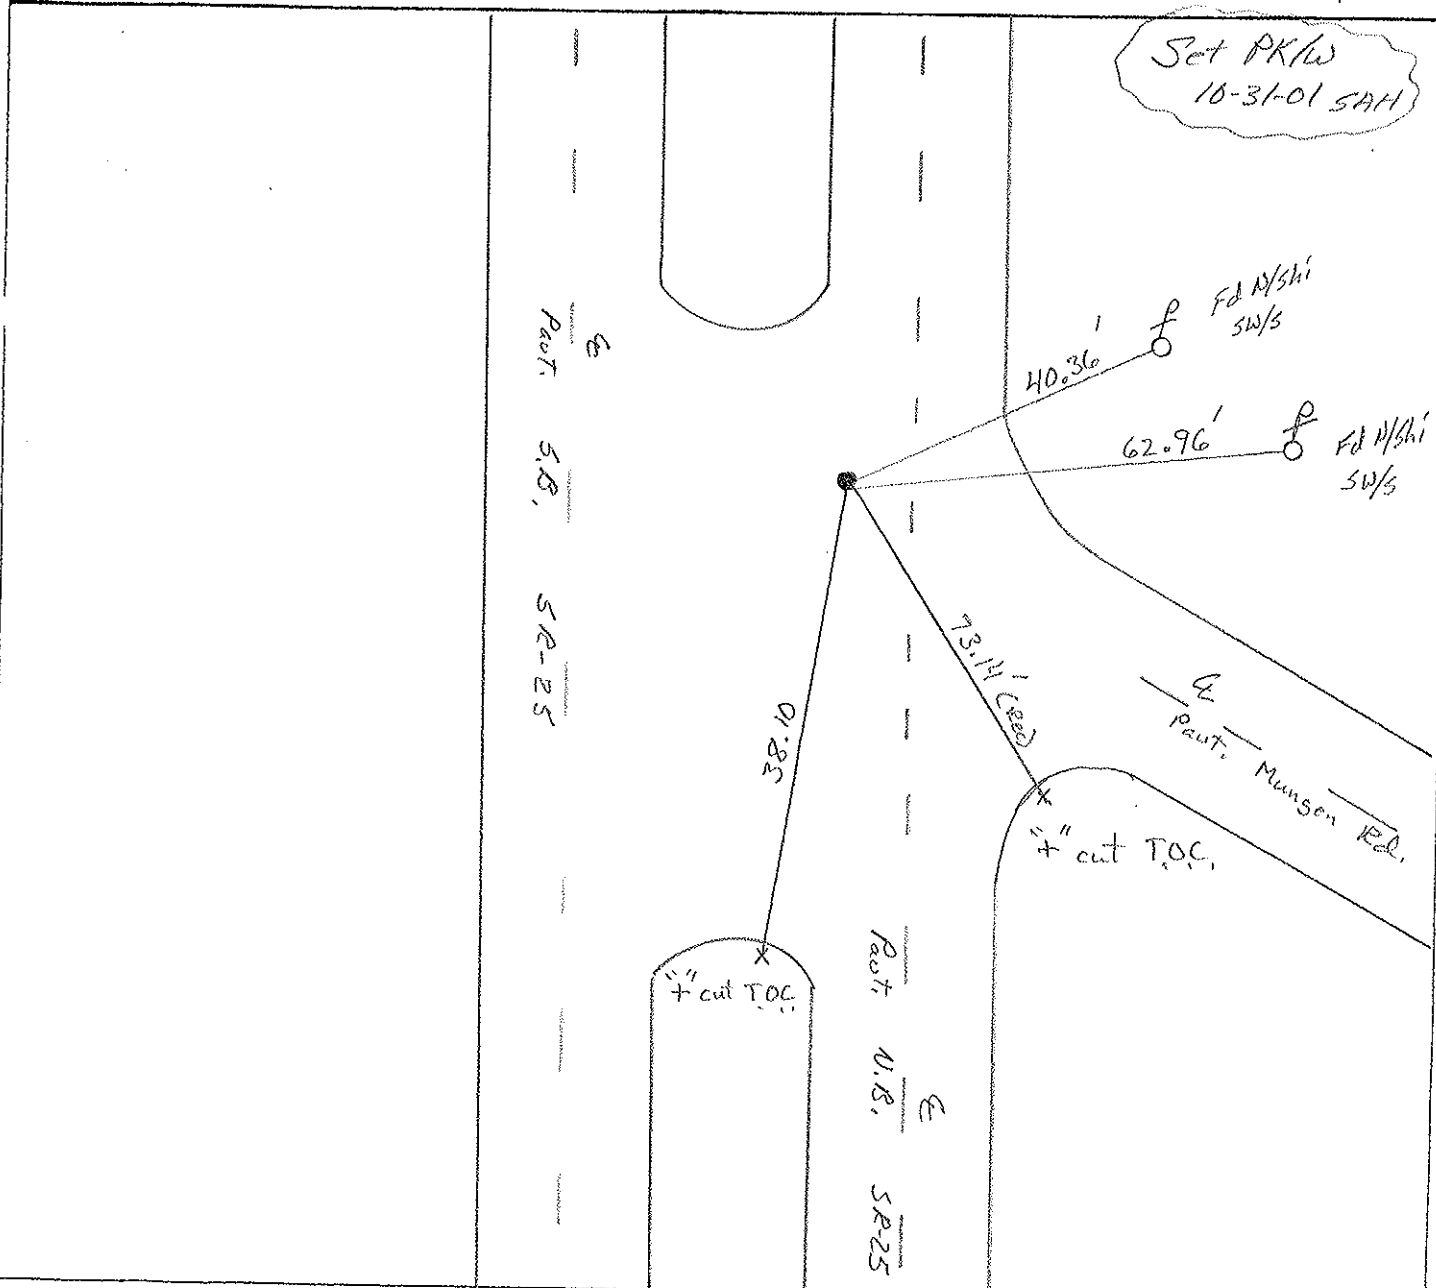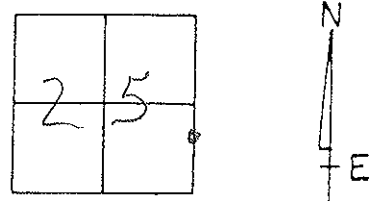

O.D.O.T. DISTRICT 2 SURVEY OFFICE

PERSONNEL

REFERENCE NO. 4

SHEET 7 OF 23

NOTES HOFFMAN

H.C. LOENRKE

R.C. BARNISSEL

DATE 3-22-91

WEATHER CLOUDY

TEMP. 55°

ROUTE SR 25

COUNTY WOOD

TOWNSHIP LIBERTY

SECTION 25

T4 N R 10 E


TYPE MONUMENT P.K./WASHER

ON SURFACE - BELOW YES


LEFT - & PAV'T. - RIGHT 10.9

0.0 TO LT EDGE PAVEMENT

S.L.M. 156 +10

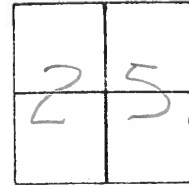

Set P.K. & Washer
6-5-91
mB

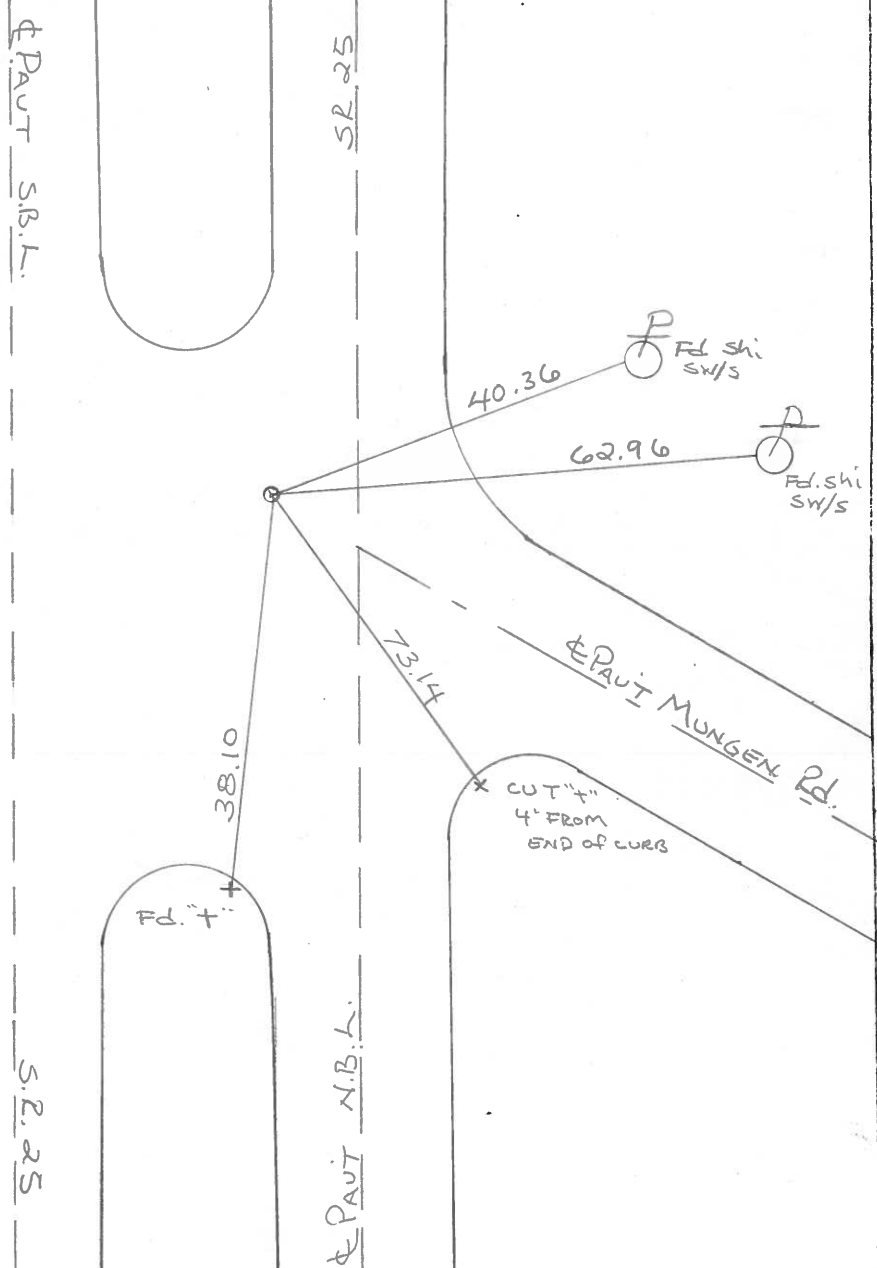

County WOOD S.R.-U.S.25

Date 6-9-81 8-25-81

Township LIBERTY

Weather Cloudy

Section 25

Temp. +75°


T4N, R10E

Personnel Hoffman

Loehrke


Householder

4

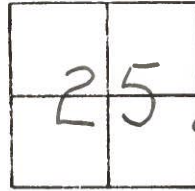

Fd. P.K. @ SURFACE
11.0' W. of & PAVT, N.B. LANES

PROJECT STA. ± 156 + 62

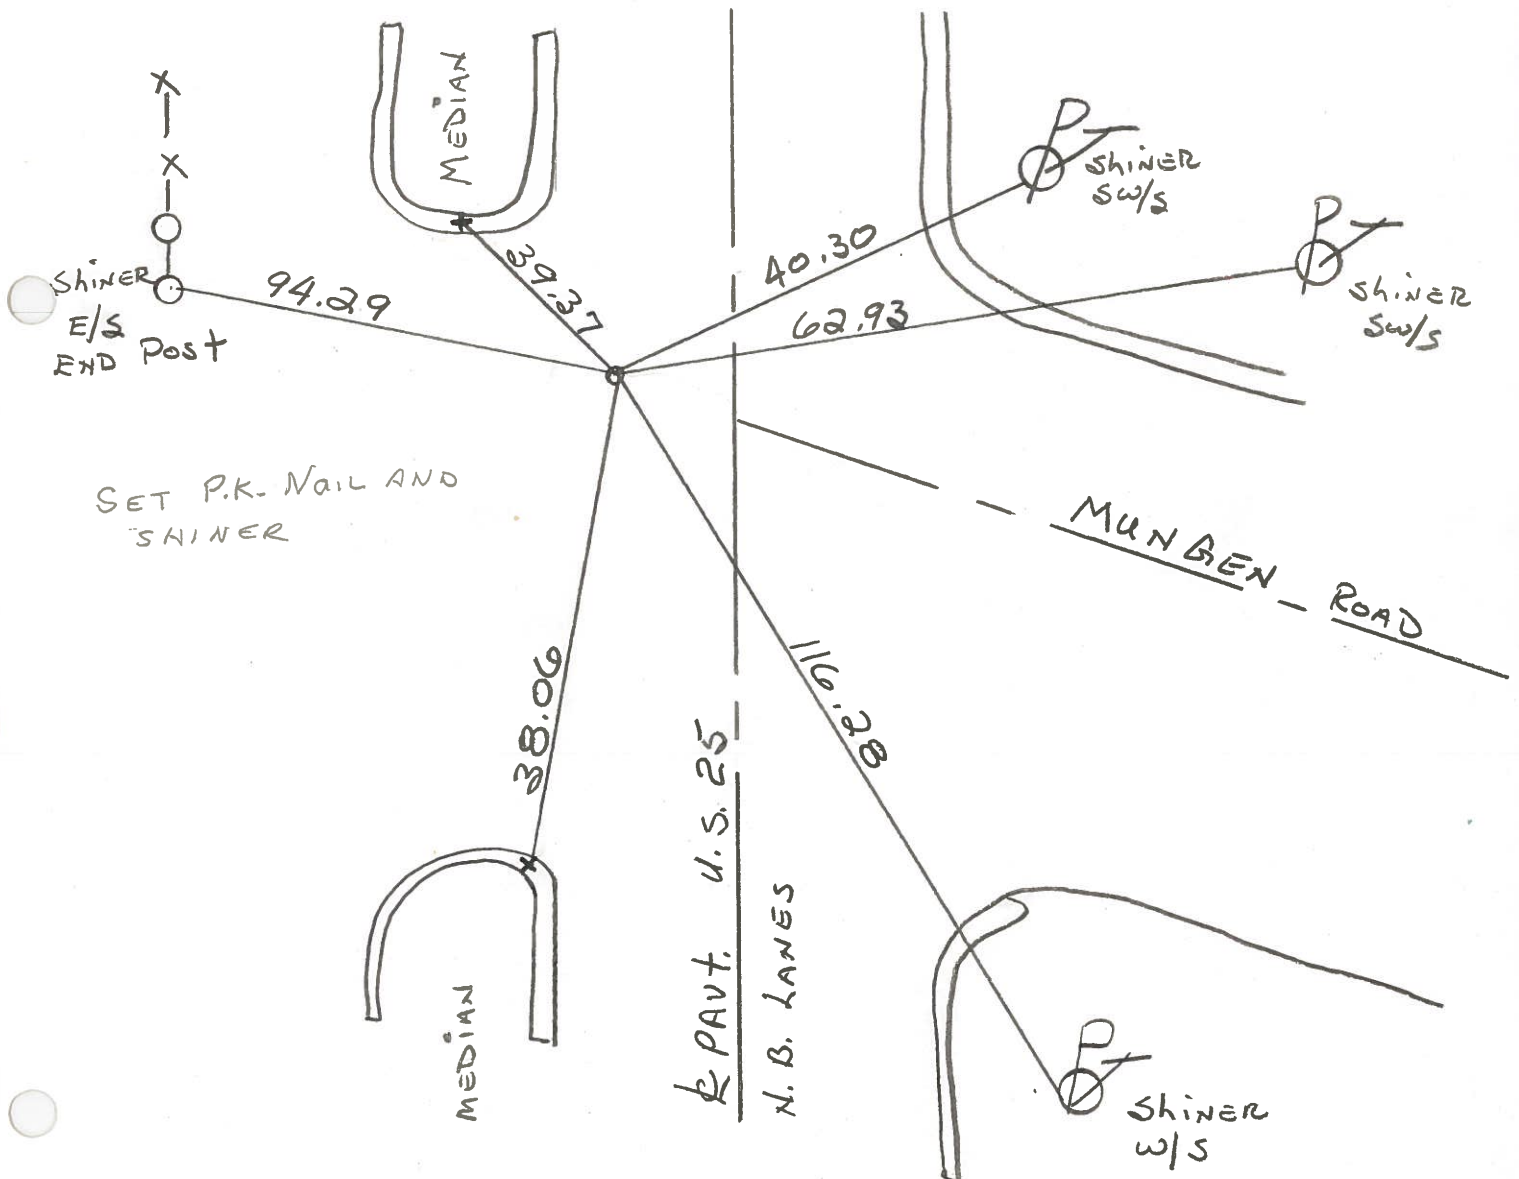

O.D.O.T. DISTRICT 2 SURVEY OFFICE

SHEET _____ OF _____

County WOOD U.S. S.R. 25

Date 7-6-71

Township LIBERTY


Weather CLEAR

Section 25

Temp. 80°

T4N, R10E

Personnel BURNSIDE

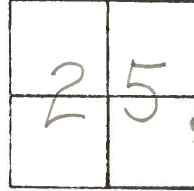

④

SMITH
BOWERS


#4



25



94.33'

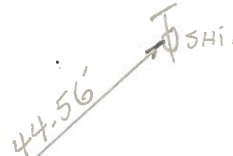

62.88'



114.17'

MUNGEN RD.



FD. P.K. NAIL
1' ± E. OF W. EDGE
PAVT. N.B.L.

U.S.