

O.D.O.T. DISTRICT 2 SURVEY OFFICE (USE ONLY)

PERSONNEL \_\_\_\_\_ REFERENCE NO. 5 SHEET 13 OF 36

NOTES HUSS DATE 4/12/01 ROUTE SR 25  
 H.C. ROUSOS WEATHER CLOUDY/WINDY COUNTY WOOD  
 R.C. VAN DUSEN TEMP. 72° TOWNSHIP LIBERTY

DWG BY MILLER PID NO PID SECTION 25  
 T 4 N R 10 E

TYPE MONUMENT \_\_\_\_\_ CNPT \_\_\_\_\_

ON SURFACE - ~~BELOW~~ ON \_\_\_\_\_


OFFSET ☉ PAVEMENT \_\_\_\_\_ LT : ~~RT~~

ON LT TO LT EDGE PAVEMENT

STATION: 160+75

HORIZ. DATUM: NAD83(2011) GEOID: NAVD88 2012A


GRID: NORTHING: 588289.174 EASTING: 1652370.837

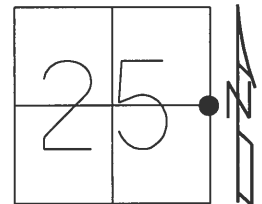

RECORD:  
 STA. 403+07.8  
 FD BRASS MON  
 FD P.K./WASHER  
 4/12/01, TMR  
 SET P.K./WASHER  
 10-31-01, SAH  
 D.N.F POINT  
 FD HOLE  
 REF5  
 5-30-18  
 10-1-18, JFO

☉ N.B. SR 25

☉ N.B. SR 25

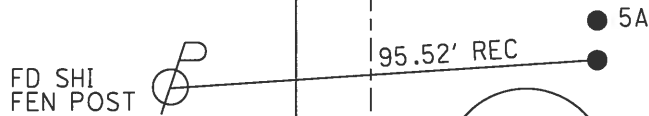

DIST. 5-5A = 5.29' REC

# O.D.O.T. DISTRICT 2 SURVEY OFFICE

PERSONNEL \_\_\_\_\_

REFERENCE NO. 5

SHEET 8 OF 23

NOTES Huss

H.C. Rousos

R.C. VanDusen

DATE 4-12-01

WEATHER Pt Cldy. Windy

TEMP. +72°F

ROUTE SR-25

COUNTY Wood

TOWNSHIP Liberty

SECTION 25

T 4 N R 10 E


TYPE MONUMENT (A) PK/W (B) PK

ON SURFACE - ~~BELOW~~ Surface

LEFT - & PAV'T - ~~RIGHT~~ On Lt. EOP


TO Lt. EDGE PAVEMENT

S.L.M. (A) 160+75 (B) 160+25

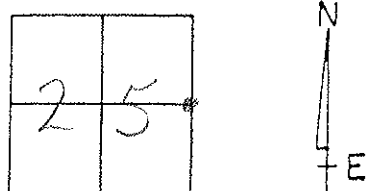

Record:  
 Point (A) - Brass Mon.  
 Sta 403+07.8  
 Point (B) Origin  
 Unknown

Set PK/W  
 Both Points  
 10-31-01  
 SAH

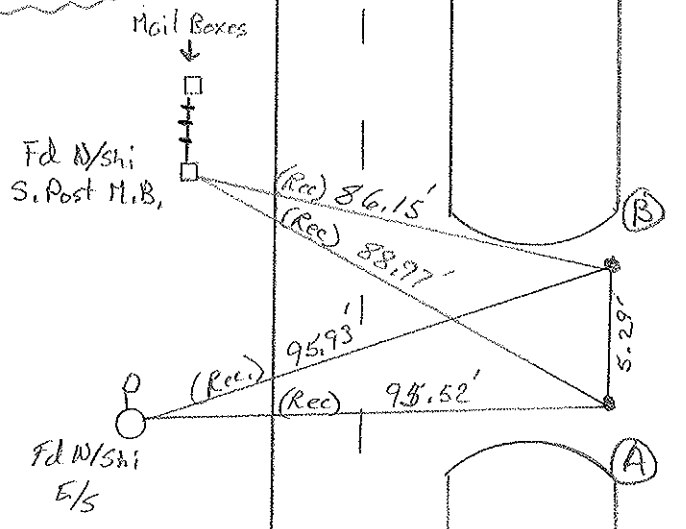

W Post. SR-25  
 S.B.  
 E Post. SR-25  
 N.B.

# O.D.O.T. DISTRICT 2 SURVEY OFFICE

PERSONNEL \_\_\_\_\_

REFERENCE NO. 5

SHEET 8 OF 23

NOTES HOFFMAN

H.C. LOENRKE

R.C. BARNHISEL

DATE 3-22-91

WEATHER CLOUDY

TEMP. 55°

ROUTE SR 25

COUNTY WOOD

TOWNSHIP LIBERTY

SECTION 25

T 4 N R 10 E


TYPE MONUMENT P.K. / WASHER & P.K. (ORIGIN UNKNOWN)

ON SURFACE - BELOW

LEFT - & PAVT. - RIGHT \_\_\_\_\_


ON TO LT. EDGE PAVEMENT

S.L.M. 160+75 - PT "A"

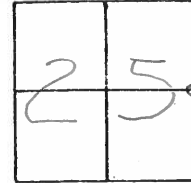

Set P.K. & Washer  
6-5-91  
MB

RECORD: POINT "A"  
BRASS MONUMENT  
Sta 403+07.8

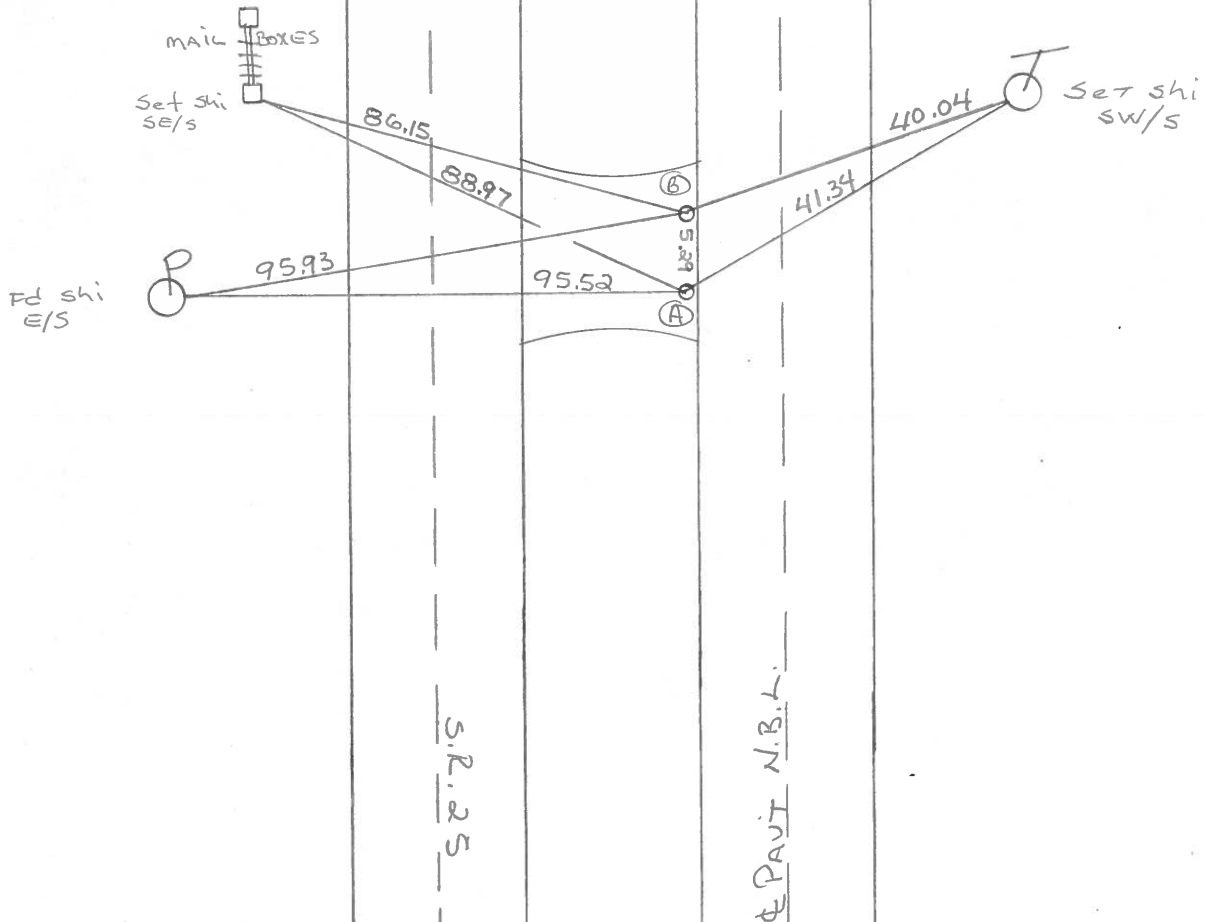

County Wood S.R.-U.S. 25

Township Liberty

Section 25

T4N, R10E

Personnel Hoffman

~~Lochke~~


Householder

5

Date 6-10-81 8-25-81

Weather Cloudy


Temp. + 70°

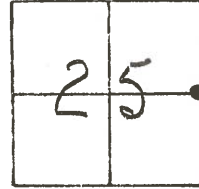

Fd. BRASS MON. @ SURFACE  
11.8' W. of & PAUT, N.B. LANES

PROJECT STA. ± 161+27

SET P.K. AND SHINER

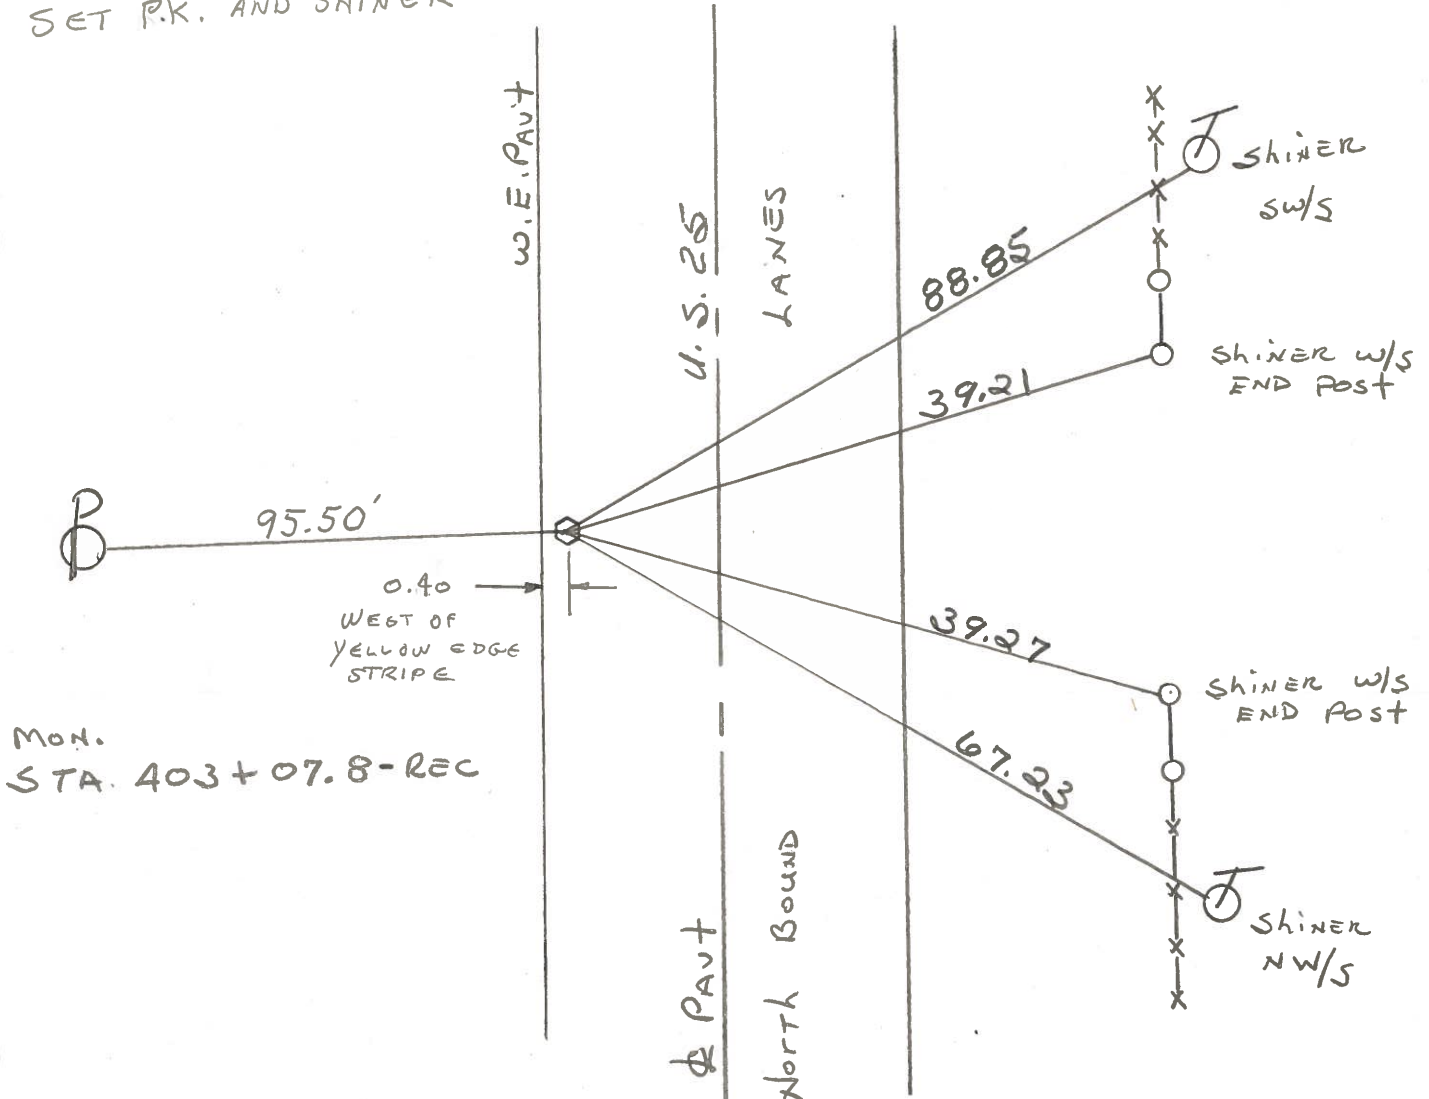

ODOT. DISTRICT 2 SURVEY OFFICE

SHEET \_\_\_\_\_ OF \_\_\_\_\_

County WOOD <sup>U.S.</sup> ~~S.R.~~ 25

Date 7-6-71

Township LIBERTY

Weather CLEAR

Section 25

Temp. 80°

T4N, R10E

Personnel BURNSIDE

SMITH

BOWERS

\_\_\_\_\_

\_\_\_\_\_

⑤

