

O.D.O.T. DISTRICT 2 SURVEY OFFICE (USE ONLY)

PERSONNEL

REFERENCE NO. 9 A

SHEET 20 OF 36

NOTES RHOADES DATE 5/30/18  
H.C. O'DONNELL WEATHER CLOUDY  
R.C. TRENKA TEMP. 82°

ROUTE SR 25  
COUNTY WOOD  
TOWNSHIP LIBERTY  
SECTION 13

DWG BY NIESE PID NO PID

T 4 N R 10 E

TYPE MONUMENT P.K. NAIL

ON SURFACE - ~~BELOW~~ ON

OFFSET  $\text{C}$  PAVEMENT 0.3' ~~LT~~ : RT  
- TO - EDGE PAVEMENT


STATION: 264+67.5

HORIZ.DATUM: NAD83(2011)

GEOID: NAVD88 2012A

GRID: NORTHING: 598685.796


EASTING: 1652458.149

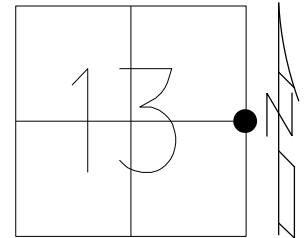

RECORD:  
FD P.K. NAIL  
(SHOT AS REF9)  
5-30-18, JFO  
DRAWING CORRECTED  
11/16/23, TDN

$\text{C}$  S.B. SR 25


$\text{C}$  N.B. SR 25

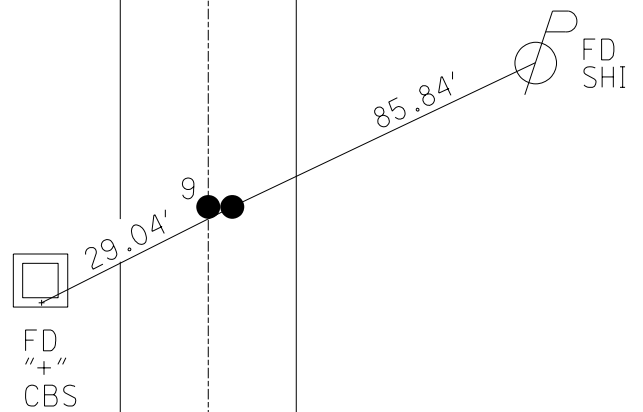


DIST.9-9A= 0.7'

# SEE VERSION UPDATED ON 11/16/23

## O.D.O.T. DISTRICT 2 SURVEY OFFICE (USE ONLY)

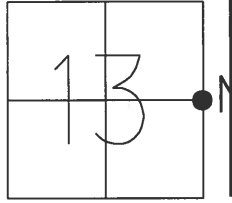PERSONNEL _____	REFERENCE NO. <u>9 A</u>	SHEET <u>20</u> OF <u>36</u>
NOTES <u>RHOADES</u>	DATE <u>5/30/18</u>	ROUTE <u>SR 25</u>
H.C. <u>O'DONNELL</u>	WEATHER <u>CLOUDY</u>	COUNTY <u>WOOD</u>
R.C. <u>TRENKA</u>	TEMP. <u>82°</u>	TOWNSHIP <u>LIBERTY</u>
DWG BY <u>MILLER</u>	PID <u>NO PID</u>	SECTION <u>13</u>
TYPE MONUMENT _____ P.K./WASHER _____		T <u>4</u> N R <u>10</u> E
ON SURFACE - <del>BELOW</del> ON _____		
OFFSET $\text{C}$ PAVEMENT ON _____ LT : RT _____		
_____ TO _____ EDGE PAVEMENT _____		
STATION: <u>264+67.5</u>		
HORIZ.DATUM: <u>NAD83(2011)</u>		GEOID: <u>NAVD88 2012A</u>
GRID: NORTHING: <u>598685.850</u>		EASTING: <u>1652457.455</u>

RECORD:  
FD P.K./WASHER  
REF A9  
5-30-18, JFO

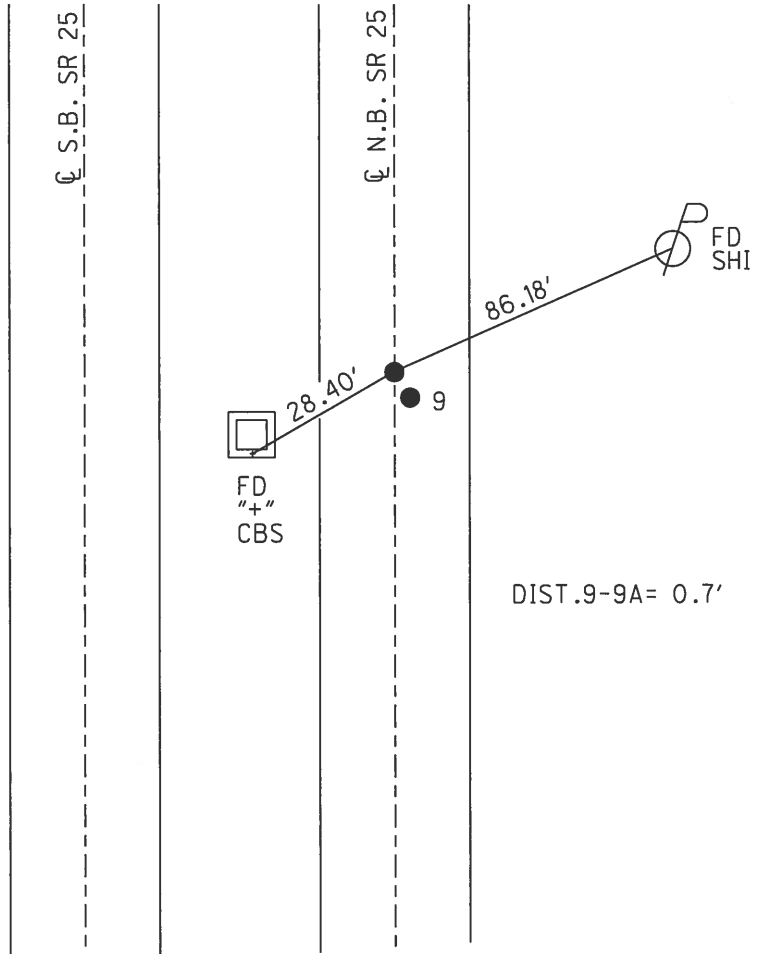

# O.D.O.T. DISTRICT 2 SURVEY OFFICE

PERSONNEL

REFERENCE NO. 9-10

SHEET 12 OF 23

NOTES Huss

H.C. Rousos

R.C. VanDusen

DATE 4-12-01

WEATHER Pt Cldy-Windy

TEMP. +72°F

ROUTE SR-25

COUNTY Wood

TOWNSHIP Liberty

SECTION 13

T 4 N R 10 E


TYPE MONUMENT (A) PK/W (B) PK/W

ON SURFACE - ~~PAV'T.~~ Surface

~~PAV'T.~~ - (A) PAV'T. - RIGHT (B) 0.2'

11.3 TO LT EDGE PAVEMENT

S.L.M. (A) 264+67 (B) 266+92

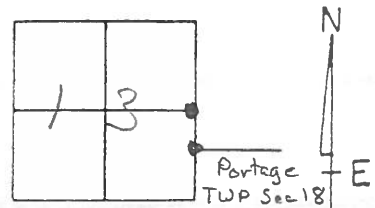

Record:

(A) BRASS MONUMENT  
Sta. 507+07.0

(B) BRASS MONUMENT  
Sta. 509+31.4

Fd N/shi  
E/S 14"

94.55'

PAV'T  
SR-25

SR-25

Fd 7" top  
South Side  
C.B.

PAV'T  
SR-25

(A)

28.43'  
(Rec)

83.07'

Fd Watch  
2' up w/s  
M.M. # 5  
post

(B)

Fd PK/W  
in fence Post

Set PK/W  
Both Points  
10-31-01  
SAH

Set N/shi  
Brace Post

Fd N/shi

77.35'

41.15'

53.22'

224.55'

86.17'

Set N/shi  
w/s P.P.

# O.D.O.T. DISTRICT 2 SURVEY OFFICE

PERSONNEL

REFERENCE NO. 9910

SHEET 12 OF 23

NOTES HOFFMAN

H.C. LOEHRKE

DATE 3-26-91

ROUTE SR 25

R.C. BARAHISEL

WEATHER OVERCAST

COUNTY WOOD

TEMP. 55°

TOWNSHIP LIBERTY

SECTION 13

T 4 N R 10 E

"A"                      "B"


TYPE MONUMENT P.K./washer - P.K./washer

ON SURFACE - BELOW      YES      YES

LEFT - C PAVT. - RIGHT 0.3 - 0.2

11.3 TO LT EDGE PAVEMENT

S.L.M. "A" = 204+67

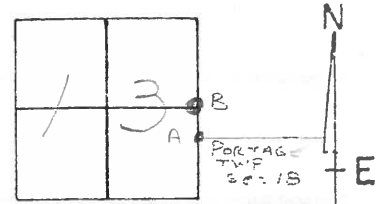

SET P.K.'s & WASHERS  
6-6-91  
mB

RECORD: POINT "A"  
BRASS MON. STA. 507+07.0  
POINT "B"  
BRASS MON. STA. 509+31.4

Set Shi  
E/S 14"

94.55


"B"

Fd Shi SW/S  
53.15

224.55

85.29

Fd Shi SW/S

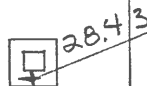

Fd "T" TOP  
South Side  
of C.B.

28.43

83.07

CUT NOTCH 2' UP  
ON POST of MILEMARKET  
# 5

S.R. 25

SR 25  
PAVT N.B.L.

County Wood S.R.-U.S. 25

Township Liberty

Section 13

T4N, R10E


Personnel Hoffman  
Householder

#9 & 10

Date 6-10-81

Weather clear

Temp. +78°

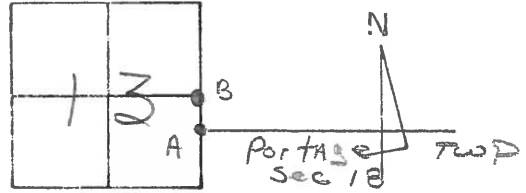


Pt. "A" Fd. BRASS MON @ SURFACE STA 507+07.0 - REC. S.L.M. 265+40  
 Pt. "B" Fd. BRASS MON @ SURFACE STA 509+31.4 - REC. S.L.M. 267+64

SET P.K./WASHER  
@ EACH POINT  
11/9/82  
S.W.H.

SET NEW SHINER  
N/S END POST

34  
106.30

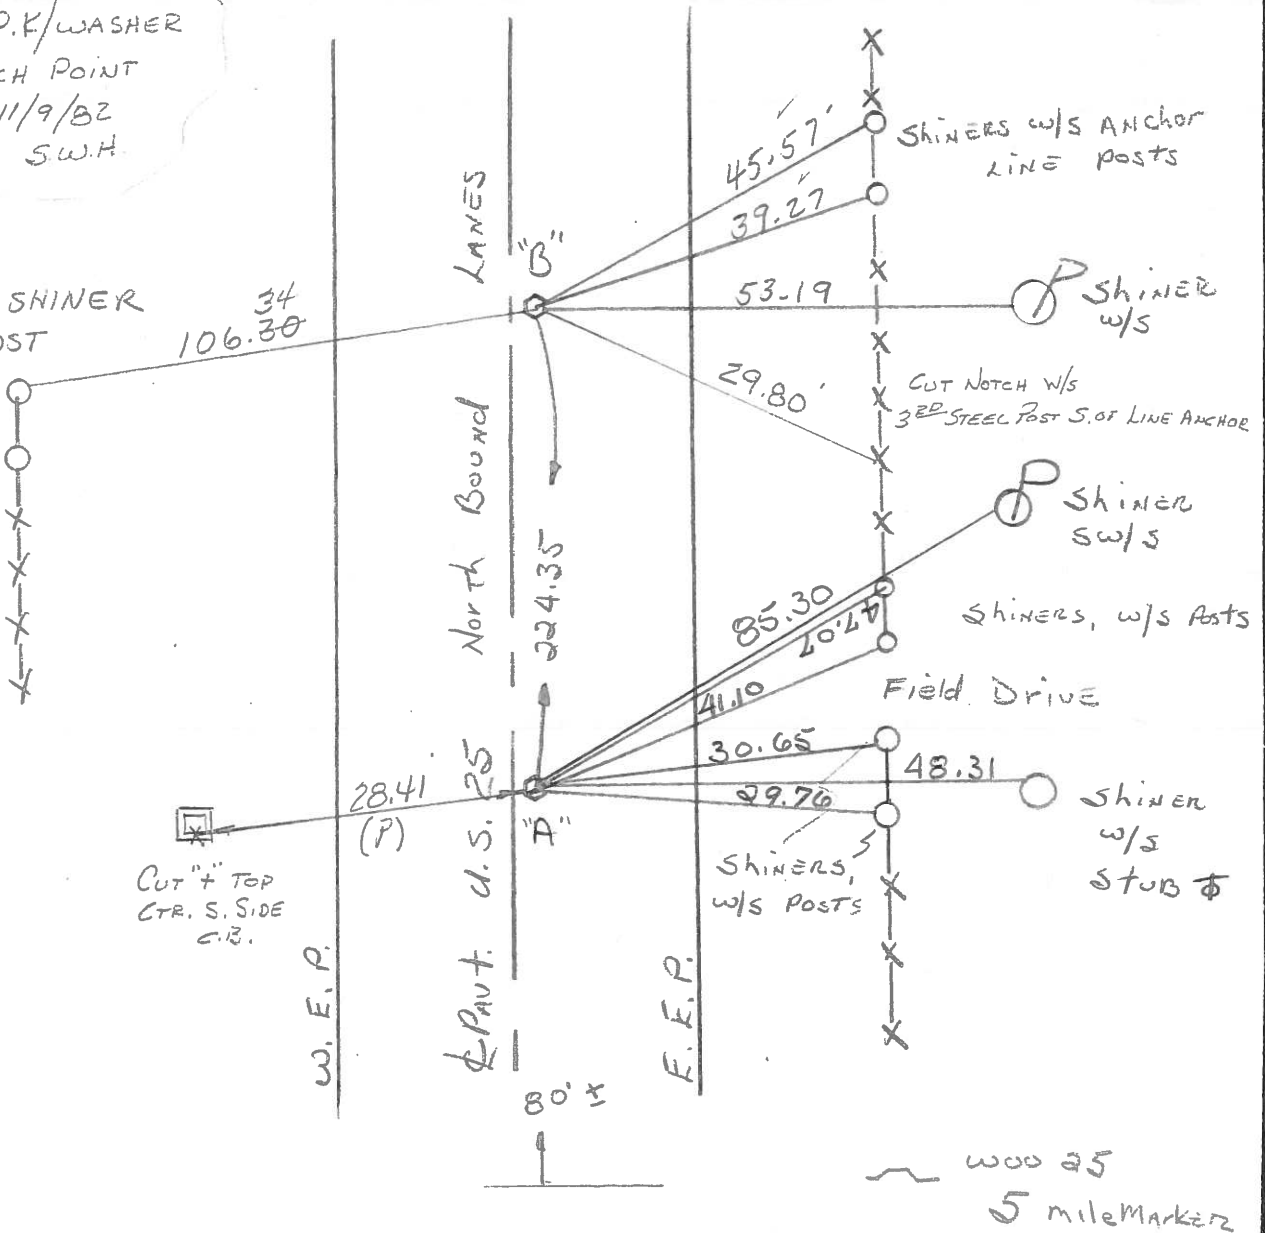

CUT 1" TOP  
CTR. S. SIDE  
C.R.

W.E.P.

PAVT. U.S. 25

F.E.P.

WOOD 25  
5 mile MARKER

County WOOD <sup>U.S.</sup> S.R. 25

Date 7-6-71

Township LIBERTY

Weather CLEAR

Section 13


Temp. 82°

T4N, R10E

Personnel BURNSIDE

SMITH

BOWERS

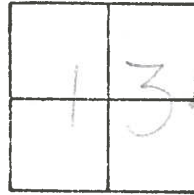


#9 - #10

BRASS MON.  
507+31.4  
E 1/4 Post Sec. 13  
LIBERTY TWP.



25  
224.35  
U.S.

W. 1/4 Post Sec. 18  
PORTAGE TWP.  
SAD. CO.  
BRASS MON.  
STA. 507+07.0

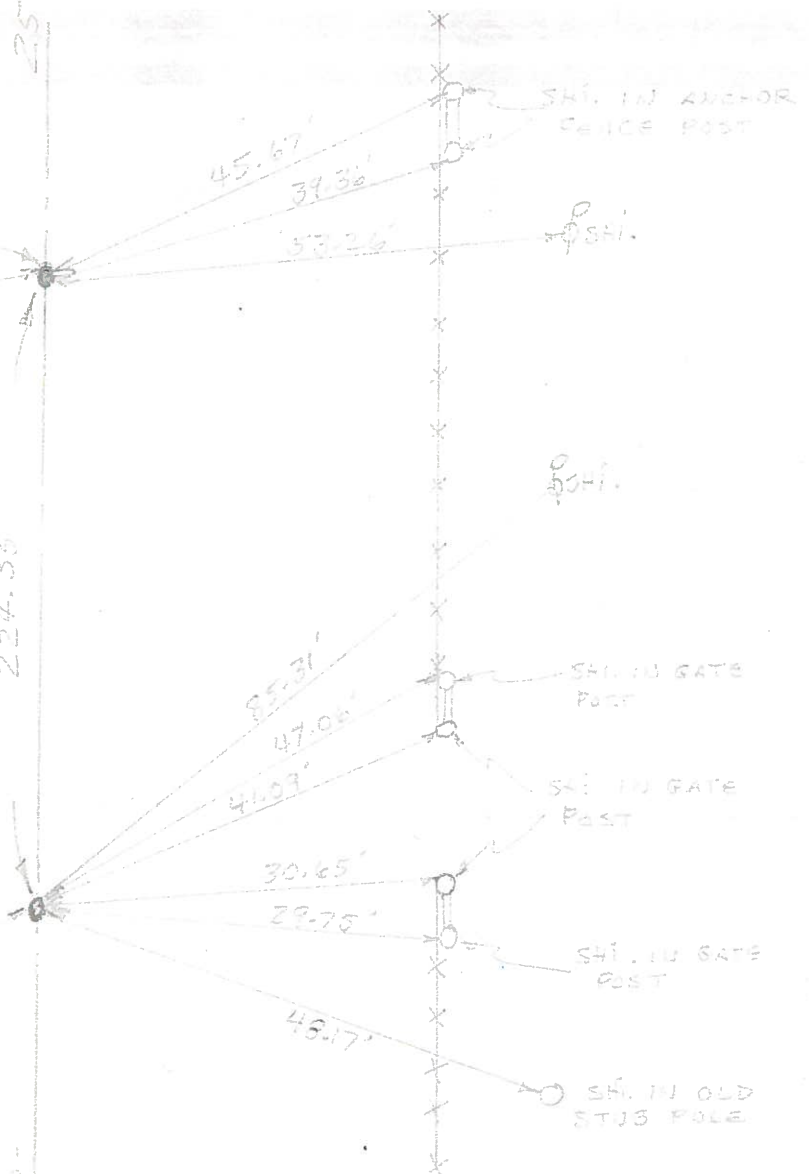



PERSONNEL TITLE PERSONNEL TITLE COUNTY Wood DATE 4-5-60  
 U.S. # 25 WEATHER  
 SEC. TEMP.

DESCRIPTION LEFT CENTER LINE RIGHT JOB NO.

Sta. 507+07.0 W. 1/4 post sec. 18 Portage Twp. Brass plate - Could not raise Mobora Mon.			Shiner in Anchor Post N.N.E. 47.0 Shiner in T.P. W.N.W. 29.00 Shiner in P.P. N.N.E. 85.38 <del>Shiner in 8" oak S.E. 95.76</del> W. edge post. 7.85 E. edge 12.15 Shiner in End Post N.N.E. 41.07 Shiner in End Post N.E. 30.63 Shiner in Anchor Post E. 29.71
(9) #237			
Sta. 509+31.4 E. 1/4 post sec. 13 Liberty Twp. Brass plate with top - (Could not plate gone (raise)			Shiner in T.P. N.W. 58.28 Shiner in T.P. S.S.W. 89.15 Shiner in P.P. N.E. 53.30 59.34 Iron cor. post S.W. 35.45 W. edge post. 8.55' E. edge 11.35' Shiner Brace Post N.N.E. 45.75 Shiner Brace Post N.E. 39.43 "X" E. Edge S. Bound lane (west) 44.10' "X" E. Edge S. Bound lane (N. west) 54.37'
(10) #238			
Sta. 533+62.85 S.W. cor. sec. 7 Portage Twp. <u>Greensburg Pike East.</u> Brass plate in lot post.			Shiner in T.P. E.S.E. 66.74 Shiner in P.P. S.S.E. 94.22 Shiner in T.P. W. 38.16 Shiner in End Post N.N.E. 44.74 Shiner in P. Pole N.E. 93.10 Shiner in End Post E.S.E. 50.93 Shiner in T. Pole S.E. 66.94
(11) #239			
Sta. 535+91.8 S.E. cor. sec. 12 Liberty Twp. <u>Greensburg Pike West.</u> Brass plate in E post.			Shiner in P.P. N.N.E. 94.60 Shiner in T.P. N.W. 45.00 Shiner in T.P. W.N.W. 67.13 conc. E/W mon. S.W. 57.29 "X" in conc. curb N.W. 38.3 "X" in conc. curb S.W. 34.14
(12) #240			