

O.D.O.T. DISTRICT 2 SURVEY OFFICE (USE ONLY)

PERSONNEL _____ REFERENCE NO. 14 A SHEET 26 OF 36

NOTES RHOADES DATE 5/30/18 ROUTE SR 25

H.C. O'DONNELL WEATHER CLOUDY COUNTY WOOD

R.C. TRENKA TEMP. 84° TOWNSHIP LIBERTY

SECTION 12

DWG BY MILLER PID NO PID

T 4 N R 10 E


TYPE MONUMENT MAG/WASHER

ON SURFACE - ~~BELOW~~ ON

OFFSET \varnothing PAVEMENT 2.5' ~~LT~~ : RT

28.5 TO LT EDGE PAVEMENT - FACE CURB


STATION: 342+56

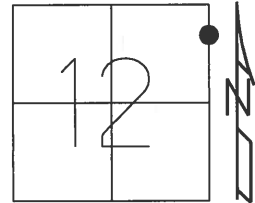

HORZ. DATUM: NAD83(2011) GEOID: NAVD88 2012A

GRID: NORTHING: 606476.483 EASTING: 1652545.697

RECORD:
 ORIGIN UNKOWN
 FD RR SPIKE
 5-18-78
 FD P.K./WASHER
 4/16/01, TMR
 SET P.K./WASHER
 10-31-01, SAH
 SET MAG/WASHER
 REFA14
 5-30-18
 10-1-18, JFO

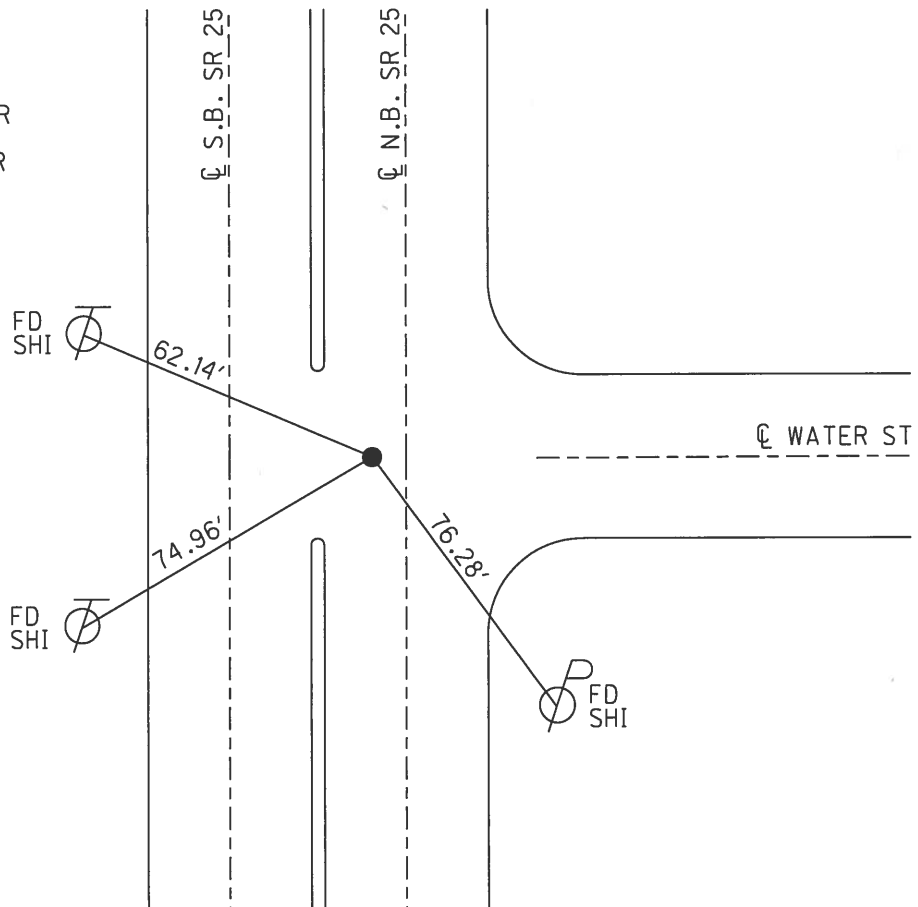

O.D.O.T. DISTRICT 2 SURVEY OFFICE

PERSONNEL _____

REFERENCE NO. 14A

SHEET 15 OF 23

NOTES Huss

H.C. Rousoe

R.C. VanDusen

DATE 4-16-01

WEATHER Cldy. Rain

TEMP. +41°

ROUTE SR 25

COUNTY WOOD

TOWNSHIP LIBERTY

SECTION 12

T 4 N R 10 E


TYPE MONUMENT PK/WASHER

ON SURFACE - BELOW YES

LEFT ← PAVT. RIGHT 2.5

28.5 TO LT. EDGE PAVEMENT - FACE CURB


S.L.M. 342456

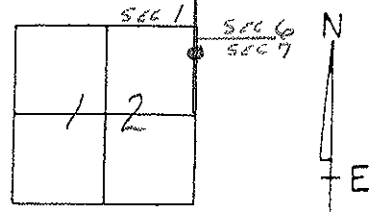

RECORD:

5-18-78 FND RR SPK
 ASSUMED SET BY
 POLYMERIZER
 ORIGIN OF PT. UNKNOWN

SET PK/WASHER
10-31-01
SAH

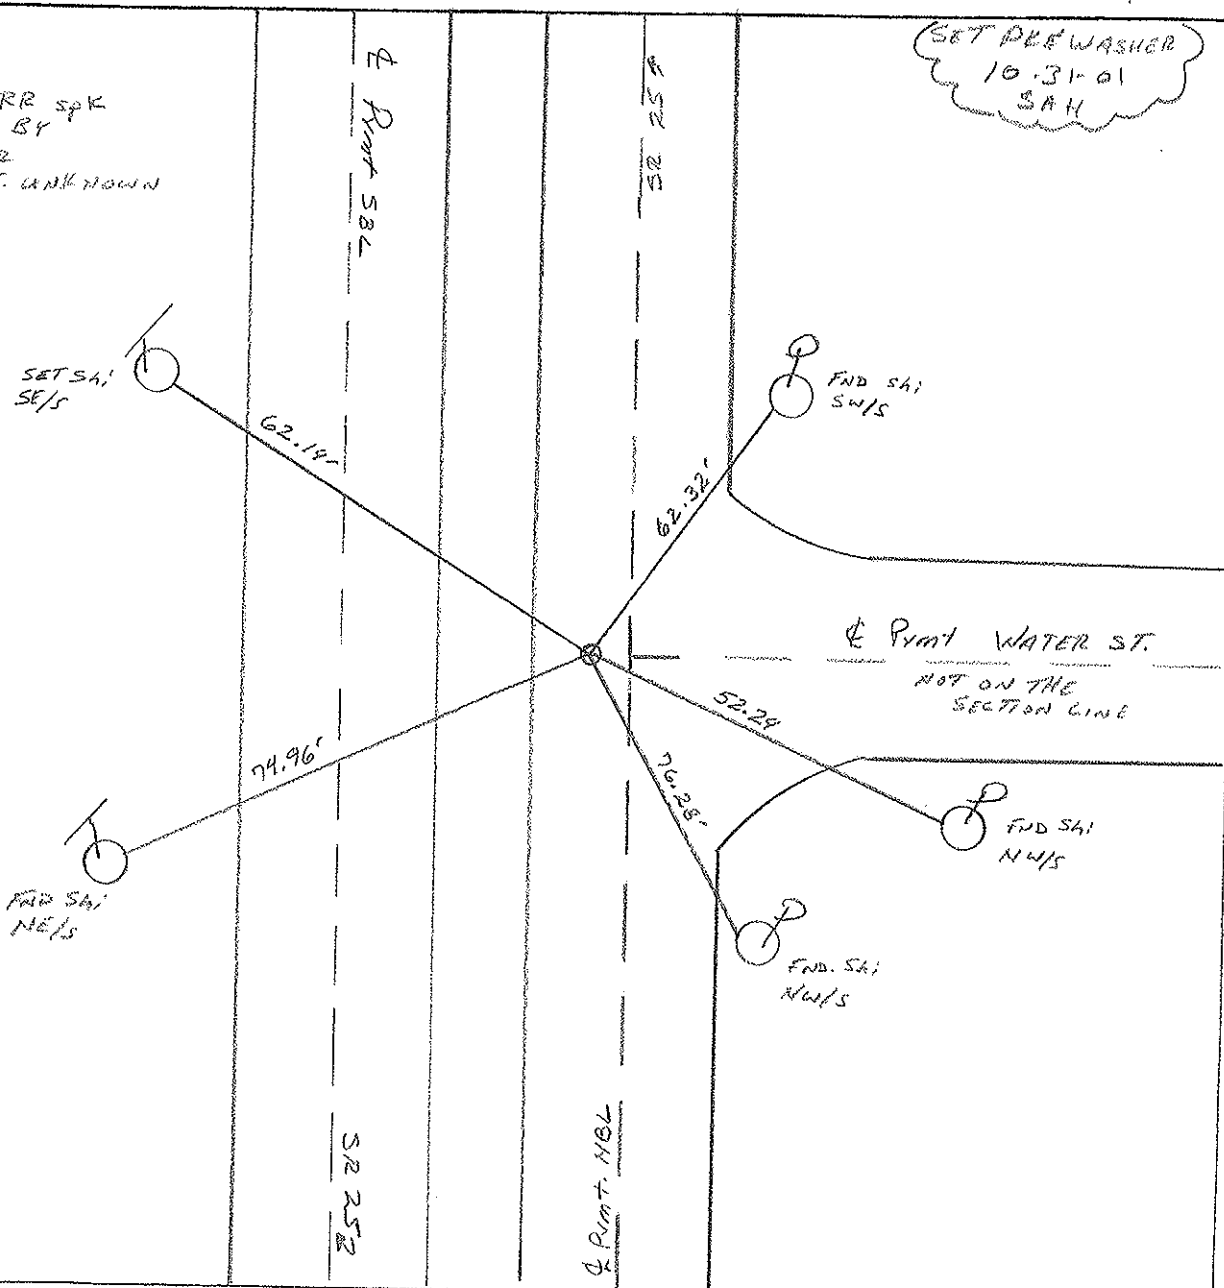

O.D.O.T. DISTRICT 2 SURVEY OFFICE

PERSONNEL _____

REFERENCE NO. _____

SHEET 15 OF 23

NOTES HOFFMAN

H.C. LOSHRKE

R.C. BARNHISEL

DATE 3-27-91

WEATHER P. CLEAR

TEMP. 50°

ROUTE SR 25

COUNTY WOOD

TOWNSHIP LIBERTY

SECTION 12

T 4 N R 10 E


TYPE MONUMENT P.K. - ORIGIN OF POINT UNKNOWN

ON SURFACE - BELOW YES

~~LEFT - C~~ PAV'T. - RIGHT 2.5

28.5 TO LT EDGE PAVEMENT - FACE CURB


S.L.M. 342 + 56

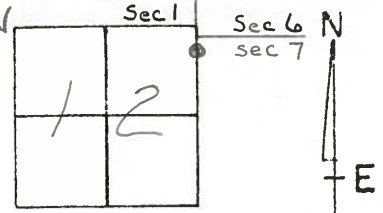

14-A

RECORD:
5-18-78 FD SPK.
ASSUMED SET BY
POGGEMEYER

SET P.K. @ WASHOE
6-6-91
m3

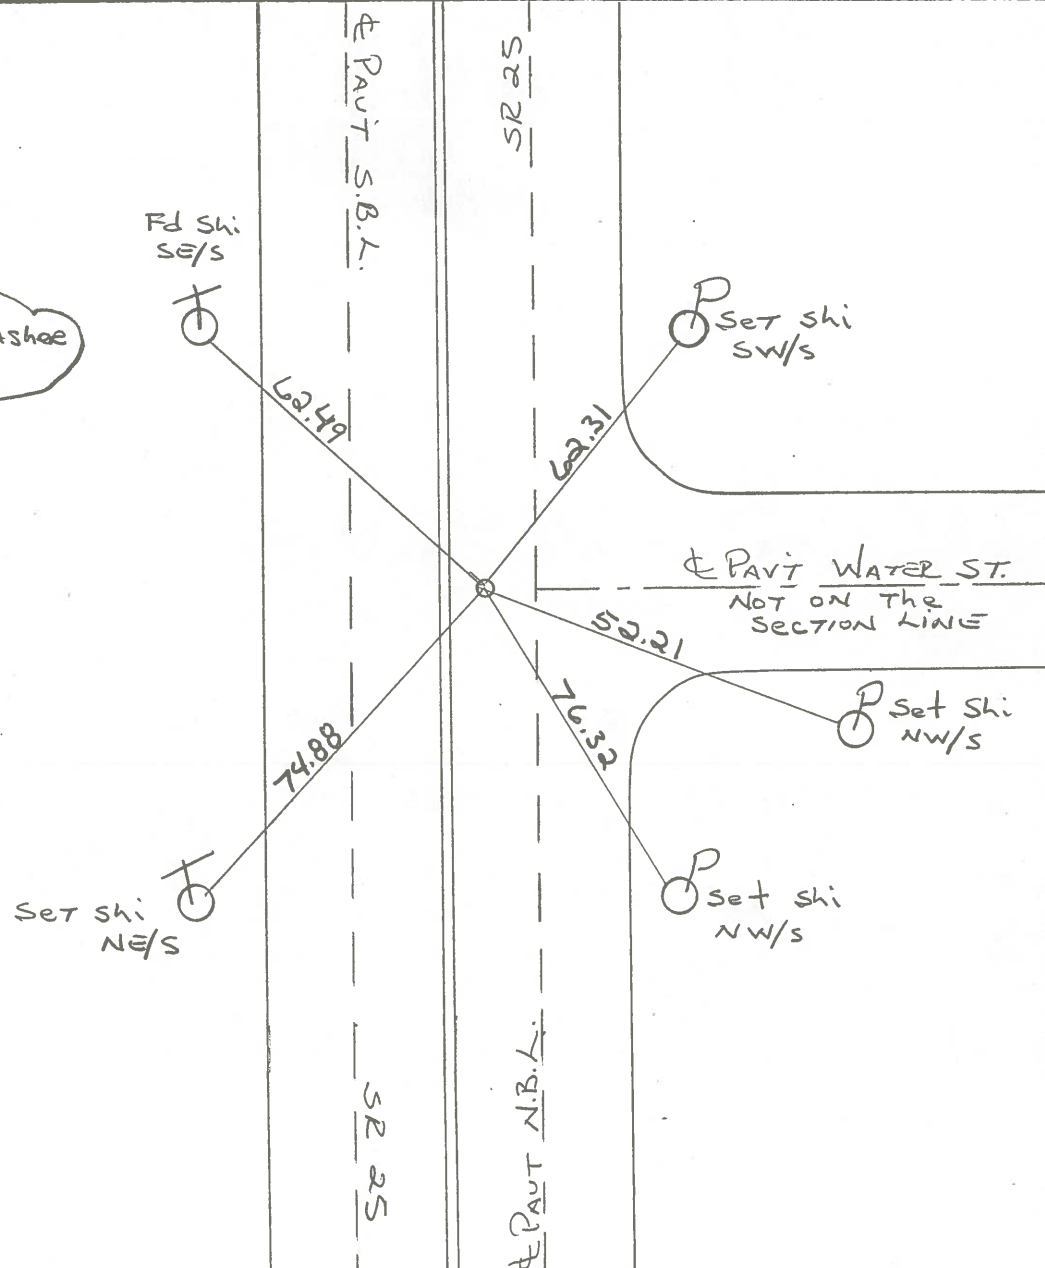

OD.O.T. DISTRICT 2 SURVEY OFFICE

Sht. ___ of ___

County Wood

Date 5-18-78

Township LIBERTY

Weather Cloudy

Section PORTAGE, OHIO
¹²

Temp. +55°

T4N, R10E


Personnel BURNSIDE

SMITH

BOWERS

MEAD

14-A

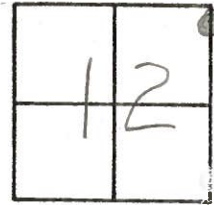

FD. SPK.
ASSUMED SET
BY POGGEMEYER
B.G.O.

