


O.D.O.T. DISTRICT 2 SURVEY OFFICE (USE ONLY)

PERSONNEL _____ REFERENCE NO. 16 B SHEET 31 OF 36
 NOTES HUSS DATE 4/16/01 ROUTE SR 25
 H.C. ROUSOS WEATHER CLOUDY/RAIN COUNTY WOOD
 R.C. VAN DUSEN TEMP. 42° TOWNSHIP LIBERTY
 DWG BY MILLER PID NO PID SECTION 1
 T 4 N R 10 E


TYPE MONUMENT _____ P.K./WASHER _____
 ON SURFACE - ~~BELOW~~ ON _____
 OFFSET \bar{C} PAVEMENT 2.6' ~~LT~~ : RT
28.6' TO LT EDGE PAVEMENT
 STATION: 357+99

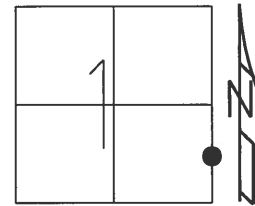

HORZ. DATUM: NAD83(2011) GEOID: NAVD88 2012A
 GRID: NORTHING: 608020.513 EASTING: 1652564.956

RECORD:
 FD P.K./WASHER
 4/16/01, BVD
 SET P.K./WASHER
 10-31-01, SAH
 FD HOLE
 REFB16
 5-30-18
 10-1-18, JFO

DIST.
 16A-16B= 54.00'
 16B-16C= 100.00'

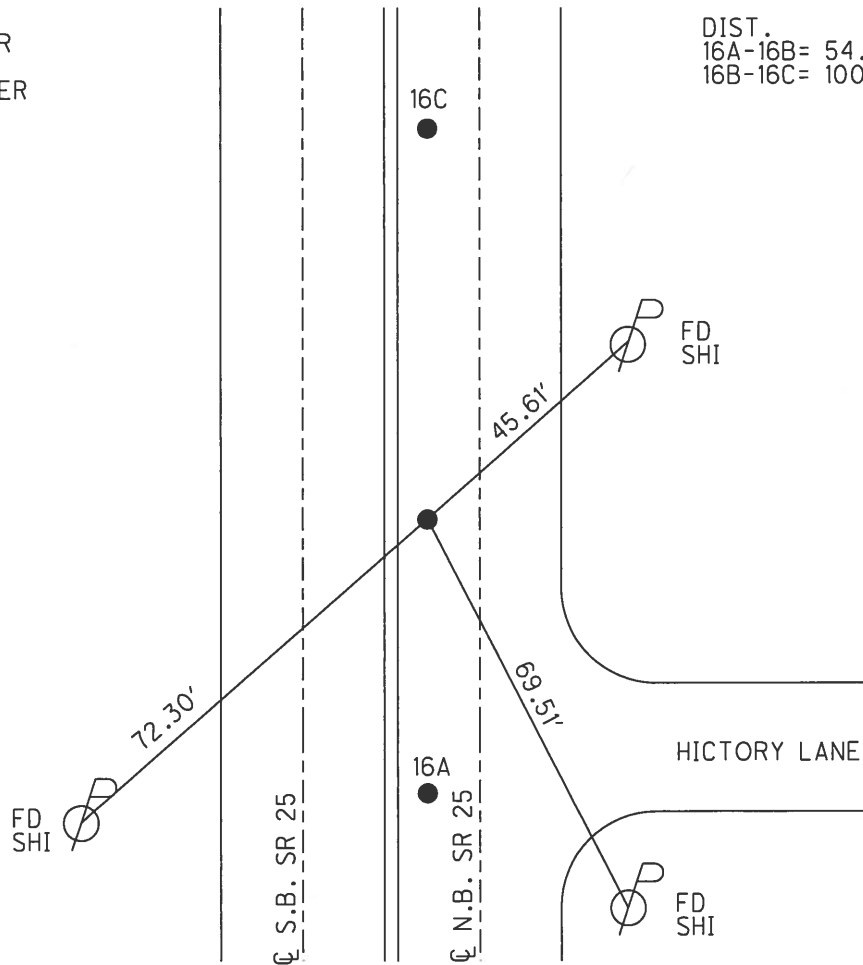

O.D.O.T. DISTRICT 2 SURVEY OFFICE

PERSONNEL _____

REFERENCE NO. _____

SHEET 18 OF 23

NOTES Huss

H.C. Rousar

R.C. Van Dusen

DATE 4-16-61

WEATHER Cldy - Rain

TEMP. +42°F

ROUTE SR-25

COUNTY Wood

TOWNSHIP Liberty

SECTION 1

T 4 N R 10 E



TYPE MONUMENT PK/W All three points

ON SURFACE - ~~BELOW~~ Surf.

~~PAV'T.~~ - PAV'T. - RIGHT 2.6' Right - All

28.6' TO L. EDGE PAVEMENT

S.L.M. (A) = 357+45 (B) = 357+99 (C) = 358+99

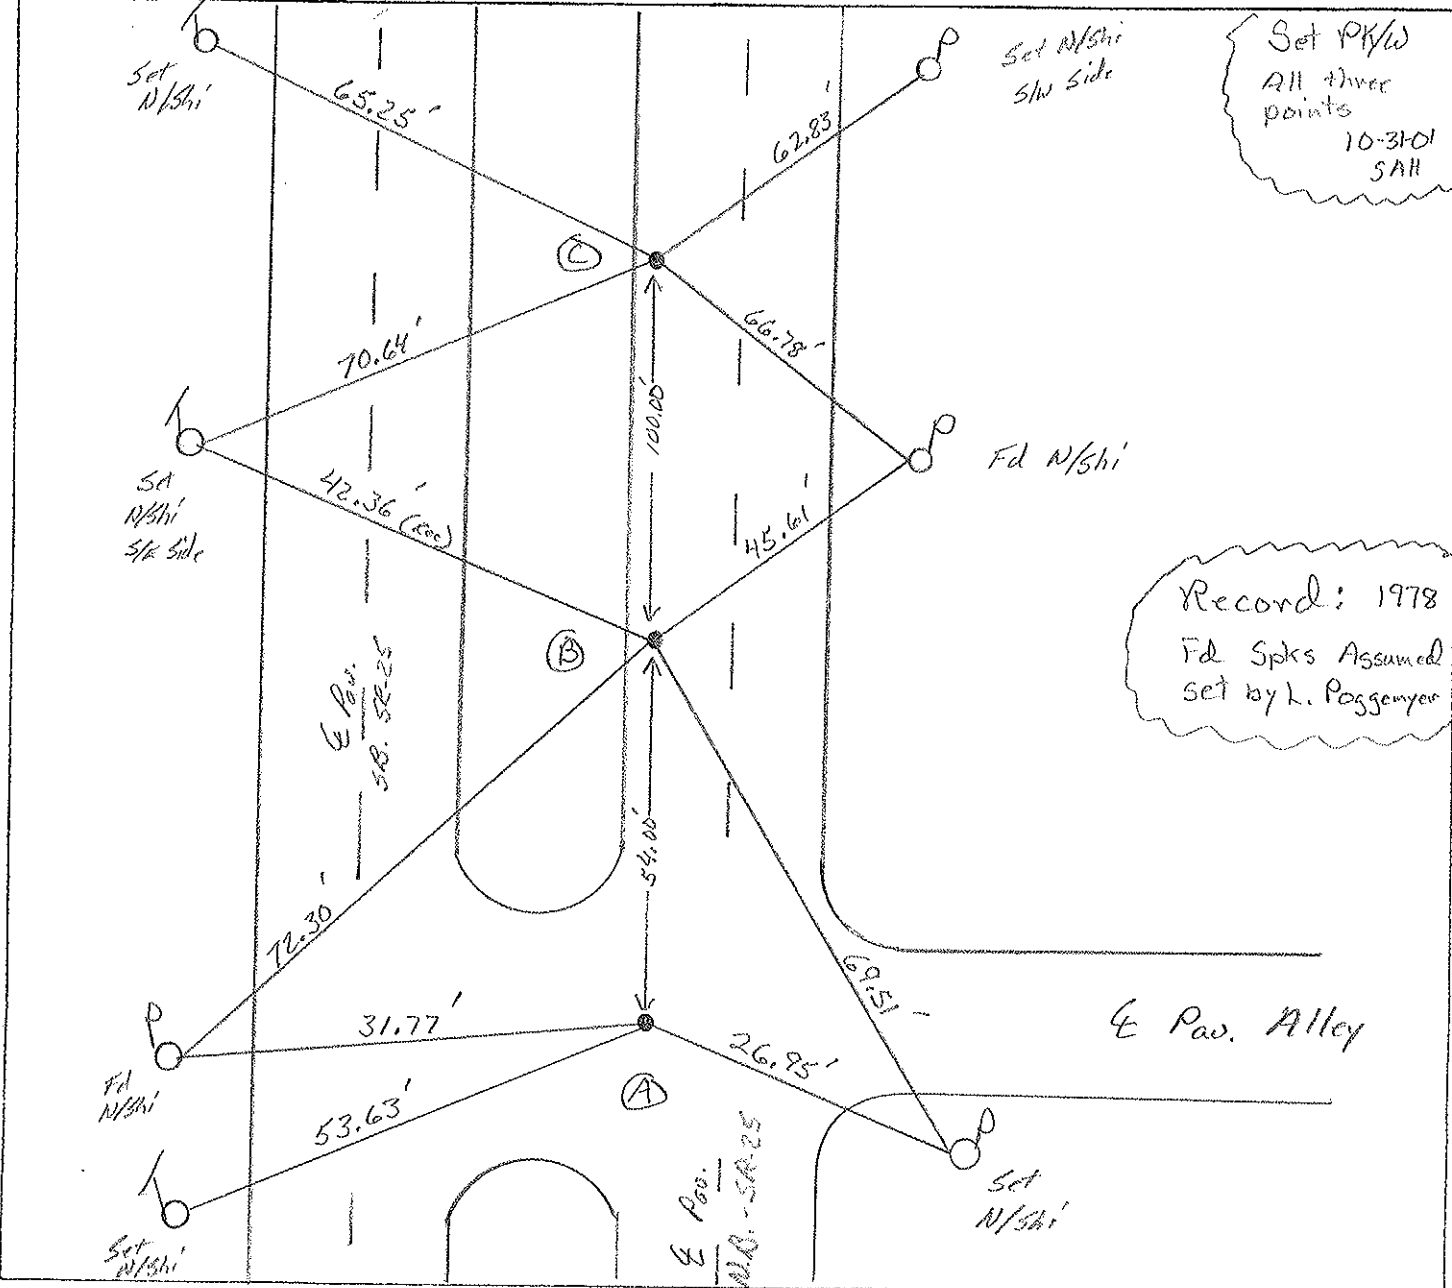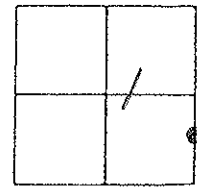

O.D.O.T. DISTRICT 2 SURVEY OFFICE

PERSONNEL

REFERENCE NO. _____

SHEET 18 OF 23

NOTES HOFFMAN

H.C. LOEHRKE

DATE 3-27-91

ROUTE SR 25

R.C. BARNHISEL

WEATHER P. CLEAR

COUNTY WOOD

TEMP. 55°

TOWNSHIP LIBERTY

SECTION 1

T4 NR 10 E

TYPE MONUMENT P.K. NAILS (3)

~~ON SURFACE~~ - BELOW ALL 1"

~~LEFT - C PAV T.~~ - RIGHT ALL 2.6'



28.6 TO LT. EDGE PAVEMENT - CURB

S.L.M. CENTER POINT = 357+99

16-A

16-B

16-C

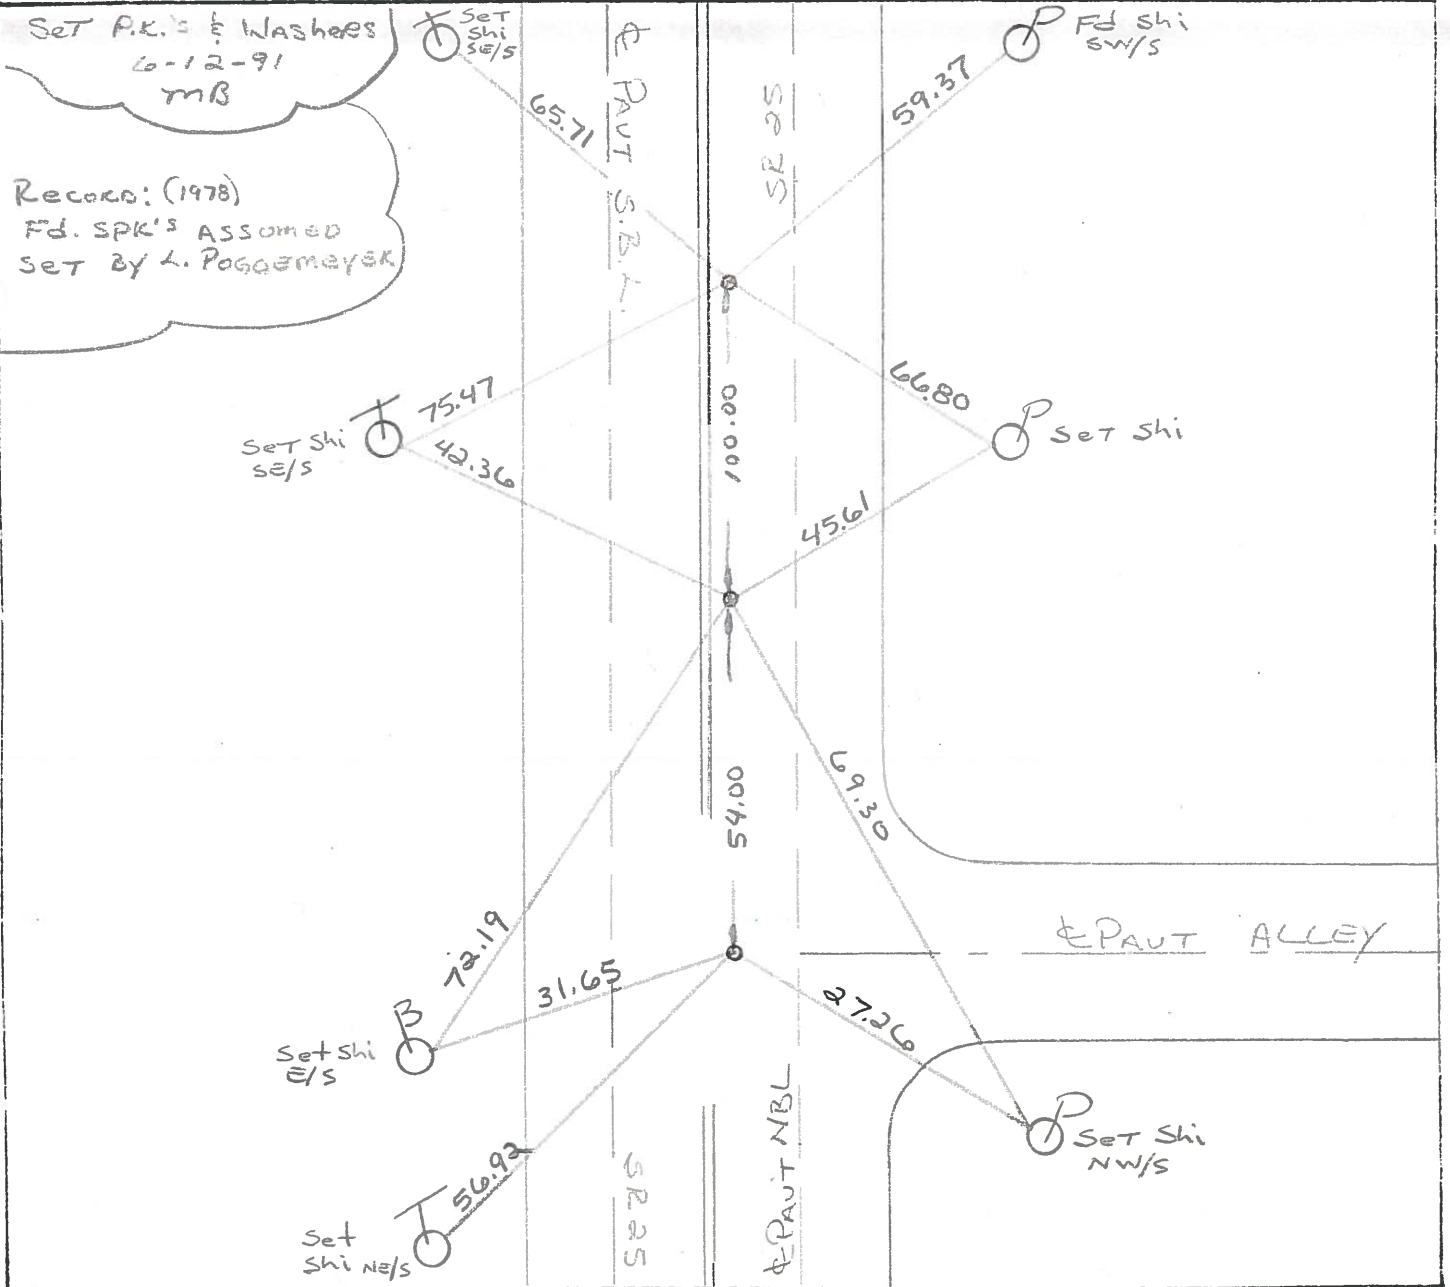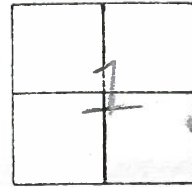

County Wood

Date 5-18-78

Township LIBERTY

Weather CLEARING

Section PORTAGE OHIO

Temp. +58°

T4N, R10E

Personnel BURNSIDE

SMITH

BOWERS


KNAPE

MEAD

16-A

16-B

16-C

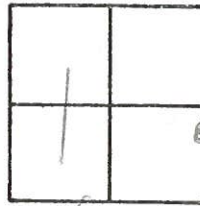

POINTS FOUND BEFORE RESURFACING PROJECT.

FD. SPK. ASSUMED SET BY L. FOGGEMEYER

