


O.D.O.T. DISTRICT 2 SURVEY OFFICE (USE ONLY)


PERSONNEL _____ REFERENCE NO. 16 C SHEET 32 OF 36
 NOTES HUSS DATE 4/16/01 ROUTE SR 25
 H.C. ROUSOS WEATHER CLOUDY/RAIN COUNTY WOOD
 R.C. VAN DUSEN TEMP. 42° TOWNSHIP LIBERTY
 DWG BY MILLER PID NO PID SECTION 1
 T 4 N R 10 E

TYPE MONUMENT _____ P.K./WASHER _____
 ON SURFACE - ~~BELOW~~ ON _____
 OFFSET ϕ PAVEMENT 2.6' ~~LT~~ : RT
28.6' TO LT EDGE PAVEMENT
 STATION: 358+99

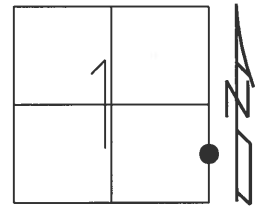

HORIZ.DATUM: NAD83(2011) GEOID: NAVD88 2012A
 GRID: NORTHING: 608120.394 EASTING: 1652566.235

RECORD:
 FD P.K./WASHER
 4/16/01, BVD
 SET P.K./WASHER
 10-31-01, SAH
 FD HOLE
 REFC16
 5-30-18
 10-1-18, JFO

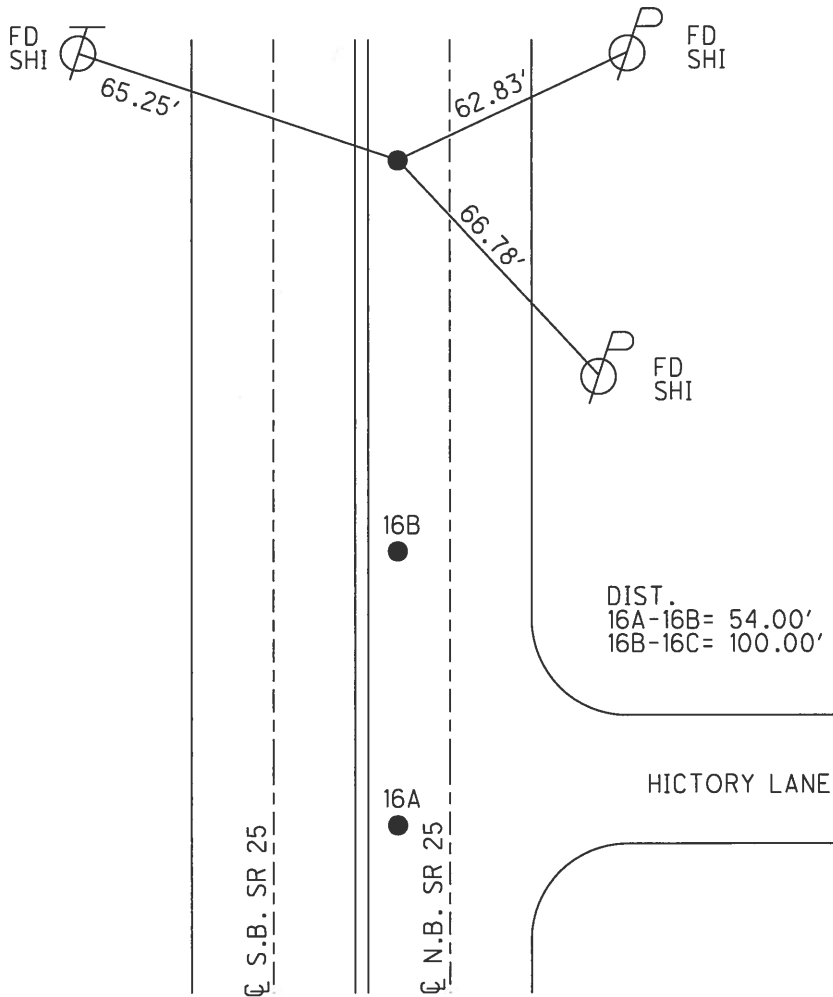

O.D.O.T. DISTRICT 2 SURVEY OFFICE

PERSONNEL _____

REFERENCE NO. _____

SHEET 18 OF 23

NOTES Huss

H.C. Rousar

R.C. Van Dusen

DATE 4-16-61

WEATHER Cldy - Rain

TEMP. +42°F

ROUTE SR-25

COUNTY Wood

TOWNSHIP Liberty

SECTION 1

T 4 N R 10 E



TYPE MONUMENT PK/W All three points

ON SURFACE - ~~BELOW~~ Surf.

~~100'~~ - PAV'T. - RIGHT 2.6' Right - All

28.6' TO Lt. EDGE PAVEMENT

S.L.M. (A) = 357+45 (B) = 357+99 (C) = 358+99

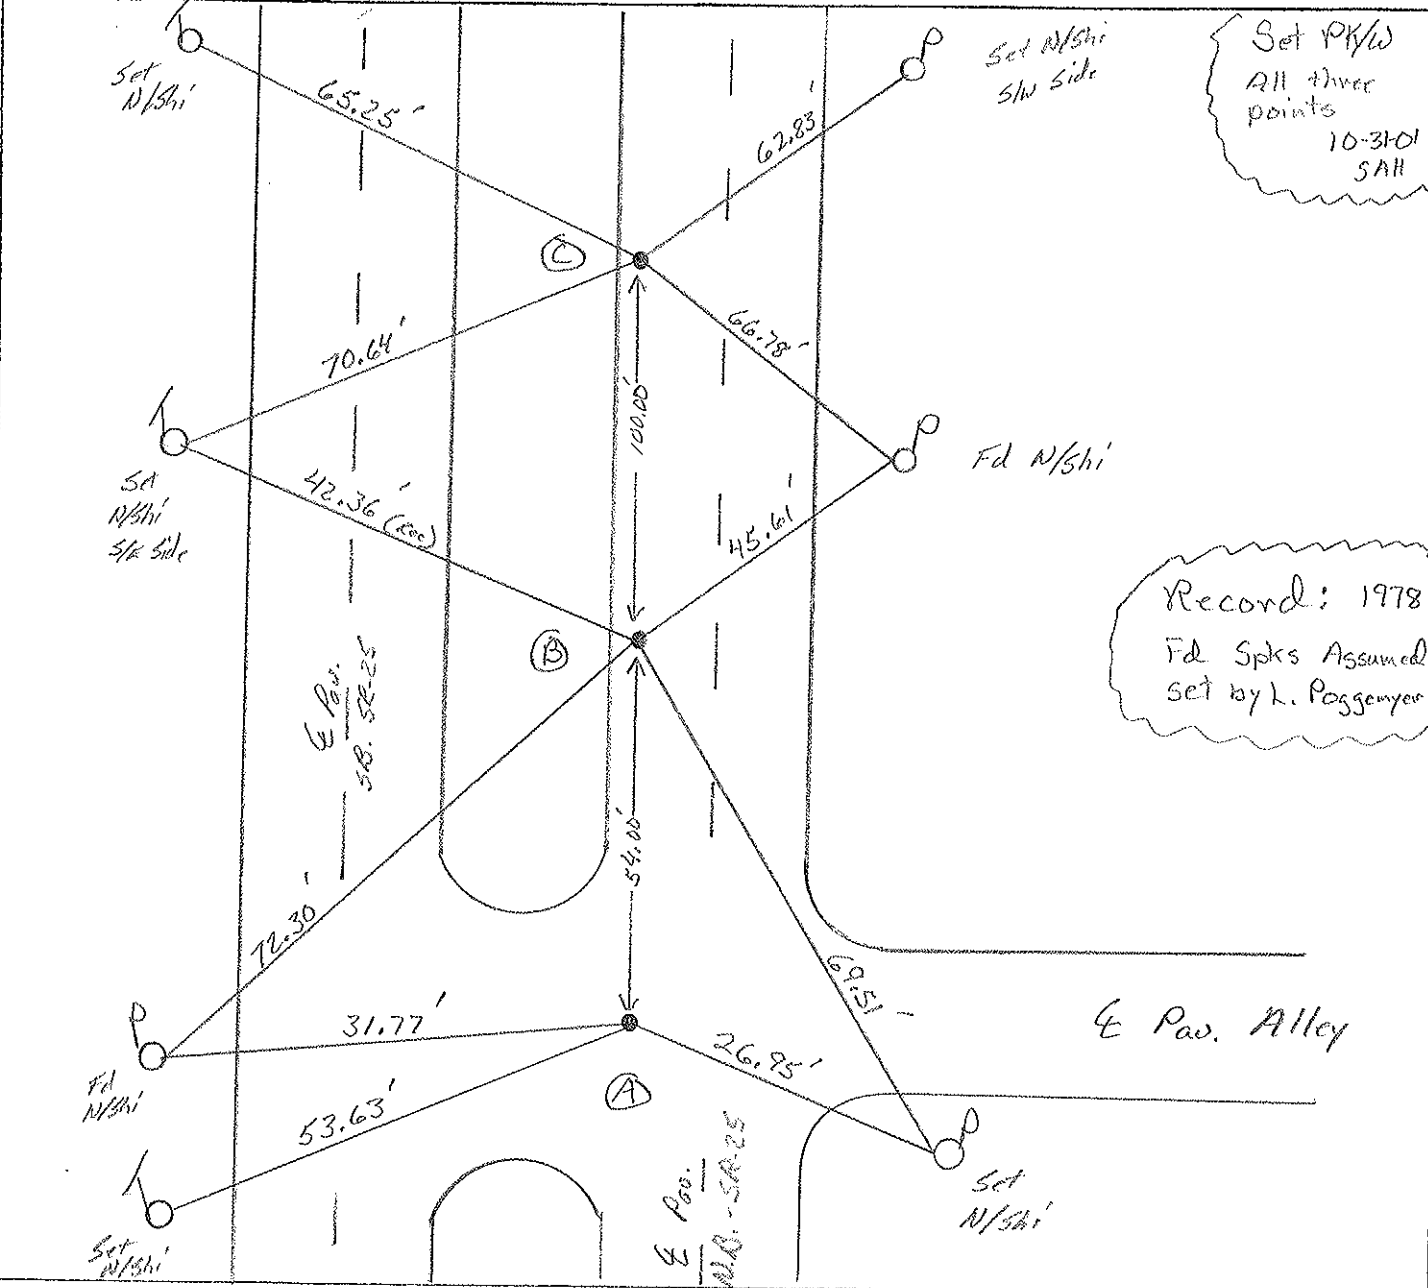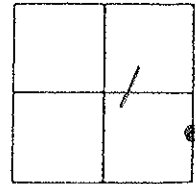

O.D.O.T. DISTRICT 2 SURVEY OFFICE

PERSONNEL

REFERENCE NO. _____

SHEET 18 OF 23

NOTES Hoffman

H.C. LOSHRICE

R.C. BARNHISEL

DATE 3-27-91

WEATHER P. CLEAR

TEMP. 55°

ROUTE SR 25

COUNTY WOOD

TOWNSHIP LIBERTY

SECTION 1

T4 NR 10 E

TYPE MONUMENT P.K. NAILS (3)

~~ON SURFACE - BELOW ALL 1"~~

~~LEFT - C PAVT. - RIGHT ALL 2.6'~~



28.6 TO Lt. EDGE PAVEMENT - CURB

S.L.M. CENTER POINT = 357+99

16-A

16-B

16-C

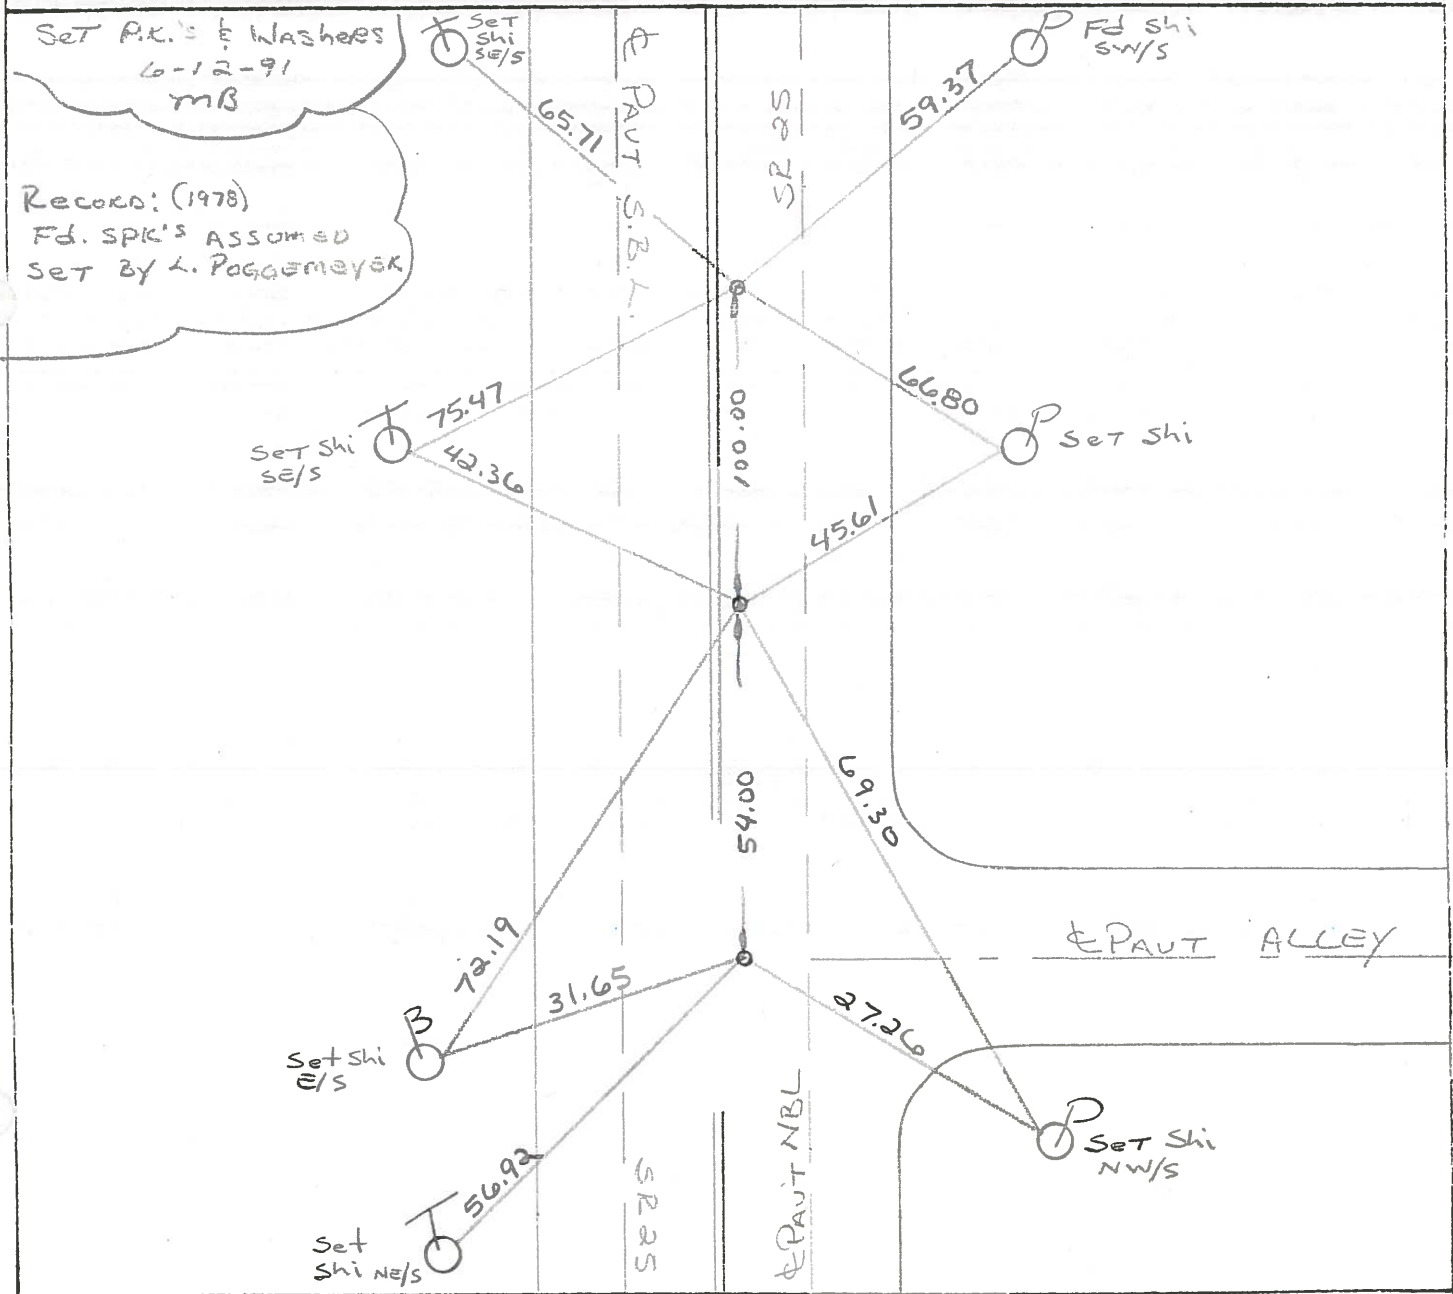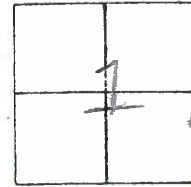

County WOOD

Date 5-18-78

Township LIBERTY

Weather CLEARING


Section PORTAGE OHIO

Temp. +58°

T4N, R1E

Personnel BURNSIDE

16-A
16-B
16-C

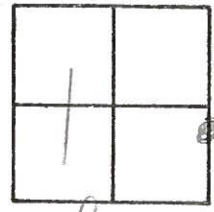

POINTS FOUND BEFORE RESURFACING PROJECT.

FD. SPK. ASSUMED SET BY L. POGGEMEYER

