


O.D.O.T. DISTRICT 2 SURVEY OFFICE (USE ONLY)

PERSONNEL \_\_\_\_\_ REFERENCE NO. 21 A SHEET 4 OF 4

NOTES BARNHISEL DATE 6-10-92 ROUTE US 25  
 H.C. VAN DUSEN WEATHER SUNNY COUNTY WOOD  
 R.C. BURNETT TEMP. 55°F TOWNSHIP PLAIN  
 SECTION 25  
 T 5 N R 10 E

TYPE MONUMENT SM RR SPIKE  
 ON SURFACE - ~~BELOW~~ ON \_\_\_\_\_  
 LEFT - ☉ PAV'T - RIGHT ON, 2' N. OF ☉ W.  
 - TO - EDGE PAVEMENT  
 S.L.M. 456+63

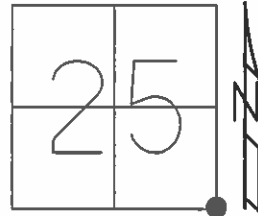


Grid: Northing: 617811.2525 Easting: 1652693.6627

RECORD:  
 BRASS MONUMENT  
 STA 698+38.3

DIST. 21-21A = 24.46'

SET PK/WASHER  
 8-20-92, BVD

FD RR SPIKE  
 GPS, CNTRL 8  
 10-01-13

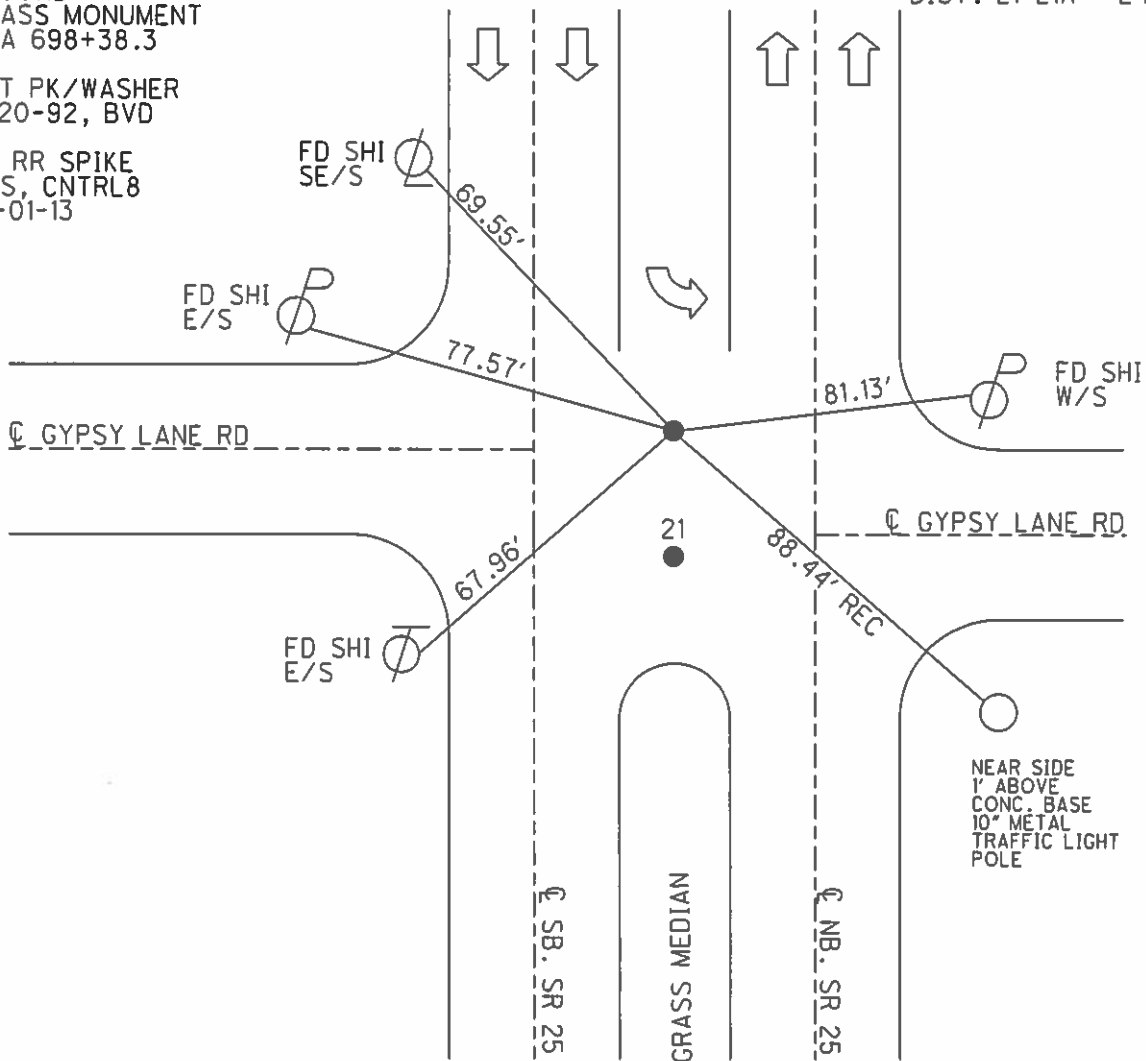

NEAR SIDE  
 1' ABOVE  
 CONC. BASE  
 10" METAL  
 TRAFFIC LIGHT  
 POLE

# O.D.O.T. DISTRICT 2 SURVEY OFFICE

PERSONNEL

REFERENCE NO. 21

SHEET 1 OF 22

NOTES BARNHISEL

H.C. VAN DUSEN

DATE 6-10-92

ROUTE U.S. 25

R.C. BURNETT

WEATHER SUNNY

COUNTY WOOD

TEMP. +55°

TOWNSHIP PLAIN

SECTION 25

T 5 N R 10 E

PT (A)

PT (B)


TYPE MONUMENT Sm RR Spk Sm RR Spk

ON SURFACE - BELOW YES YES

LEFT - C PAV'T. - RIGHT YES YES

- TO - EDGE PAVEMENT

S.L.M. 456+39 E 456+63

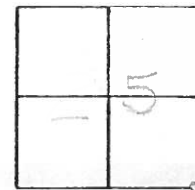


PK'S & WASHERS  
SET 8-20-92  
BYD

PT (A) = 1.5 S. of R E.

PT (B) = 2.0 N. of C W.

RECORD - PT "B"  
BRASS MONUMENT  
STA = 698+37.3

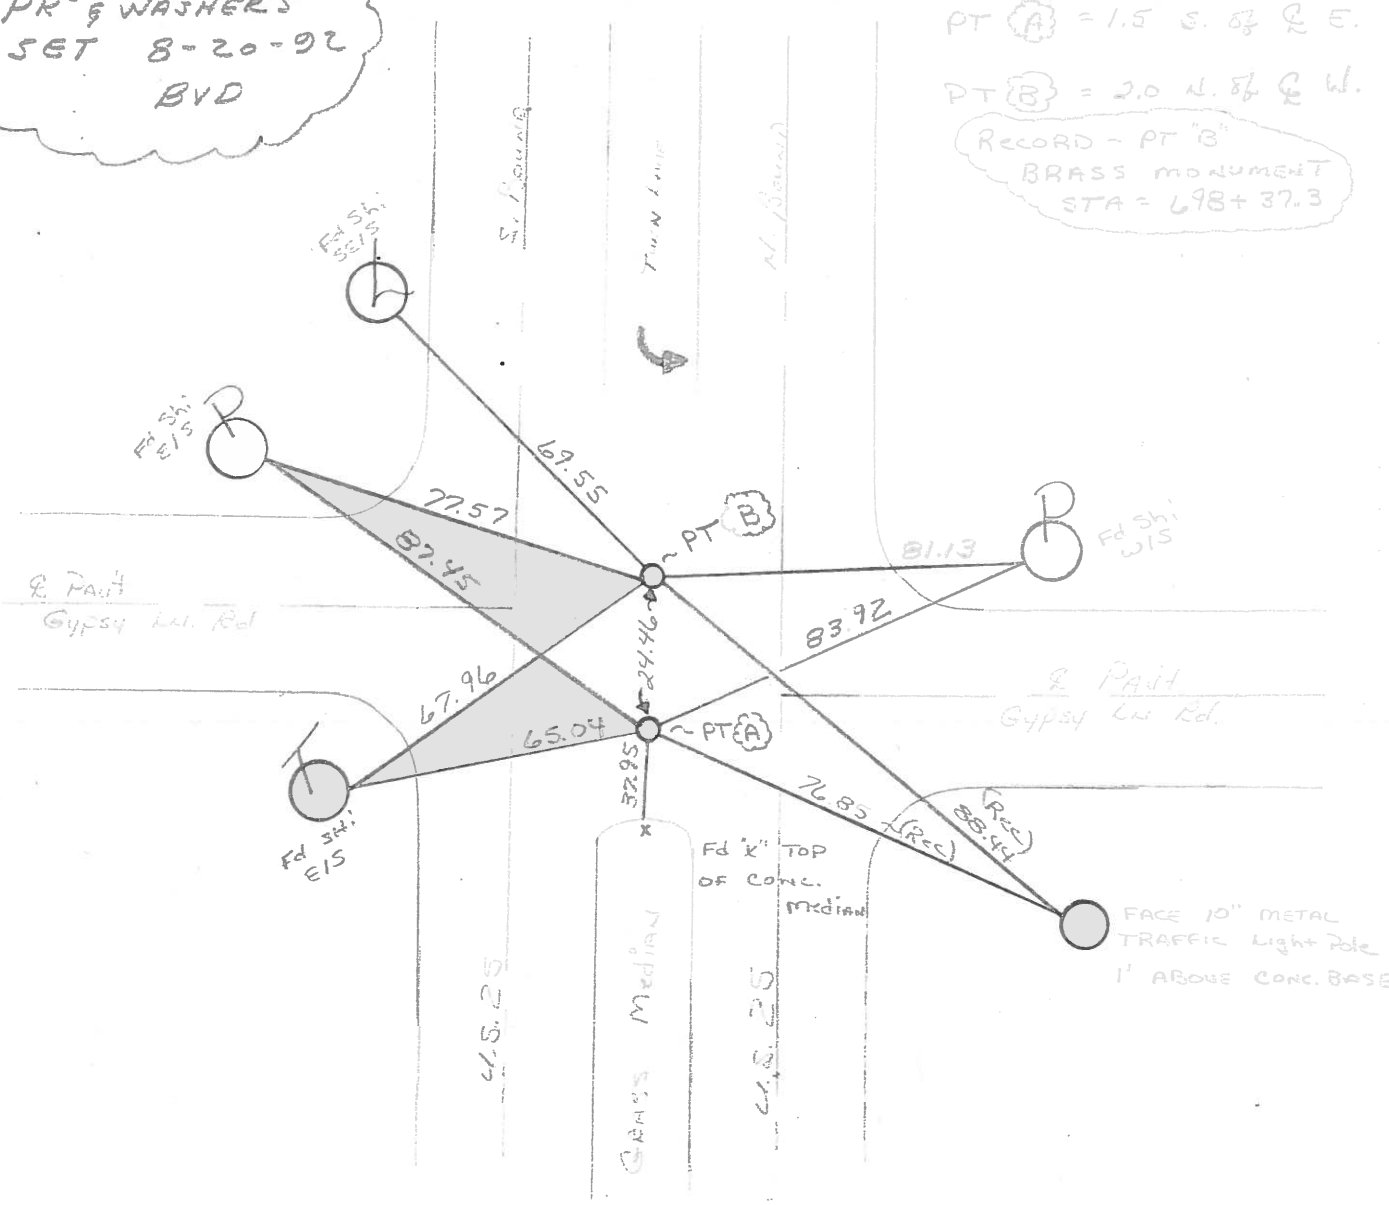

OD.O.T. DISTRICT 2 SURVEY OFFICE

SHEET OF

County WOOD <sup>U.S.</sup> ~~S.R.~~ 25

Date 7-7-71 <sup>O.K. 5-18-78</sup>

Township PLAIN


Weather CLEAR

Section 25


Temp. 77°

T5N, R10E

Personnel BURNSIDE  
SMITH  
BOWERS

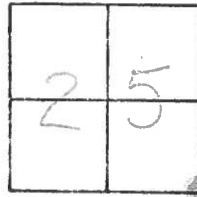


# 21

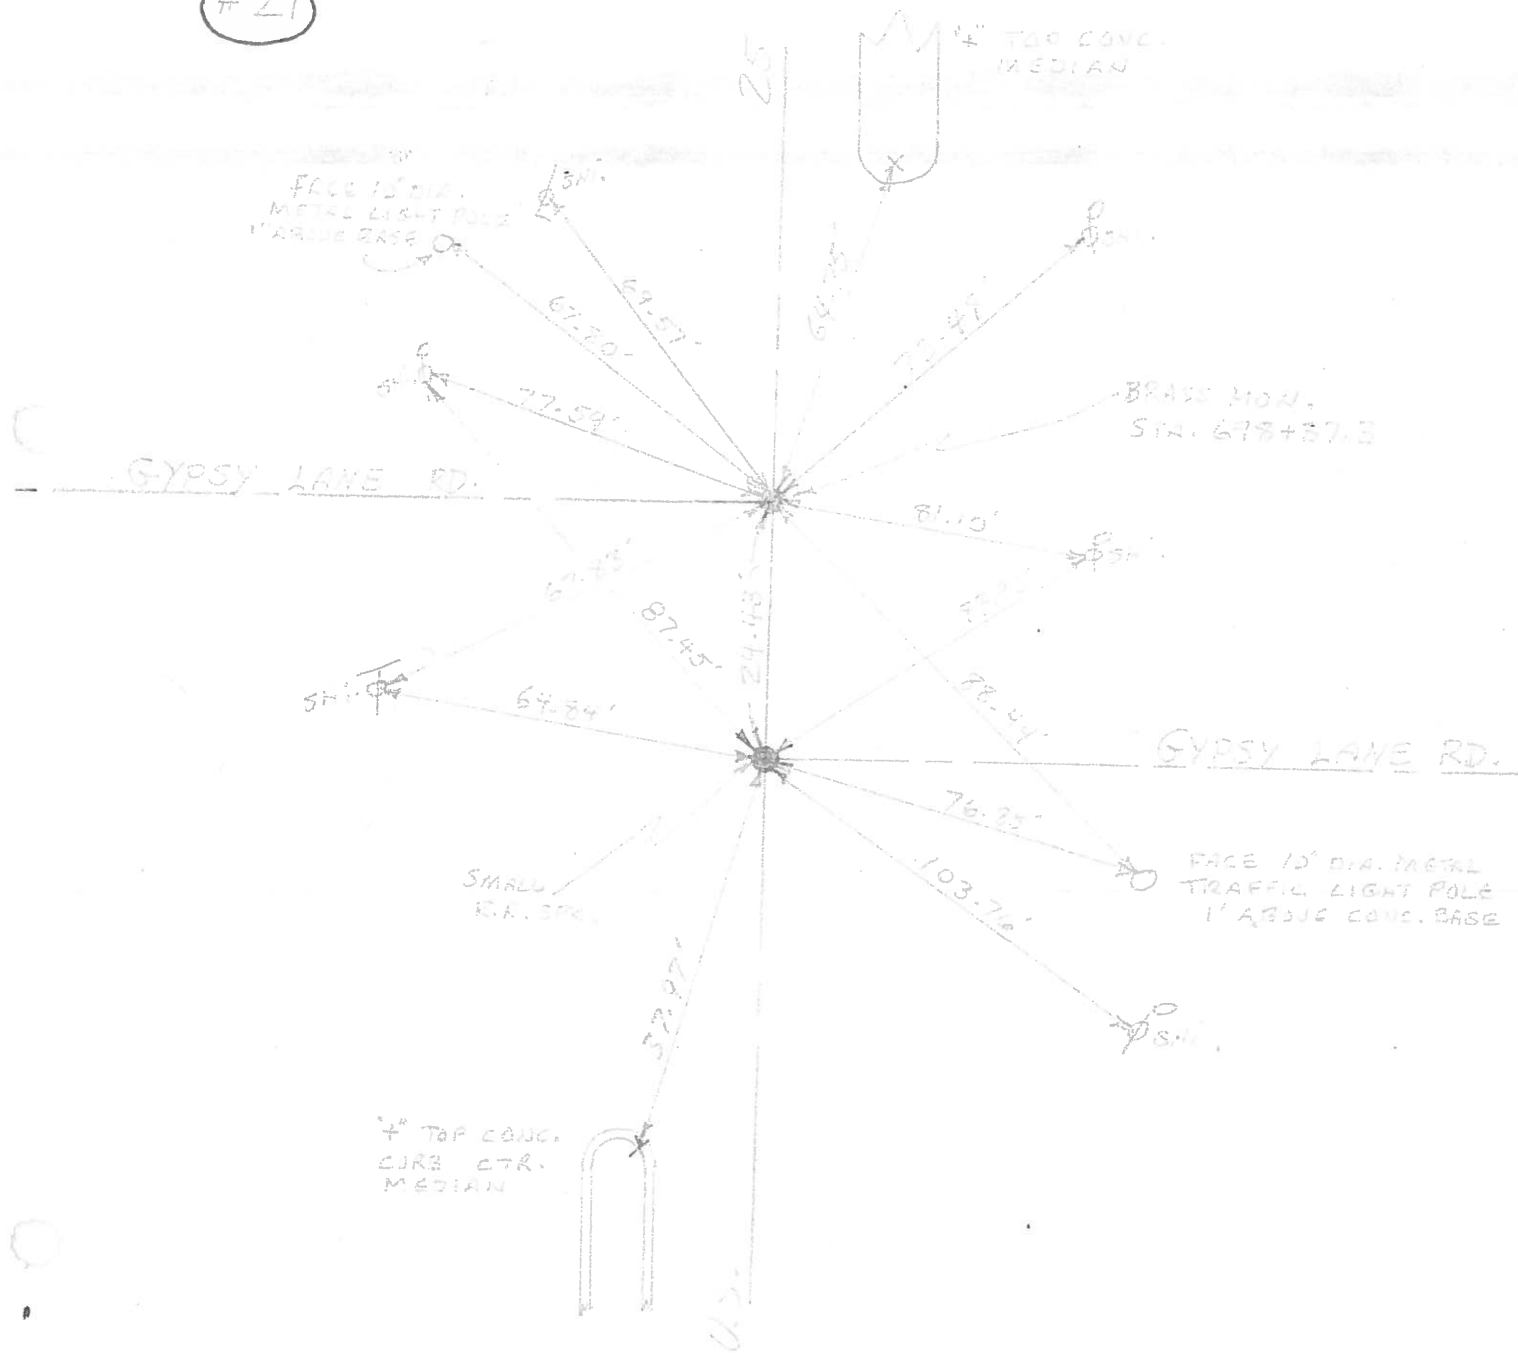

PERSONNEL \_\_\_\_\_ TITLE \_\_\_\_\_ PERSONNEL \_\_\_\_\_ TITLE \_\_\_\_\_  
 COUNTY Wood DATE June 1st 64  
 S. R. 115 25 WEATHER \_\_\_\_\_  
 SEC. \_\_\_\_\_ TEMP. \_\_\_\_\_

DESCRIPTION New Wit. Ties JOB NO. \_\_\_\_\_

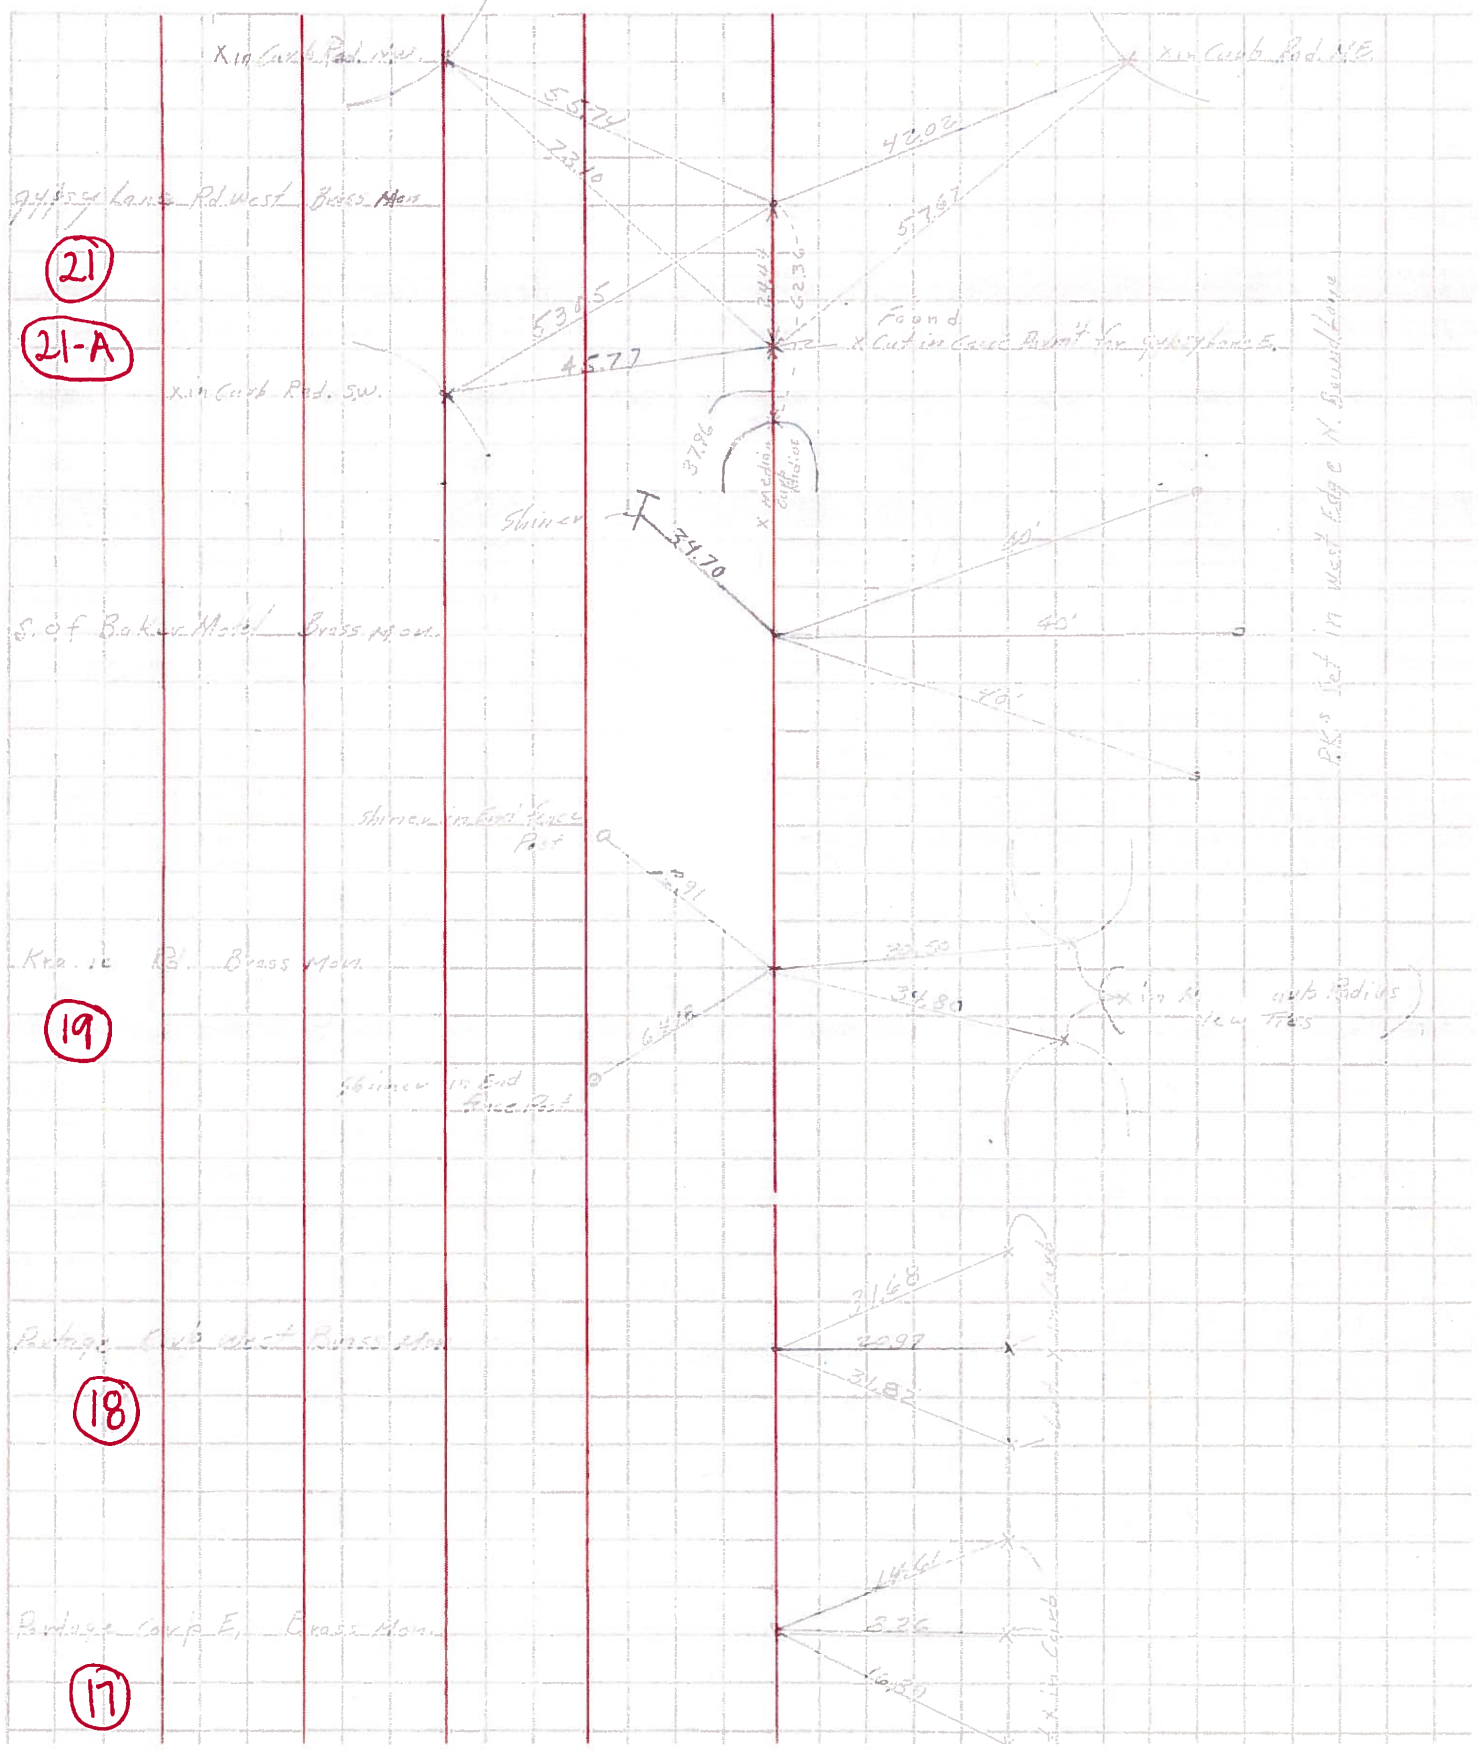

(21)  
 (21-A)

(19)

(18)

(17)