

O.D.O.T. DISTRICT 2 SURVEY OFFICE (USE ONLY)

PERSONNEL

REFERENCE NO. 22 A

SHEET 7 OF 35

NOTES BARNHISEL

DATE 4/14/92

ROUTE US 25

H.C. VAN DUSEN

WEATHER CLOUDY

COUNTY WOOD

R.C. BARNHISEL

TEMP. 40°

TOWNSHIP PLAIN

SECTION 25

DWG BY RHOADES

PID _____

T 5 N R 10 E

TYPE MONUMENT P.K.NAIL

ON SURFACE - ~~BELOW~~ ON _____

OFFSET C PAVEMENT ON _____ LT : RT

22.6' TO LT EDGE PAVEMENT



STATION: 490+47

HORZ.DATUM: _____

GEOID: _____

GRID: NORTHING: _____

EASTING: _____

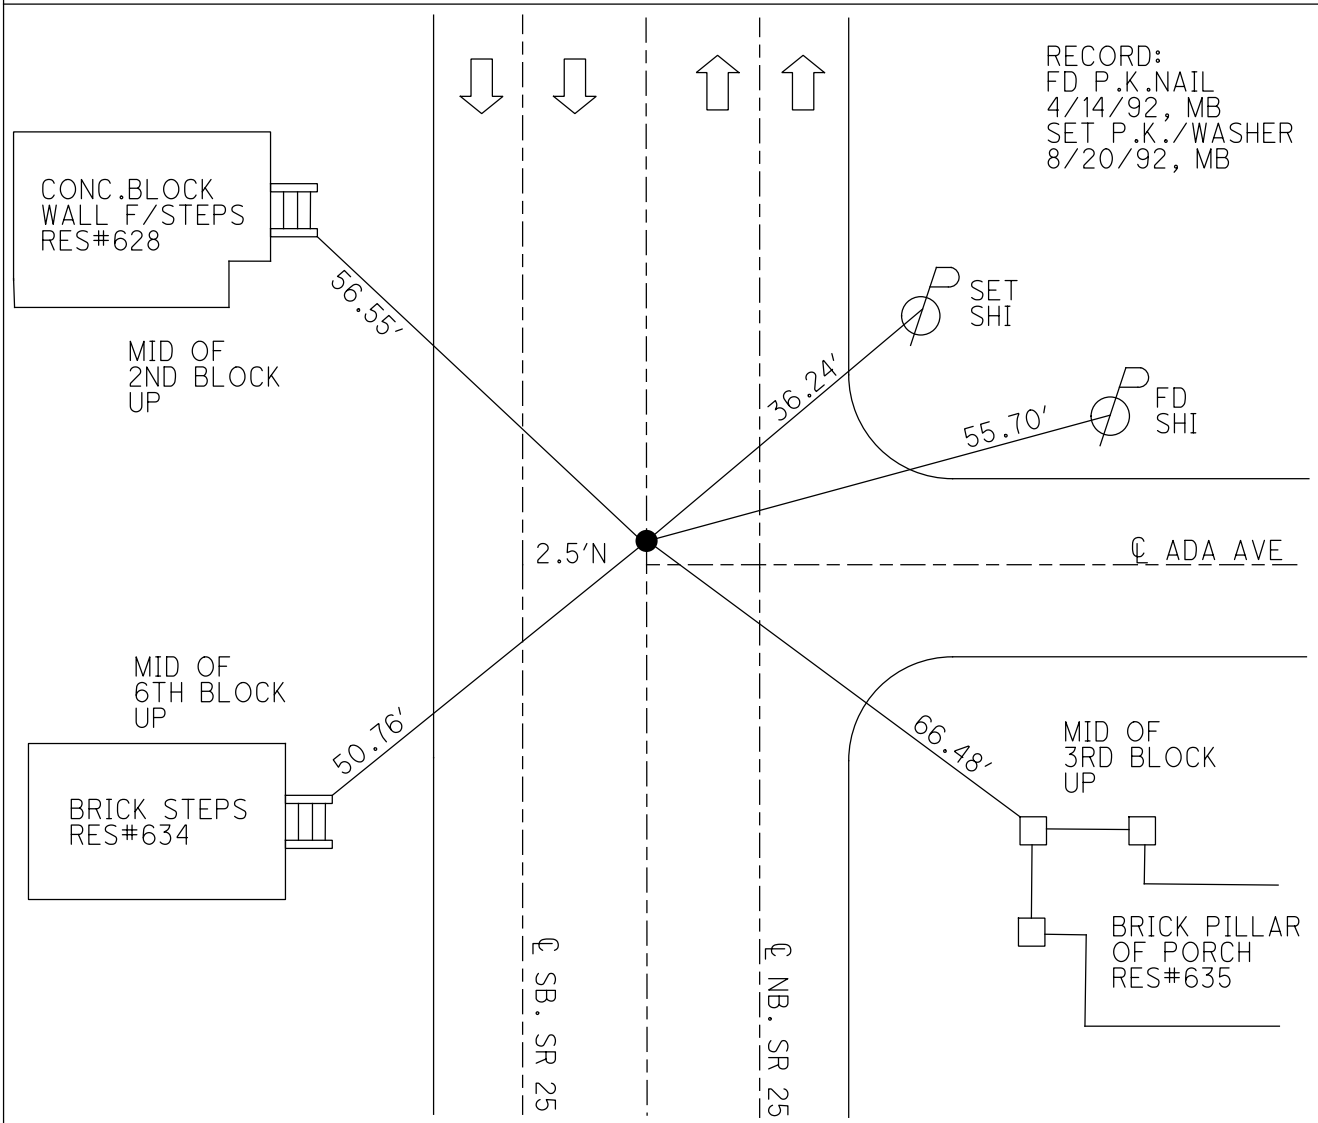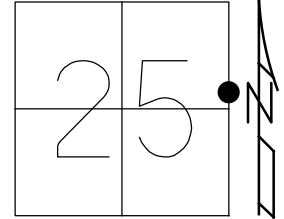

O.D.O.T. DISTRICT 2 SURVEY OFFICE

PERSONNEL

REFERENCE NO. 22-A

SHEET 3 OF 22

NOTES BARNHISEL

H.C. VAN DUSEN

DATE 4-14-92

ROUTE U.S. 25

R.C. BARNHISEL

WEATHER Cloudy

COUNTY Wood

TEMP. +40°

TOWNSHIP Plant

SECTION 25

T. S. N. R. 10 E.



TYPE MONUMENT P.K. NAIL

ON SURFACE - BELOW YES

LEFT - & PAV'T. - RIGHT YES

22.6 TO LT EDGE PAVEMENT FACE & CURB

S.L.M. 490+47 2.5 N. & E.

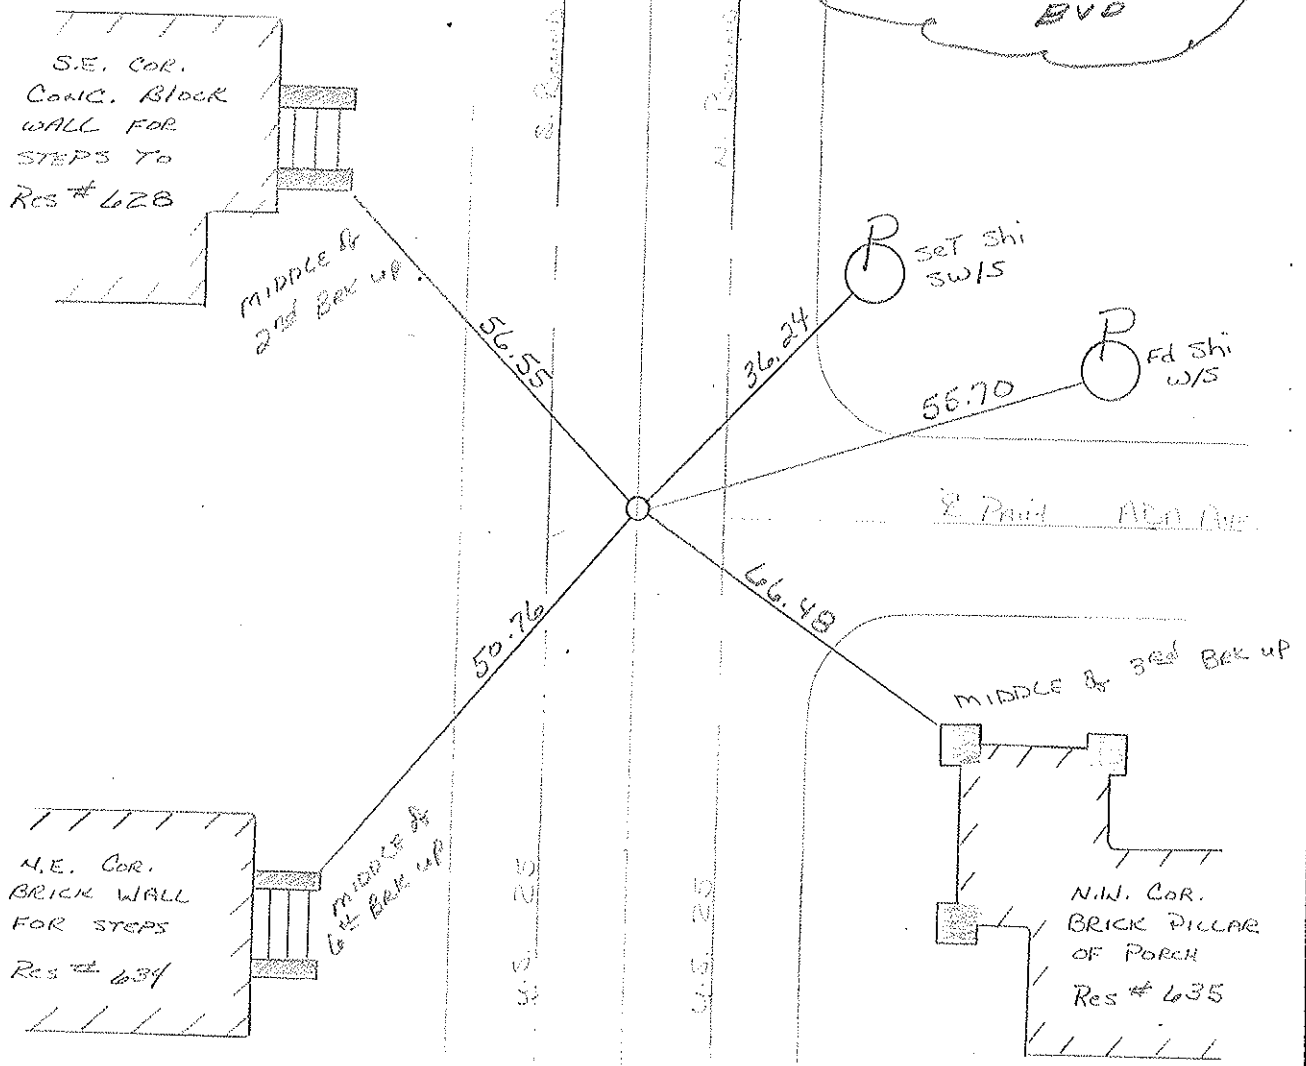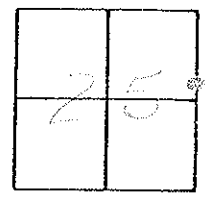

ODOT. DISTRICT 2 SURVEY OFFICE

SHEET

OF

County WOOD ^{U.S.} S.R. 25

Date 3-26-75

Township PLAIN


Weather PT. CLOUDY

Section 25

Temp. 26°

T N, R E

Personnel BURNSIDE

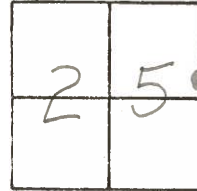

22-A

