

O.D.O.T. DISTRICT 2 SURVEY OFFICE (USE ONLY)

PERSONNEL \_\_\_\_\_ REFERENCE NO. 22 B SHEET 8 OF 35

NOTES BARNHISEL DATE 4/14/92 ROUTE US 25  
 H.C. VAN DUSEN WEATHER CLOUDY COUNTY WOOD  
 R.C. BARNHISEL TEMP. 40° TOWNSHIP PLAIN  
 SECTION 25

DWG BY RHOADES PID \_\_\_\_\_

T 5 N R 10 E

TYPE MONUMENT P.K.NAIL

ON SURFACE - ~~BELOW~~ ON \_\_\_\_\_


OFFSET ☉ PAVEMENT ON \_\_\_\_\_ LT : RT

- TO - EDGE PAVEMENT

STATION: 493+51

HORZ.DATUM: \_\_\_\_\_ GEOID: \_\_\_\_\_

GRID: NORTHING: \_\_\_\_\_ EASTING: \_\_\_\_\_

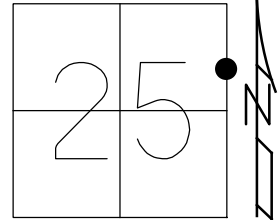

RECORD:  
 FD P.K.NAIL  
 4/14/92, MB  
 SET P.K./WASHER  
 8/20/92, MB



DIST.22B-22BC= 110.00'

COR.BRICK  
 PORCH POST

50.12'

RES#602

58.75'

COR.FDN

SET  
 SHI

RES#539

CONC. BLOCK  
 1ST BRICK UP

35.70'

67.60'

☉ GEORGIA AVE

70.46'

BRICK  
 PORCH FDN  
 2ND BRICK UP

RES#605

☉ SB. SR 25

☉ NB. SR 25

# O.D.O.T. DISTRICT 2 SURVEY OFFICE

PERSONNEL

REFERENCE NO. 22-R

SHEET 4 OF 22

NOTES BARNHISEL

H.C. Van Dusen

DATE 4-14-92

ROUTE U.S. 25

R.C. BARNHISEL

WEATHER cloudy

COUNTY Wood

TEMP. +40°

TOWNSHIP Plain

SECTION 25

T. 5 N. R. 10 E



TYPE MONUMENT P.K. NAIL (S. Ridge Rd)

ON SURFACE - BELOW yes

LEFT- & PAV'T. - RIGHT yes

22.7 TO RT EDGE PAVEMENT

S.L.M. 494+61 (S. Ridge Rd)

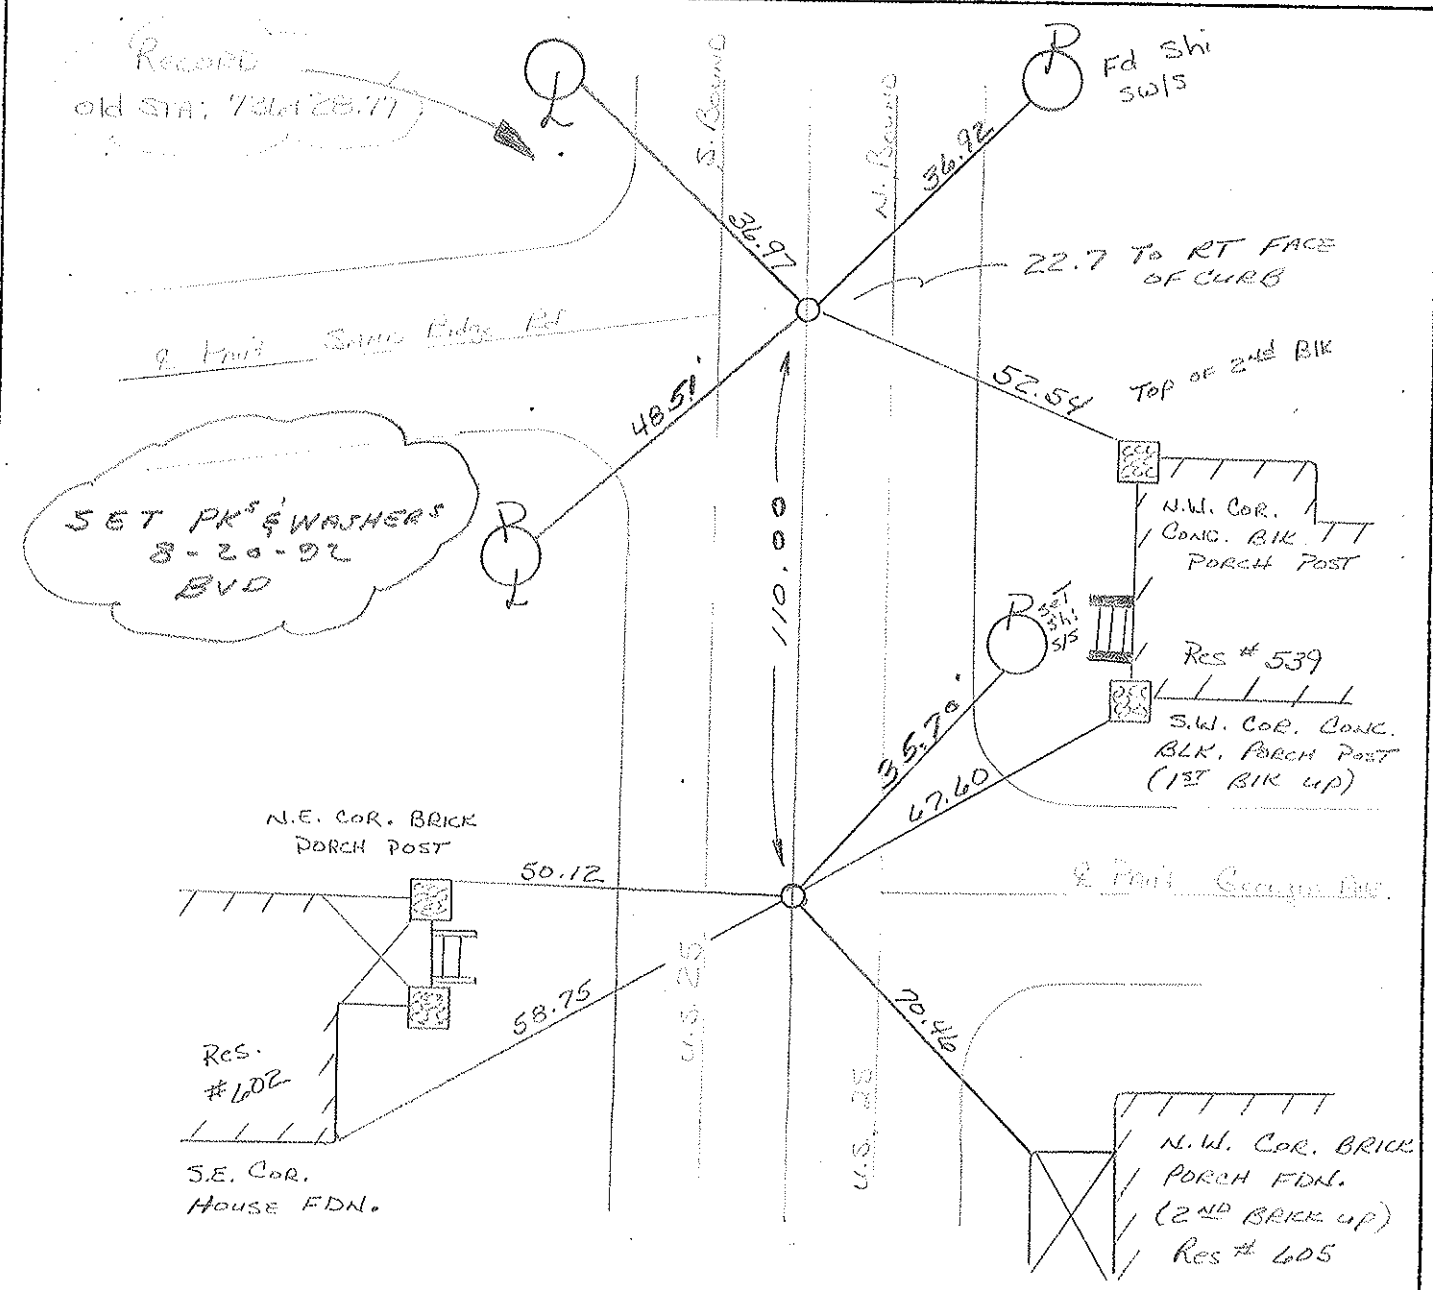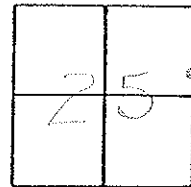

ODOT. DISTRICT 2 SURVEY OFFICE

SHEET OF

County WOOD U.S. S.R. 25

Date 3-26-75

Township PLAIN

Weather PT. CLOUDY

Section 25


Temp. 26°

T5N, R10E


Personnel BURNSIDE

SMITH

BOWERS

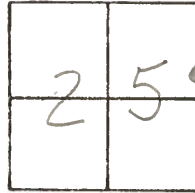

# 22-8

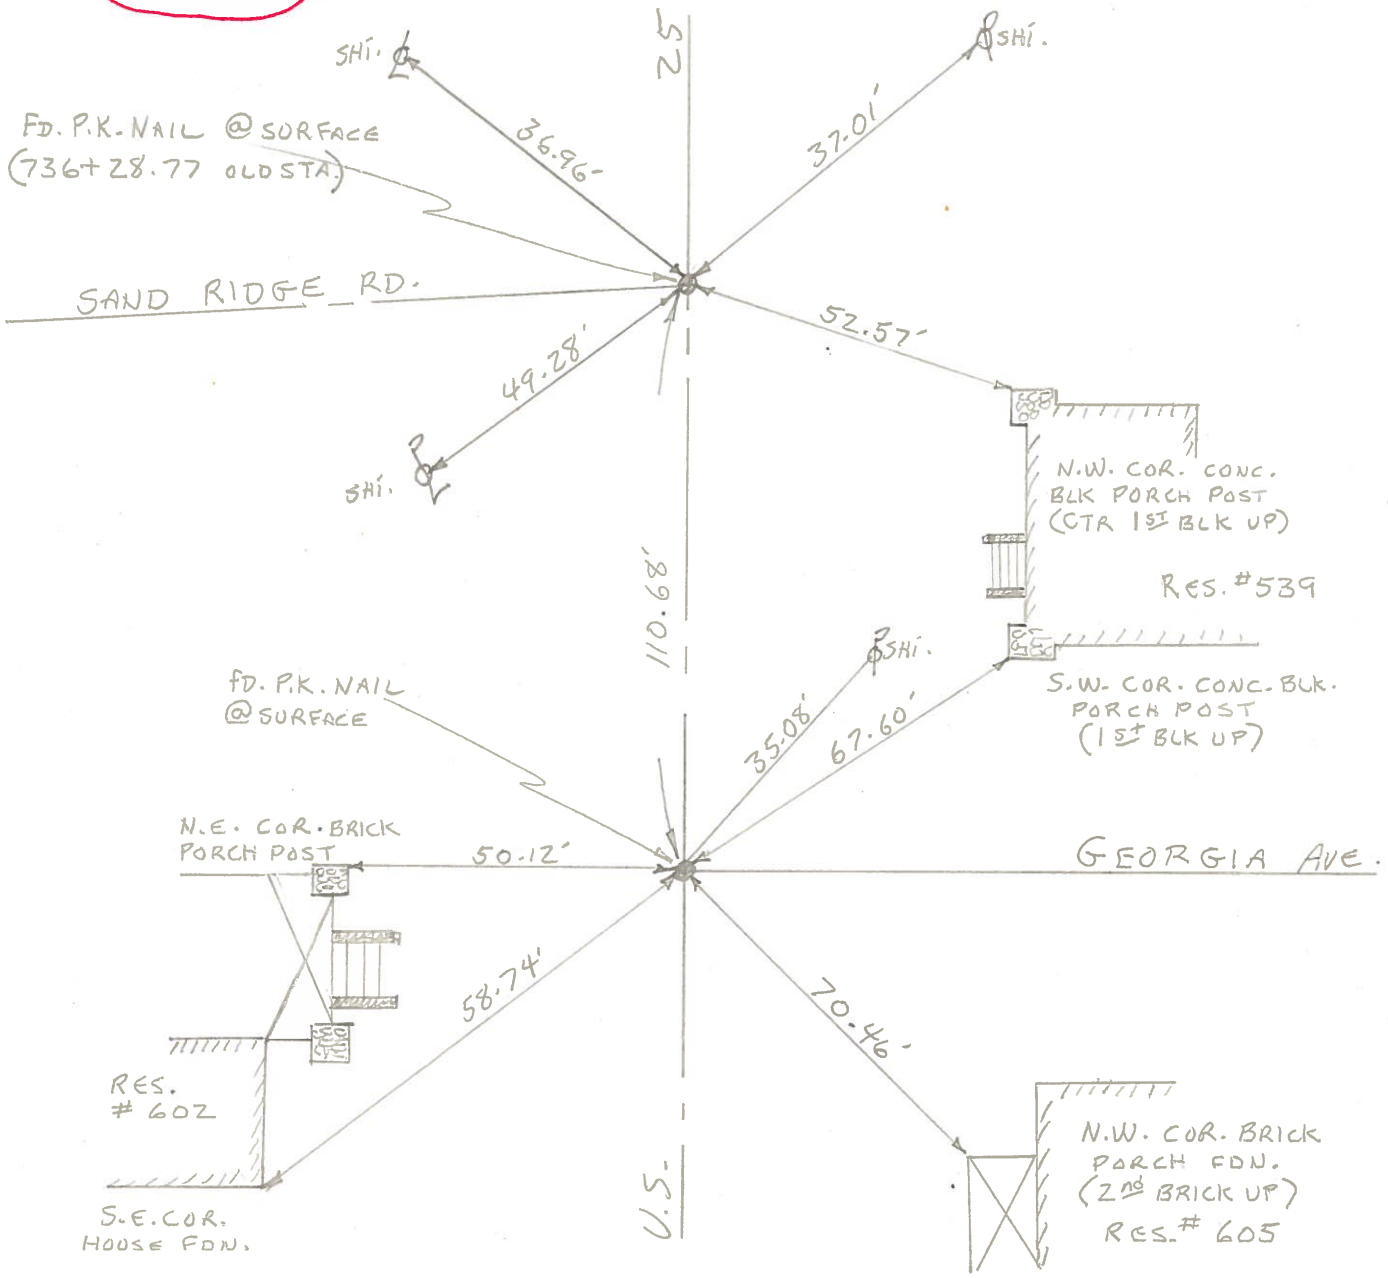

PERSONNEL	TITLE	PERSONNEL	TITLE	COUNTY	DATE
Silvester				d	4/22/58
				S. R.	WEATHER
Cc				SEC. B.	TEMP.
DESCRIPTION Napoleon Rd - N. Corp. / ne					JOB NO.
LEFT		CENTER LINE		RIGHT	

